




LOCATION: SOUTH BURLINGTON:
STA. 52+45, LT
COLOR: WHITE BORDER AND TEXT (RETROREFLECTIVE)
BLUE BACKGROUND (RETROREFLECTIVE)
MATERIAL: PER THE TABLE ON SHEET 90

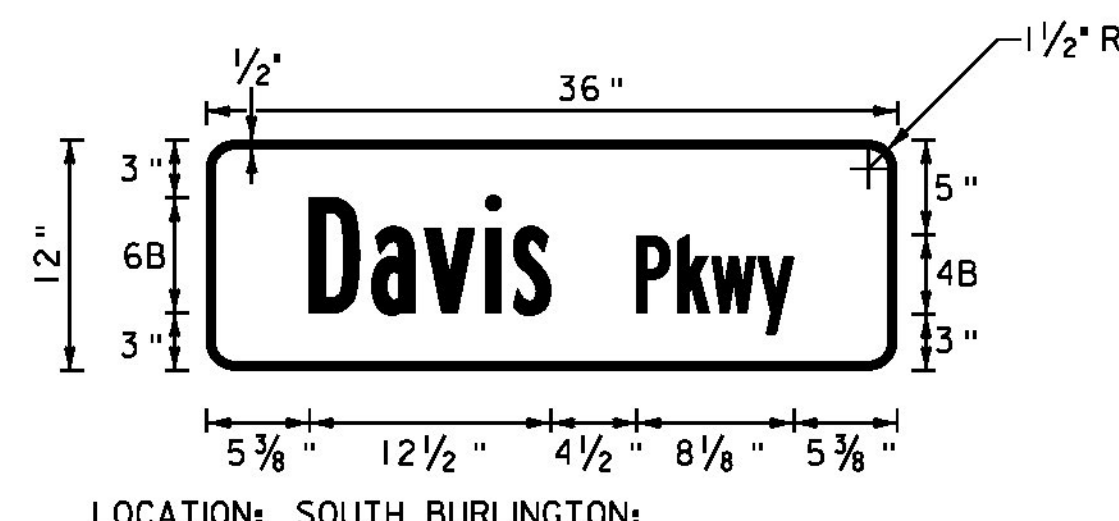


LOCATION: SOUTH BURLINGTON:
STA. 62+32, RT
COLOR: WHITE BORDER AND TEXT (RETROREFLECTIVE)
BLUE BACKGROUND (RETROREFLECTIVE)
MATERIAL: PER THE TABLE ON SHEET 90

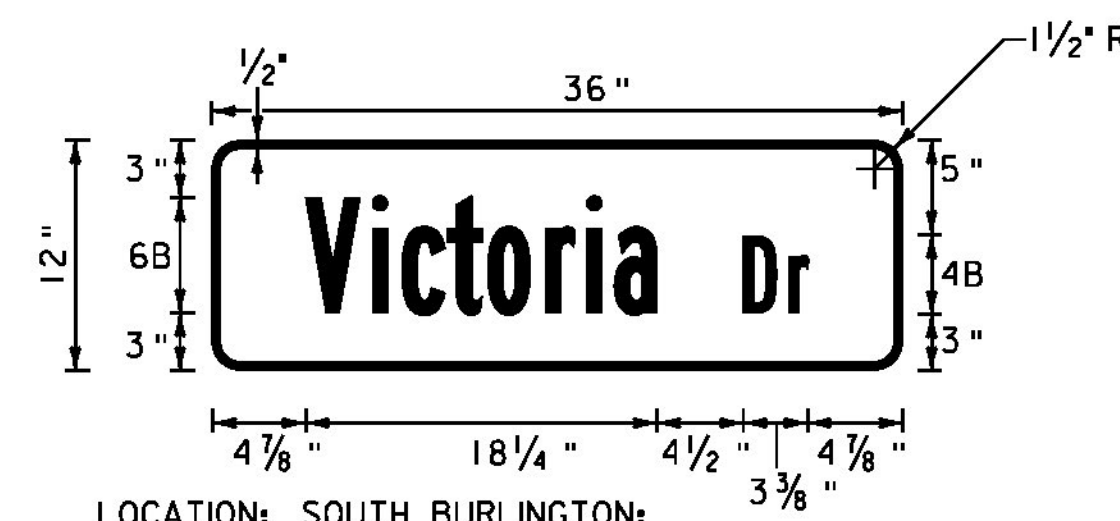


LOCATION: SOUTH BURLINGTON:
STA. 78+38, RT
COLOR: WHITE BORDER AND TEXT (RETROREFLECTIVE)
BLUE BACKGROUND (RETROREFLECTIVE)
MATERIAL: PER THE TABLE ON SHEET 90

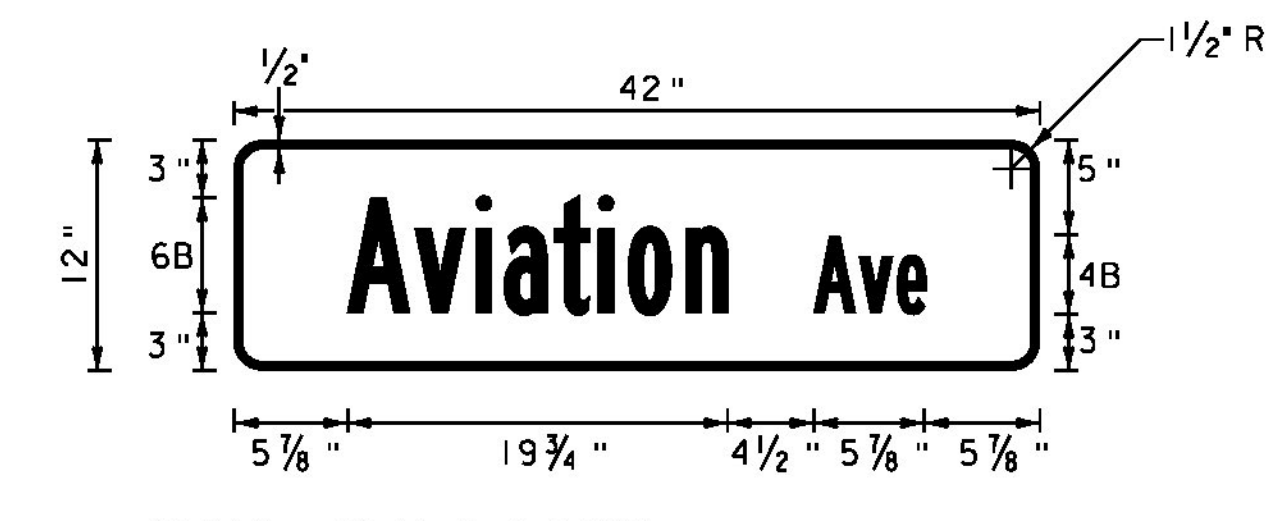


LOCATION: SOUTH BURLINGTON:
STA. 114+66, LT
COLOR: WHITE BORDER AND TEXT (RETROREFLECTIVE)
BLUE BACKGROUND (RETROREFLECTIVE)
MATERIAL: PER THE TABLE ON SHEET 90

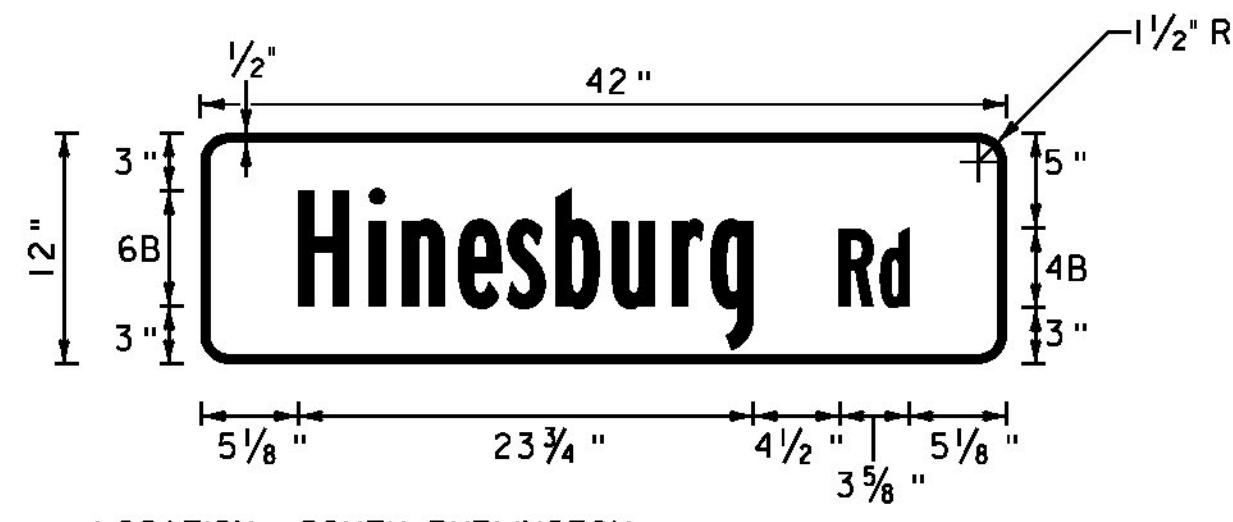


LOCATION: SOUTH BURLINGTON:
STA. 53+70, RT
COLOR: WHITE BORDER AND TEXT (RETROREFLECTIVE)
BLUE BACKGROUND (RETROREFLECTIVE)
MATERIAL: PER THE TABLE ON SHEET 90

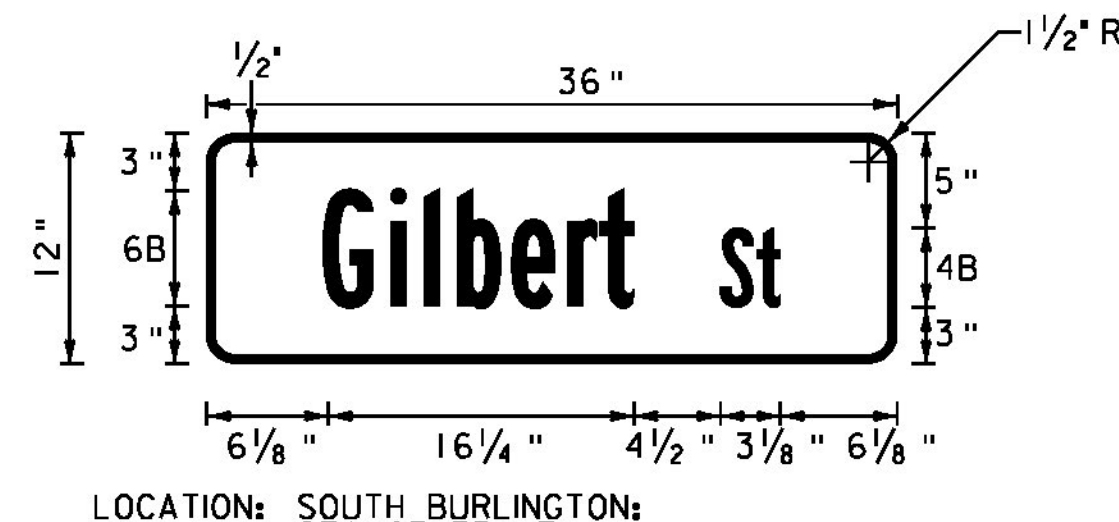


LOCATION: SOUTH BURLINGTON:
STA. 67+33, LT
COLOR: WHITE BORDER AND TEXT (RETROREFLECTIVE)
BLUE BACKGROUND (RETROREFLECTIVE)
MATERIAL: PER THE TABLE ON SHEET 90

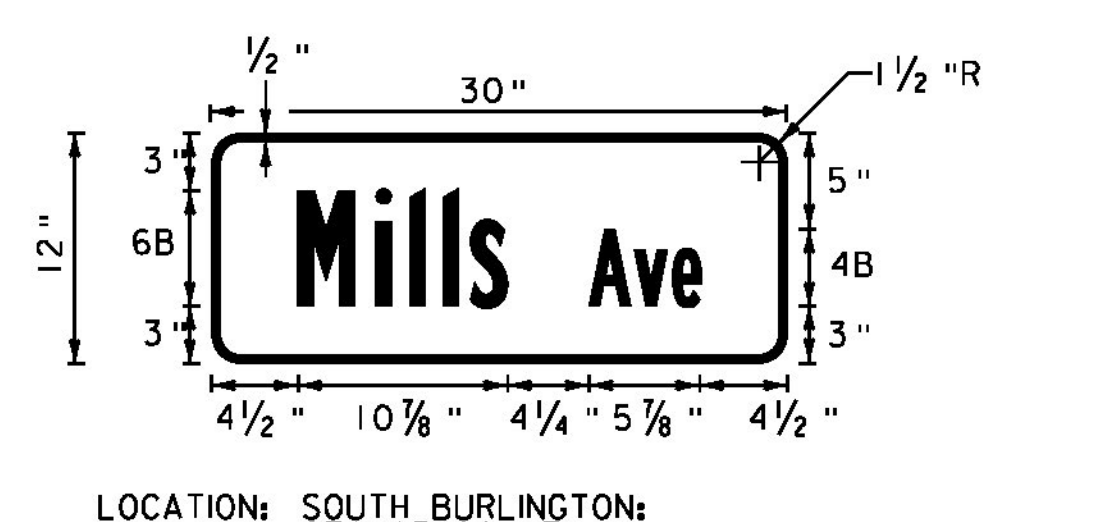


LOCATION: SOUTH BURLINGTON:
STA. 83+20, LT
COLOR: WHITE BORDER AND TEXT (RETROREFLECTIVE)
BLUE BACKGROUND (RETROREFLECTIVE)
MATERIAL: PER THE TABLE ON SHEET 90

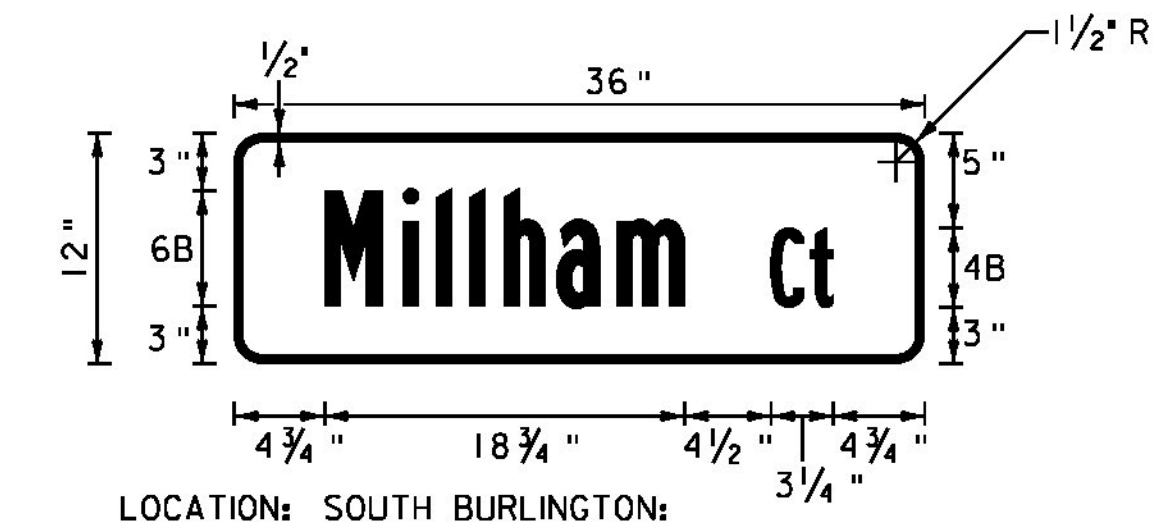


LOCATION: SOUTH BURLINGTON:
STA. 120+46, RT
COLOR: WHITE BORDER AND TEXT (RETROREFLECTIVE)
BLUE BACKGROUND (RETROREFLECTIVE)
MATERIAL: PER THE TABLE ON SHEET 90

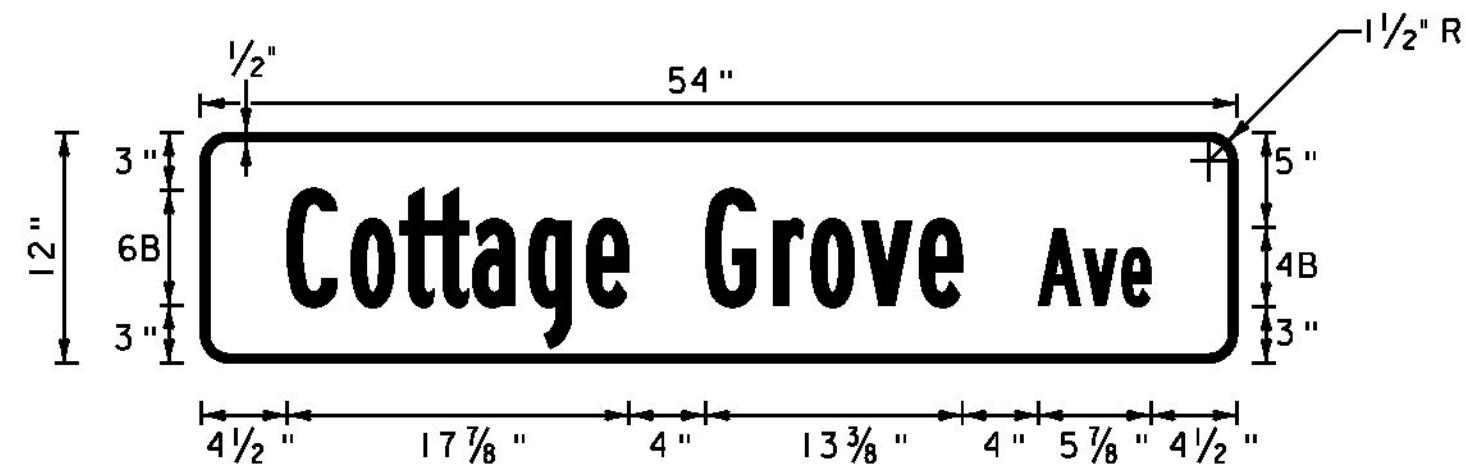


LOCATION: SOUTH BURLINGTON:
STA. 54+82, LT
COLOR: WHITE BORDER AND TEXT (RETROREFLECTIVE)
BLUE BACKGROUND (RETROREFLECTIVE)
MATERIAL: PER THE TABLE ON SHEET 90

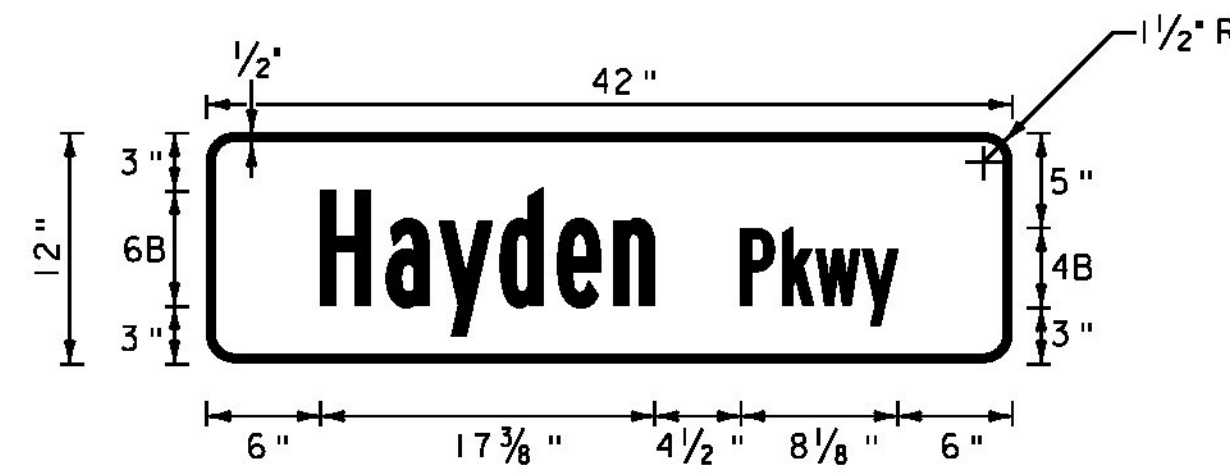


LOCATION: SOUTH BURLINGTON:
STA. 67+93, RT
COLOR: WHITE BORDER AND TEXT (RETROREFLECTIVE)
BLUE BACKGROUND (RETROREFLECTIVE)
MATERIAL: PER THE TABLE ON SHEET 90

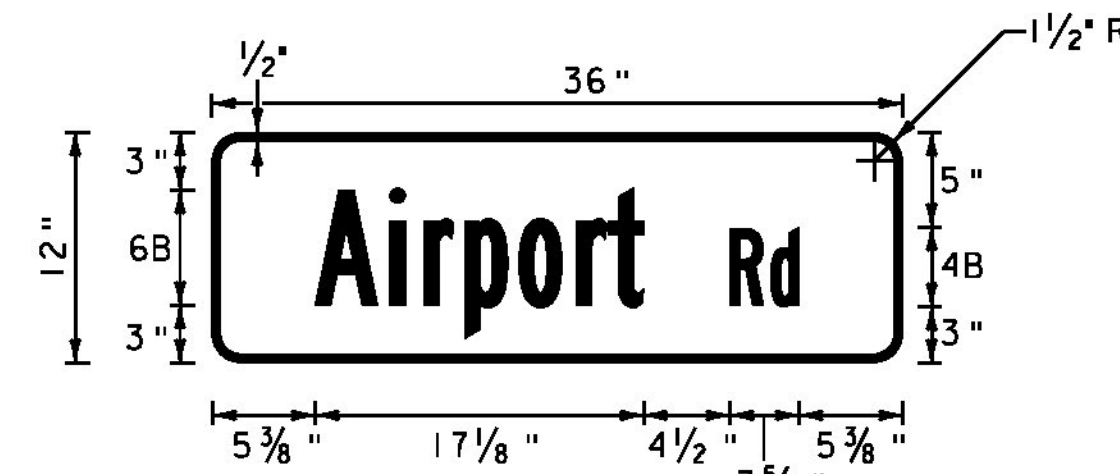


LOCATION: SOUTH BURLINGTON:
STA. 88+90, LT
COLOR: WHITE BORDER AND TEXT (RETROREFLECTIVE)
BLUE BACKGROUND (RETROREFLECTIVE)
MATERIAL: PER THE TABLE ON SHEET 90

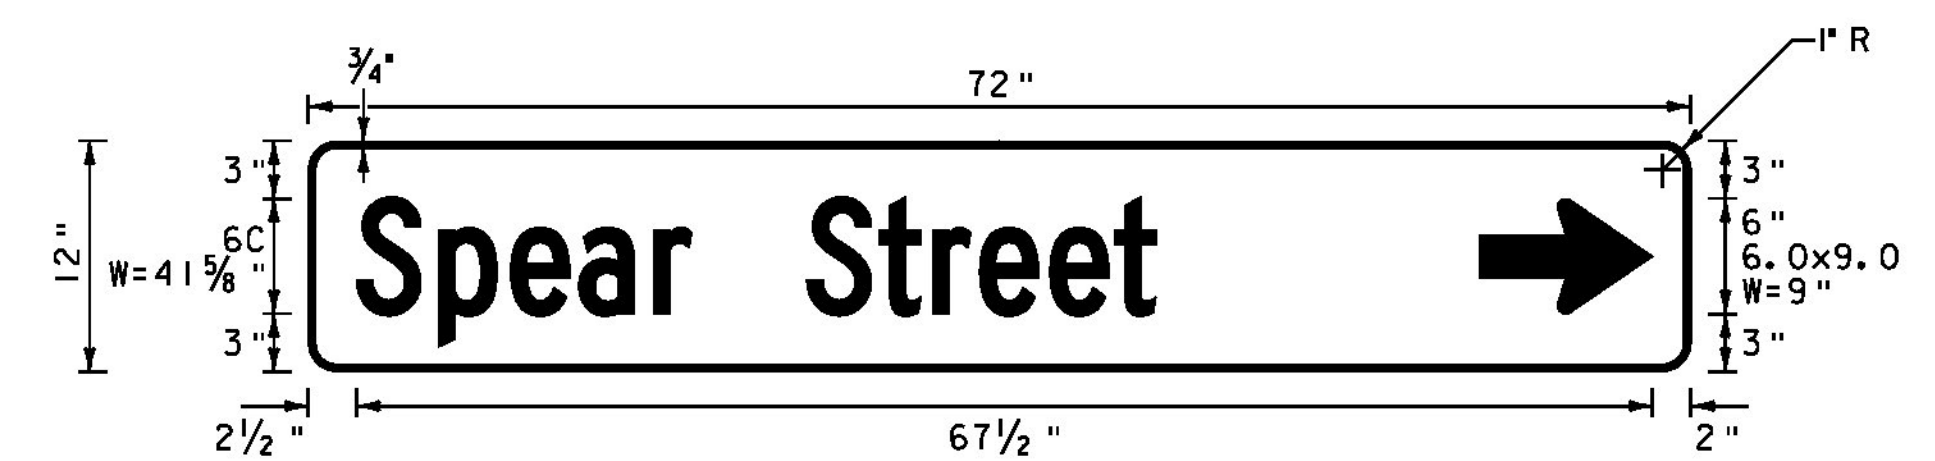

LOCATION: BURLINGTON
STA. 36+55, RT
COLOR: WHITE BORDER AND TEXT (RETROREFLECTIVE)
GREEN BACKGROUND (RETROREFLECTIVE)
MATERIAL: 0.125" FLAT SHEET ALUMINUM

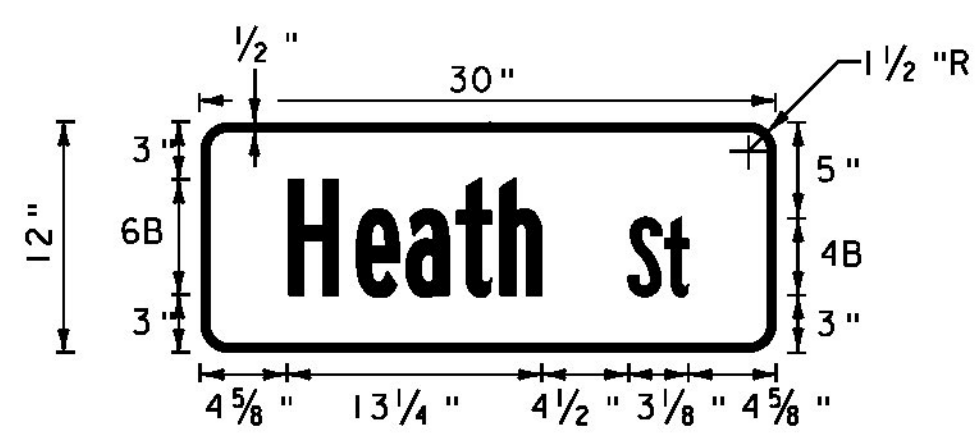


LOCATION: SOUTH BURLINGTON:
STA. 59+82, RT
COLOR: WHITE BORDER AND TEXT (RETROREFLECTIVE)
BLUE BACKGROUND (RETROREFLECTIVE)
MATERIAL: PER THE TABLE ON SHEET 90

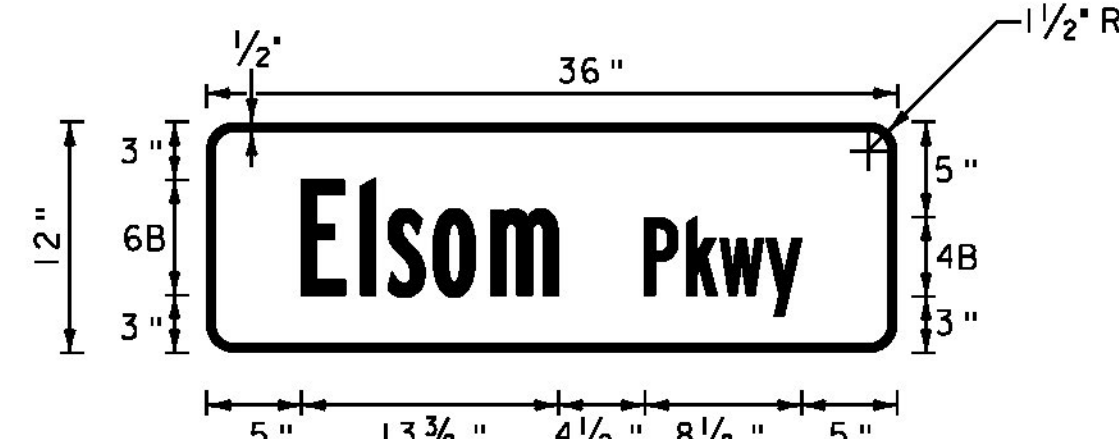


LOCATION: SOUTH BURLINGTON:
STA. 71+92, RT
COLOR: WHITE BORDER AND TEXT (RETROREFLECTIVE)
BLUE BACKGROUND (RETROREFLECTIVE)
MATERIAL: PER THE TABLE ON SHEET 90




LOCATION: SOUTH BURLINGTON:
STA. 99+62, LT
COLOR: WHITE BORDER AND TEXT (RETROREFLECTIVE)
BLUE BACKGROUND (RETROREFLECTIVE)
MATERIAL: PER THE TABLE ON SHEET 90

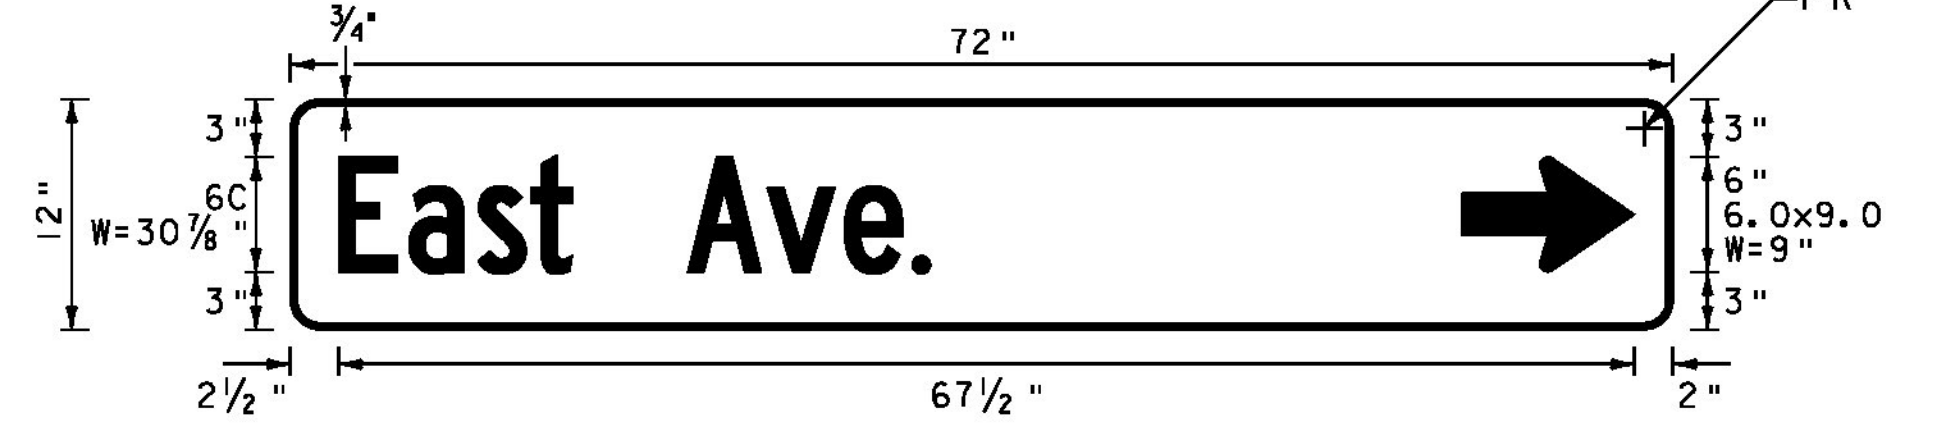


LOCATION: BURLINGTON
STA. 36+55, RT
COLOR: WHITE BORDER AND TEXT (RETROREFLECTIVE)
GREEN BACKGROUND (RETROREFLECTIVE)
MATERIAL: 0.125" FLAT SHEET ALUMINUM

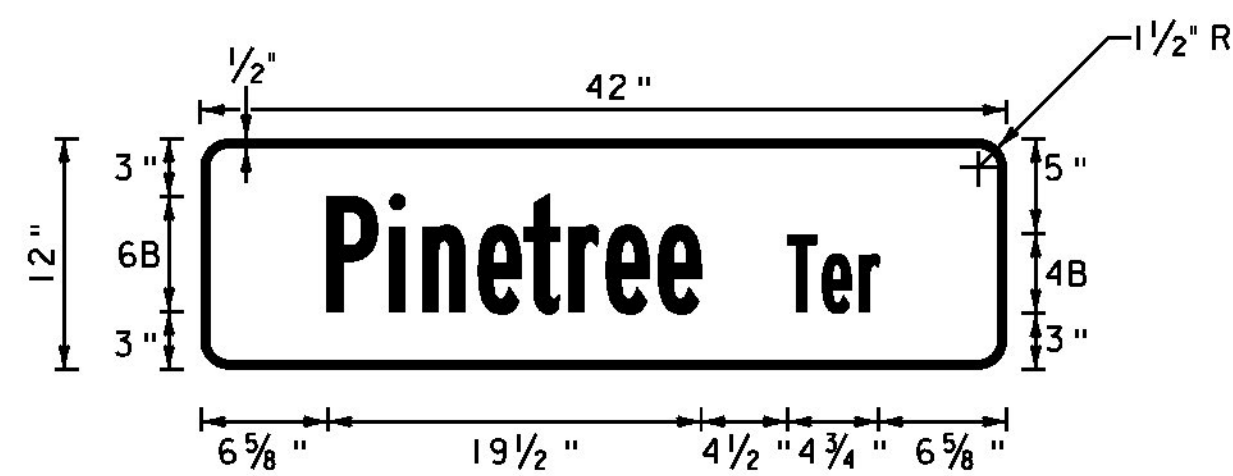

LOCATION: SOUTH BURLINGTON:
STA. 61+93, LT
COLOR: WHITE BORDER AND TEXT (RETROREFLECTIVE)
BLUE BACKGROUND (RETROREFLECTIVE)
MATERIAL: PER THE TABLE ON SHEET 90

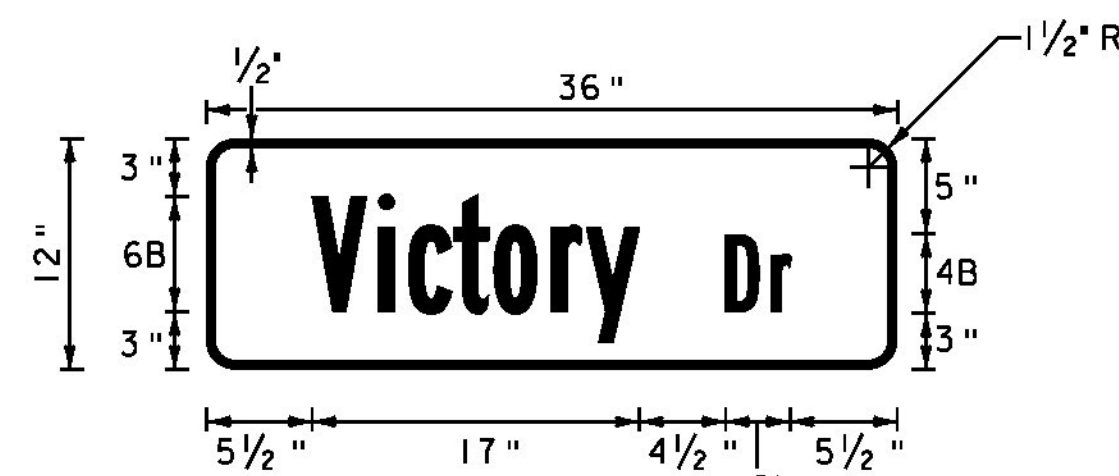

LOCATION: SOUTH BURLINGTON:
STA. 76+90, LT
COLOR: WHITE BORDER AND TEXT (RETROREFLECTIVE)
BLUE BACKGROUND (RETROREFLECTIVE)
MATERIAL: PER THE TABLE ON SHEET 90

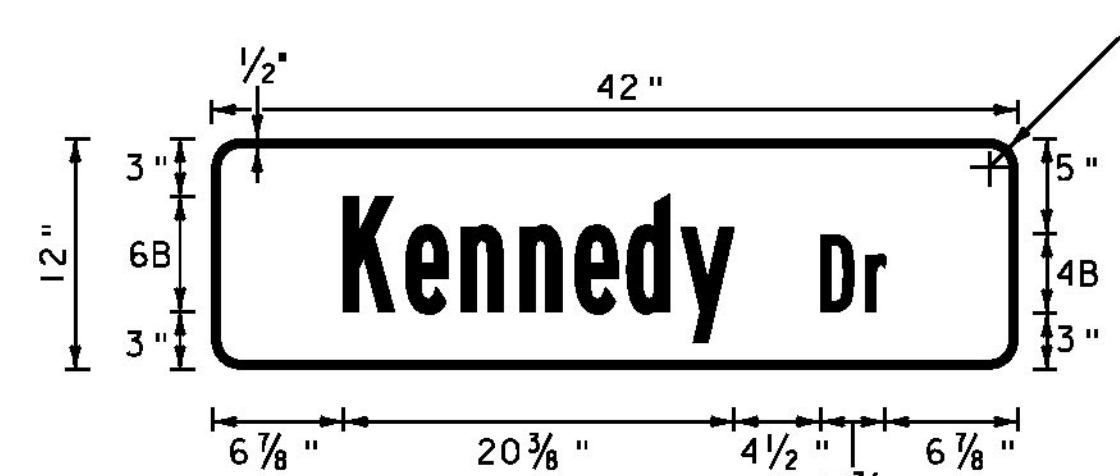

LOCATION: SOUTH BURLINGTON:
STA. 101+16, RT
COLOR: WHITE BORDER AND TEXT (RETROREFLECTIVE)
BLUE BACKGROUND (RETROREFLECTIVE)
MATERIAL: PER THE TABLE ON SHEET 90

NOT TO SCALE

NOTE: SEE TRAFFIC SIGN NOTES ON SHEET 90.

**TRAFFIC
SIGN
DETAIL
SHEET #2**

PROJECT NAME: BURLINGTON-SOUTH BURLINGTON
PROJECT NUMBER: NH 2624(I)
FILE NAME: p06d216.dgn
PROJECT LEADER:
DESIGNED BY: STANTEC
IPARM FILE: p06d216tsd02.i
PLOT DATE: 2/7/2012
DRAWN BY: STANTEC
CHECKED BY: STANTEC
SHEET 89 OF 108

