


U.S. ROUTE 2 / SOUTH WILLARD STREET INTERSECTION

ITEM 900.620 SPECIAL PROVISION (PEDESTRIAN SIGNAL HEADS, COUNTDOWN) (U.S. ROUTE 2 @ SOUTH WILLARD STREET) BURLINGTON STA. 0+00		
QUANTITY	UNIT	DESCRIPTION
8	EA	COUNT-DOWN PEDESTRIAN SIGNAL WITH MOUNTING HARDWARE
8	EA	ACCESSIBLE PEDESTRIAN PUSHBUTTON ASSEMBLY

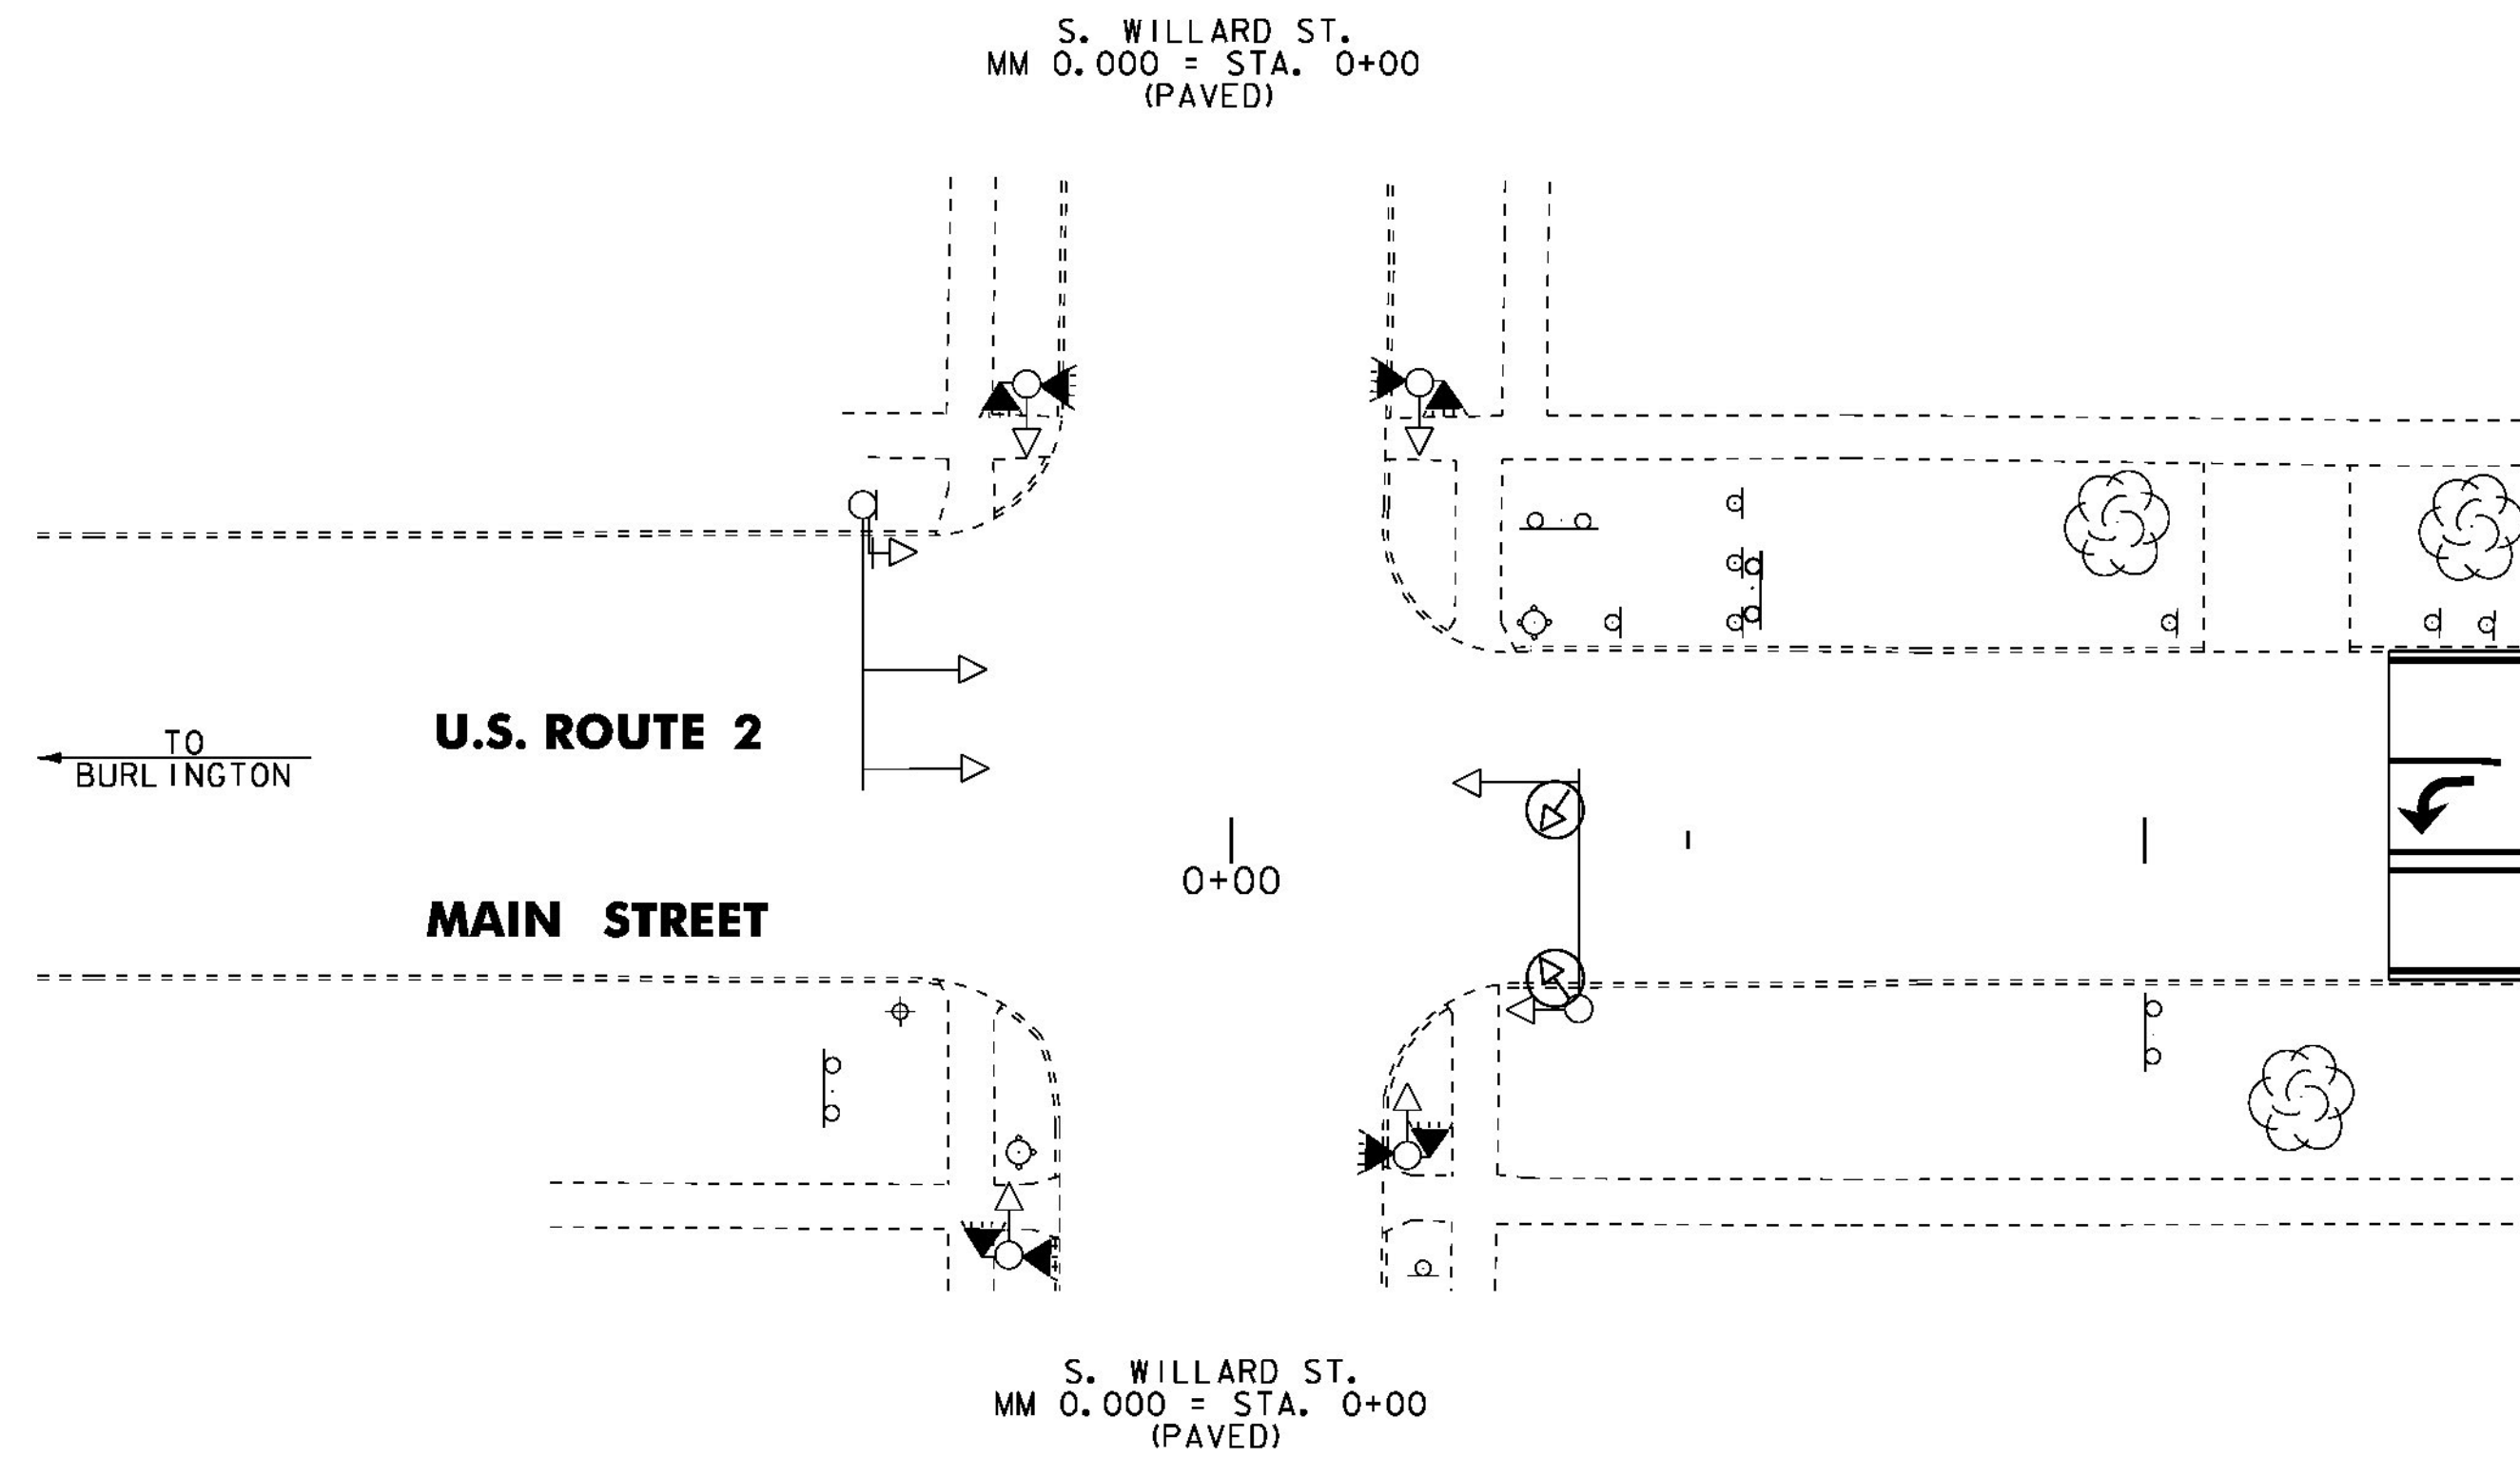

LEGEND	
DESCRIPTION	
---	EXISTING CONDUIT
□	EXISTING JUNCTION BOX
CT	EXISTING CONTROLLER CABINET
⊕	EXISTING POLE
□	VIDEO DETECTION AREA
⊕	EXISTING VIDEO DETECTOR CAMERA
⊕	PROPOSED VIDEO DETECTOR CAMERA
⊕	EXISTING VEHICLE SIGNAL
⊕	PROPOSED VEHICLE SIGNAL
PB	EXISTING PULL BOX
⊕	EXISTING PEDESTRIAN SIGNAL
⊕	PROPOSED COUNT-DOWN PEDESTRIAN SIGNAL

NOTES:

- THIS PLAN SHEET IS NOT TO SCALE AND SHALL ONLY BE USED AS A GUIDE FOR THE PLACEMENT OF THE HARDWARE LISTED. THE CONTRACTOR SHALL CONFIRM ALL LOCATIONS IN THE FIELD WITH THE RESIDENT ENGINEER PRIOR TO INSTALLATION. LOCATIONS MAY BE REVISED AS A RESULT OF THE SITE SURVEY.

NOT TO SCALE



TRAFFIC SIGNAL SYSTEM SHEET #1

PROJECT NAME: BURLINGTON-SOUTH BURLINGTON	PLOT DATE: 16-FEB-2012
PROJECT NUMBER: NH 2624(I)	DRAWN BY: STANTEC
FILE NAME: p06d216.dgn	CHECKED BY: STANTEC
PROJECT LEADER: JLL	SHEET 93 OF 108
DESIGNED BY: STANTEC	
IPARM FILE: p06d216tsss01.i	