


PLANT LIST

QTY.	SIZE	COMMON NAME	BOTANICAL NAME	SPACING & COMMENTS
SEEDLINGS				
213	5'-6' HT.	RED MAPLE	ACER RUBRUM	ARU
12	4'-5' HT.	COTTONWOOD	POPULOUS DELTOIDES	PDE
48	5'-6' HT.	SUGAR MAPLE	ACER SACCHARUM	ASA
324	5'-6' HT.	RED OAK	QUERCUS RUBRA	QRU
4	5'-6' HT.	BLACK CHERRY	PRUNUS SEROTINA	PSE
1	3' HT.	WHITE PINE	PINUS STROBUS	PST
LARGE TREES				
7	1-1/2" CAL.	RED MAPLE	ACER RUBRUM	AR
7	1-1/2" CAL.	SUGAR MAPLE	ACER SACCHARUM	AS
46	1-1/2" CAL.	RED OAK	QUERCUS RUBRA	QR
SHRUBS				
8480	30" HEIGHT	GRAY DOGWOOD	CORNUS RACEMOSA	CR
64	30" HEIGHT	NANNYBERRY	VIBURNUM LENTAGO	VL

CONTRACTOR KEPT THE CLEARING LIMITS TIGHT TO WORK AREA NEGATING THE NEED FOR MOST OF THE TREES.

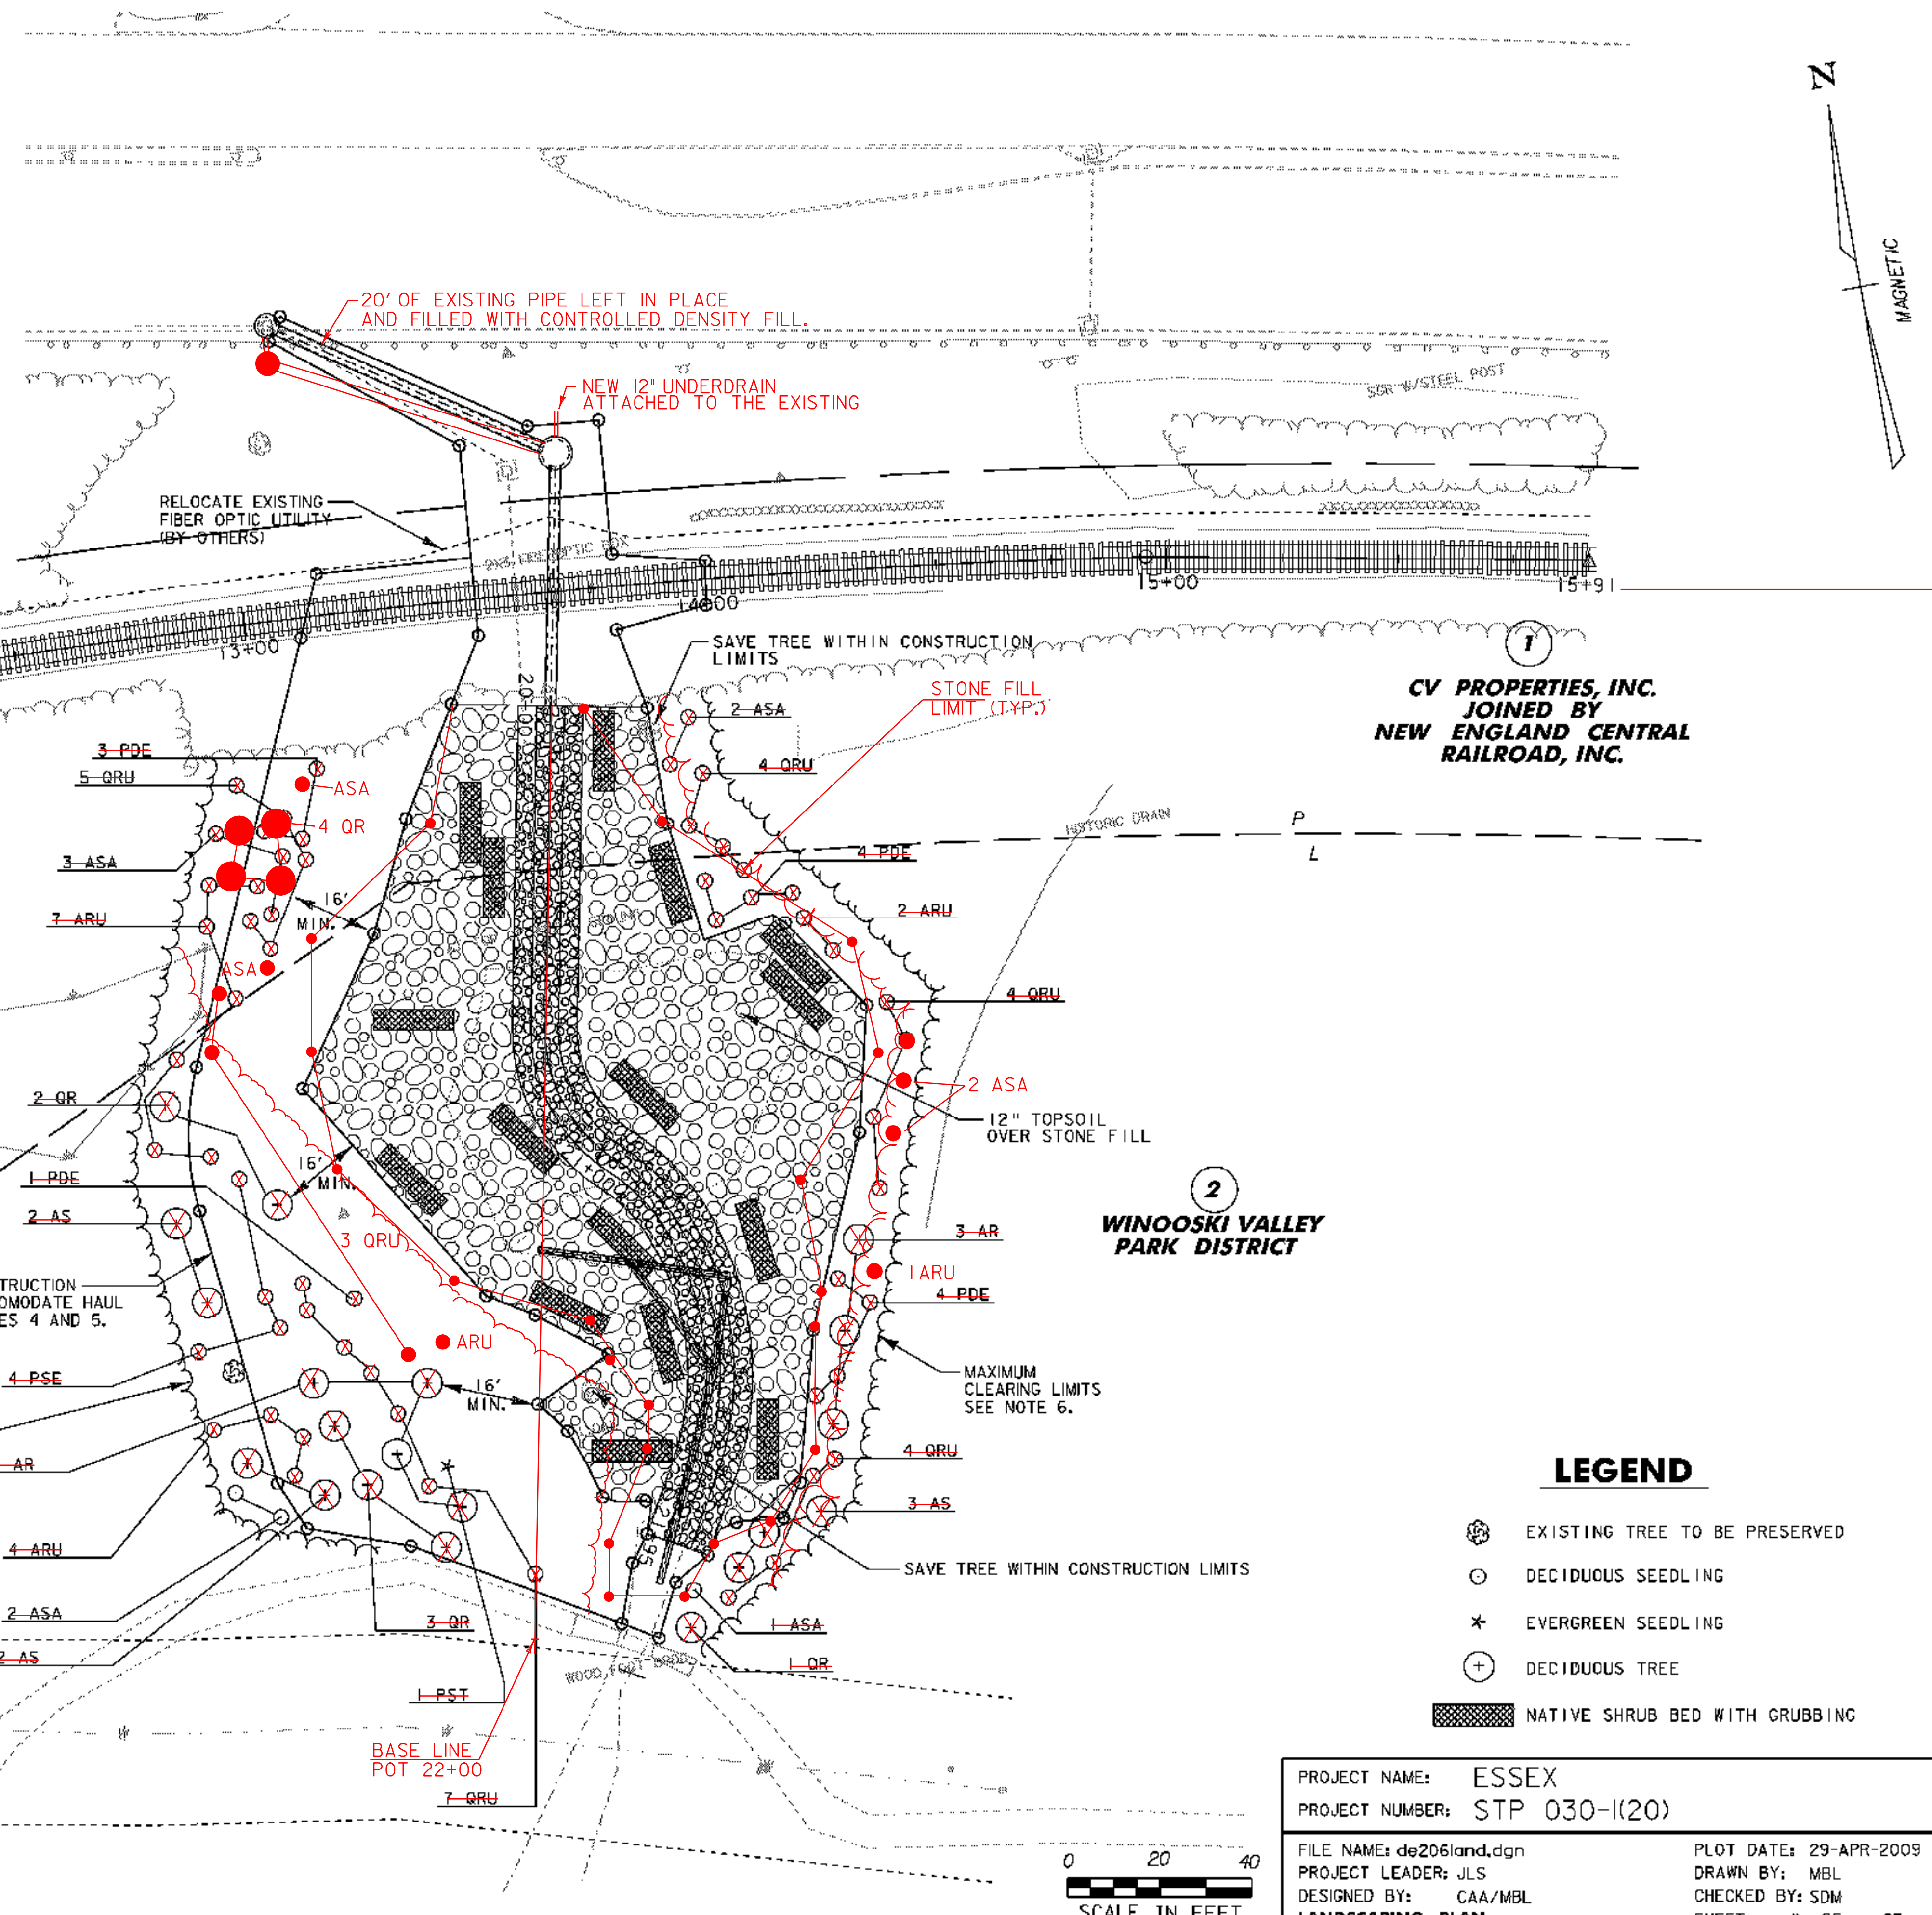

- NOTES:**
1. INSTALLATION OF SHRUBBERY SHALL BE DETERMINED BY THE RESIDENT ENGINEER.
 2. PLANTINGS LAYOUT MAY VARY BUT A NATURAL AND RANDOM PATTERN IS PREFERRED.
 3. ALL PROPOSED TREES PLANTED OUTSIDE OF STONED SLOPE SHALL BE INSTALLED NO CLOSER THAN 16' FROM EDGE OF STONED AREA.

LEGEND

- EXISTING TREE TO BE PRESERVED
- DECIDUOUS SEEDLING
- EVERGREEN SEEDLING
- DECIDUOUS TREE
- NATIVE SHRUB BED WITH GRUBBING

PROJECT NAME:	ESSEX	PLOT DATE:	29-APR-2009
PROJECT NUMBER:	STP 030-1(20)	DRAWN BY:	MBL
FILE NAME:	de206land.dgn	CHECKED BY:	SDM
PROJECT LEADER:	JLS	DESIGNED BY:	CAA/MBL
LANDSCAPING PLAN			SHEET 11 OF 27