


BEGIN SIGN LAYOUT AT THE BEGINNING OF MERGING TAPER. TAPER SHALL BE DELINEATED BY REFLECTORIZED PLASTIC DRUMS. USE MERGIN TAPER WHEN CLOSING RIGHT LANE.

REFLECTORIZED CHANNELING DEVICE (TYP.)

- NOTES:**
1. USE PORTABLE "RIGHT LANE CLOSED 1 MILE" WHEN SIGN PACKAGE IS MOVED FORWARD. SIGNS NOTED AS FIXED SHALL REMAIN IN PLACE THROUGH THE ENTIRE PROJECT. SIGNS NOTED AS PORTABLE SHALL MOVE AS THE WORK AREA CHANGES. ALL SIGNS SHALL BE REMOVED OR COVERED WHEN NOT NEEDED.
  2. WHEN WORK ZONE SPEED LIMIT IS NOT IN USE ALL ASSOCIATED SIGNS SHALL BE COVERED, TURNED AND OR LAID FLAT SO AS THE MOTORING PUBLIC CAN NOT READ THESE SIGNS.
  3. PAYMENT FOR TEMPORARY CONSTRUCTION SIGNS WILL BE MADE UNDER CONTRACT ITEM NO. 641.10 - TRAFFIC CONTROL.

SEE NOTE 1

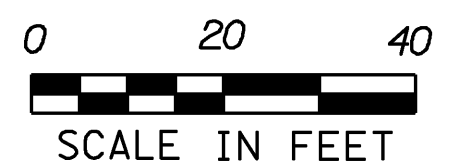

PROJECT NAME:	ESSEX
PROJECT NUMBER:	STP 030-1(20)
FILE NAME:	de206frm.dgn
PROJECT LEADER:	JLS
DESIGNED BY:	CAA/MBL
<b>TRAFFIC CONTROL PLAN 1</b>	
PLOT DATE:	29-APR-2009
DRAWN BY:	MBL
CHECKED BY:	SDM
SHEET	16 OF 27