


13+00

STA. 13+00

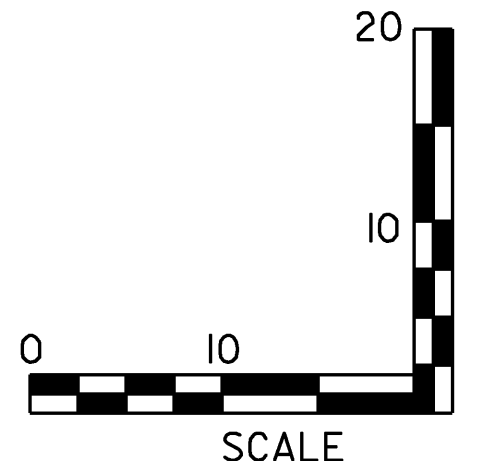

PROJECT NAME: ESSEX	
PROJECT NUMBER: STP 030-I(20)	
FILE NAME: de206xsl.dgn	PLOT DATE: 11-MAY-2009
PROJECT LEADER: JLS	DRAWN BY: MBL
DESIGNED BY: CAA/MBL	CHECKED BY: SDM
<b>CROSS SECTIONS 1</b>	SHEET 19 OF 27