


13+25

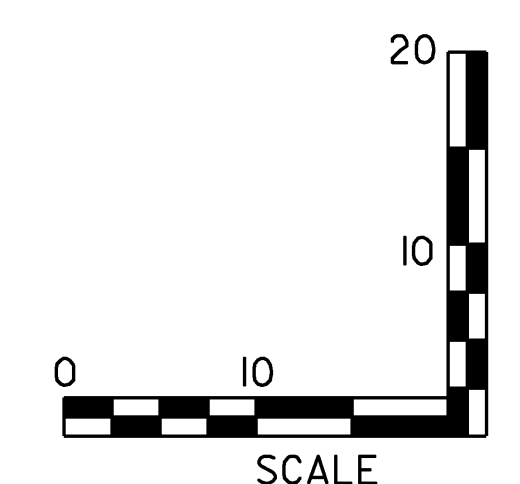

STA. 13+25

PROJECT NAME: ESSEX	PLOT DATE: 11-MAY-2009
PROJECT NUMBER: STP 030-I(20)	DRAWN BY: MBL
FILE NAME: de206xsl.dgn	CHECKED BY: SDM
DESIGNED BY: CAA/MBL	SHEET 20 OF 27
CROSS SECTIONS 2	