


13+50

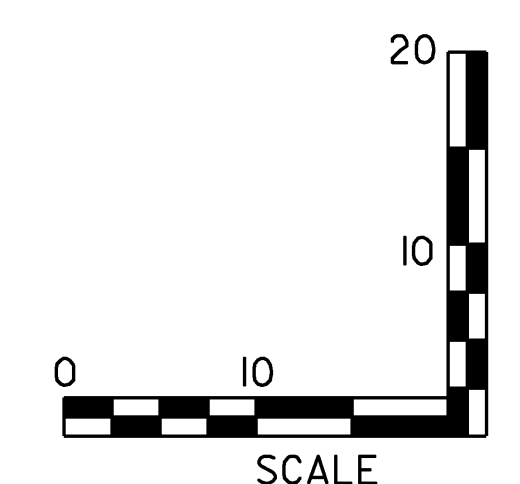

STA. 13+50

PROJECT NAME: ESSEX	PLOT DATE: 11-MAY-2009
PROJECT NUMBER: STP 030-1(20)	DRAWN BY: MBL
FILE NAME: de206xsl.dgn	CHECKED BY: SDM
PROJECT LEADER: JLS	SHEET 21 OF 27
DESIGNED BY: CAA/MBL	
CROSS SECTIONS 3	