


13+75

STA. 13+75

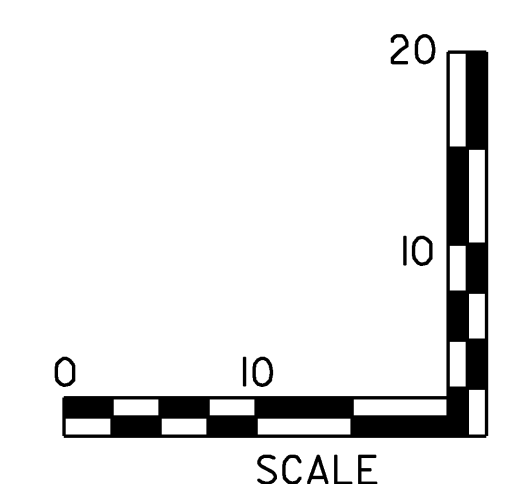

PROJECT NAME: ESSEX	
PROJECT NUMBER: STP 030-1(20)	
FILE NAME: de206xsl.dgn	PLOT DATE: 11-MAY-2009
PROJECT LEADER: JLS	DRAWN BY: MBL
DESIGNED BY: CAA/MBL	CHECKED BY: SDM
<b>CROSS SECTIONS 4</b>	SHEET 22 OF 27