


14+00

STA. 14+00

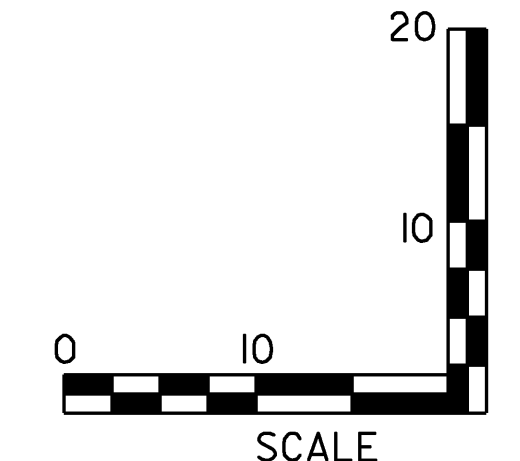

PROJECT NAME: ESSEX	PLOT DATE: 11-MAY-2009
PROJECT NUMBER: STP 030-1(20)	DRAWN BY: MBL
FILE NAME: de206xsl.dgn	CHECKED BY: SDM
DESIGNED BY: CAA/MBL	SHEET 23 OF 27
<b>CROSS SECTIONS 5</b>	