


14+50

STA. 14+50

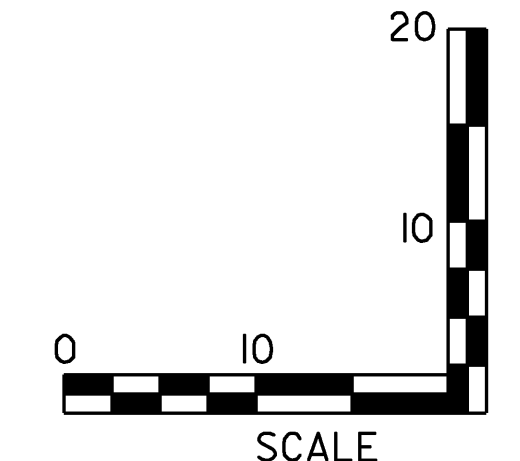

PROJECT NAME: ESSEX	PLOT DATE: 11-MAY-2009
PROJECT NUMBER: STP 030-I(20)	DRAWN BY: MBL
FILE NAME: de206xsl.dgn	CHECKED BY: SDM
DESIGNED BY: CAA/MBL	SHEET 25 OF 27
CROSS SECTIONS 7	