


SECTIONS NOT USED
SEE BASE LINE SECTIONS

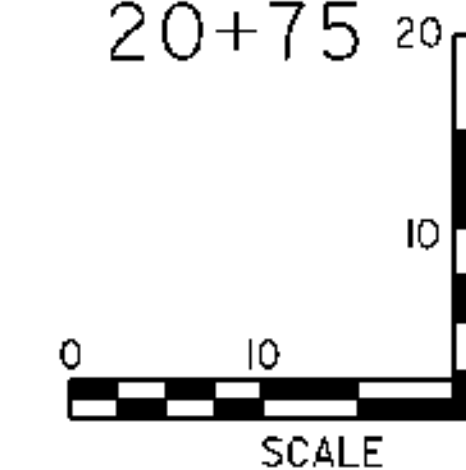

PROJECT NAME: ESSEX		PLOT DATE: 11-MAY-2009	
PROJECT NUMBER: STP 030-1(20)		DRAWN BY: MBL	
FILE NAME: d0206xsl.dgn	DESIGNED BY: CAA/MBL	CHECKED BY: SDM	SHEET 26 OF 27
PROJECT LEADER: JLS		CROSS SECTIONS 8	

STA. 20+00 TO STA. 21+25