


SECTIONS NOT USED
SEE BASE LINE SECTIONS

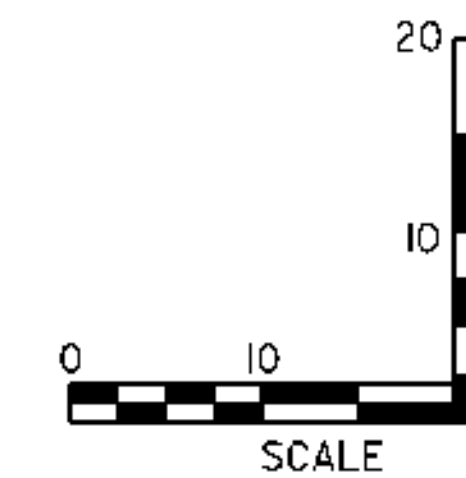

STA. 21+50 TO STA. 21+95	
PROJECT NAME:	ESSEX
PROJECT NUMBER:	STP 030-1(20)
FILE NAME:	d0206xsl.dgn
PROJECT LEADER:	JLS
DESIGNED BY:	CAA/MBL
CROSS SECTIONS 9	
PLOT DATE:	11-MAY-2009
DRAWN BY:	MBL
CHECKED BY:	SDM
SHEET	27 OF 27