



BEGIN PROJECT
 STP 030-2 (22)
 STA. 10+47.23

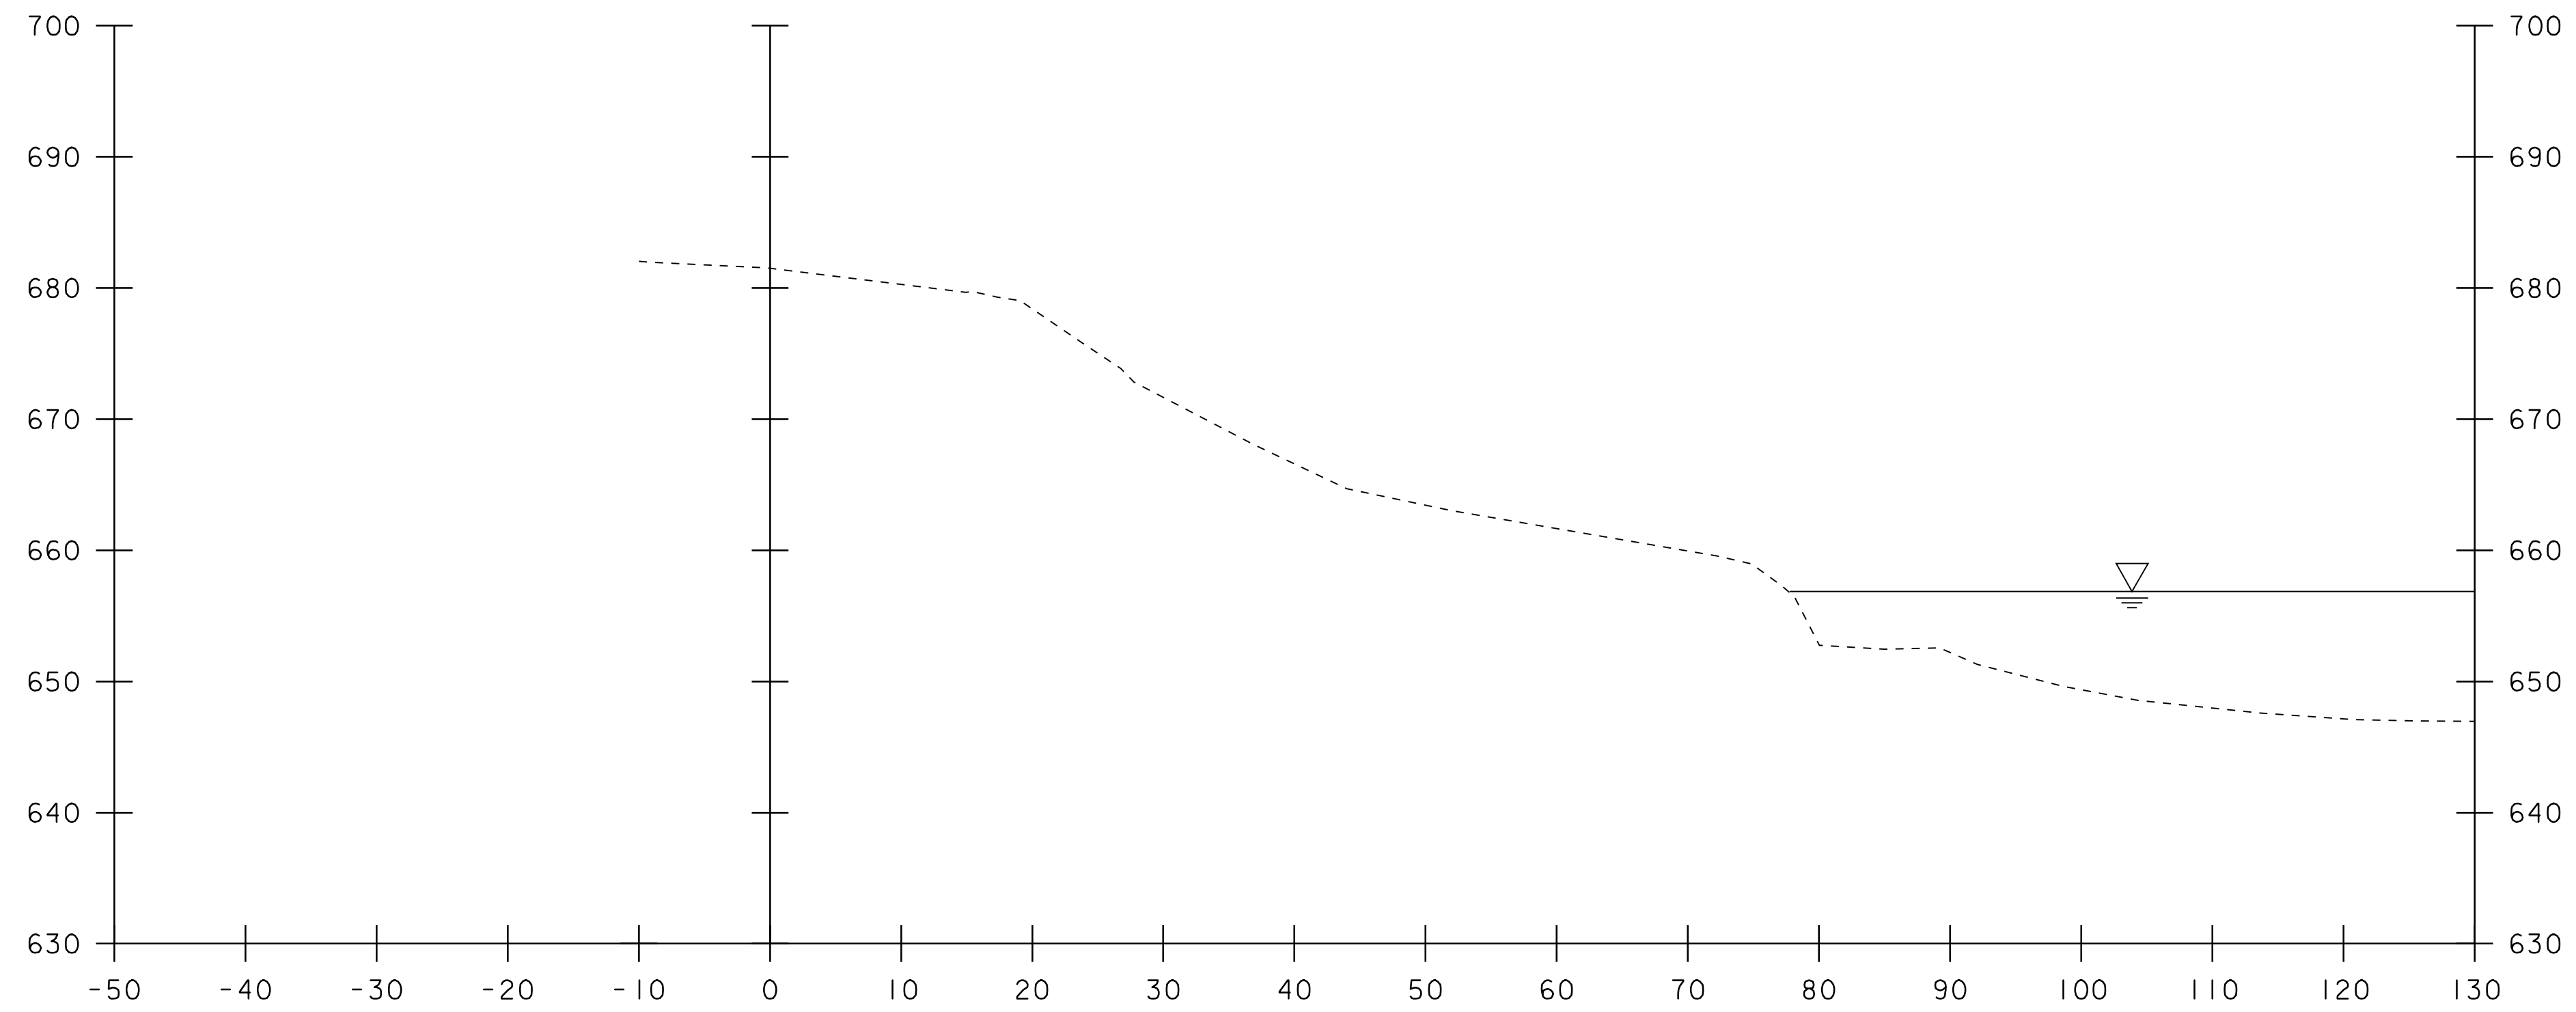

10+25

9+75
 TRENCH EARTH EXC. 0' - 5' = 4.54 SF ✓
 CJJ 12-5-08
 SEH 12-22-08

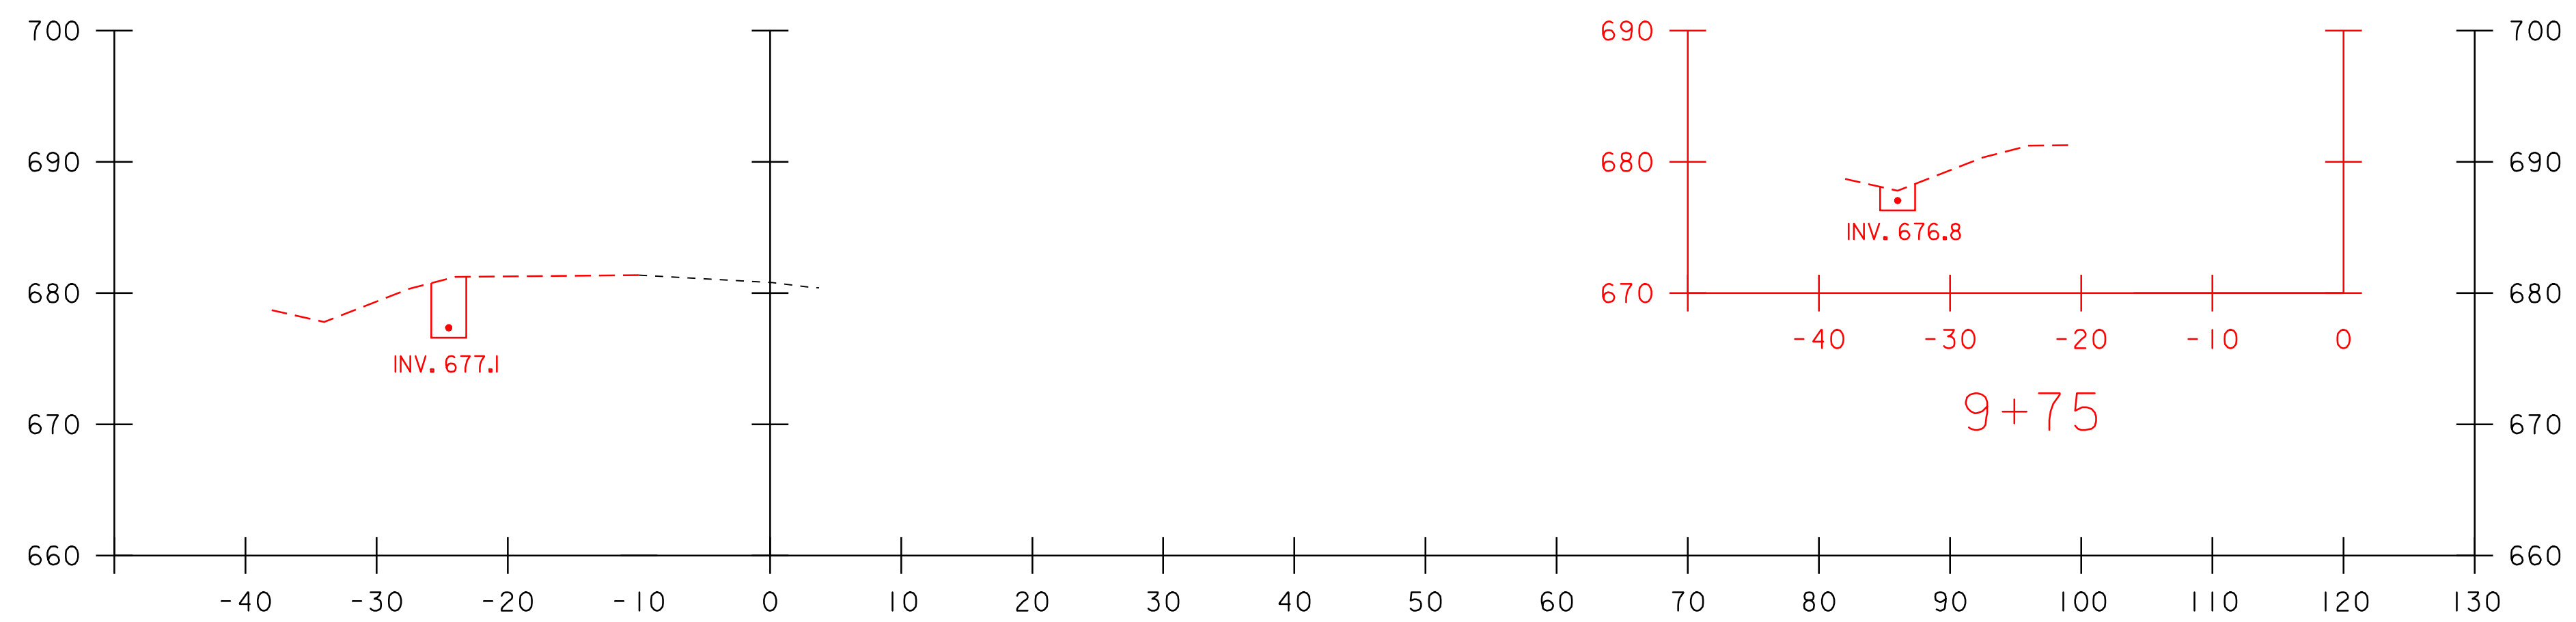

10+00
 TRENCH EARTH EXC. 0' - 5' = 11.91 SF ✓
 CJJ 12-5-08
 SEH 12-22-08

10+00

STA. 10+00 TO STA. 10+75

NOTE:
 WATER LEVEL ON CROSS SECTIONS ARE FOR REFERENCING PURPOSES ONLY.



PROJECT NAME: WOLCOTT	PLOT DATE: 26-AUG-2009 16:22
PROJECT NUMBER: STP 030-2(22)	DRAWN BY: MBL
FILE NAME: d07b096xsl.dgn	CHECKED BY: SDM
PROJECT LEADER: JLS	SHEET 15 OF 22
DESIGNED BY: DLG/MBL	
CROSS SECTIONS	