


10+75

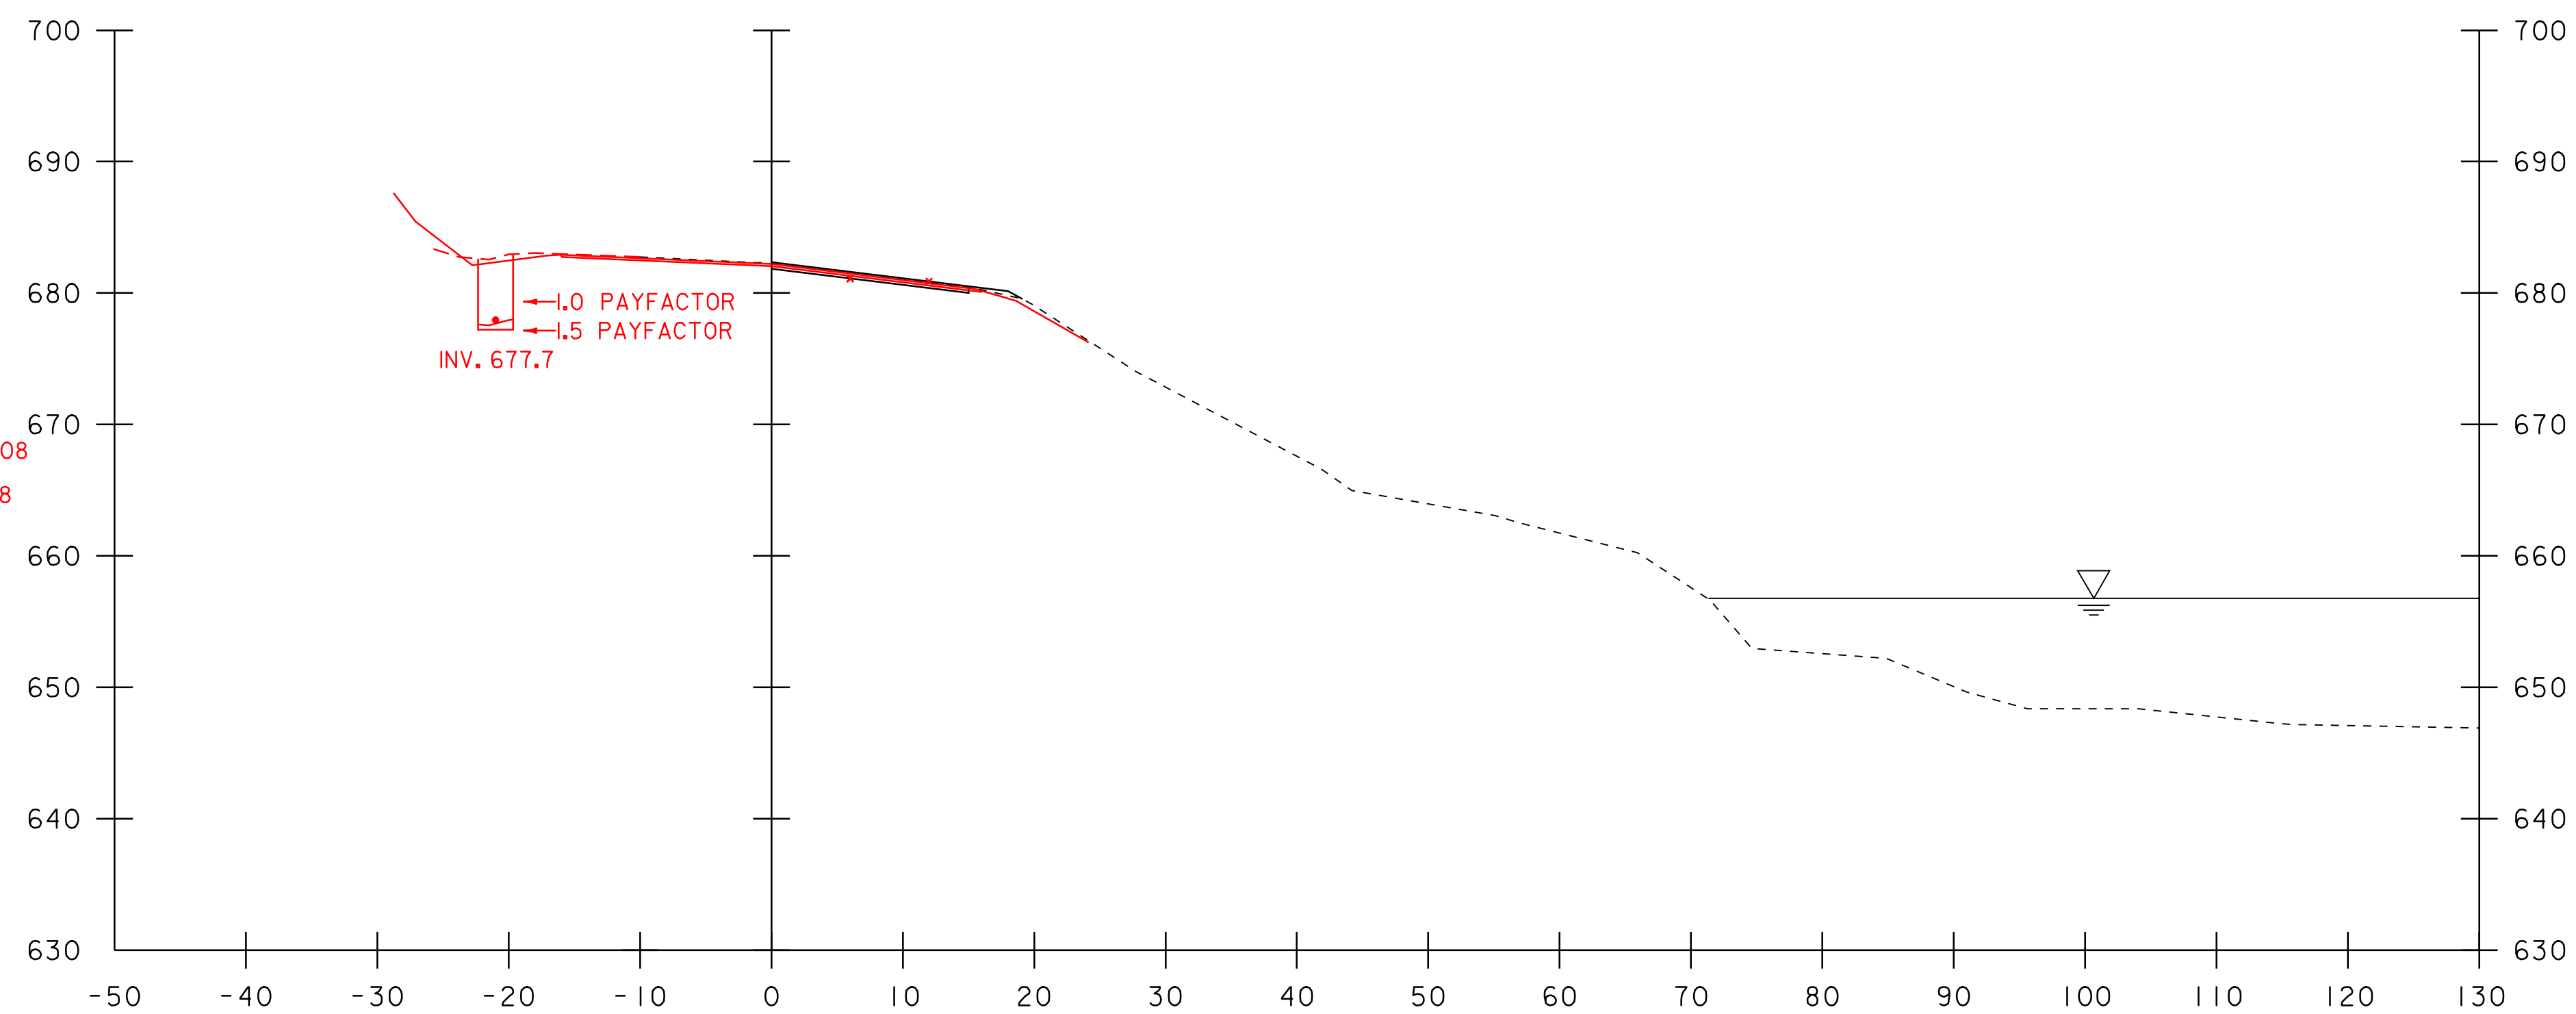

10+50

10+50
 COMMON EXC. = 0.40+0.96+2.25=3.61 SF ✓ SEH 12-17-08
 SUBBASE CR. GRVL. = 0 ✓ SEH 12-17-08
 TRENCH EARTH EXC. 0' - 5' = 13.33 SF ✓ SEH 12-22-08
 TRENCH EARTH EXC. 5' + = 1.37 SF ✓ SEH 12-22-08
 CJJ 12-5-08

STA. 10+00 TO STA. 10+75

PROJECT NAME:	WOLCOTT	PLOT DATE:	26-AUG-2009 16:22
PROJECT NUMBER:	STP 030-2(22)	DRAWN BY:	MBL
FILE NAME:	d07b096xsl.dgn	DESIGNED BY:	DLG/MBL
CROSS SECTIONS		CHECKED BY:	SDM
		SHEET	15, 16 OF 22



NOTE:
 WATER LEVEL ON CROSS SECTIONS ARE FOR REFERENCING PURPOSES ONLY.