


11+25

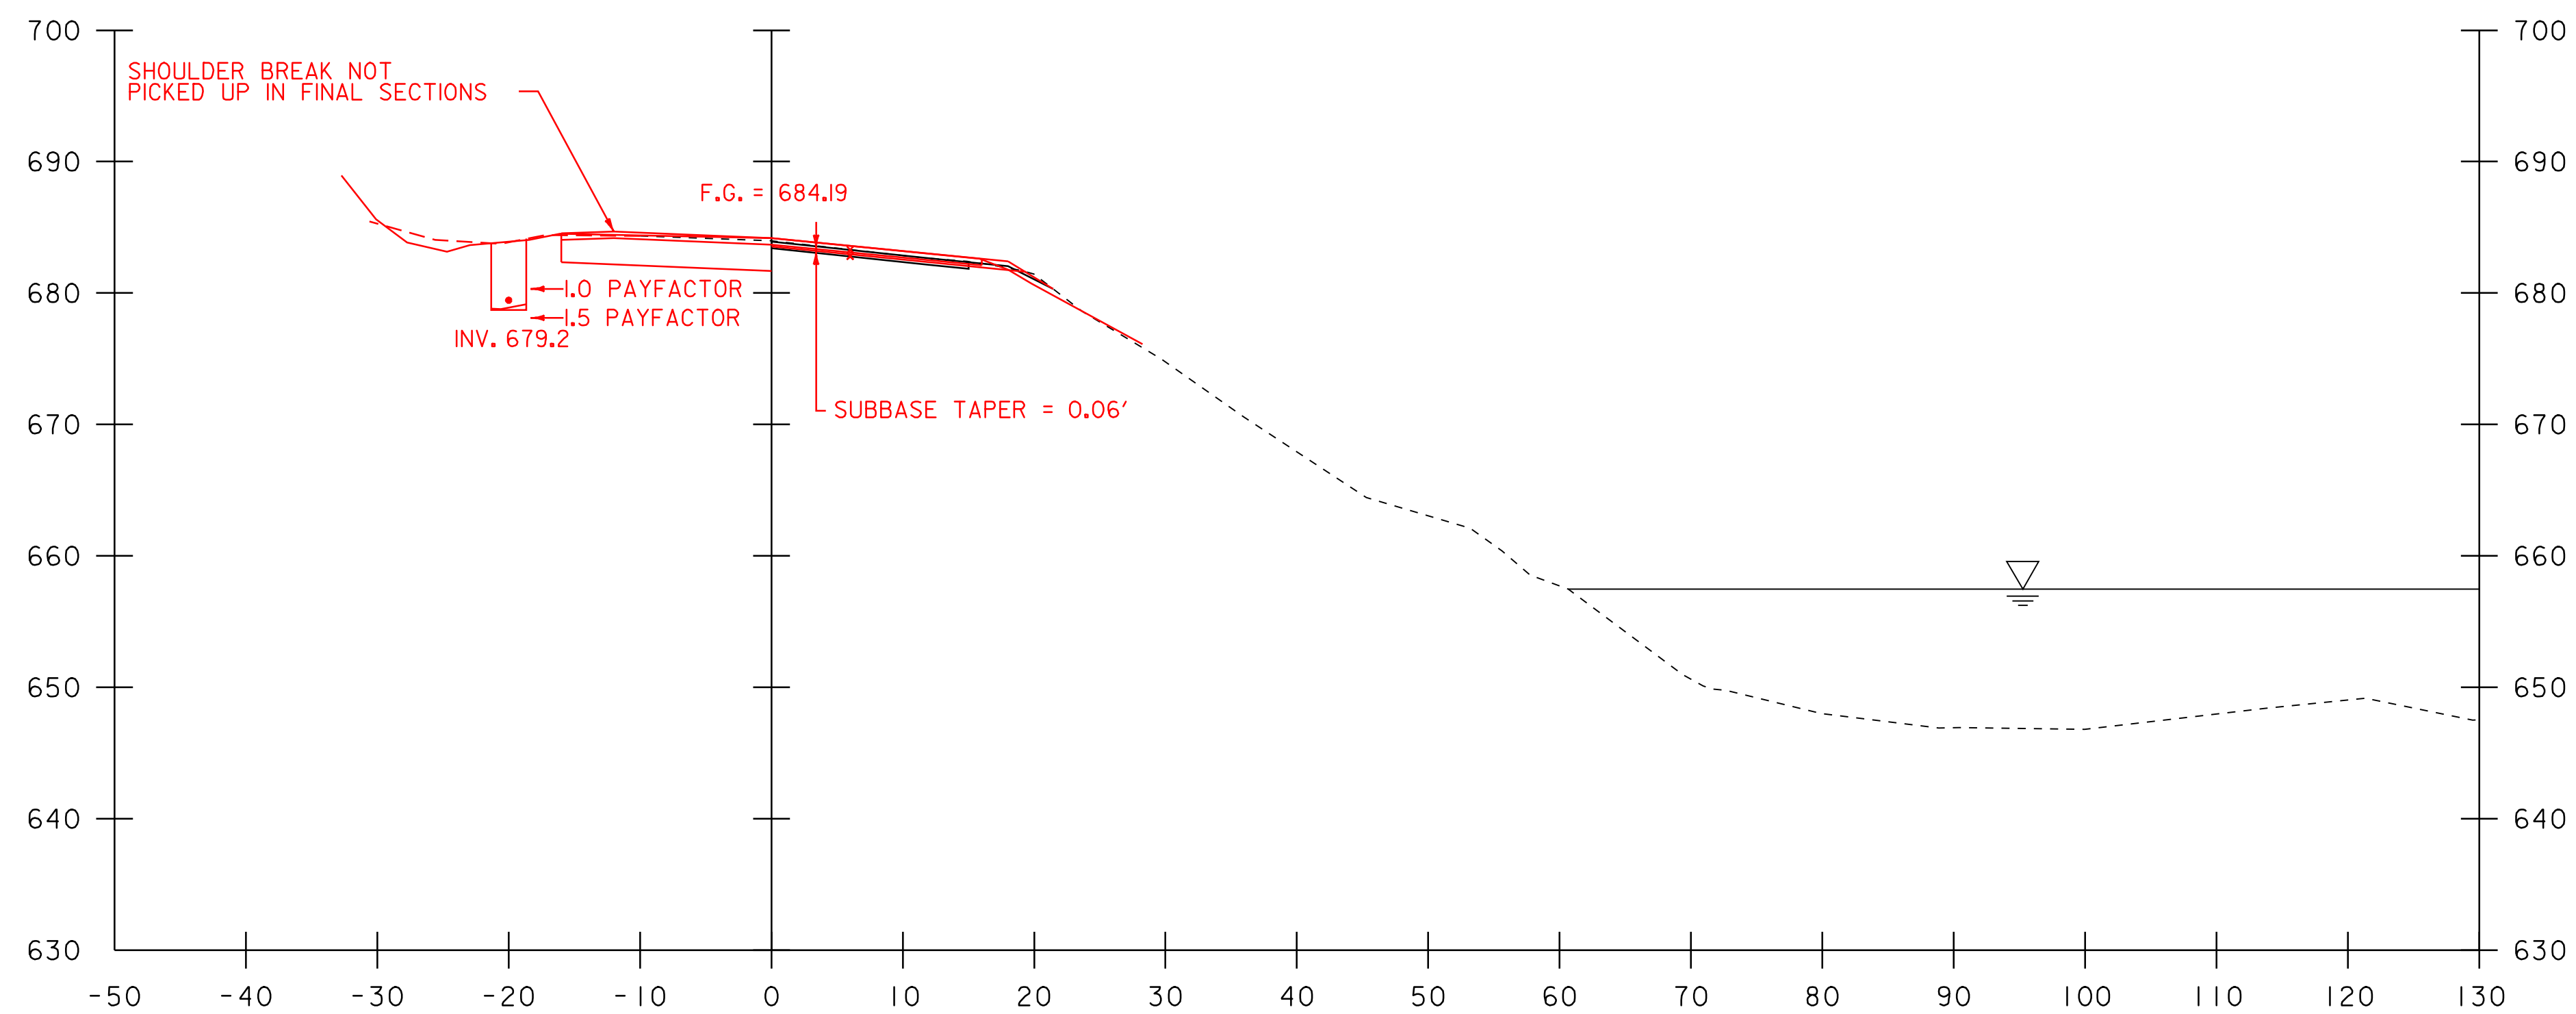

11+00

11+00  
 COMMON EXC. = 4.22+0.22+41.93=46.37 SF ✓ SEH 12-17-08  
 SUBBASE CR. GRVL. = 34.61 SF ✓ SEH 12-17-08  
 TRENCH EARTH EXC. 0' - 5' = 13.33 SF ✓ SEH 12-22-08  
 TRENCH EARTH EXC. 5' + = 0.54 SF ✓ SEH 12-22-08  
 CJJ 12-5-08

11+00  
 GEOTEXTILE FOR ROADBED SEPERATOR LT = 16.01LF ✓  
 CJJ 12-8-08  
 SEH 12-18-08

NOTE:  
 SLOPES ARE RESULTANT BASED  
 ON MAINTAINING CONSTRUCTION  
 LIMITS ON THE EXISTING ROW  
 STA. 11+00 TO STA. 11+75

BEGIN ROW "A"  
 PILE INSTALLATION  
 STA. 11+54.00



PROJECT NAME:	WOLCOTT	FILE NAME:	d07b096xsl.dgn	PLOT DATE:	26-AUG-2009 16:22
PROJECT NUMBER:	STP 030-2(22)	PROJECT LEADER:	JLS	DRAWN BY:	MBL
		DESIGNED BY:	DLG/MBL	CHECKED BY:	SDM
		CROSS SECTIONS		SHEET	16 OF 22

NOTE:  
 WATER LEVEL ON CROSS SECTIONS ARE FOR REFERENCING PURPOSES ONLY.