


11+75

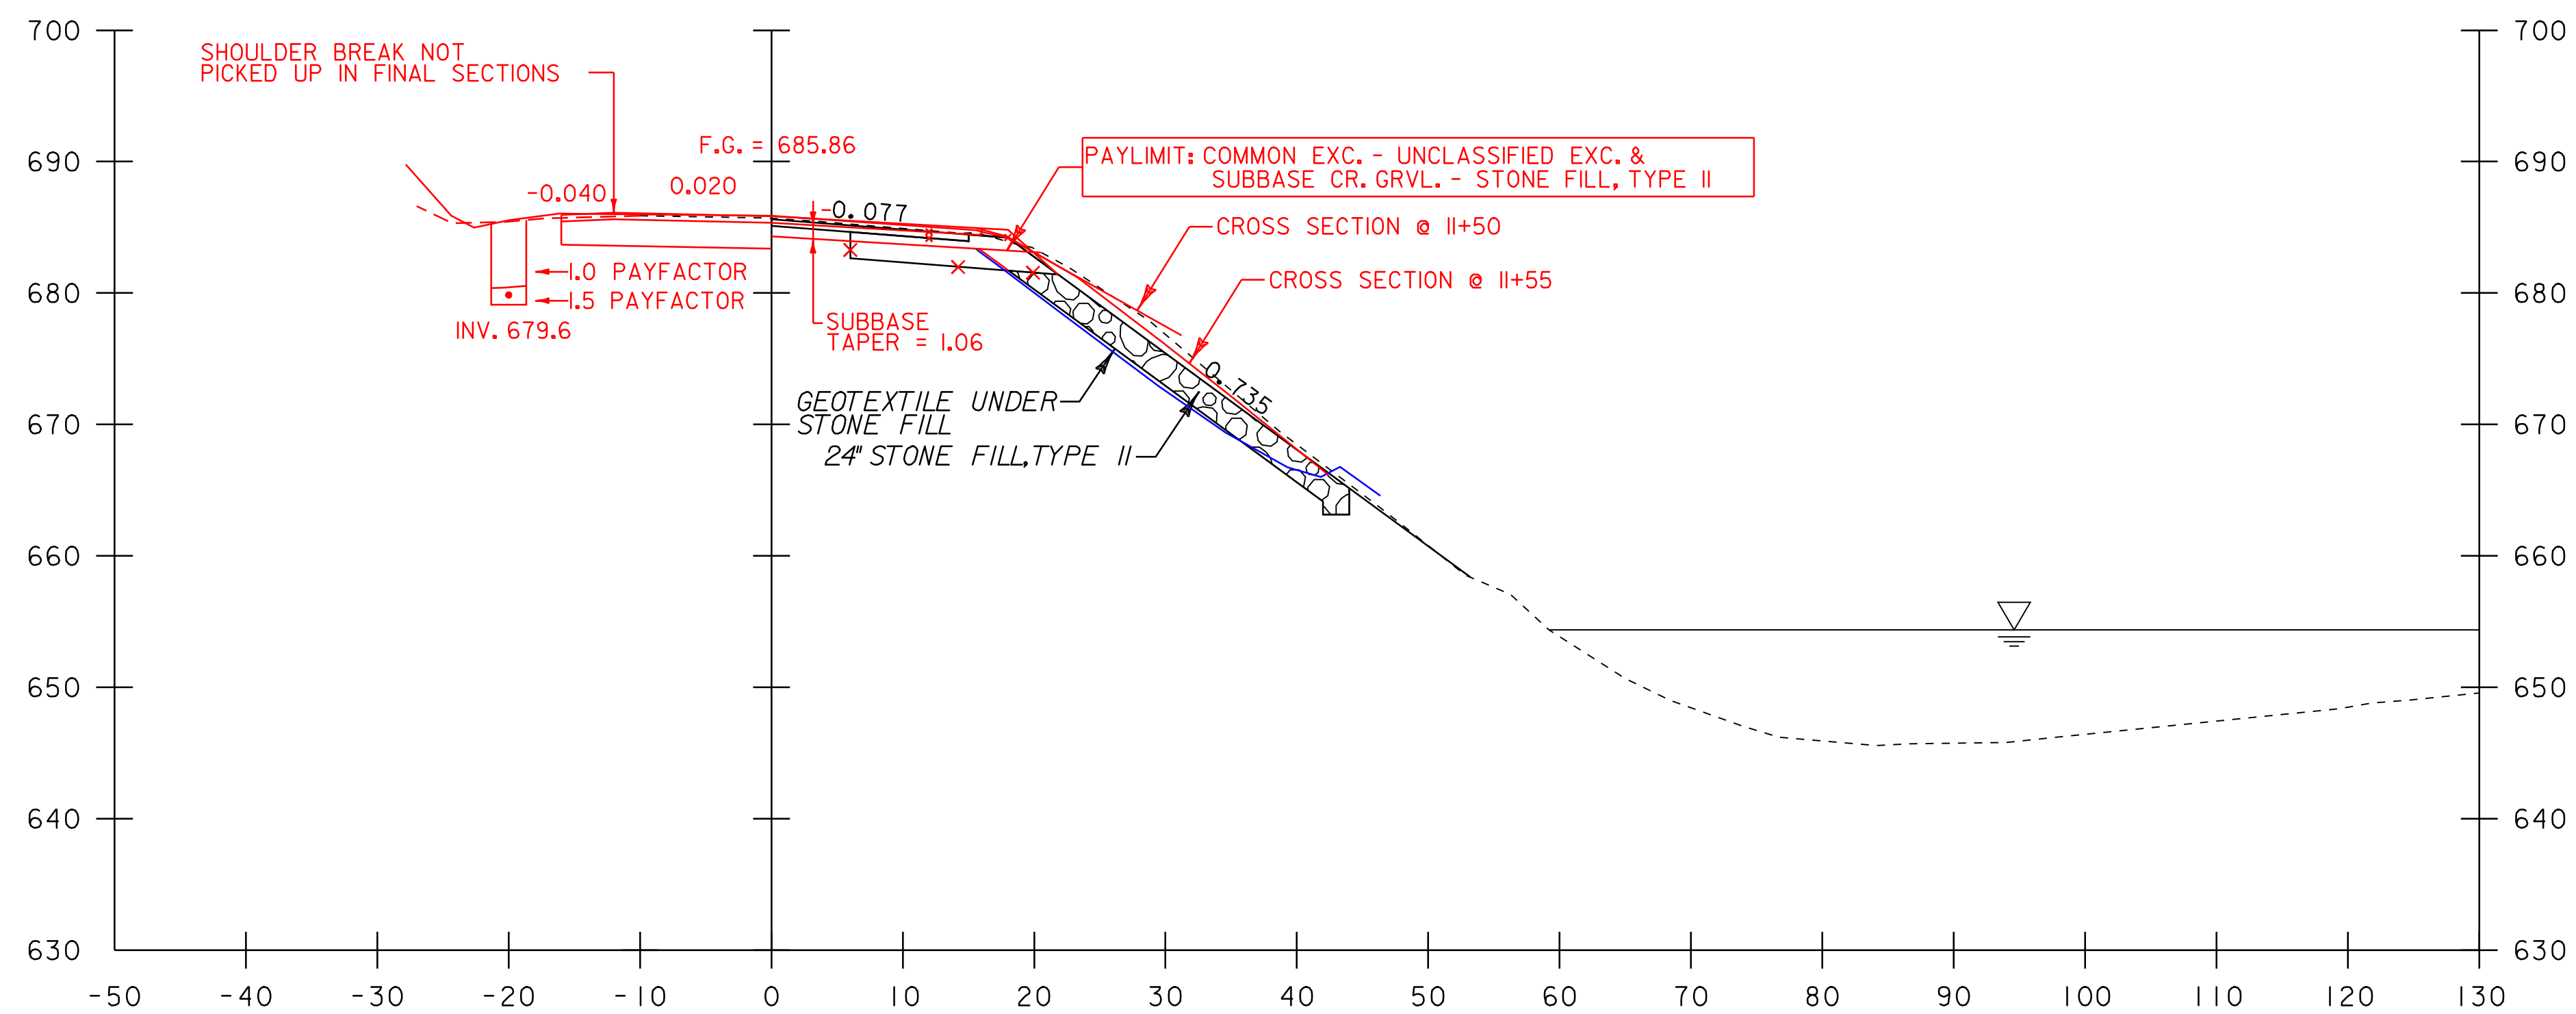

BEGIN ROW "A"
PILE INSTALLATION
STA. 11+54.00

11+50

11+50
COMMON EXC. = 0.44+59.27=59.71 SF ✓ SEH 12-17-08
SUBBASE CR. GRVL. = 0.81+51.66=52.47 SF ✓ SEH 12-17-08
TRENCH EARTH EXC. 0' - 5' = 13.33 SF ✓ SEH 12-22-08
TRENCH EARTH EXC. 5'+ = 3.58 SF ✓ SEH 12-22-08

CJJ 12-5-08

11+50
GEOTEXTILE FOR ROADBED SEPERATOR LT = 16.01 FT ✓
GEOTEXTILE FOR ROADBED SEPERATOR RT = 19.92 FT ✓

CJJ 12-8-08
SEH 12-18-08

NOTE:
SLOPES ARE RESULTANT BASED
ON MAINTAINING CONSTRUCTION
LIMITS ON THE EXISTING ROW

STA. 11+00 TO STA. 11+75

PROJECT NAME: WOLCOTT
PROJECT NUMBER: STP 030-2(22)

FILE NAME: d07b096xsl.dgn
PROJECT LEADER: JLS
DESIGNED BY: DLG/MBL
CROSS SECTIONS

PLOT DATE: 26-AUG-2009 16:22
DRAWN BY: MBL
CHECKED BY: SDM
SHEET 16 OF 22



NOTE:
WATER LEVEL ON CROSS SECTIONS ARE FOR REFERENCING PURPOSES ONLY.