


12+25

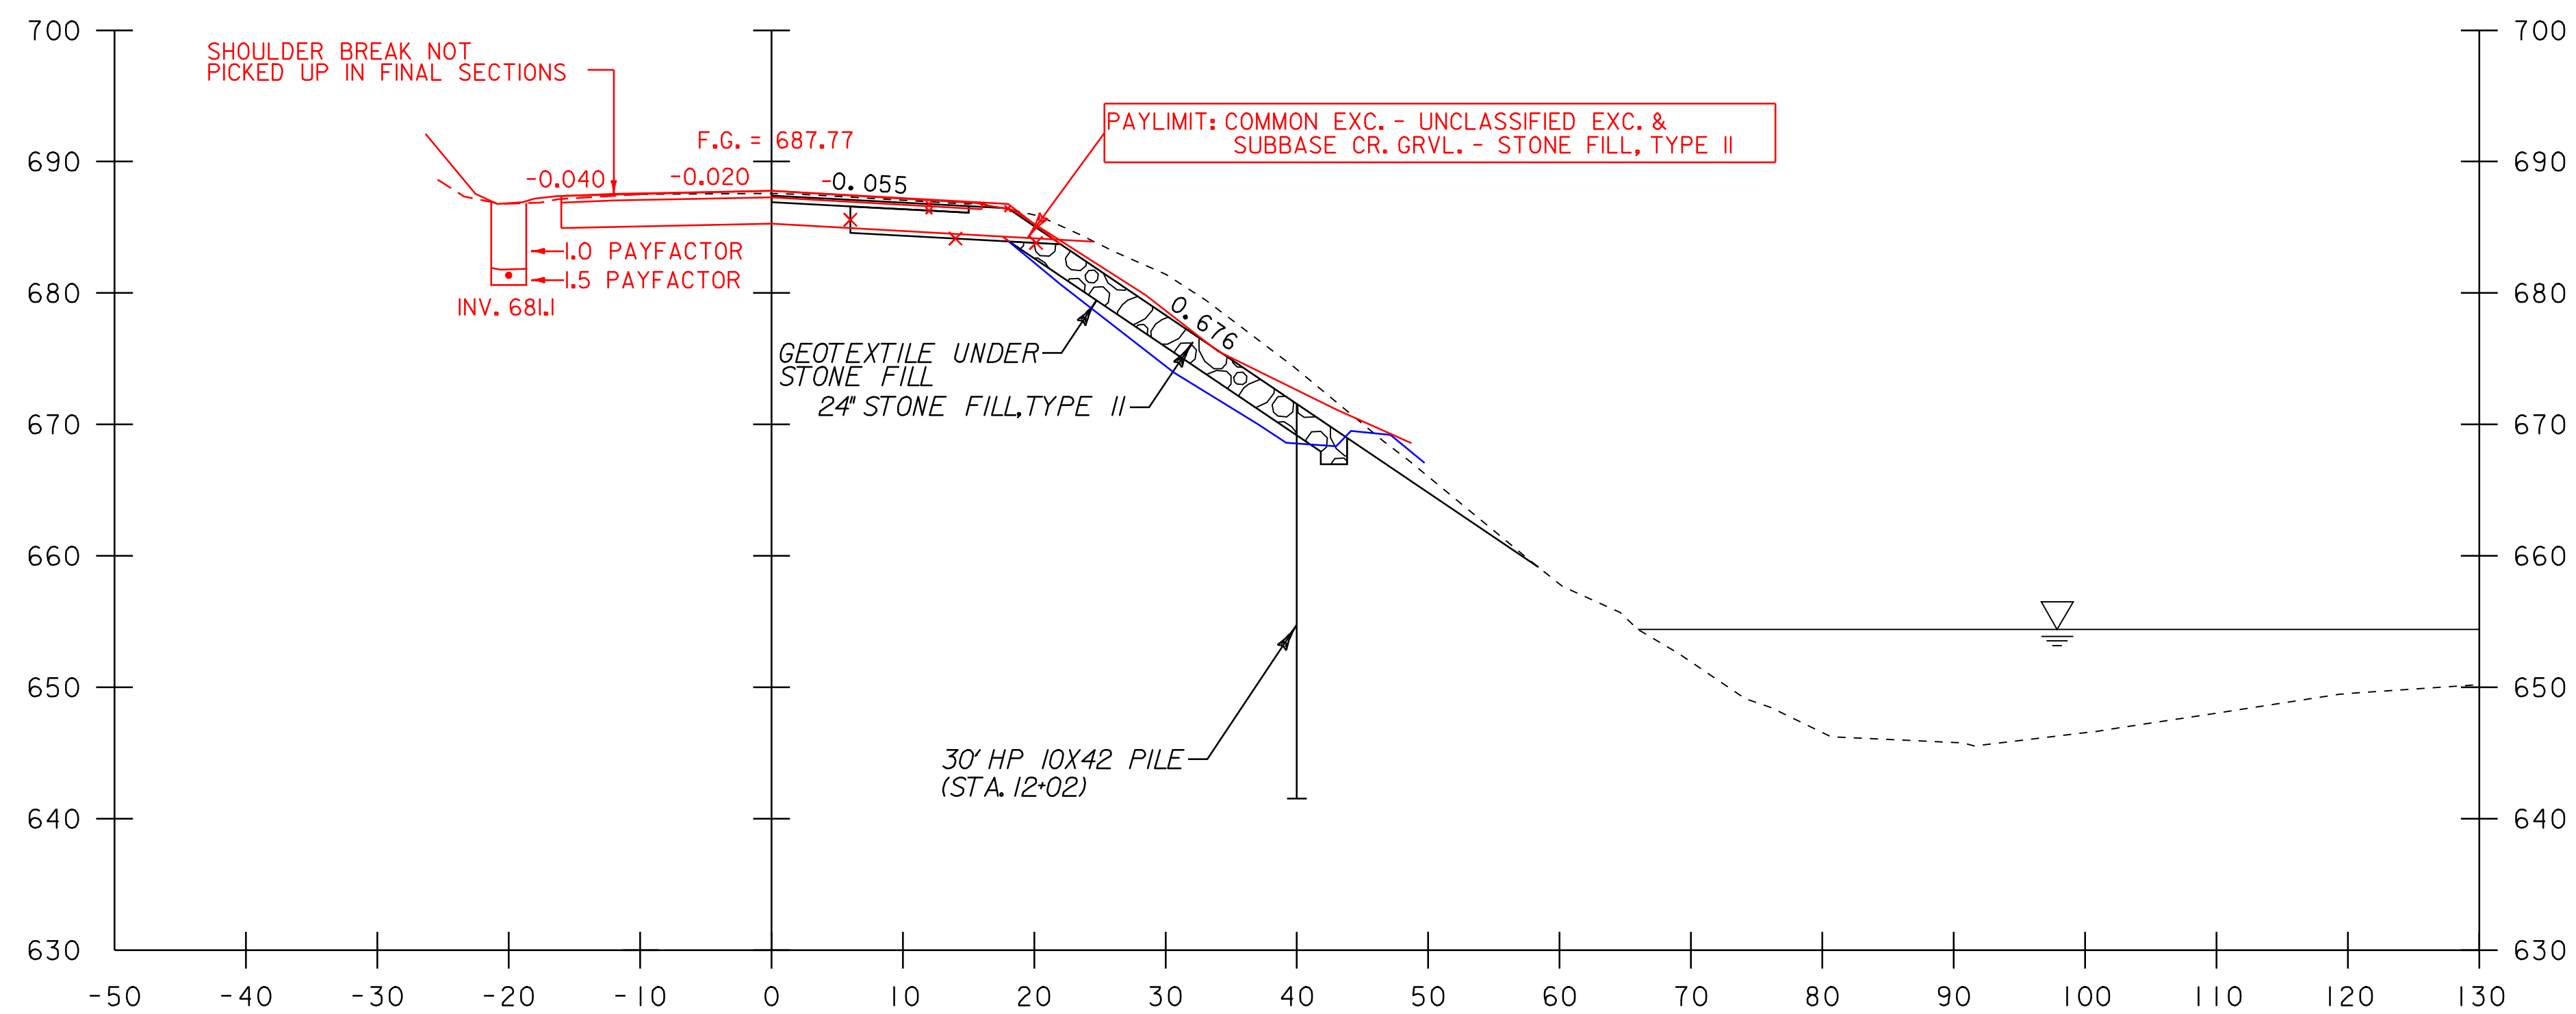

12+00

12+00  
 COMMON EXC. = 87.81 SF ✓ SEH 12-17-08  
 SUBBASE CR. GRVL. = 0.83+72.48=73.31 SF ✓ SEH 12-17-08  
 TRENCH EARTH EXC. 0'-5' = 13.33 SF ✓ SEH 12-22-08  
 TRENCH EARTH EXC. 5'+ = 3.27 SF ✓ SEH 12-22-08  
 CJJ 12-5-08

12+00  
 GEOTEXTILE FOR ROADBED SEPERATOR LT = 16.00 FT ✓  
 GEOTEXTILE FOR ROADBED SEPERATOR RT = 21.56 FT ✓  
 CJJ 12-8-08  
 SEH 12-18-08

SHOULDER BREAK NOT  
 PICKED UP IN FINAL SECTIONS

F.G. = 687.77

-0.040 -0.020 -0.055

1.0 PAYFACTOR  
 1.5 PAYFACTOR

INV. 681.1

PAYLIMIT: COMMON EXC. - UNCLASSIFIED EXC. &  
 SUBBASE CR. GRVL. - STONE FILL, TYPE II

BEGIN LANE & SHOULDER  
 RECONSTRUCTION  
 STA. 11+97.23

NOTE:  
 WATER LEVEL ON CROSS SECTIONS ARE FOR REFERENCING PURPOSES ONLY.



NOTE:  
 SLOPES ARE RESULTANT BASED  
 ON MAINTAINING CONSTRUCTION  
 LIMITS ON THE EXISTING ROW

STA. 12+00 TO STA. 12+75

|                               |                              |
|-------------------------------|------------------------------|
| PROJECT NAME: WOLCOTT         | PLOT DATE: 26-AUG-2009 16:22 |
| PROJECT NUMBER: STP 030-2(22) | DRAWN BY: MBL                |
| FILE NAME: d07b096xsl.dgn     | CHECKED BY: SDM              |
| PROJECT LEADER: JLS           | CROSS SECTIONS               |
| DESIGNED BY: DLG/MBL          | SHEET 17 OF 22               |