



12+75

BEGIN ROW "B"
PILE INSTALLATION
STA. 12+59.00

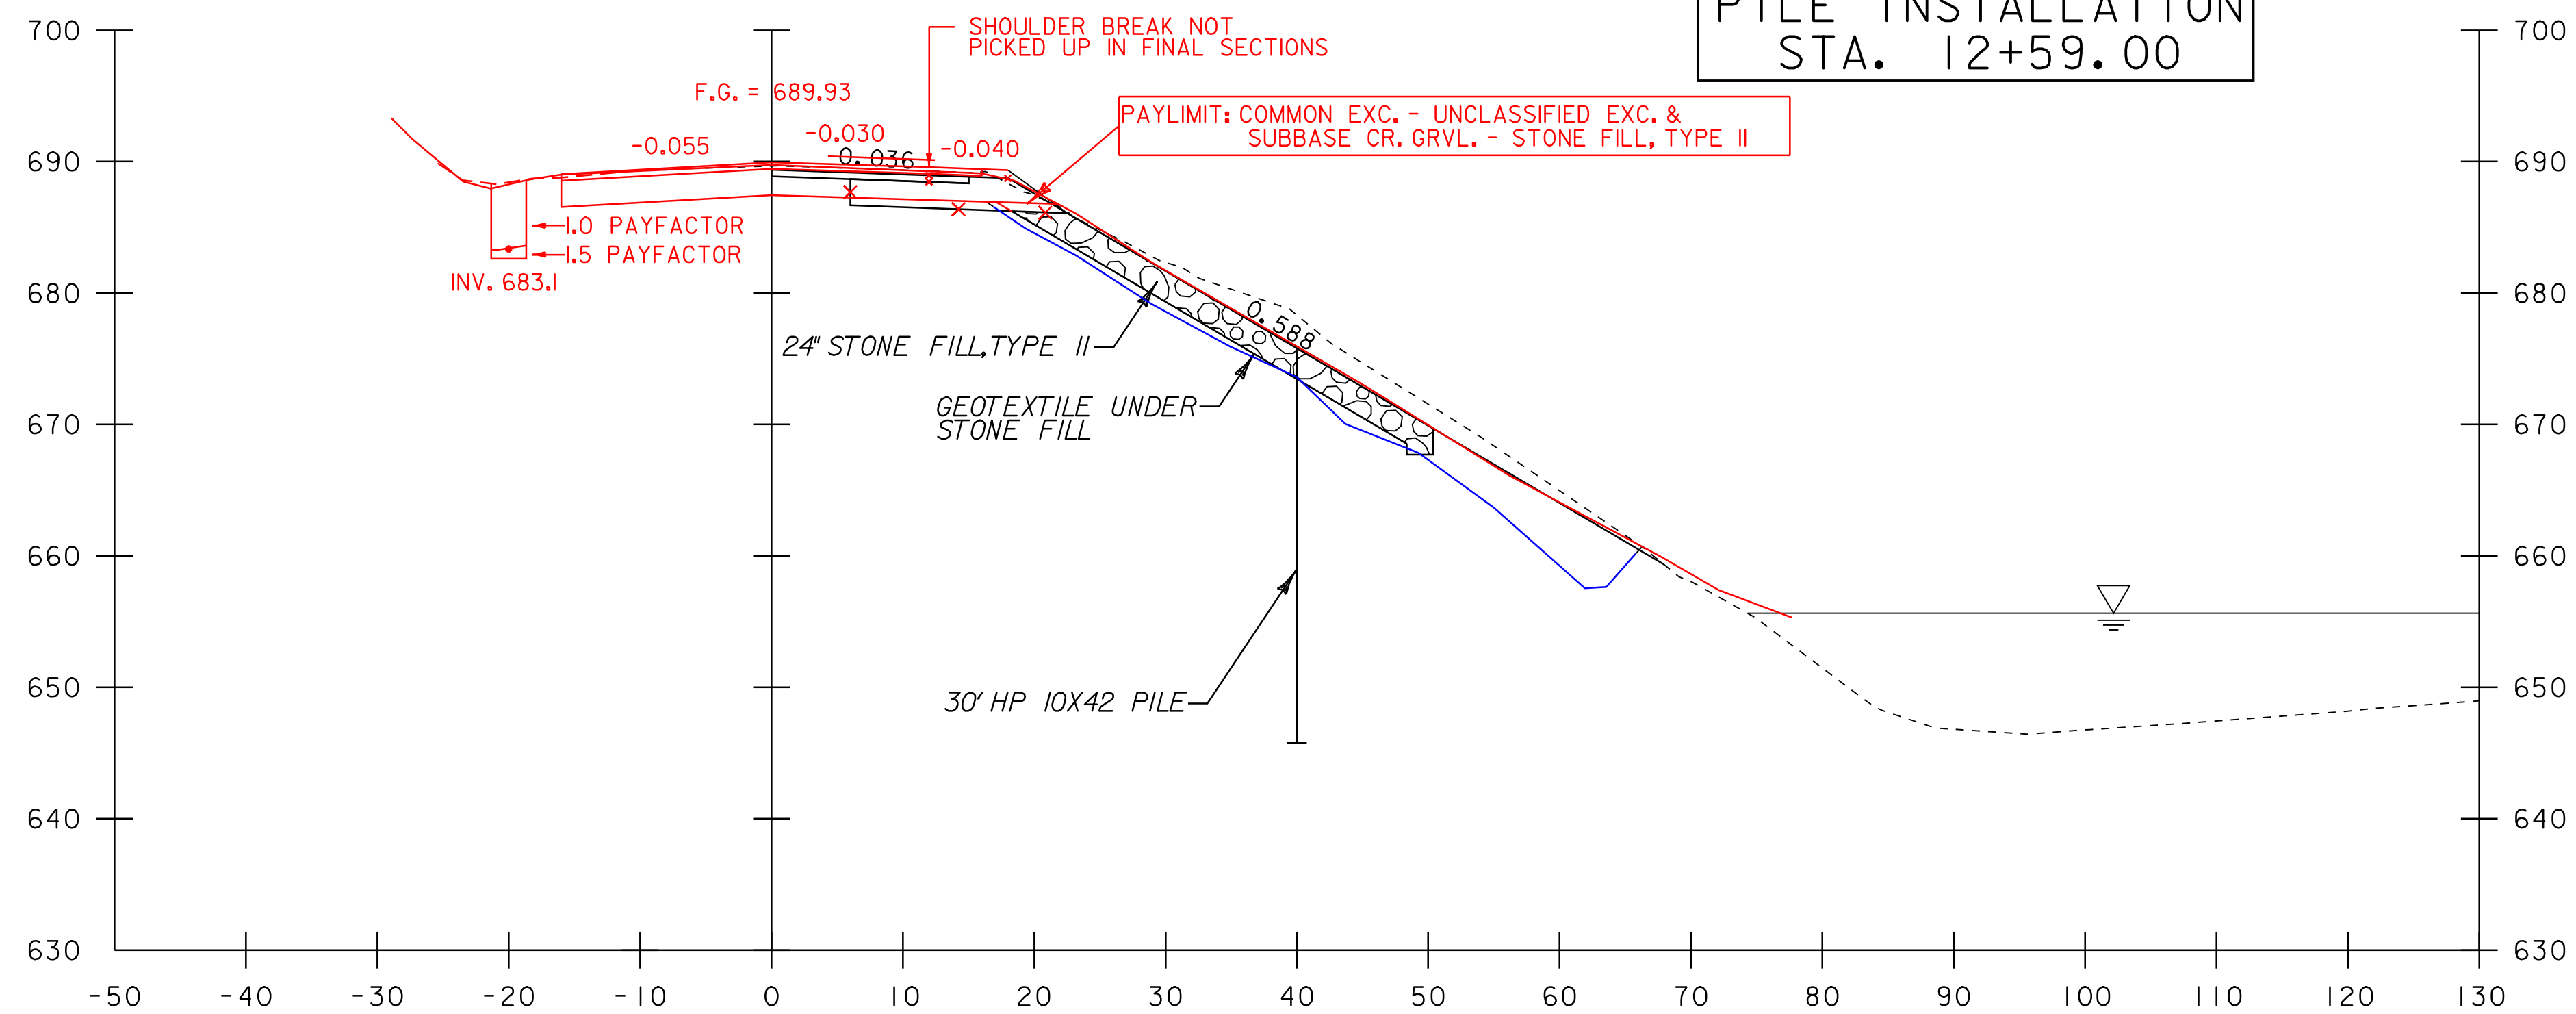

12+50

BEGIN LANE & SHOULDER
RECONSTRUCTION
STA. 11+97.23

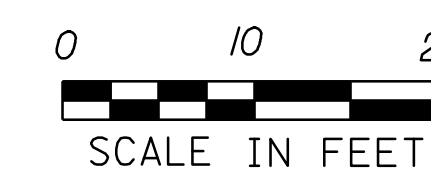

SCALE IN FEET

| | | | |
|-----------------|----------------|----------------|-------------------|
| PROJECT NAME: | WOLCOTT | PLOT DATE: | 26-AUG-2009 16:22 |
| PROJECT NUMBER: | STP 030-2(22) | DRAWN BY: | MBL |
| FILE NAME: | d07b096xsl.dgn | CHECKED BY: | SDM |
| PROJECT LEADER: | JLS | CROSS SECTIONS | SHEET 17 OF 22 |
| DESIGNED BY: | DLG/MBL | | |

12+50
COMMON EXC. = 0.51+79.63+0.02=80.15 SF ✓ SEH 12-17-08
SUBBASE CR. GRVL. = 71.35+0.22=71.57 SF ✓ SEH 12-17-08
TRENCH EARTH EXC. 0' - 5' = 13.33 SF ✓ SEH 12-22-08
TRENCH EARTH EXC. 5' + = 2.20 SF ✓ SEH 12-22-08
CJJ 12-5-08

12+50
GEOTEXTILE FOR ROADBED SEPERATOR LT = 16.02 FT ✓
GEOTEXTILE FOR ROADBED SEPERATOR RT = 21.53 FT ✓
CJJ 12-8-08
SEH 12-18-08

NOTE:
WATER LEVEL ON CROSS SECTIONS ARE FOR REFERENCING PURPOSES ONLY.

NOTE:
SLOPES ARE RESULTANT BASED
ON MAINTAINING CONSTRUCTION
LIMITS ON THE EXISTING ROW
- STA. 12+00 TO STA. 12+75