


13+00
 COMMON EXC. = 36.05 SF ✓ SEH 12-17-08
 SUBBASE CR. GRVL. = 39.43 SF ✓ SEH 12-17-08
 CJJ 12-5-08

13+00
 GEOTEXTILE FOR ROADBED SEPERATOR RT = 21.35 FT ✓
 CJJ 12-8-08
 SEH 12-18-08

NOTE:
 SLOPES ARE RESULTANT BASED
 ON MAINTAINING CONSTRUCTION
 LIMITS ON THE EXISTING ROW
 STA. 13+00 TO STA. 13+25

PROJECT NAME:	WOLCOTT	FILE NAME:	d07b096xsl.dgn	PLOT DATE:	26-AUG-2009 16:22
PROJECT NUMBER:	STP 030-2(22)	PROJECT LEADER:	JLS	DRAWN BY:	MBL
		DESIGNED BY:	DLG/MBL	CHECKED BY:	SDM
		CROSS SECTIONS		SHEET	18, 21 OF 22

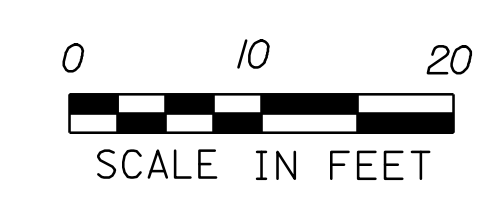

NOTE:
 WATER LEVEL ON CROSS SECTIONS ARE FOR REFERENCING PURPOSES ONLY.