


15+25

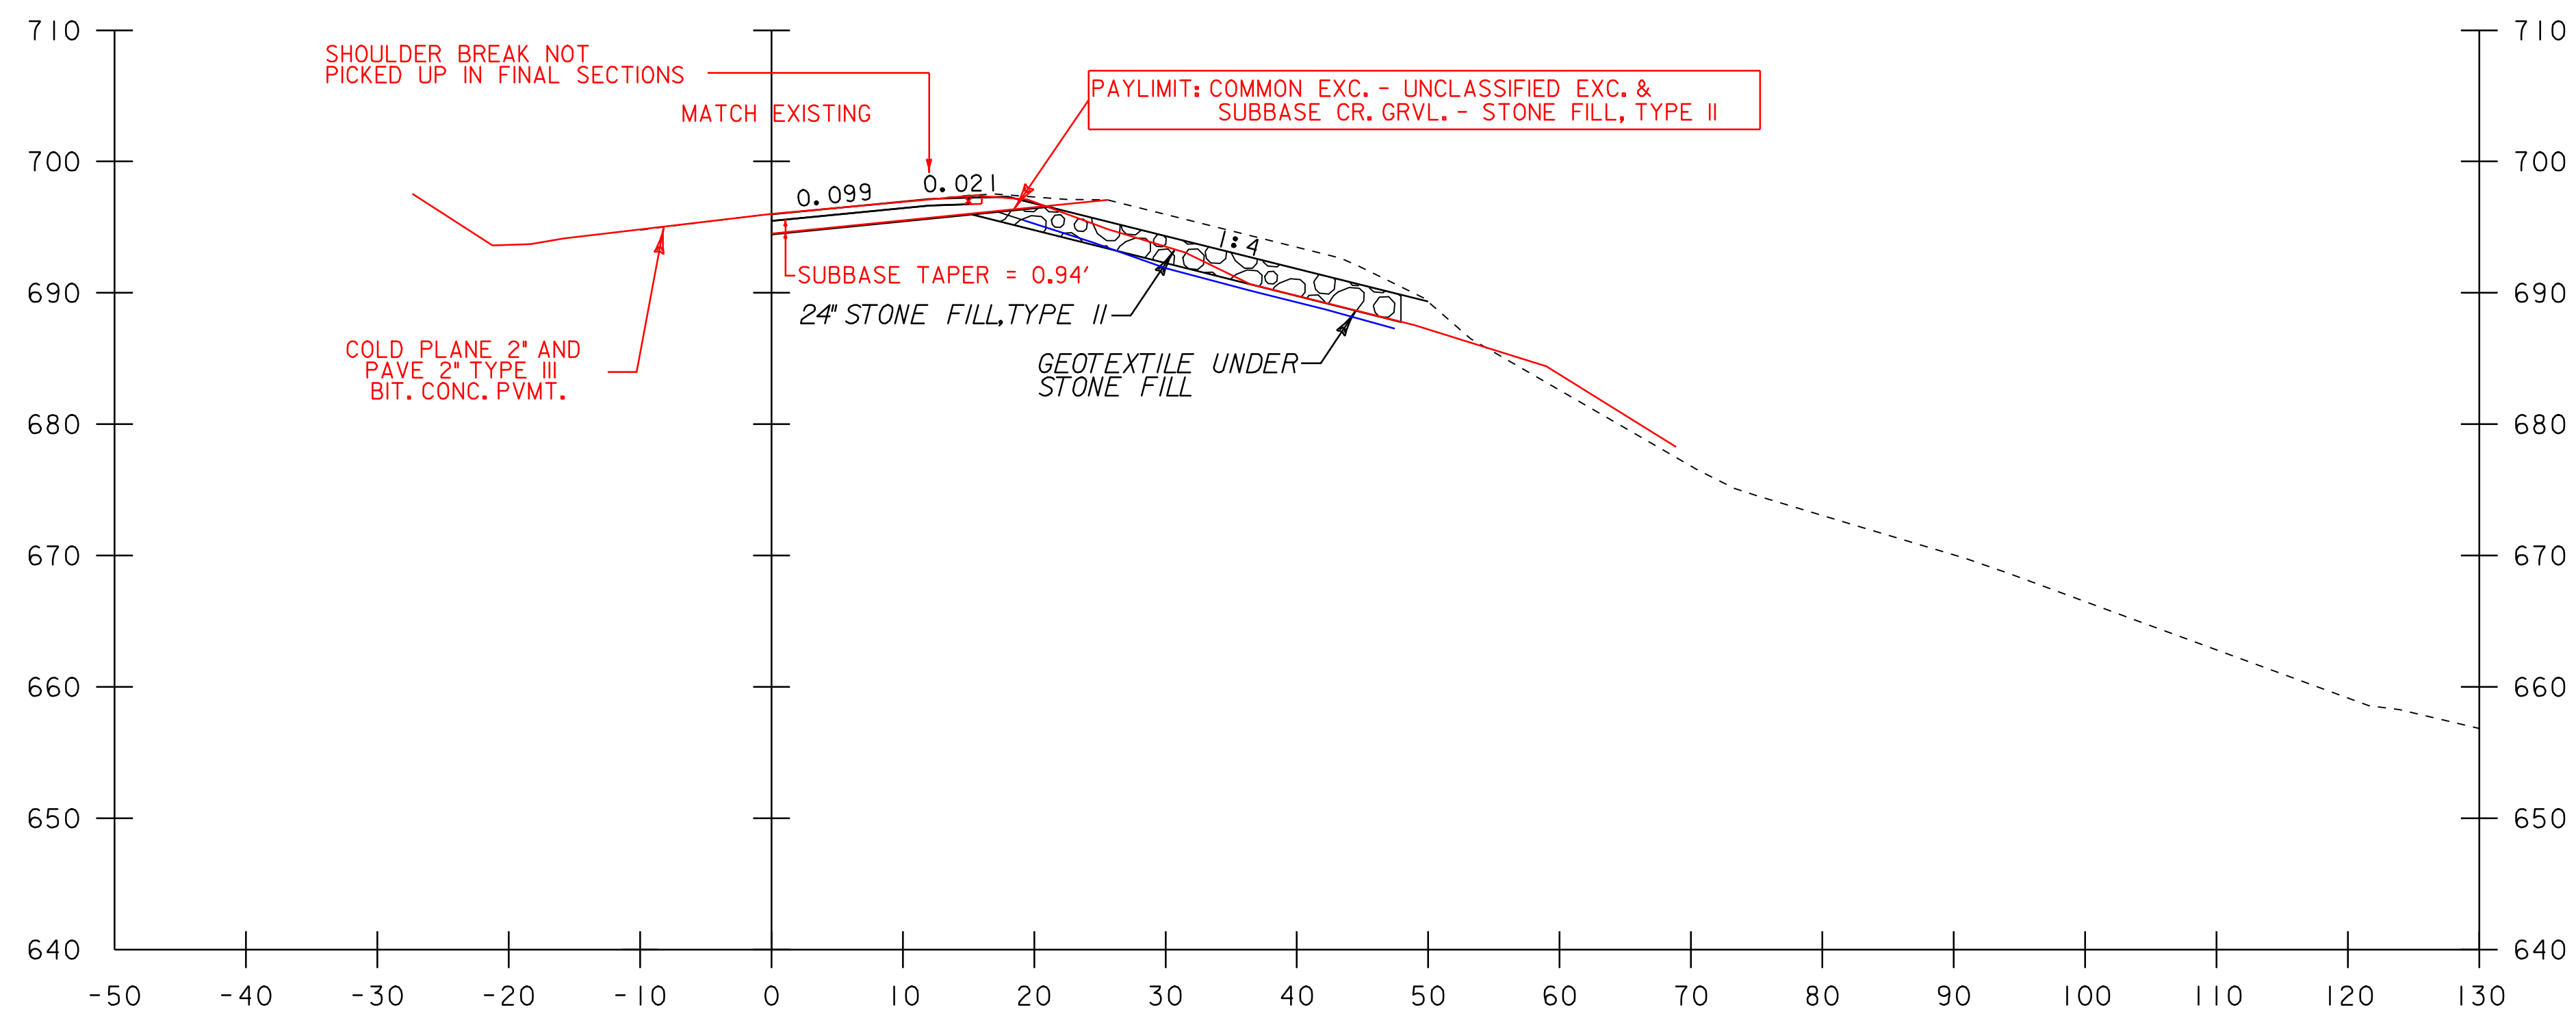

15+00

15+00
COMMON EXC. = 29.40 SF ✓ SEH 12-17-08
SUBBASE CR. GRVL. = 18.04 SF ✓ SEH 12-17-08
CJJ 12-5-08

15+00
GEOTEXTILE FOR ROADBED SEPERATOR RT = 20.99 FT ✓
CJJ 12-8-08
SEH 12-18-08

END LANE & SHOULDER
RECONSTRUCTION
STA. 14+47.18

NOTE:
WATER LEVEL ON CROSS SECTIONS ARE FOR REFERENCING PURPOSES ONLY.



PROJECT NAME: WOLCOTT
PROJECT NUMBER: STP 030-2(22)

FILE NAME: d07b096xsl.dgn
PROJECT LEADER: JLS
DESIGNED BY: DLG/MBL
CROSS SECTIONS

NOTE:
SLOPES ARE RESULTANT BASED
ON MAINTAINING CONSTRUCTION
LIMITS ON THE EXISTING ROW

STA. 14+50 TO STA. 15+25

PLOT DATE: 26-AUG-2009 16:22
DRAWN BY: MBL
CHECKED BY: SDM
SHEET 28 OF 22

RIVER = 143.04' RT

RIVER = 131.20' RT