



END PROJECT
 STP 030-2 (22)
 STA. 15+97.18

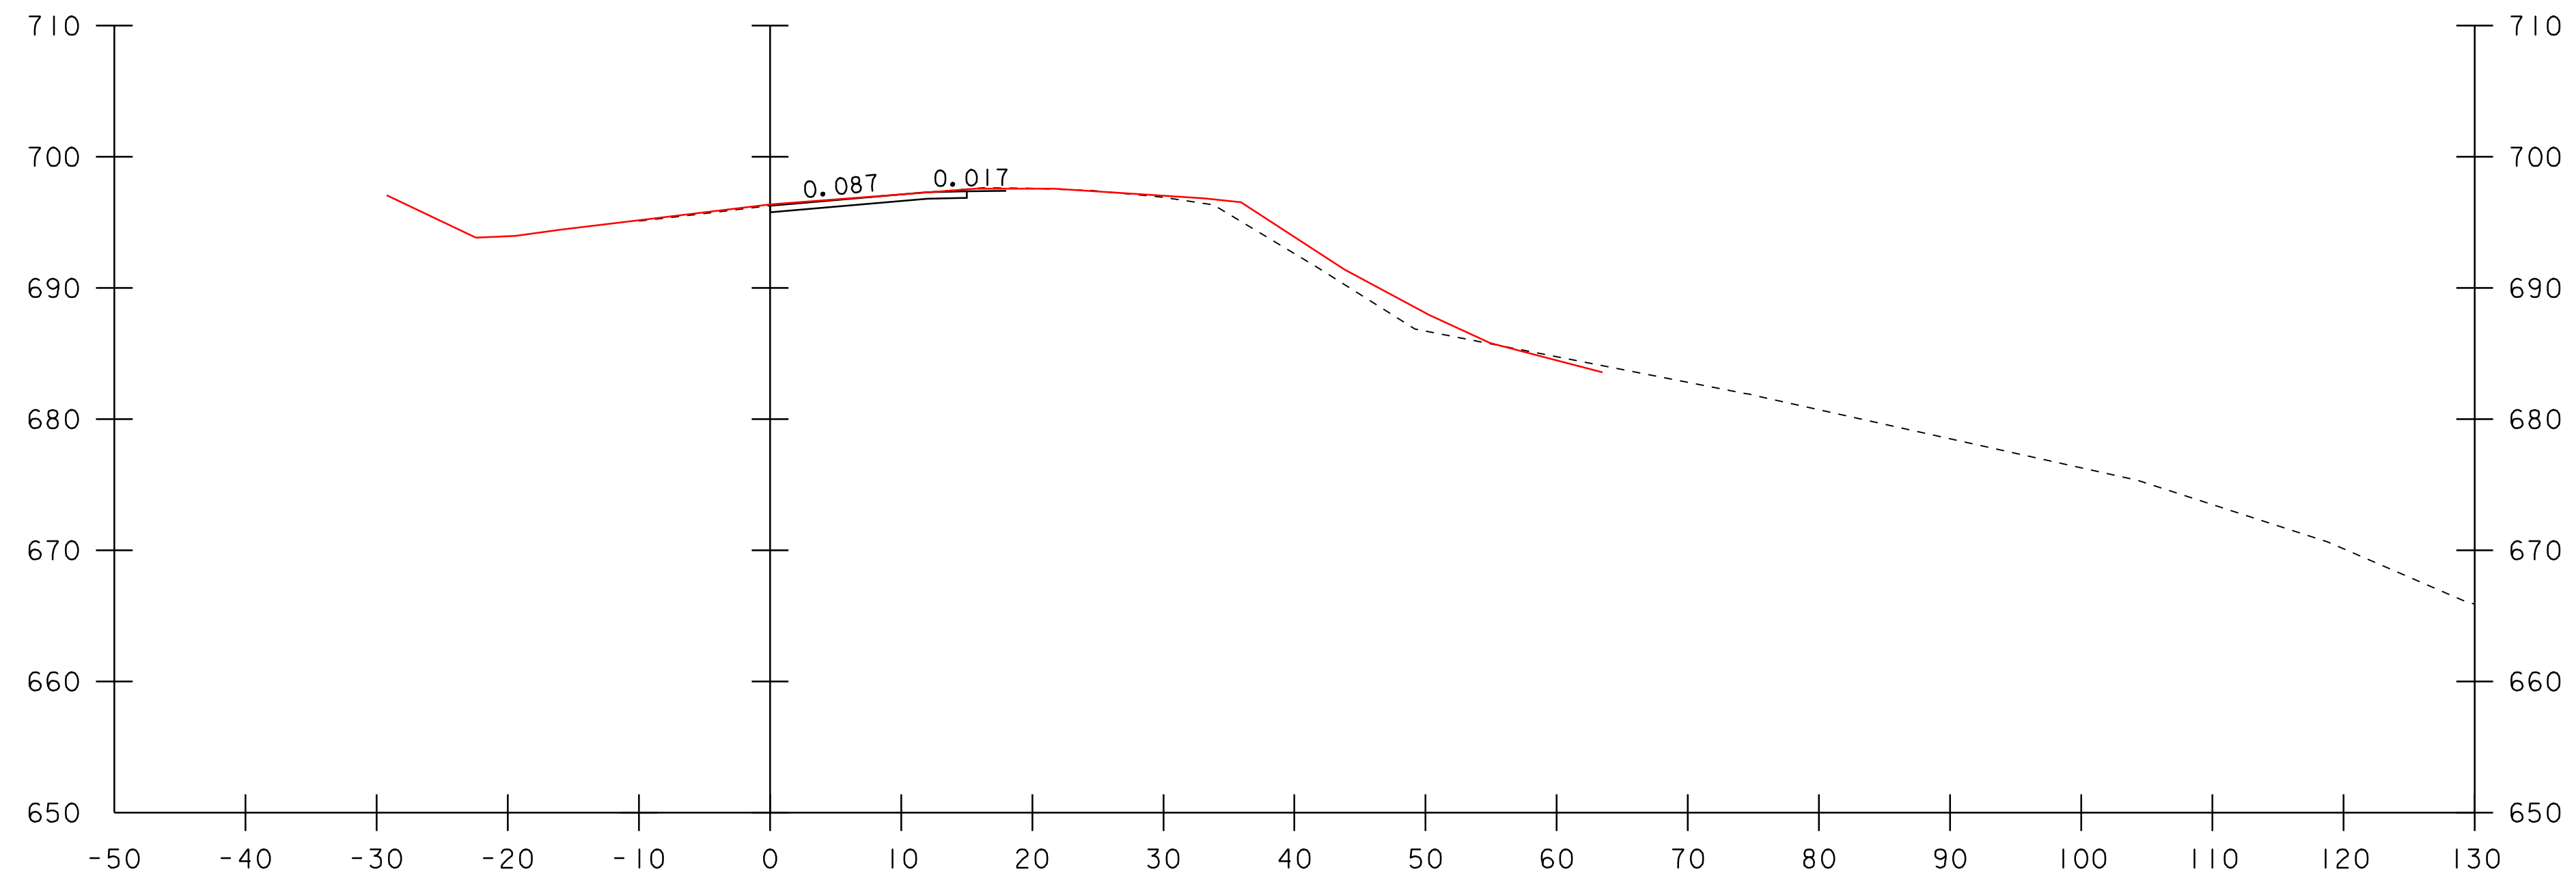

15+75

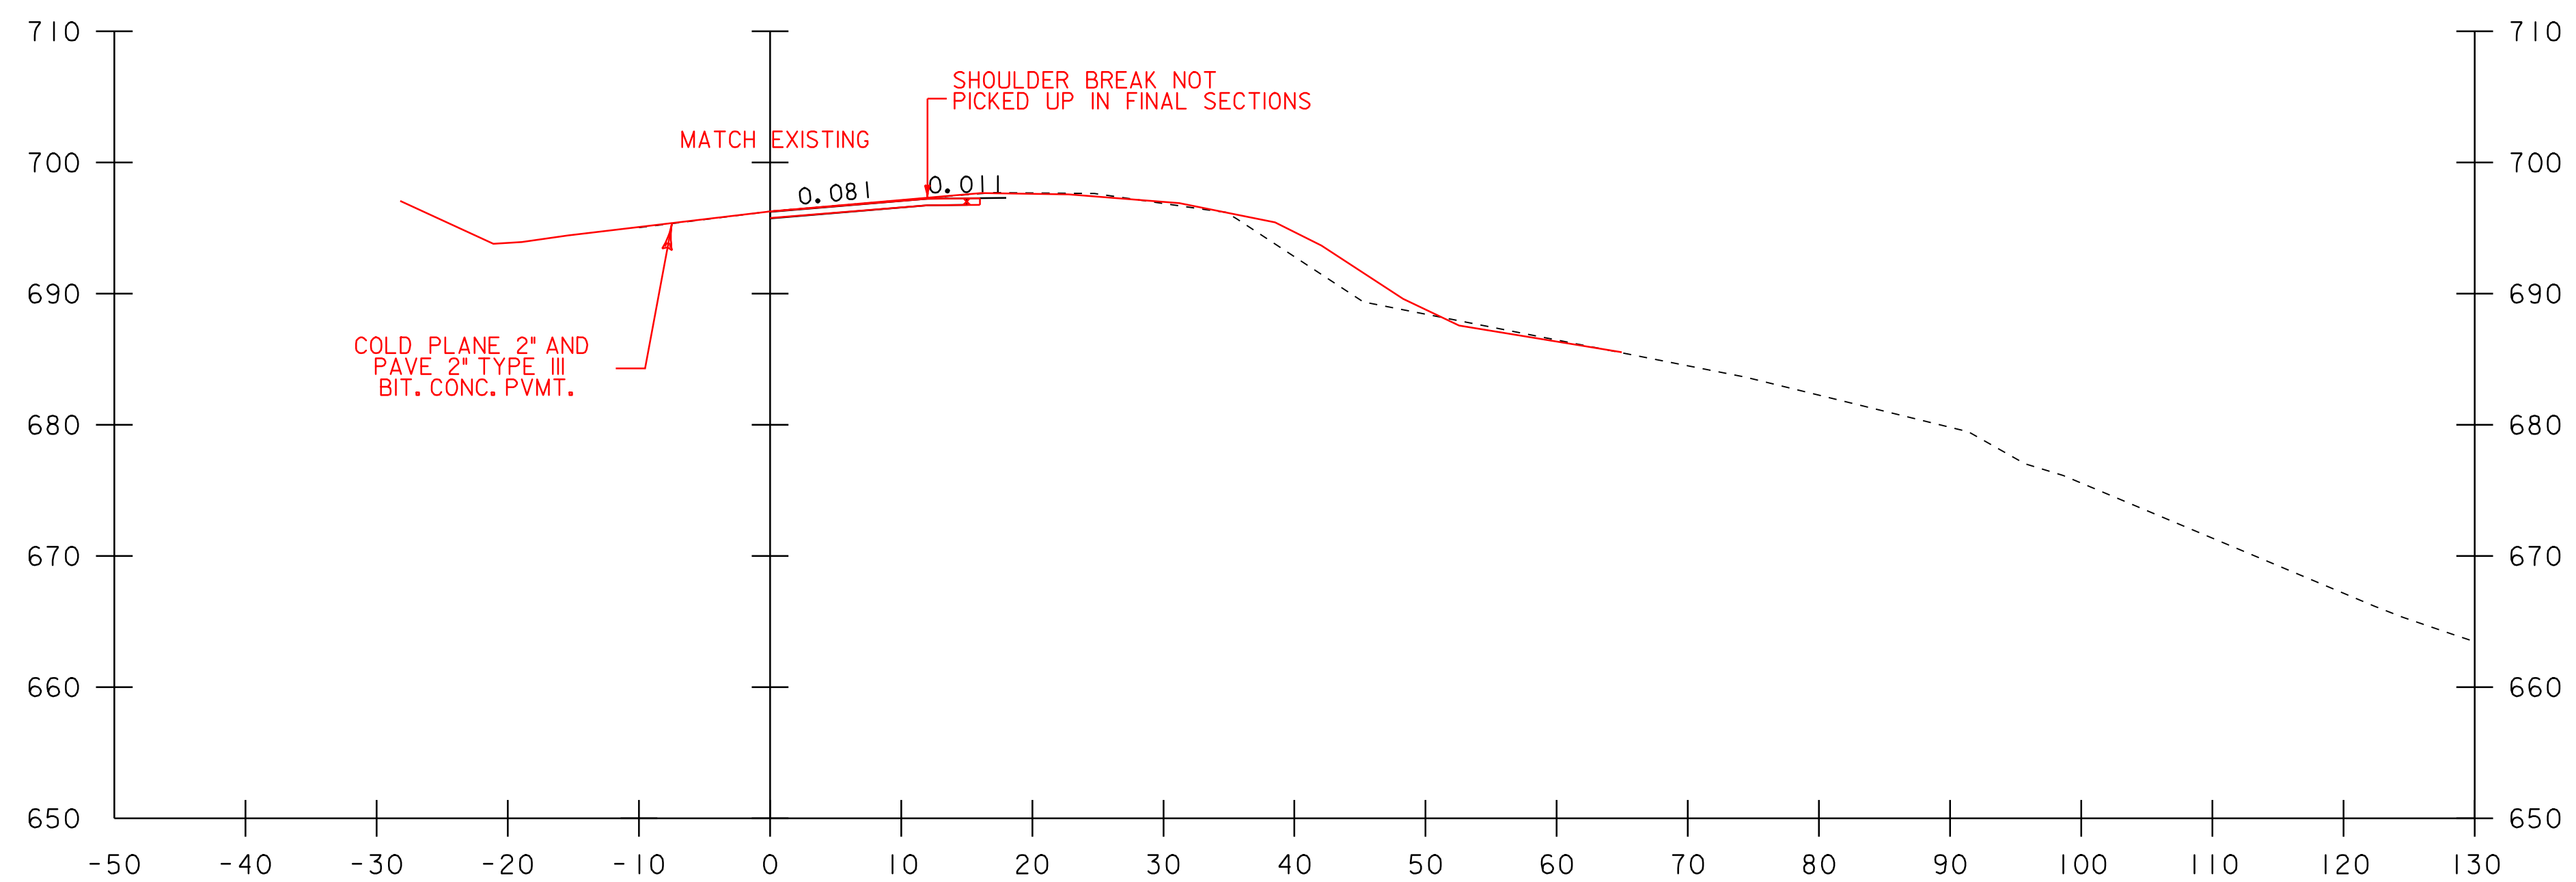

15+50

15+00
 COMMON EXC. = 9.09 SF ✓
 CJJ 12-5-08
 SEH 12-17-08

STA. 15+50 TO STA. 16+25

PROJECT NAME:	WOLCOTT	PLOT DATE:	26-AUG-2009 16:22
PROJECT NUMBER:	STP 030-2 (22)	DRAWN BY:	MBL
FILE NAME:	d07b096xsl.dgn	DESIGNED BY:	DLG/MBL
CROSS SECTIONS		CHECKED BY:	SDM
		SHEET	22 OF 22



NOTE:
 WATER LEVEL ON CROSS SECTIONS ARE FOR REFERENCING PURPOSES ONLY.