



END PROJECT
 STP 030-2 (22)
 STA. 15+97.18

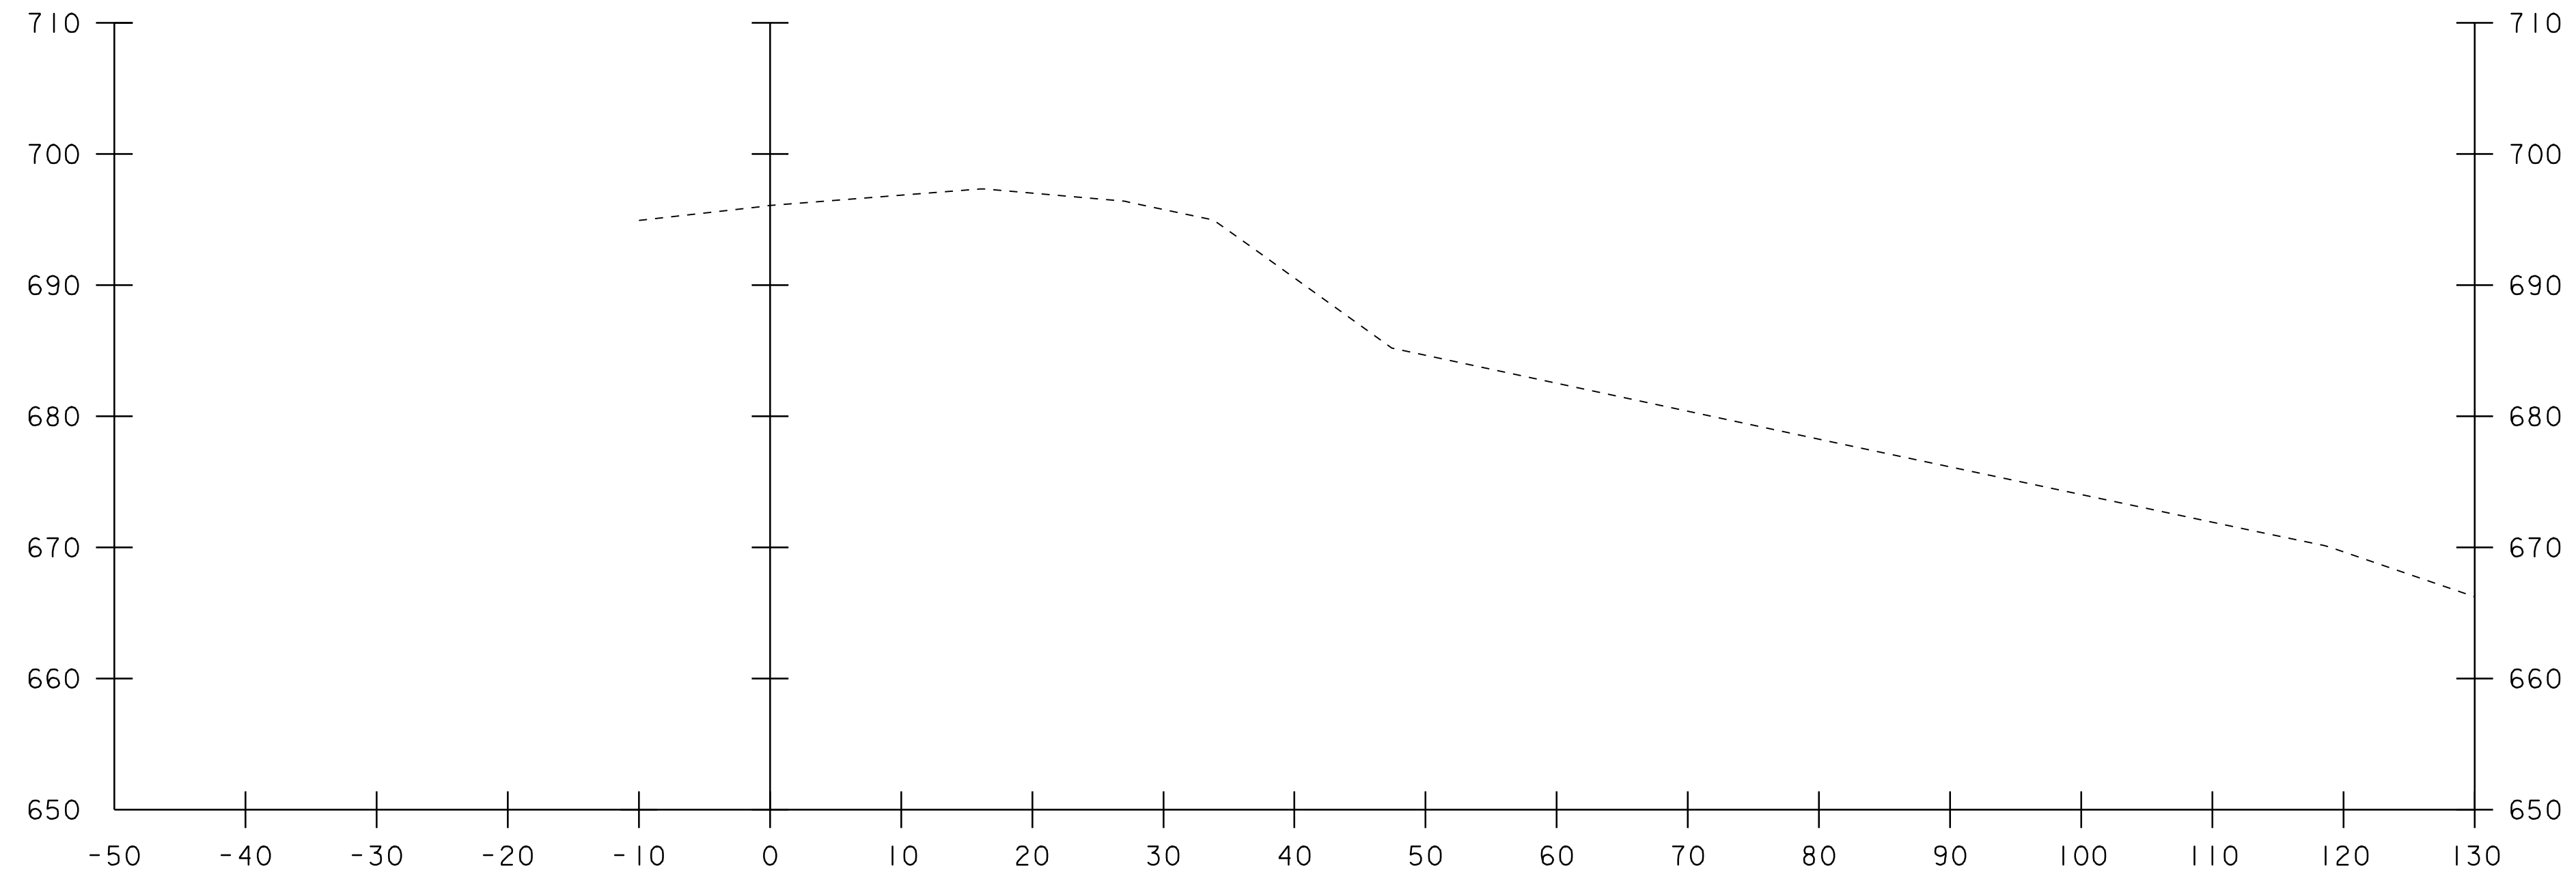


16+25

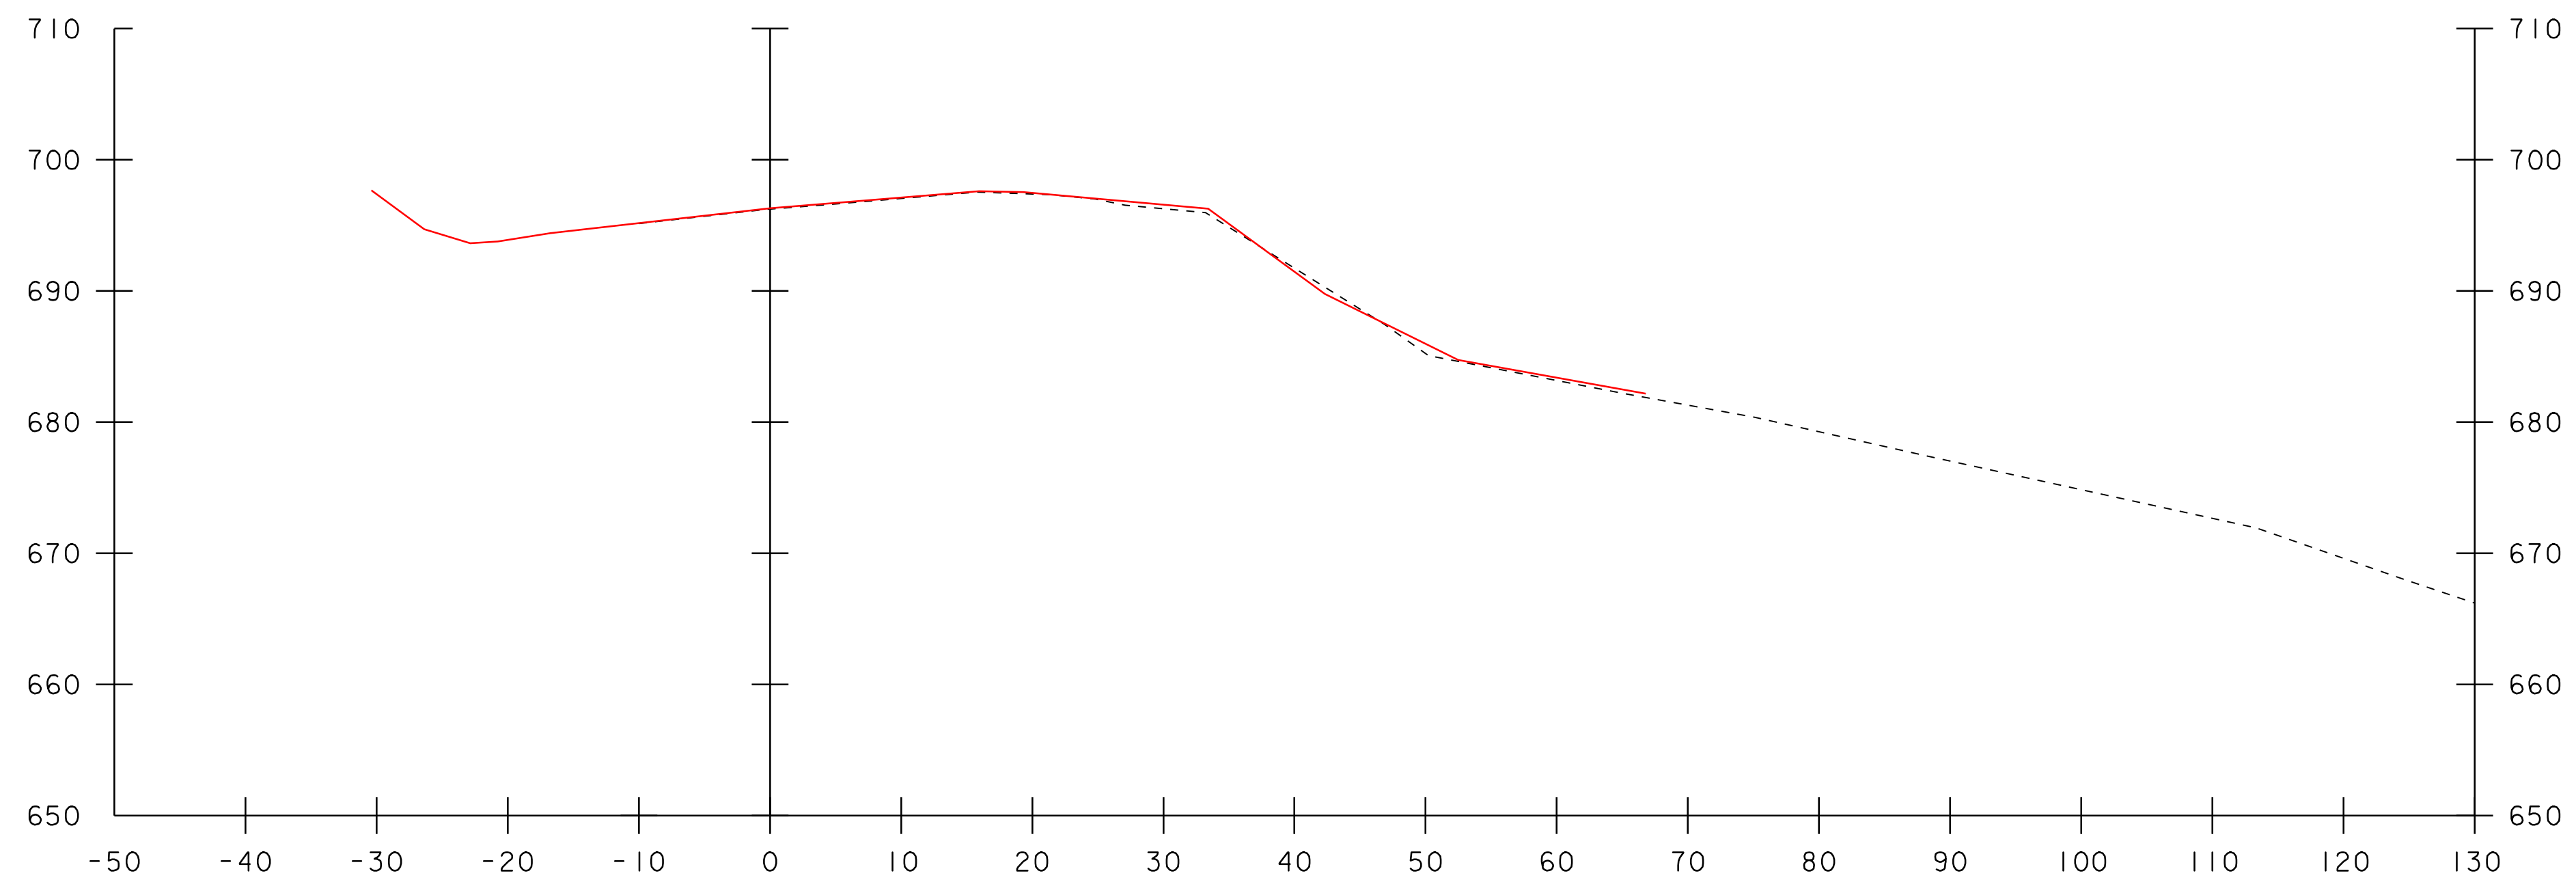

16+00

STA. 15+50 TO STA. 16+25

PROJECT NAME:	WOLCOTT	PLOT DATE:	26-AUG-2009 16:22
PROJECT NUMBER:	STP 030-2 (22)	DRAWN BY:	MBL
FILE NAME:	d07b096xsl.dgn	CHECKED BY:	SDM
PROJECT LEADER:	JLS	CROSS SECTIONS	SHEET 22 OF 22
DESIGNED BY:	DLG/MBL		

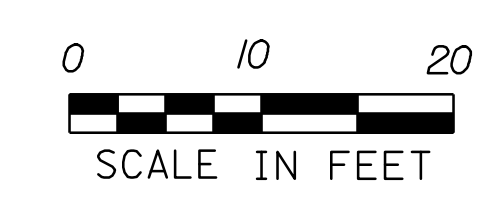

NOTE:
 WATER LEVEL ON CROSS SECTIONS ARE FOR REFERENCING PURPOSES ONLY.