




STATE OF VERMONT AGENCY OF TRANSPORTATION

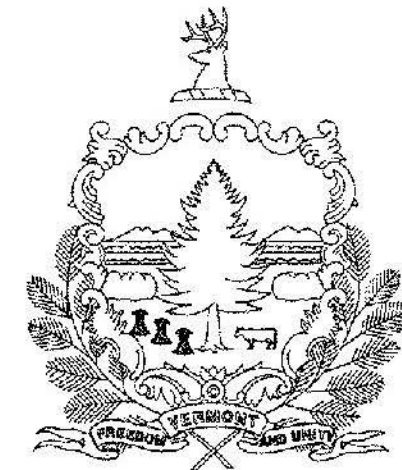

PROPOSED IMPROVEMENT TOWN OF PERU COUNTY OF BENNINGTON VT ROUTE 11 (MINOR ARTERIAL)

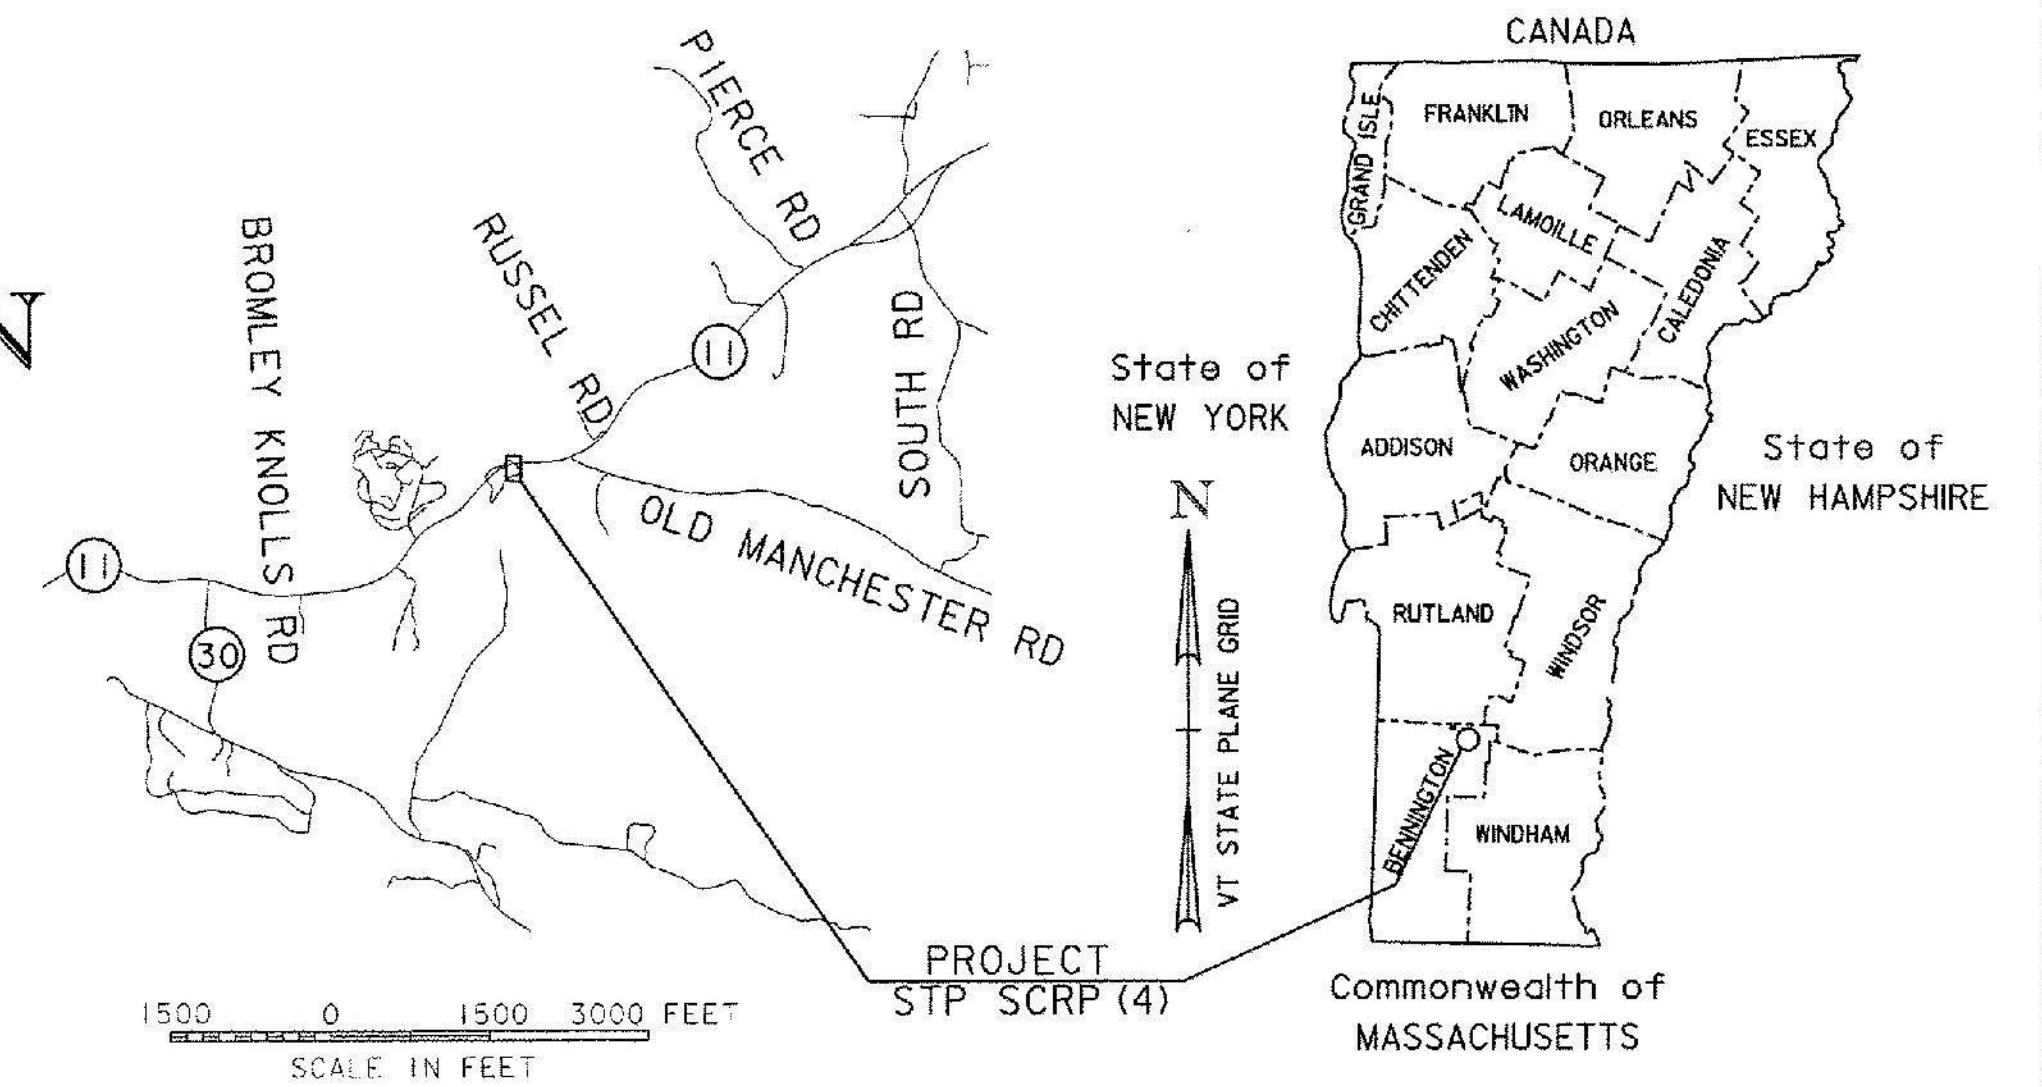

PROJECT LOCATION: BEGINNING IN THE TOWN OF PERU ON VT ROUTE 11 AT STATION 33+35.16 (MM 0.516) AND EXTENDING
EASTERLY 44.00 FEET (0.008 MILE) TO STATION 33+79.16 (MM 0.524)
LENGTH OF PROJECT = 44.00 FEET (0.008 MILE)
LENGTH OF CULVERT WORK = 493.19 FEET (0.093 MILE)
PROJECT DESCRIPTION: ABANDON EXISTING CULVERT, CONSTRUCTION OF A NEW CULVERT AND APPURTENANT ROADWAY WORK.

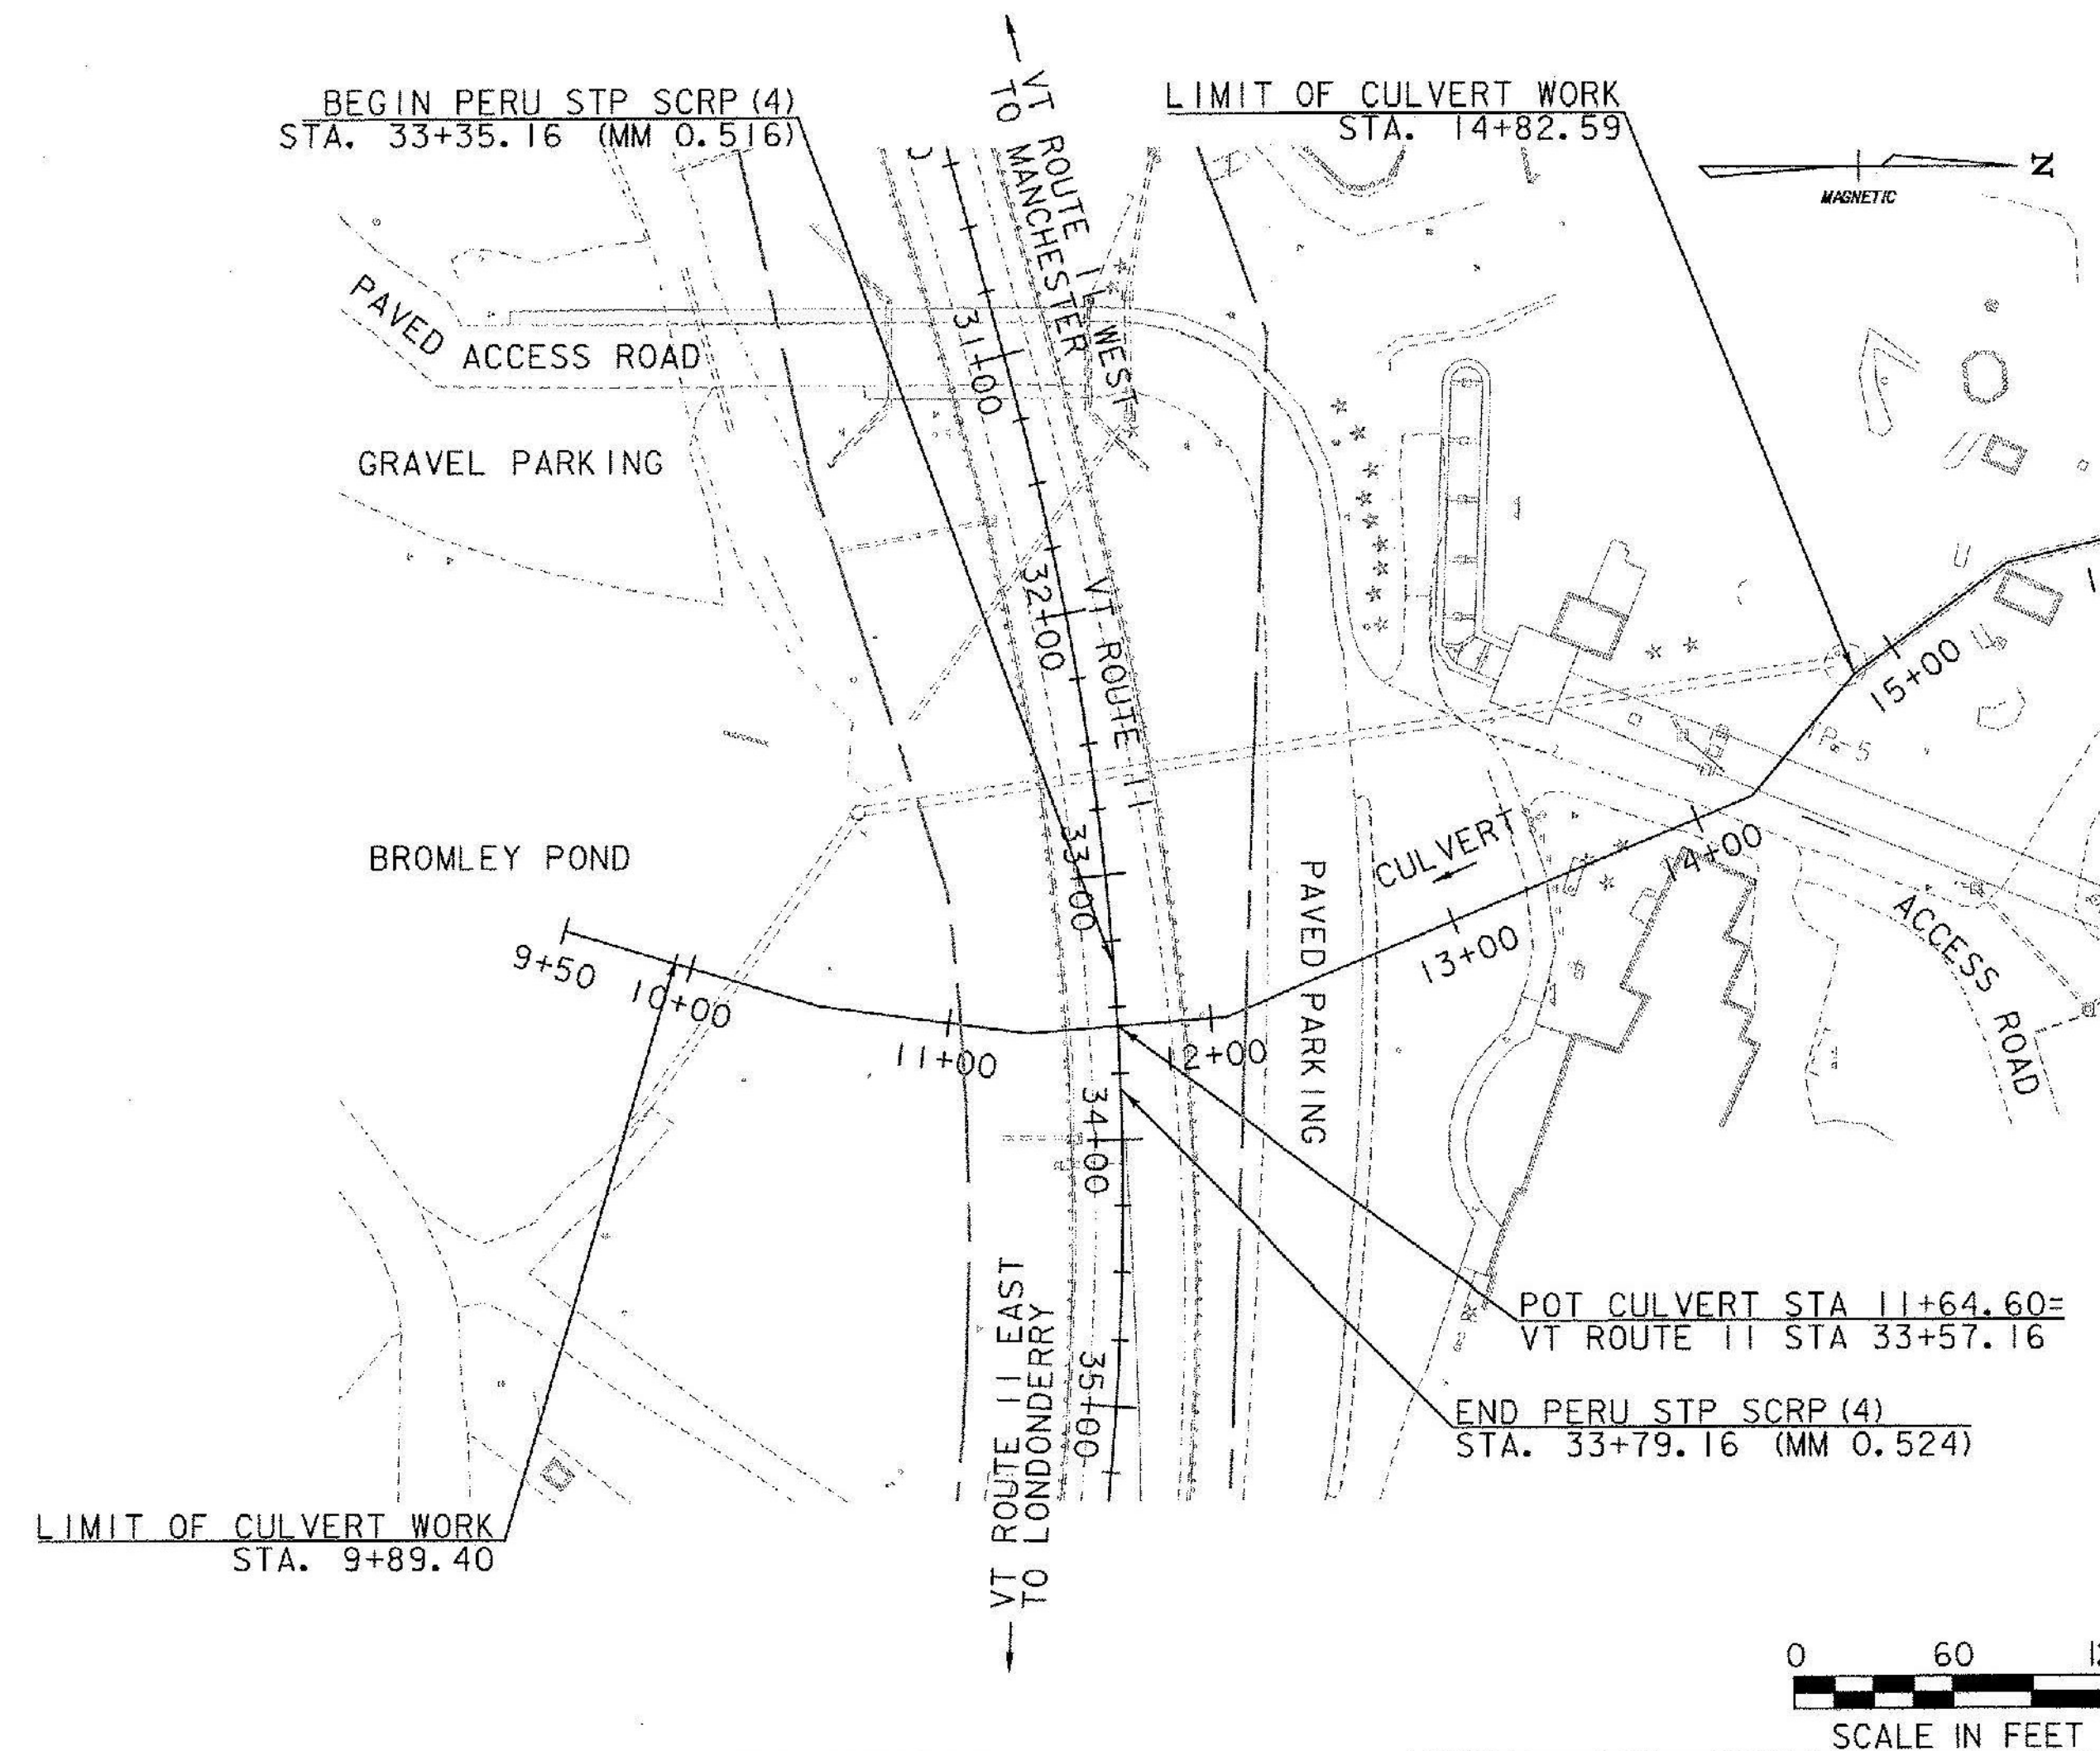

Record Plans

Contractor: RENAUD BROTHERS, INC.
Resident Engineer: RONALD LEMAIRE (2015 - 2017) / JUDY GILMORE (2018)
Construction Began: JUNE 2, 2015
Construction Complete: JUNE 11, 2018
Record Plans By: JUDY GILMORE

I hereby certify that all construction required by this set of drawings has been accomplished as indicated herein.

BY: on 2018-09-20 16:39:33 GMT Resident Engineer

Date: September 20, 2018

NOTE: Any further information concerning final quantities, amounts or other details relative to this project may be found at Central Files in the electronic archives.

CONSTRUCTION IS TO BE CARRIED ON IN ACCORDANCE WITH THESE PLANS AND THE STANDARD SPECIFICATIONS FOR CONSTRUCTION DATED 2011, AS APPROVED BY THE FEDERAL HIGHWAY ADMINISTRATION ON JULY 20, 2011 FOR USE ON THIS PROJECT, INCLUDING ALL SUBSEQUENT REVISIONS AND SUCH REVISED SPECIFICATIONS AND SPECIAL PROVISIONS AS ARE INCORPORATED IN THESE PLANS.

QUALITY ASSURANCE PROGRAM : LEVEL 2
SURVEYED BY : L. ORVIS PC/G. HITCHCOCK
SURVEYED DATE : 5/29/2008, 8/5/2008, 4/3/2012
DATUM
VERTICAL ASSUMED
HORIZONTAL ASSUMED

DIRECTOR OF PROJECT DELIVERY	APPROVED DATE 12/31/2014
PROJECT MANAGER : KEN UPMAL, P.E.	
PROJECT NAME : PERU	
PROJECT NUMBER : STP SCR(4)	
SHEET 1 OF 45 SHEETS	

GREEN INTERNATIONAL AFFILIATES, INC.
CIVIL AND STRUCTURAL ENGINEERS