
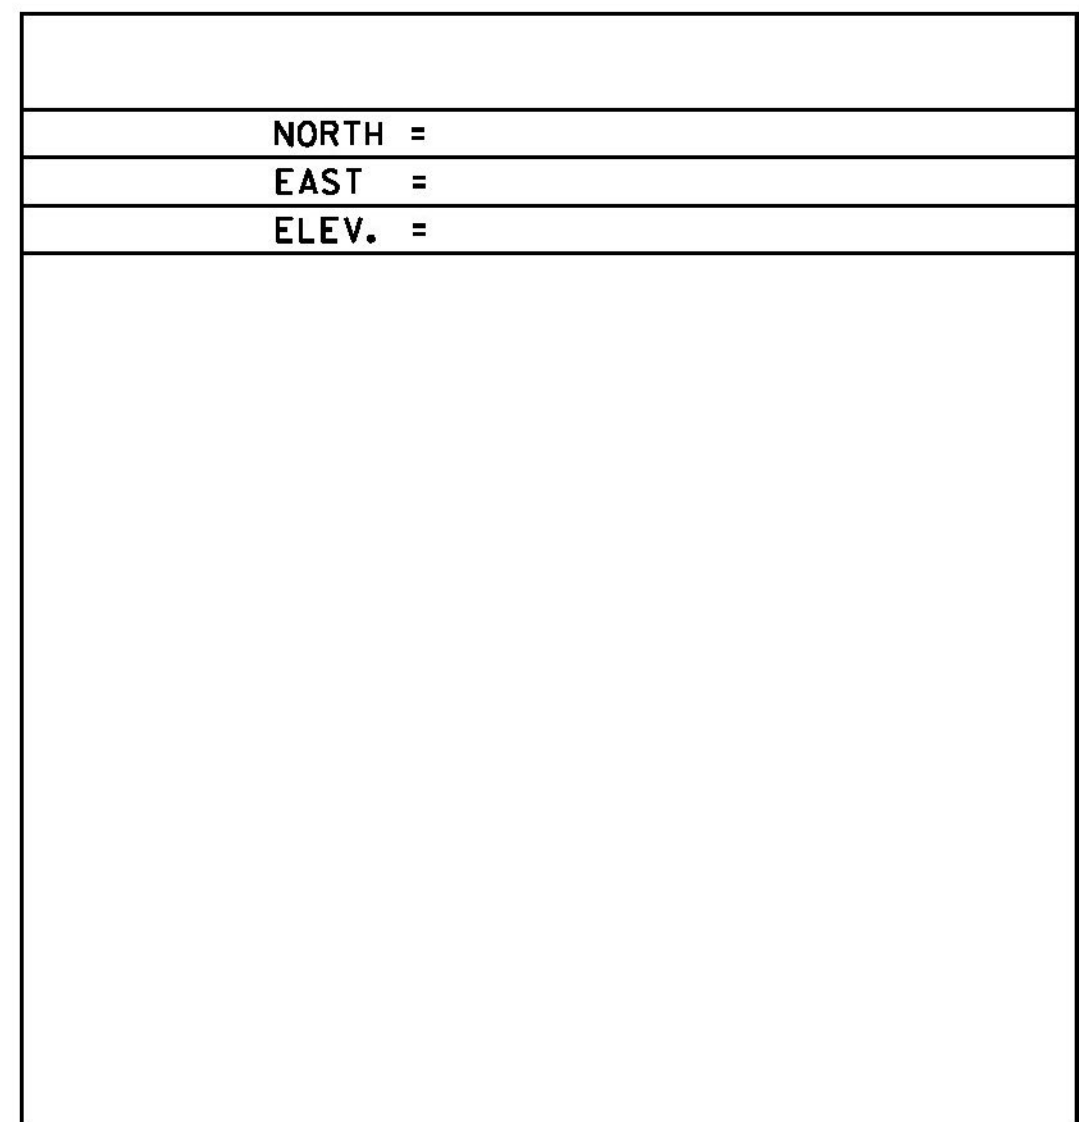
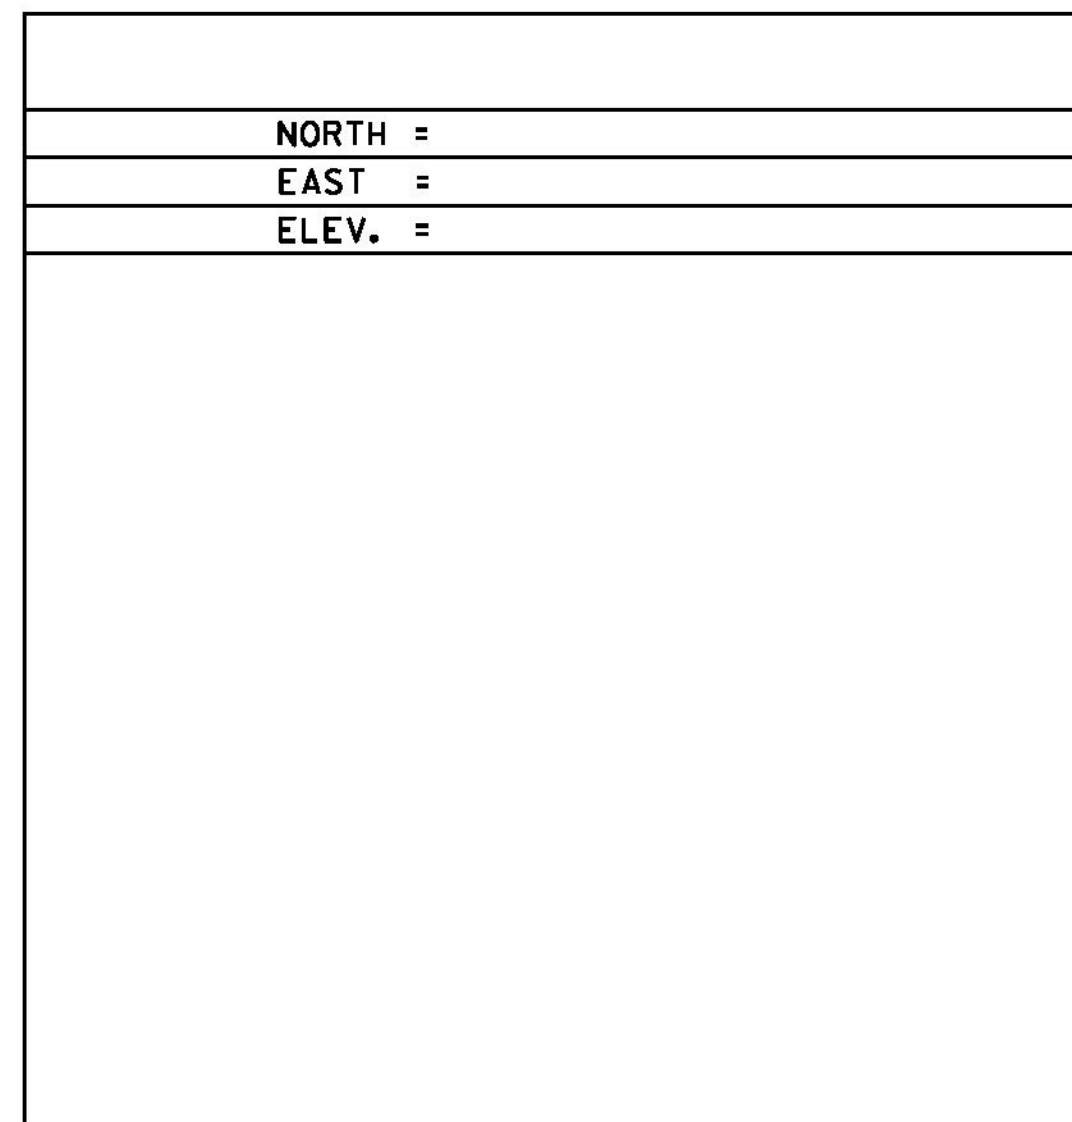
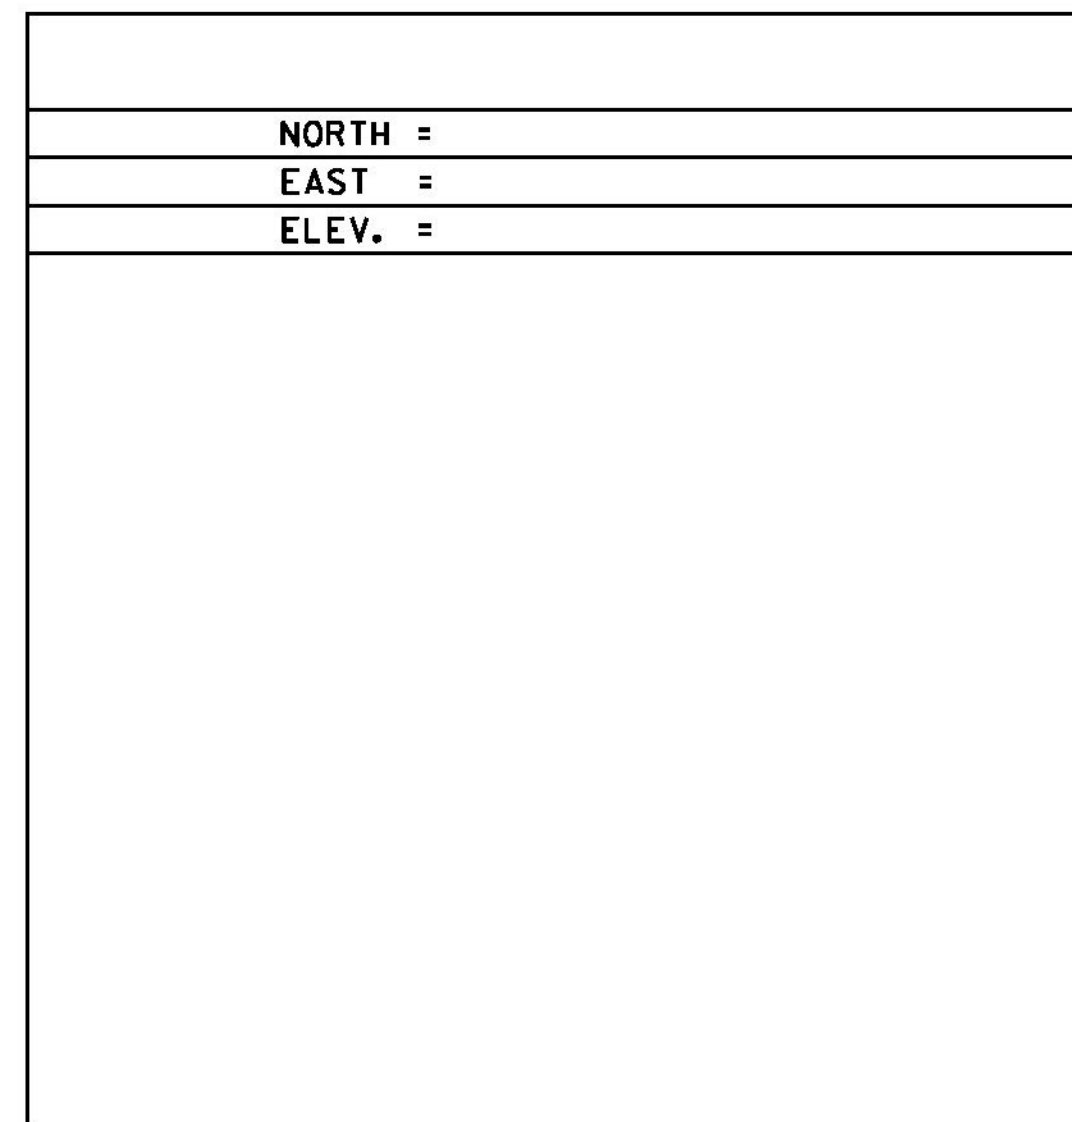
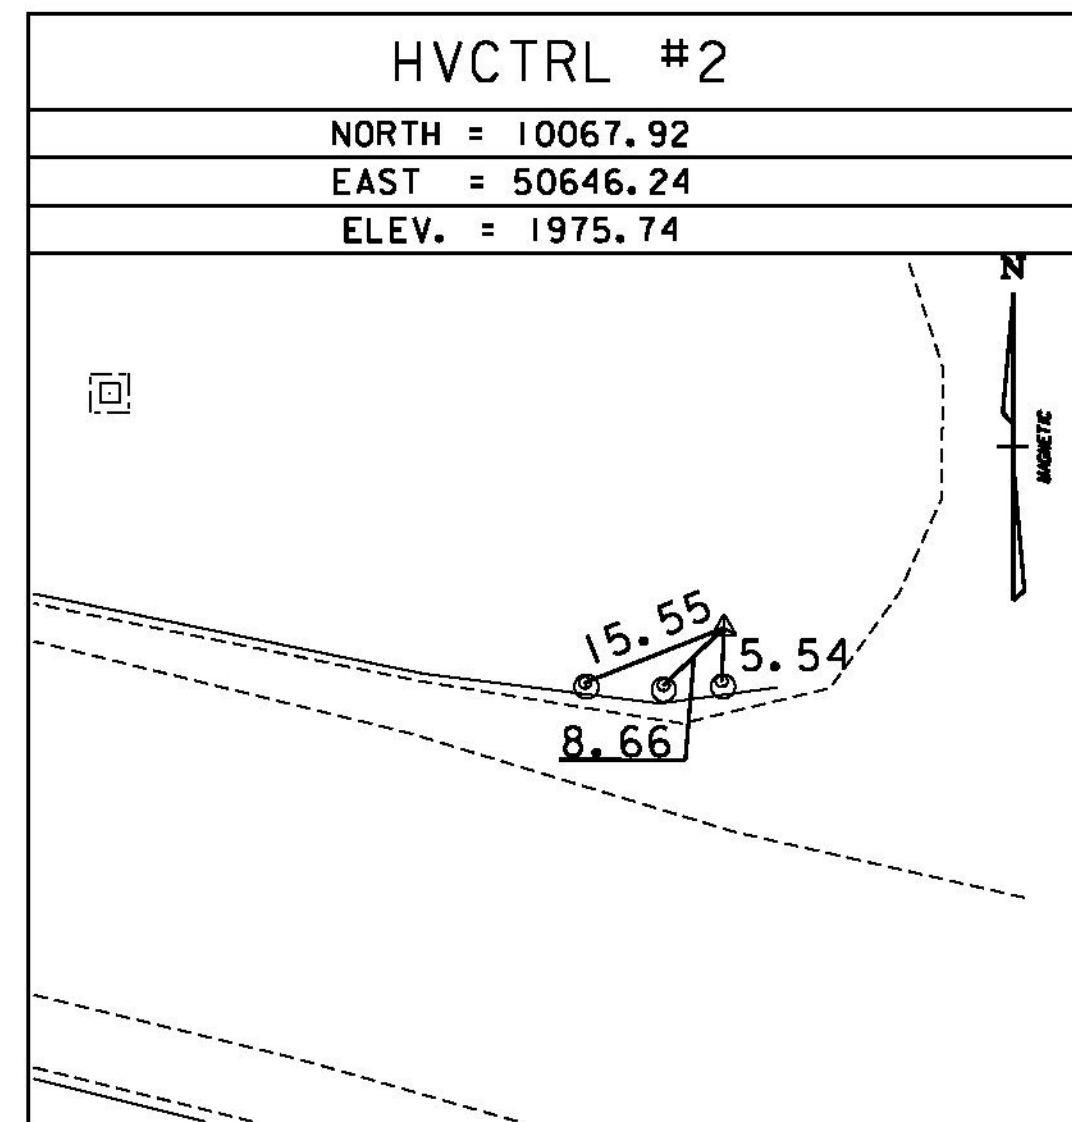


GPS CONTROL POINTS






This Project has Assumed Horizontal and Vertical Datums

TRAVERSE TIES

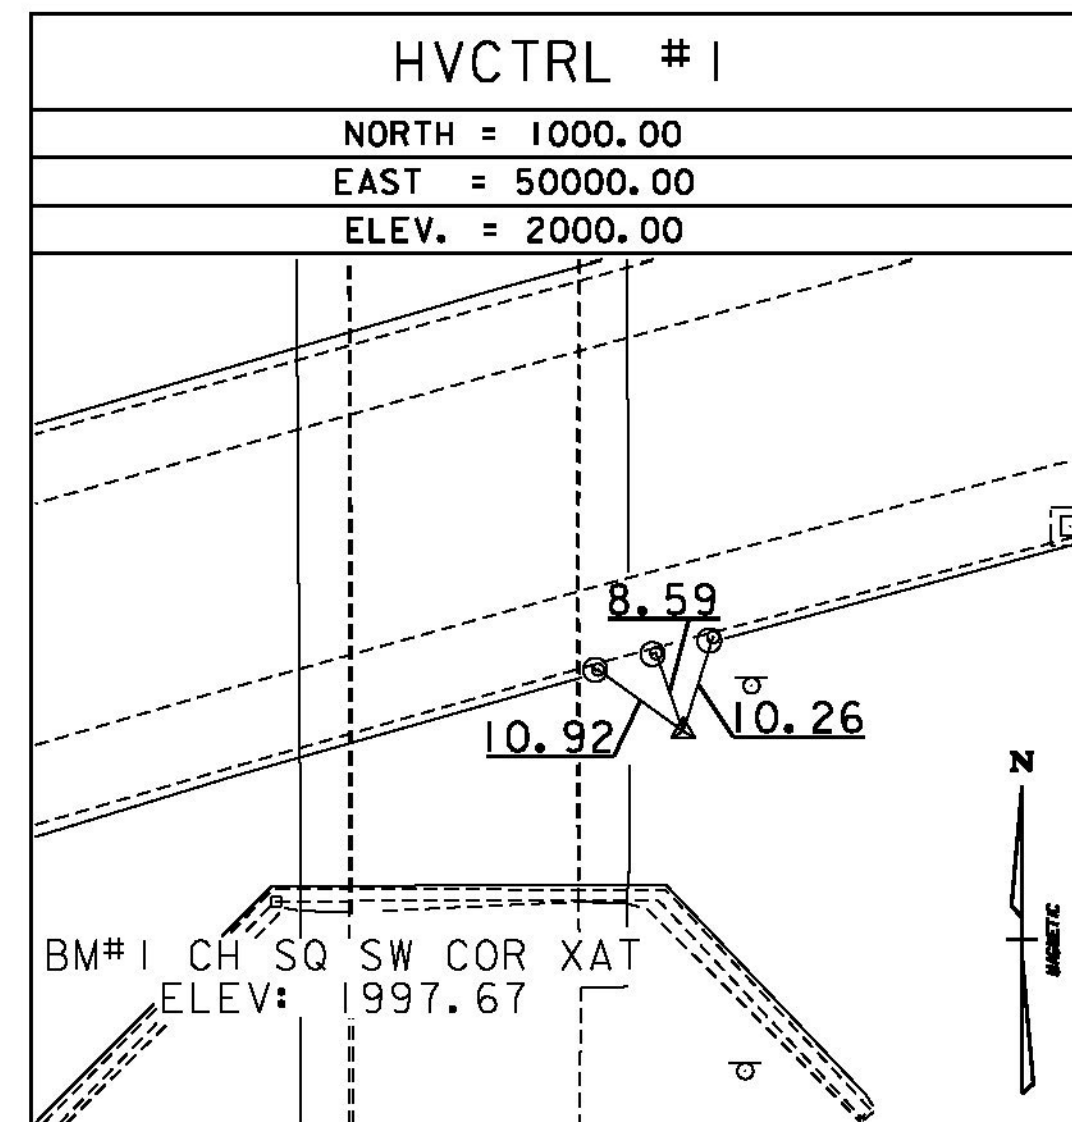


* Main Traverse Completed 5/29/08 L. ORVIS PC/R. BULLOCK/C. CYR/R. BOCKUS

ALIGNMENT TIES

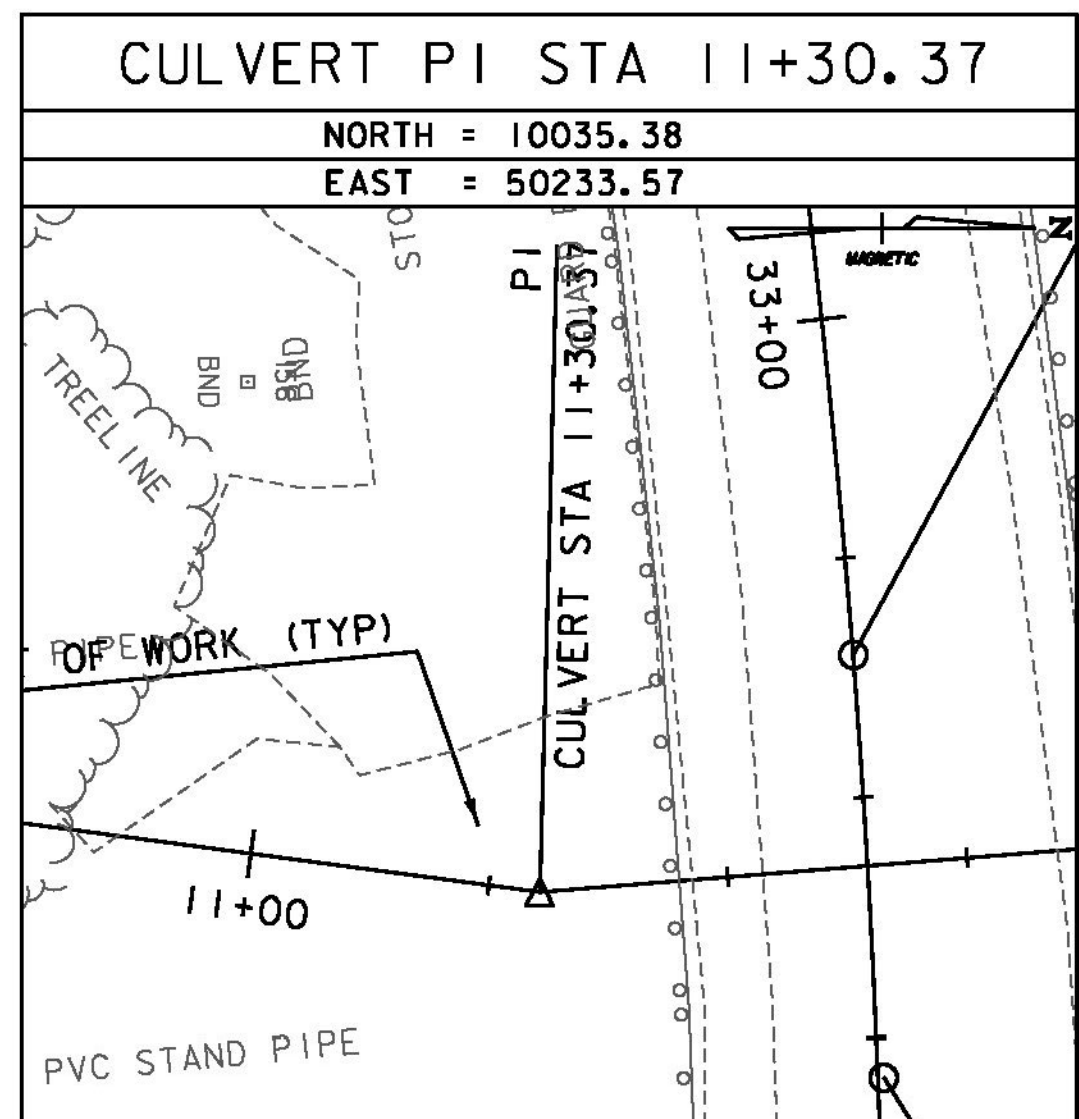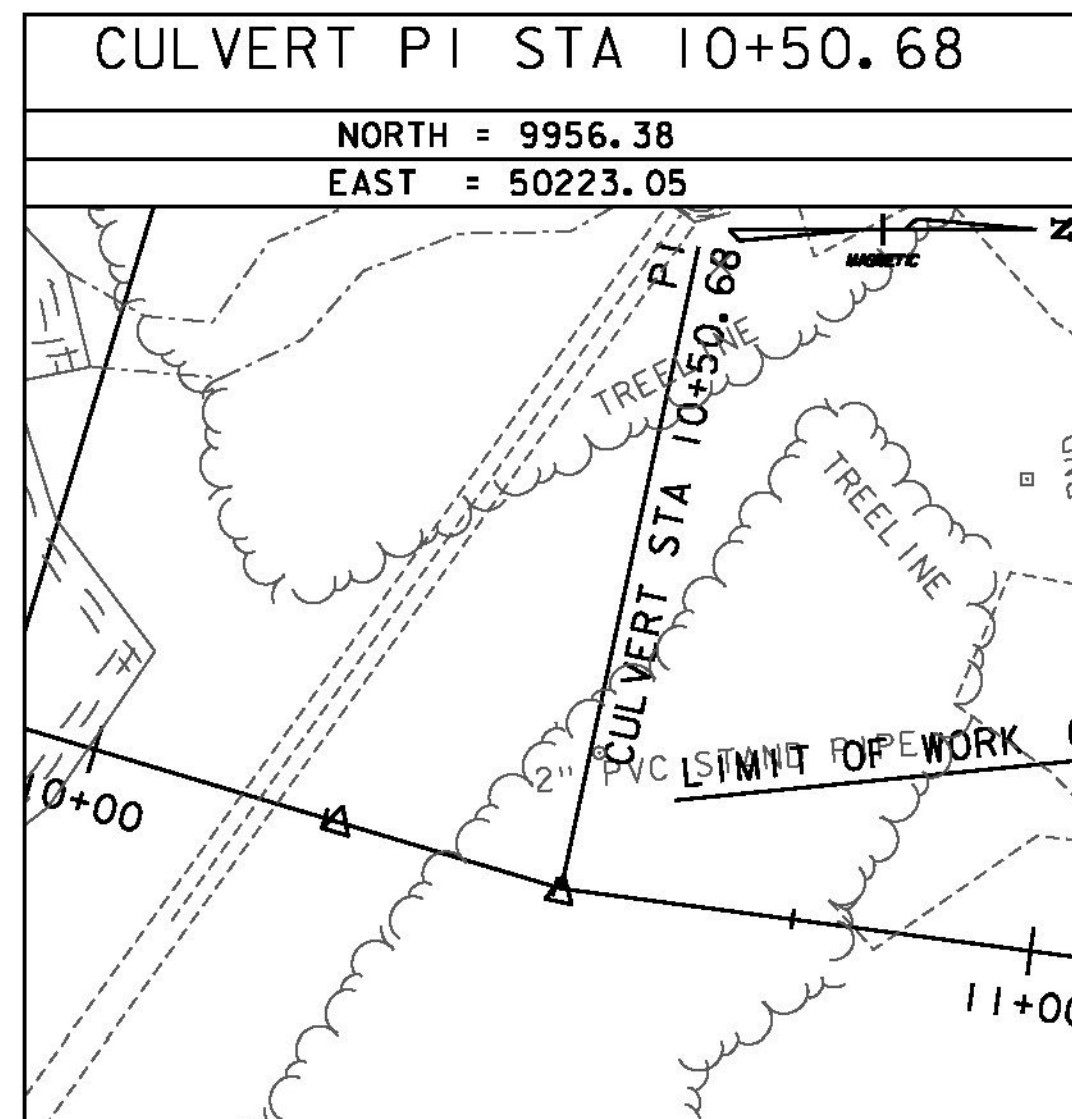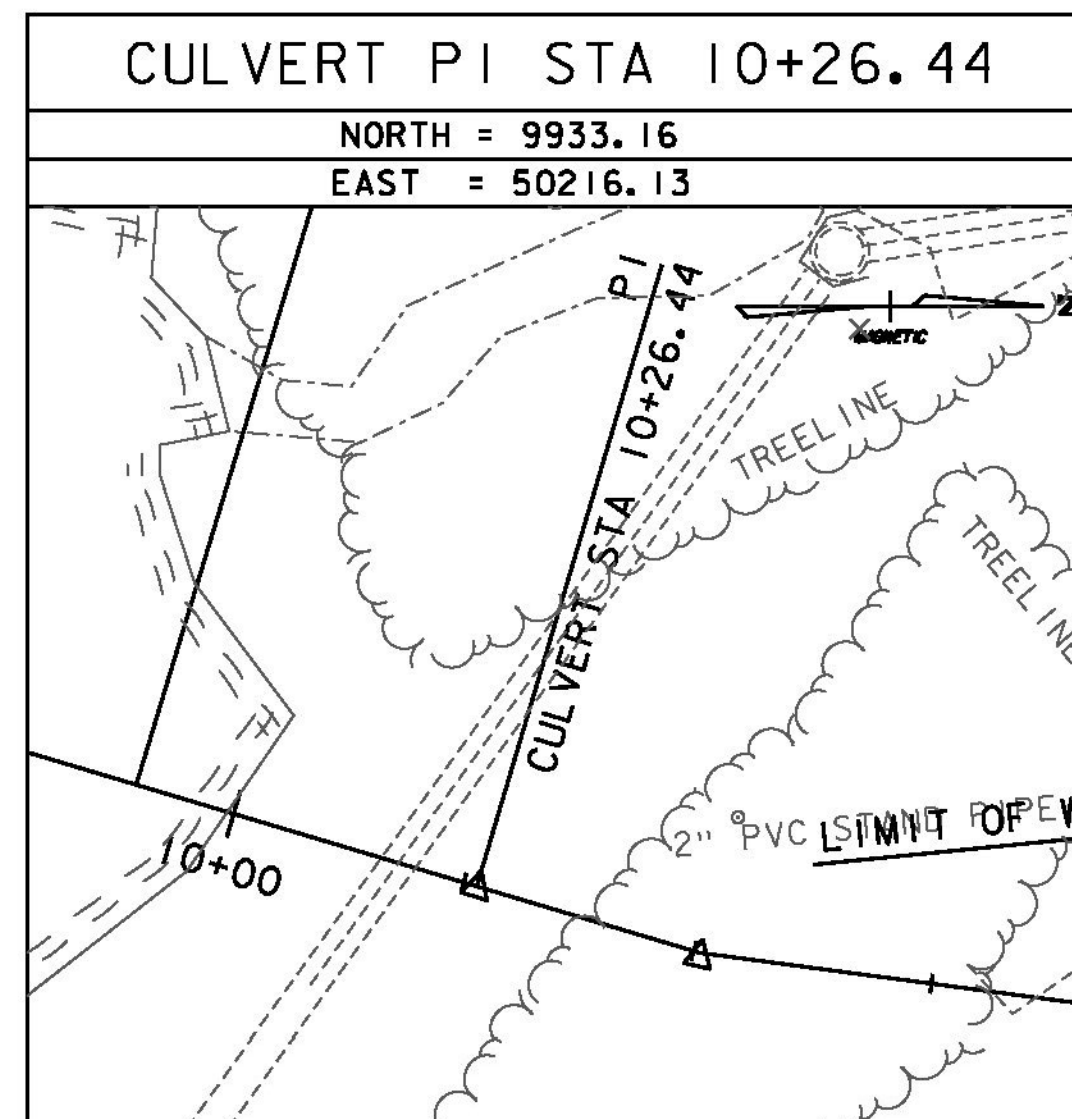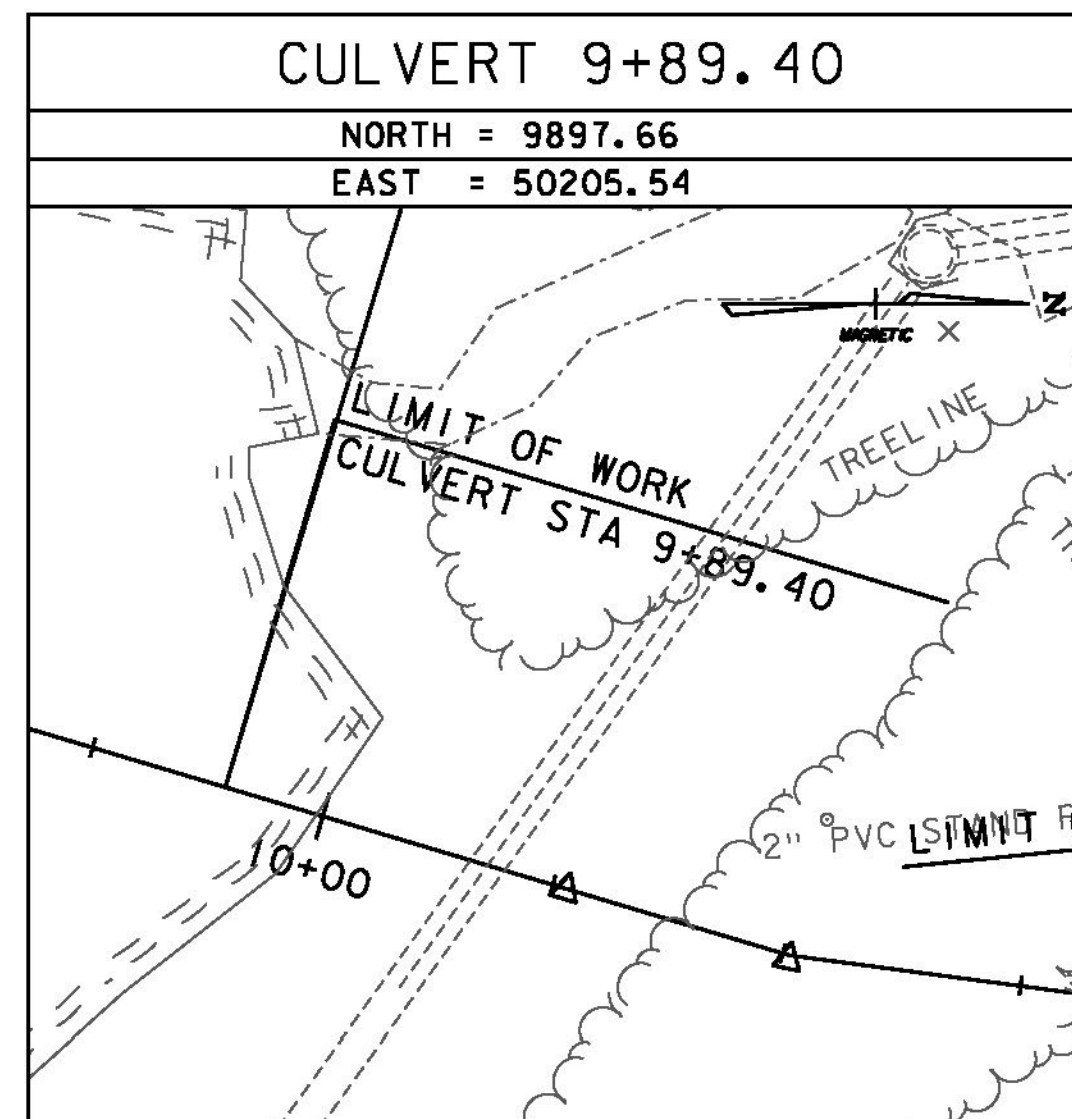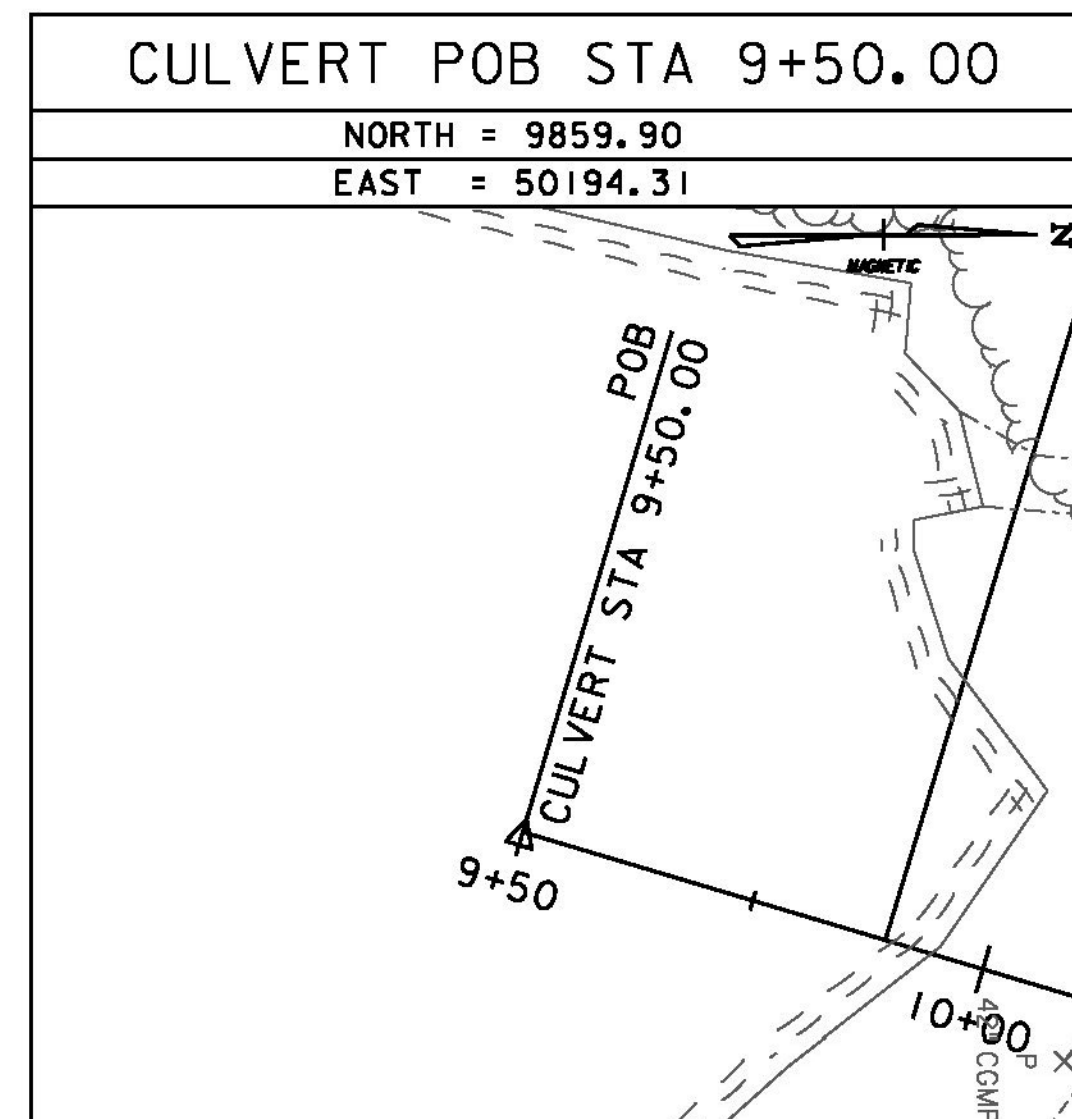

DATUM	
VERTICAL	ASSUMED
HORIZONTAL	ASSUMED
ADJUSTMENT	NONE

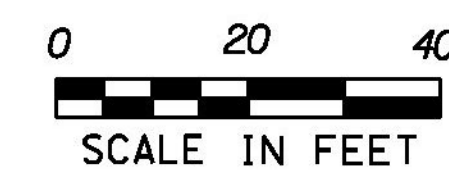

GREEN INTERNATIONAL AFFILIATES, INC.
CIVIL AND STRUCTURAL ENGINEERS

PROJECT NAME:	PERU	FILE NAME:	z07bi06t1.dgn	PLOT DATE:	12/31/2014
PROJECT NUMBER:	STP SCR(4)	PROJECT LEADER:	E. ATKINS	DRAWN BY:	C. MORIN
		DESIGNED BY:	M. BRADLEY	CHECKED BY:	E. ATKINS
		TIE SHEET 1		SHEET	14 OF 45