


VT ROUTE 11 MATERIAL TRANSITION DETAIL
NOT TO SCALE

VT ROUTE 11

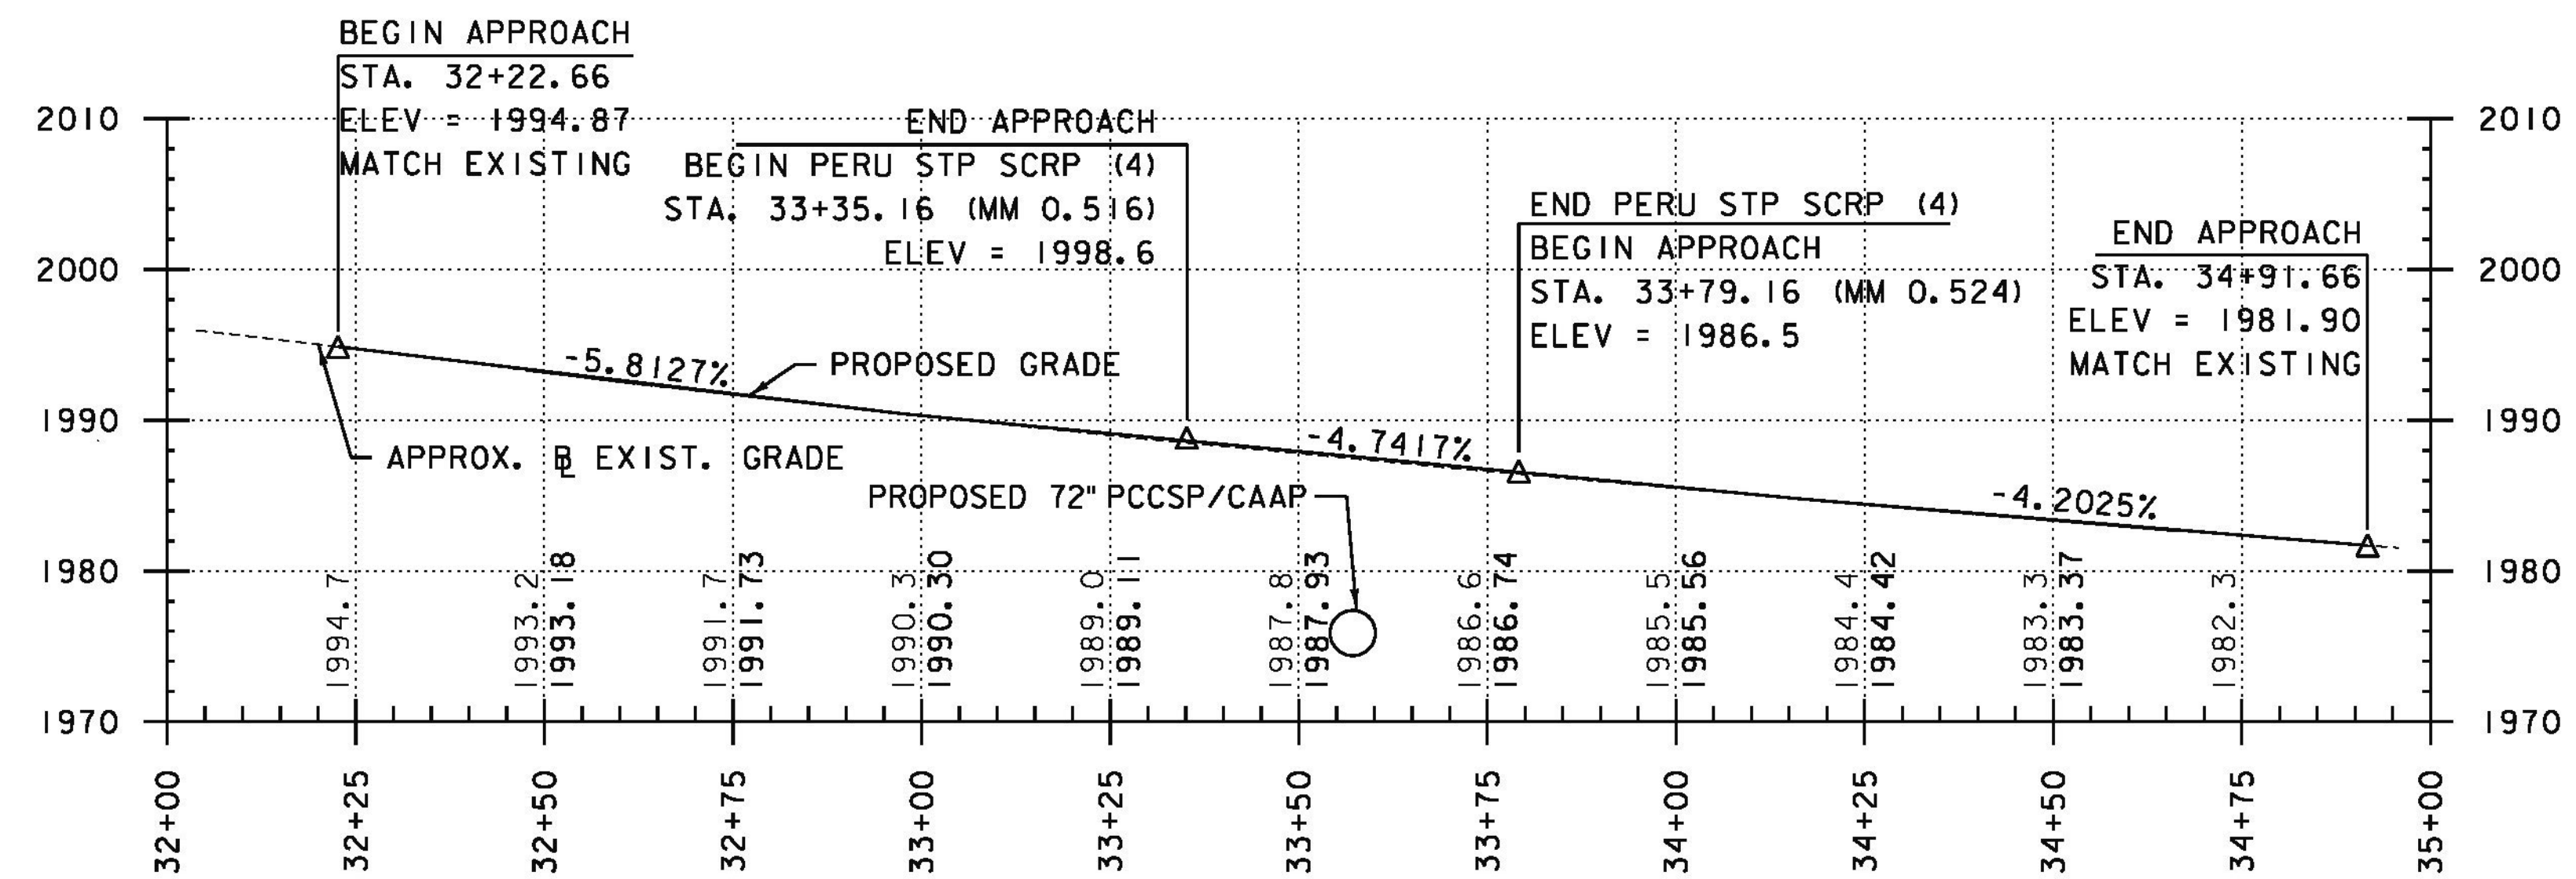

THE GRADES SHOWN TO THE NEAREST TENTH ARE THE ORIGINAL GROUND APPROXIMATE ELEVATIONS ALONG THE PROPOSED ALIGNMENT. THE GRADES SHOWN TO THE NEAREST HUNDREDTH ARE THE PROPOSED PROFILE GRADES FOR THE NEW ALIGNMENT.

NOTE:
1. ALL STATIONS AND ELEVATIONS ARE SHOWN IN FEET.



PROJECT NAME: PERU
PROJECT NUMBER: STP SCR(4)

FILE NAME: z07bi06xsl.dgn
PROJECT LEADER: E. ATKINS
DESIGNED BY: M. BRADLEY
PROFILE SHEET 2

PLOT DATE: 12/31/2014
DRAWN BY: M. BRADLEY
CHECKED BY: E. ATKINS
SHEET 30 OF 45