


SEE SHEET 3 FOR SYMBOLOGY LEGEND

PROJECT NAME: PERU
 PROJECT NUMBER: STP SCR(4)

FILE NAME: z07b106erobdr.dgn
 PROJECT LEADER: E. ATKINS
 DESIGNED BY: M. BRADLEY
 EPSC FINAL CONDITIONS PLAN SHEET

PLOT DATE: 12/31/2014
 DRAWN BY: M. BRADLEY
 CHECKED BY: E. ATKINS
 SHEET 34 OF 45

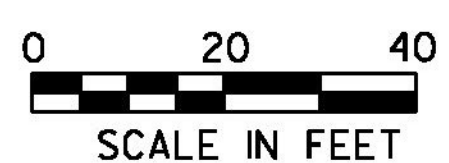

GREEN INTERNATIONAL AFFILIATES, INC.
 CIVIL AND STRUCTURAL ENGINEERS