




32+22.66 BEGIN APPROACH

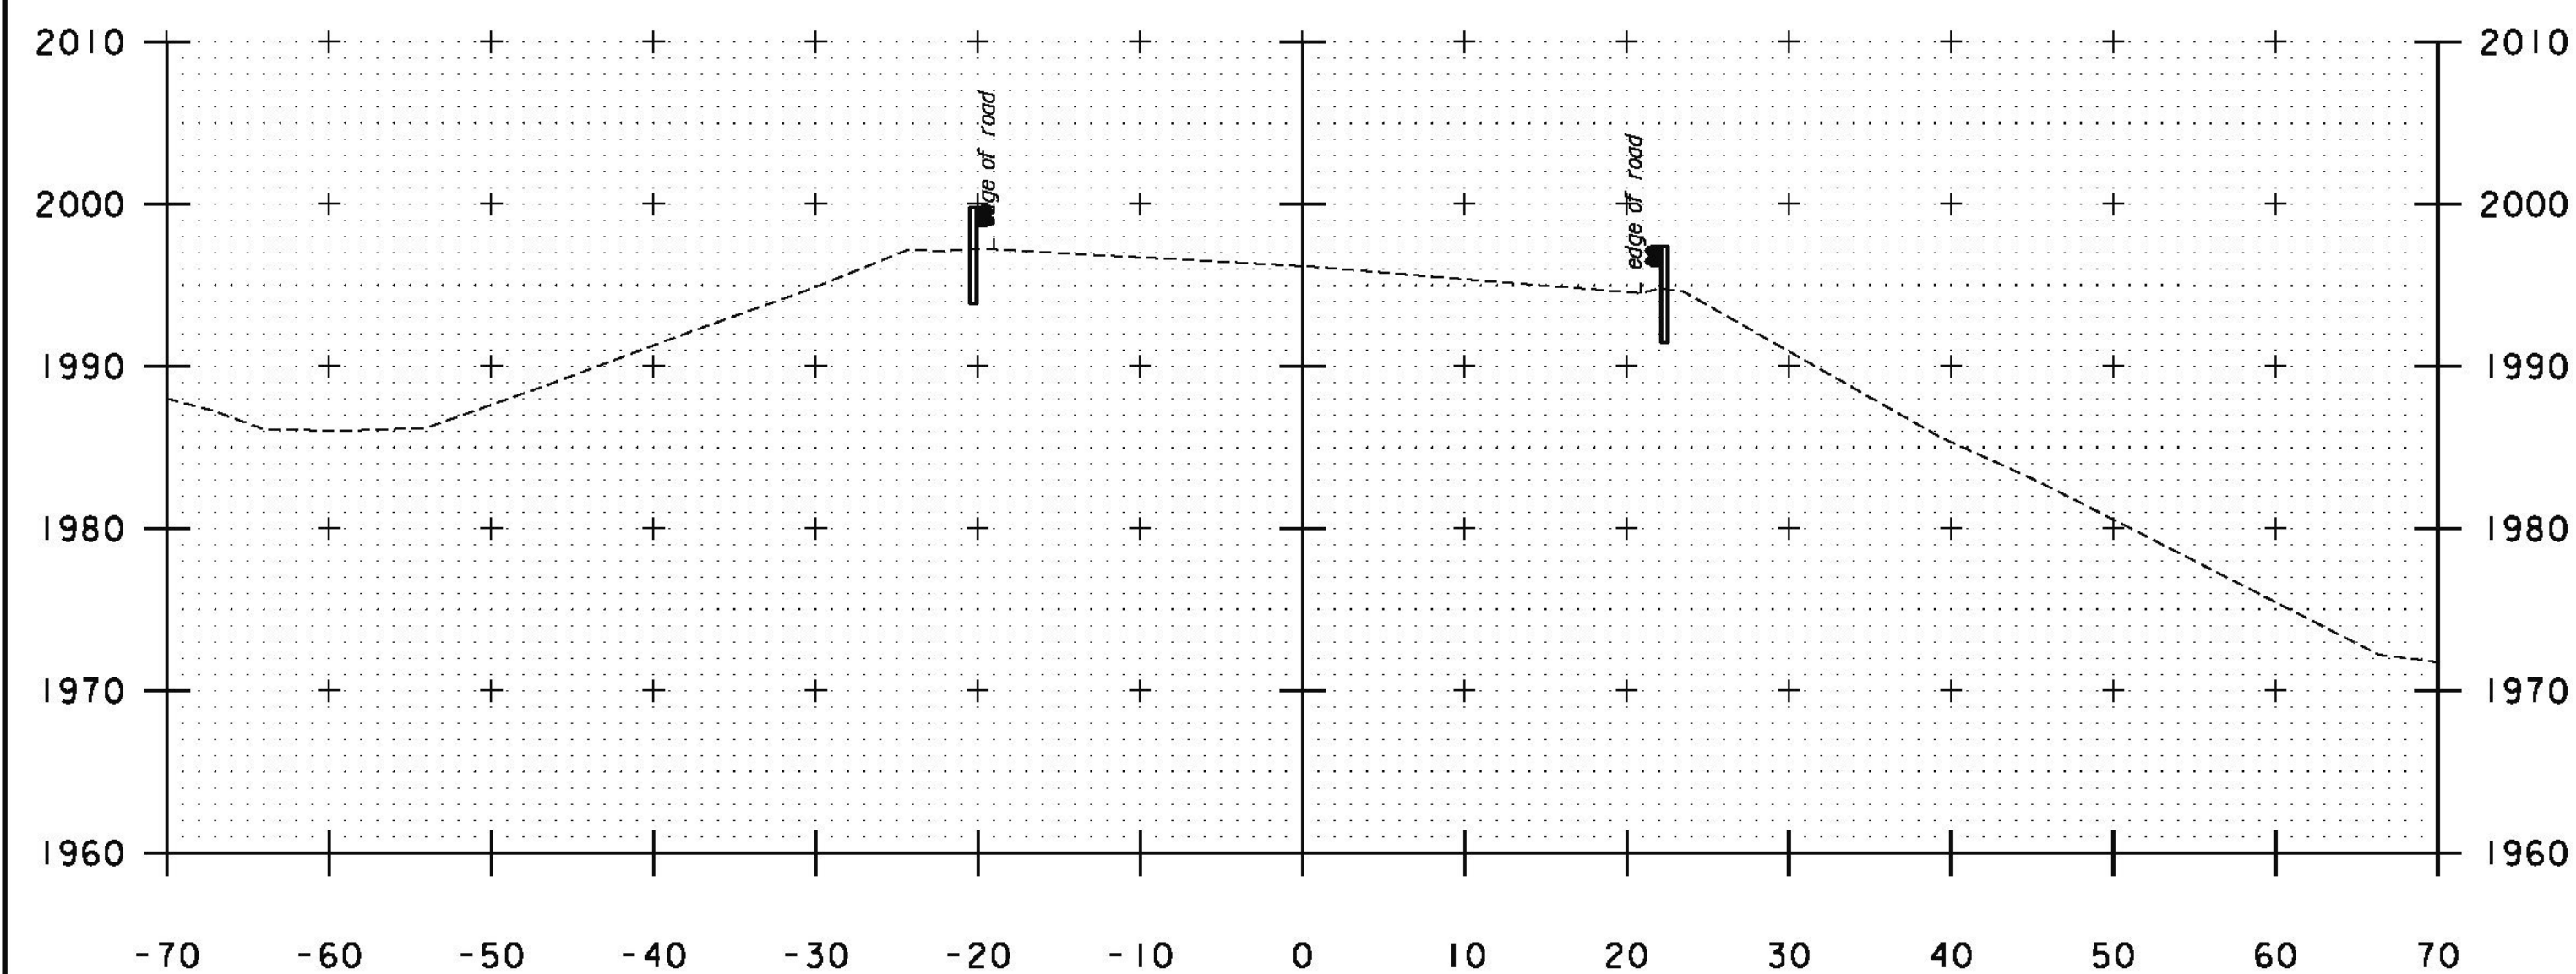

32+00

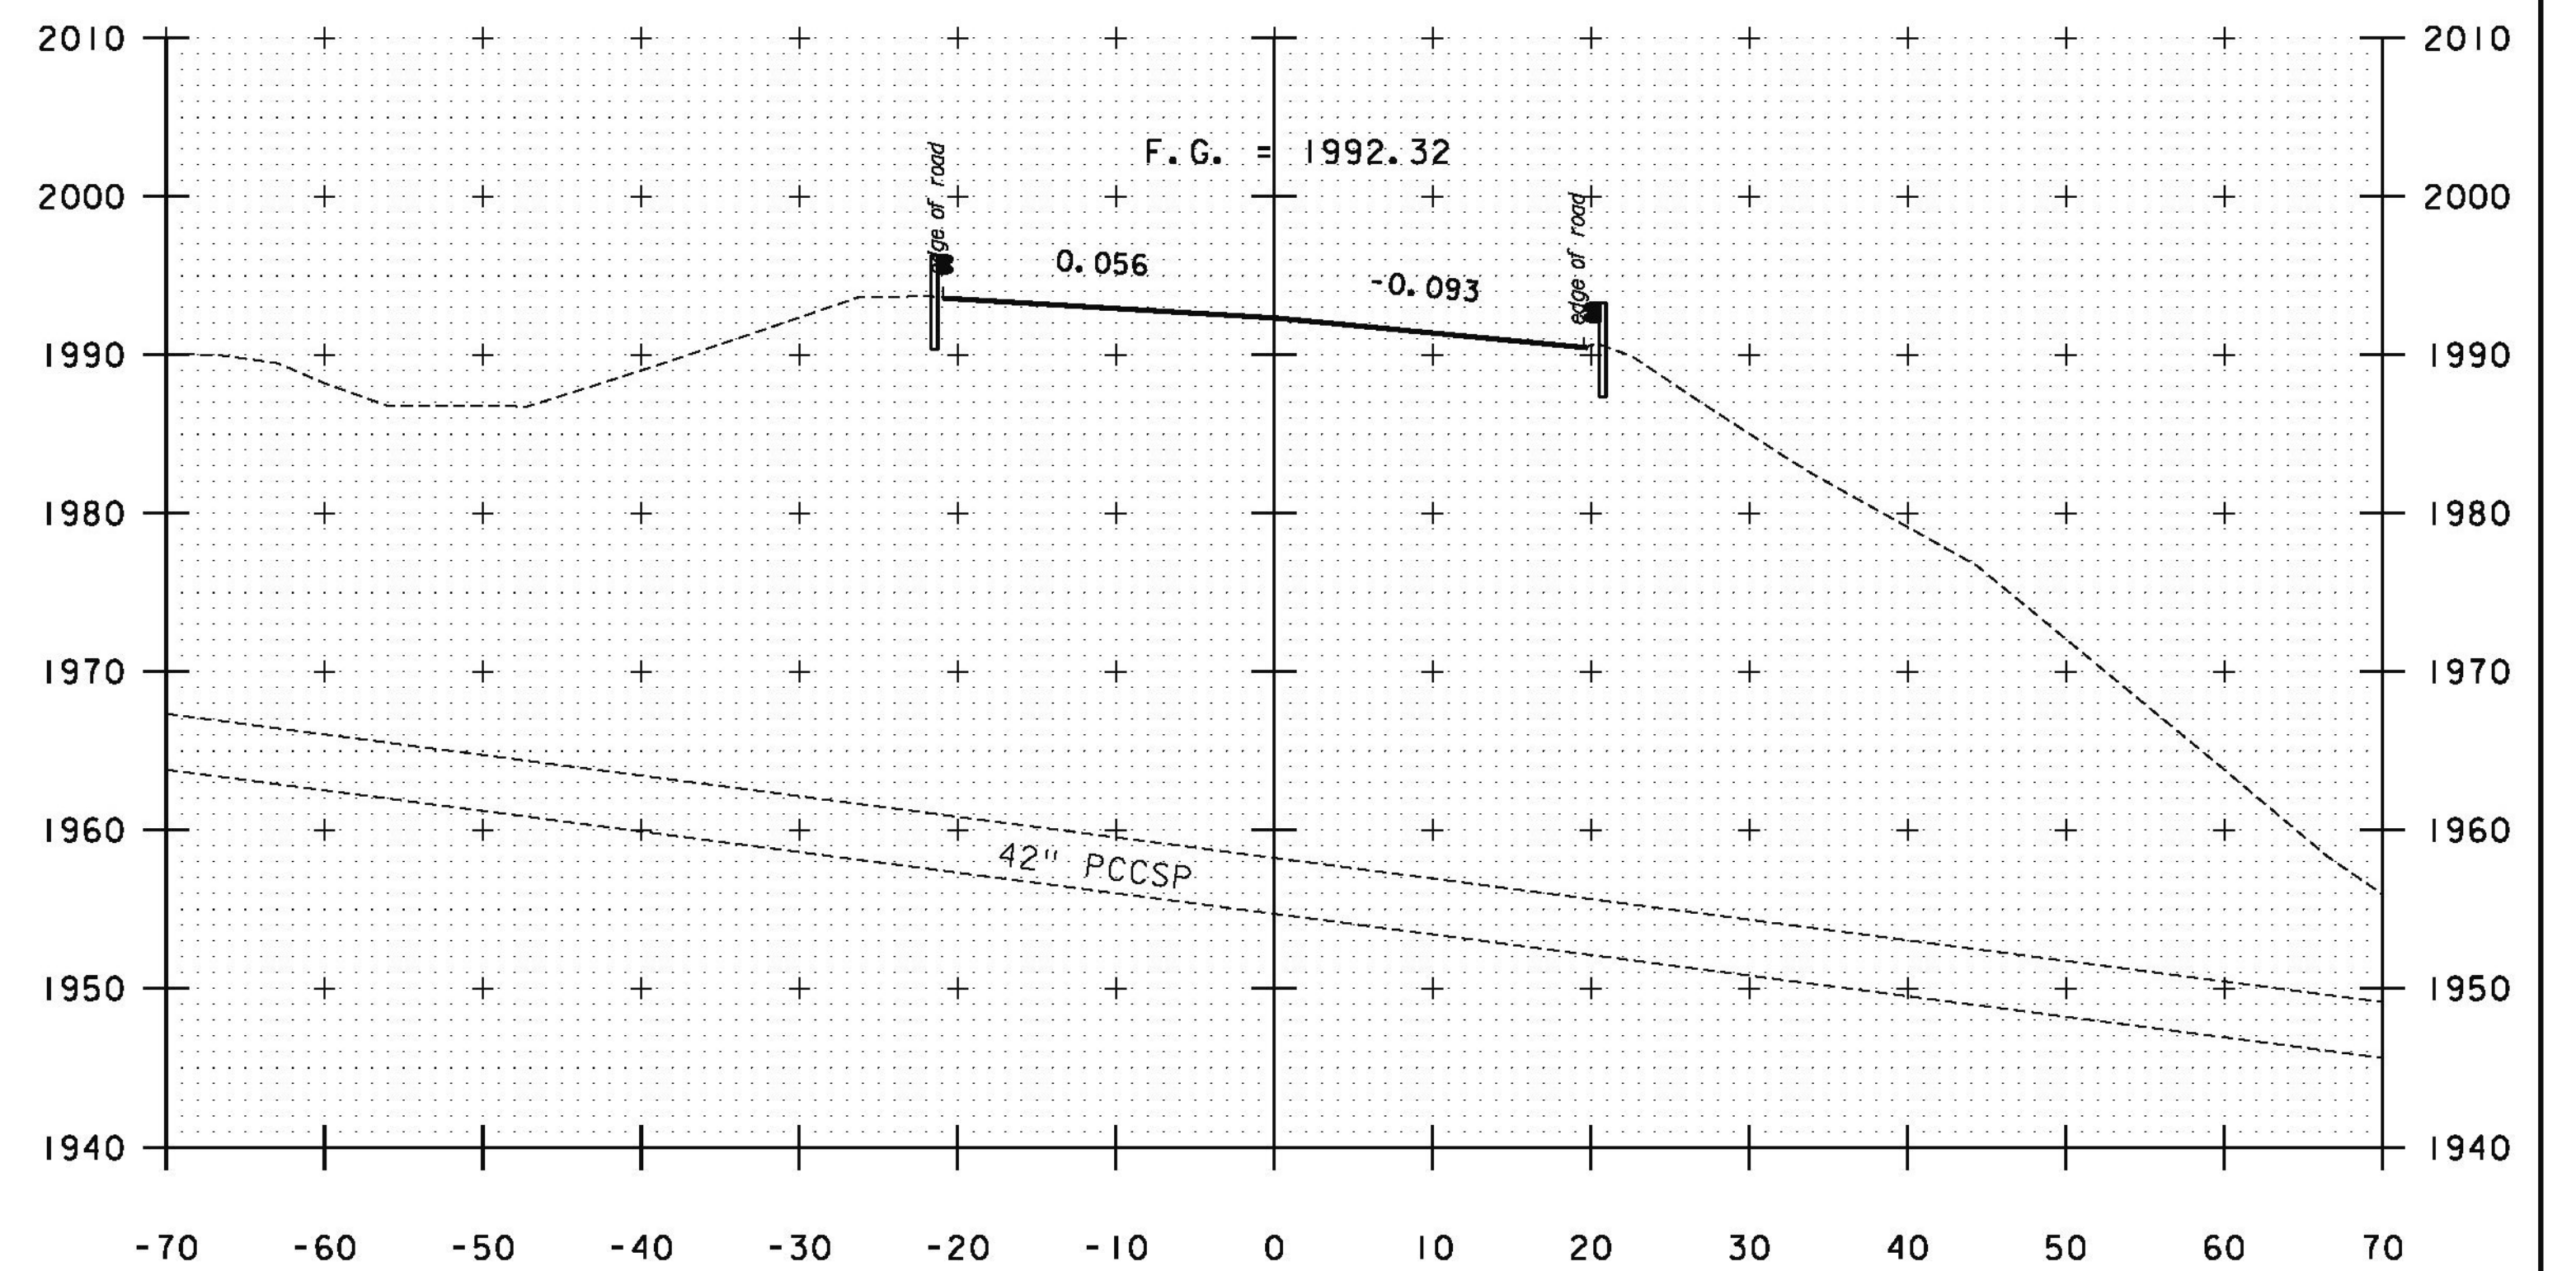

32+64.55

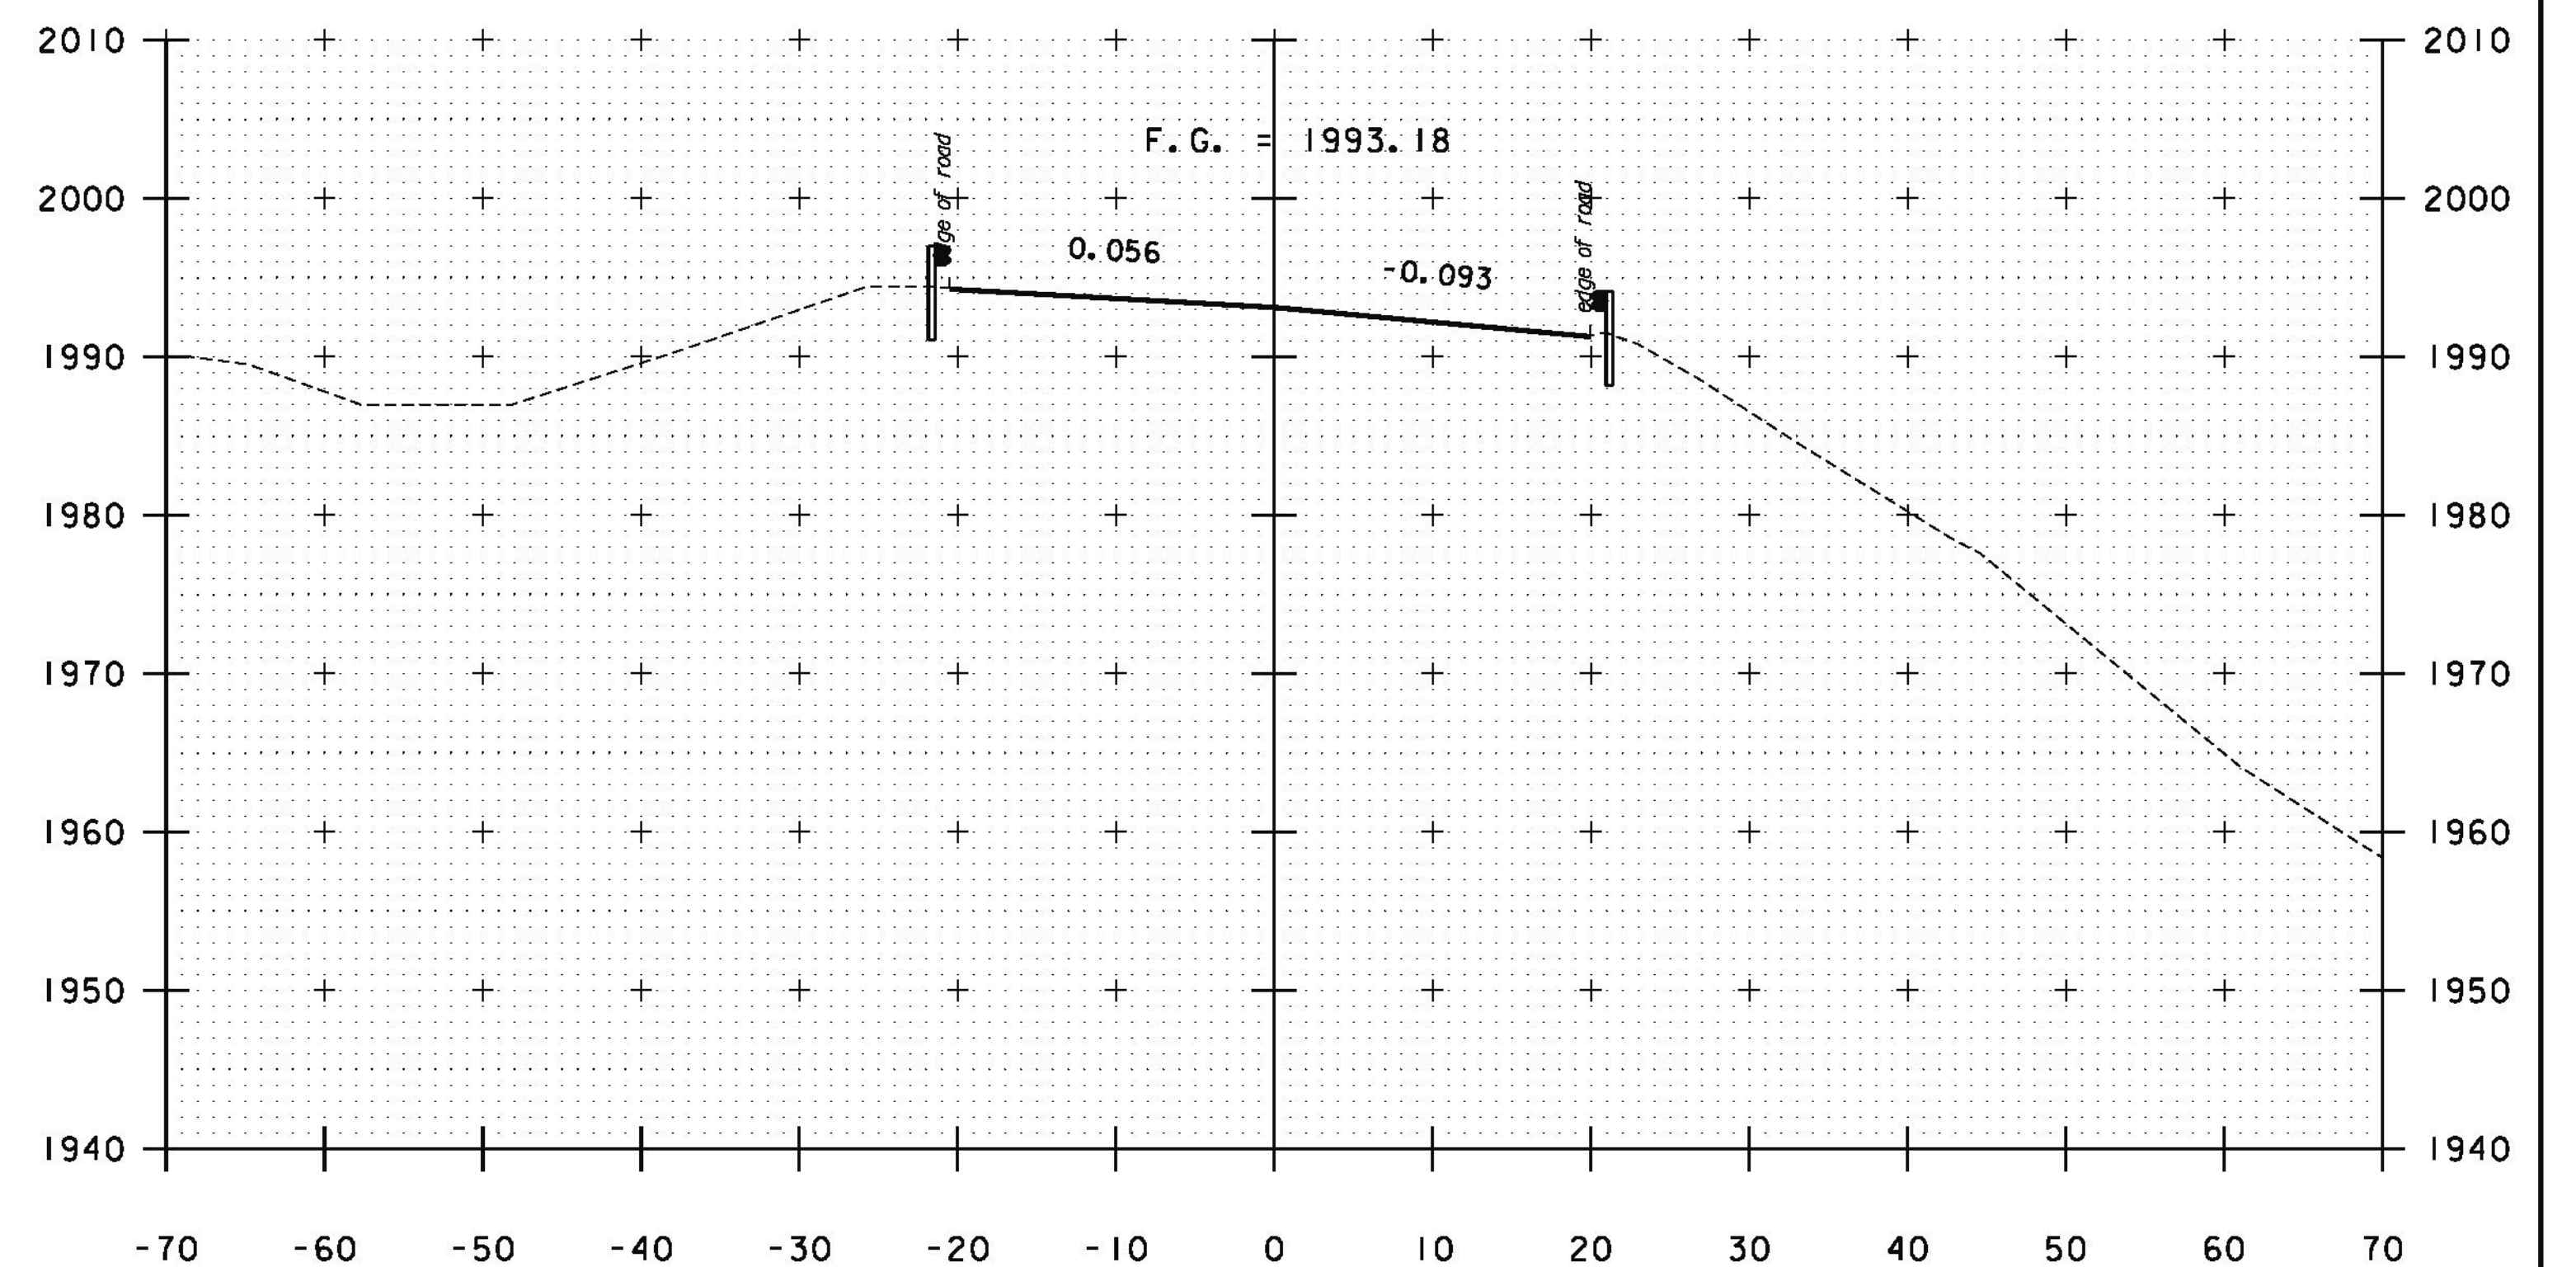

32+50

STA. 32+00 TO STA. 32+64.55

PROJECT NAME:	PERU	PLOT DATE:	12/31/2014
PROJECT NUMBER:	STP SCRP(4)	DRAWN BY:	M. BRADLEY
FILE NAME:	z07bi06xsl.dgn	DESIGNED BY:	M. BRADLEY
PROJECT LEADER:	E. ATKINS	CHECKED BY:	E. ATKINS
CROSS SECTION SHEET 1		SHEET	38 OF 45