




33+35.16 END APPROACH
BEGIN PERU STP SCRP (4)

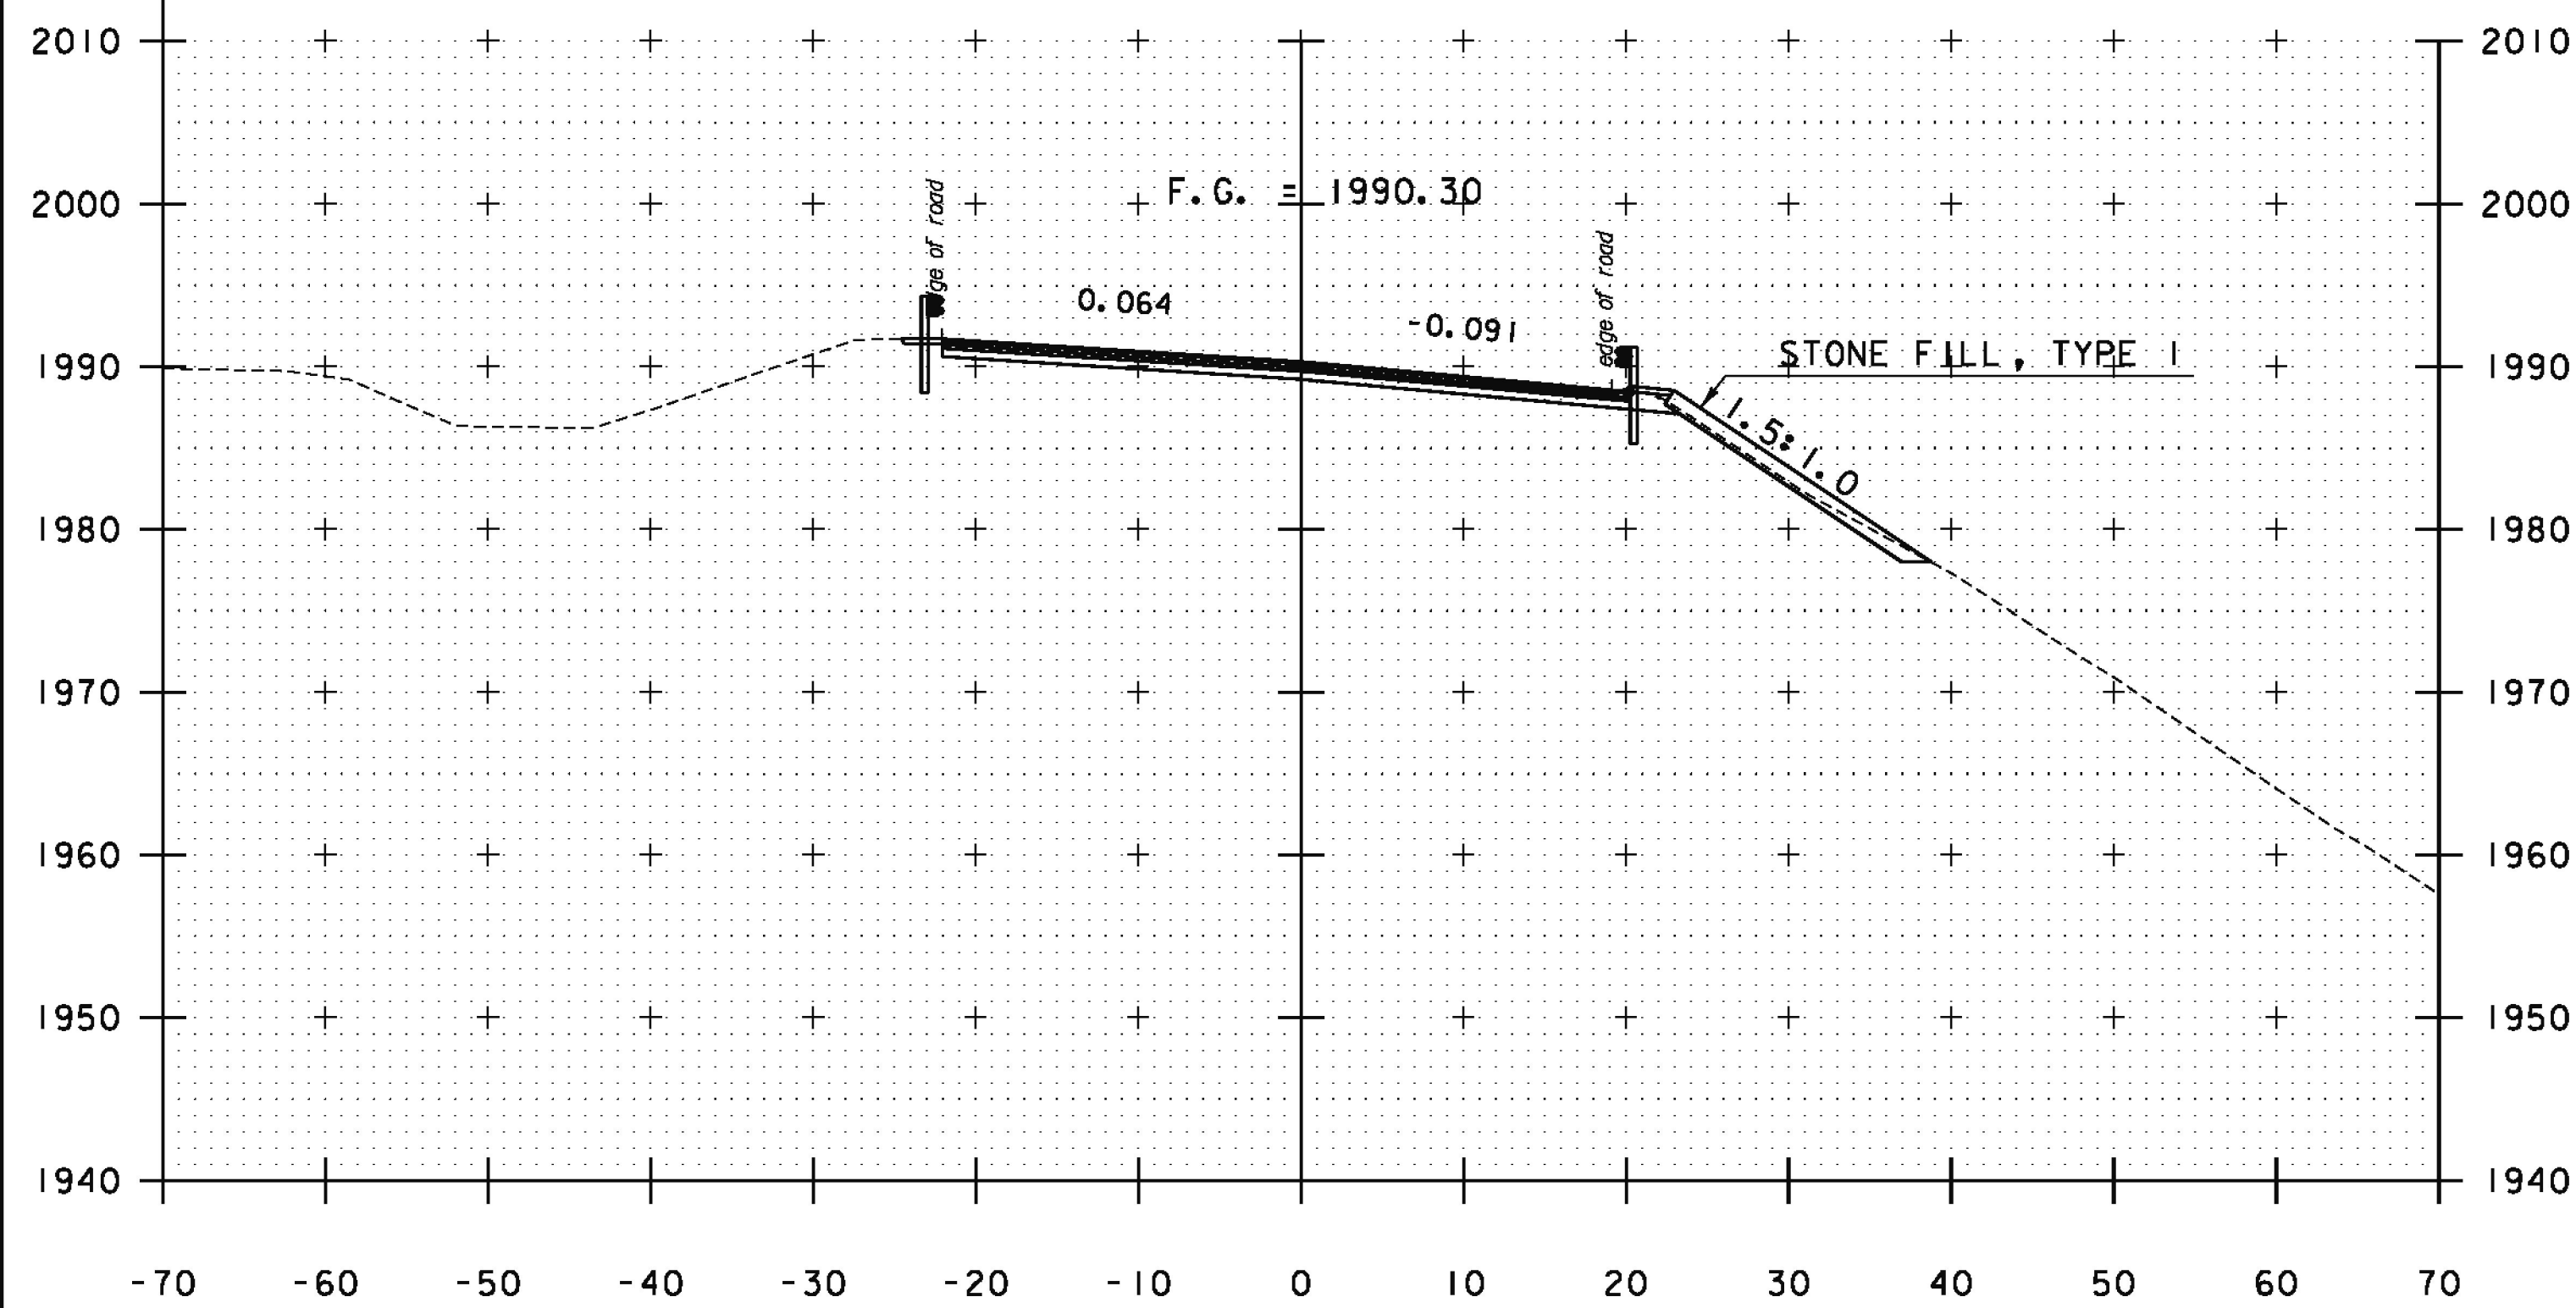


33+00

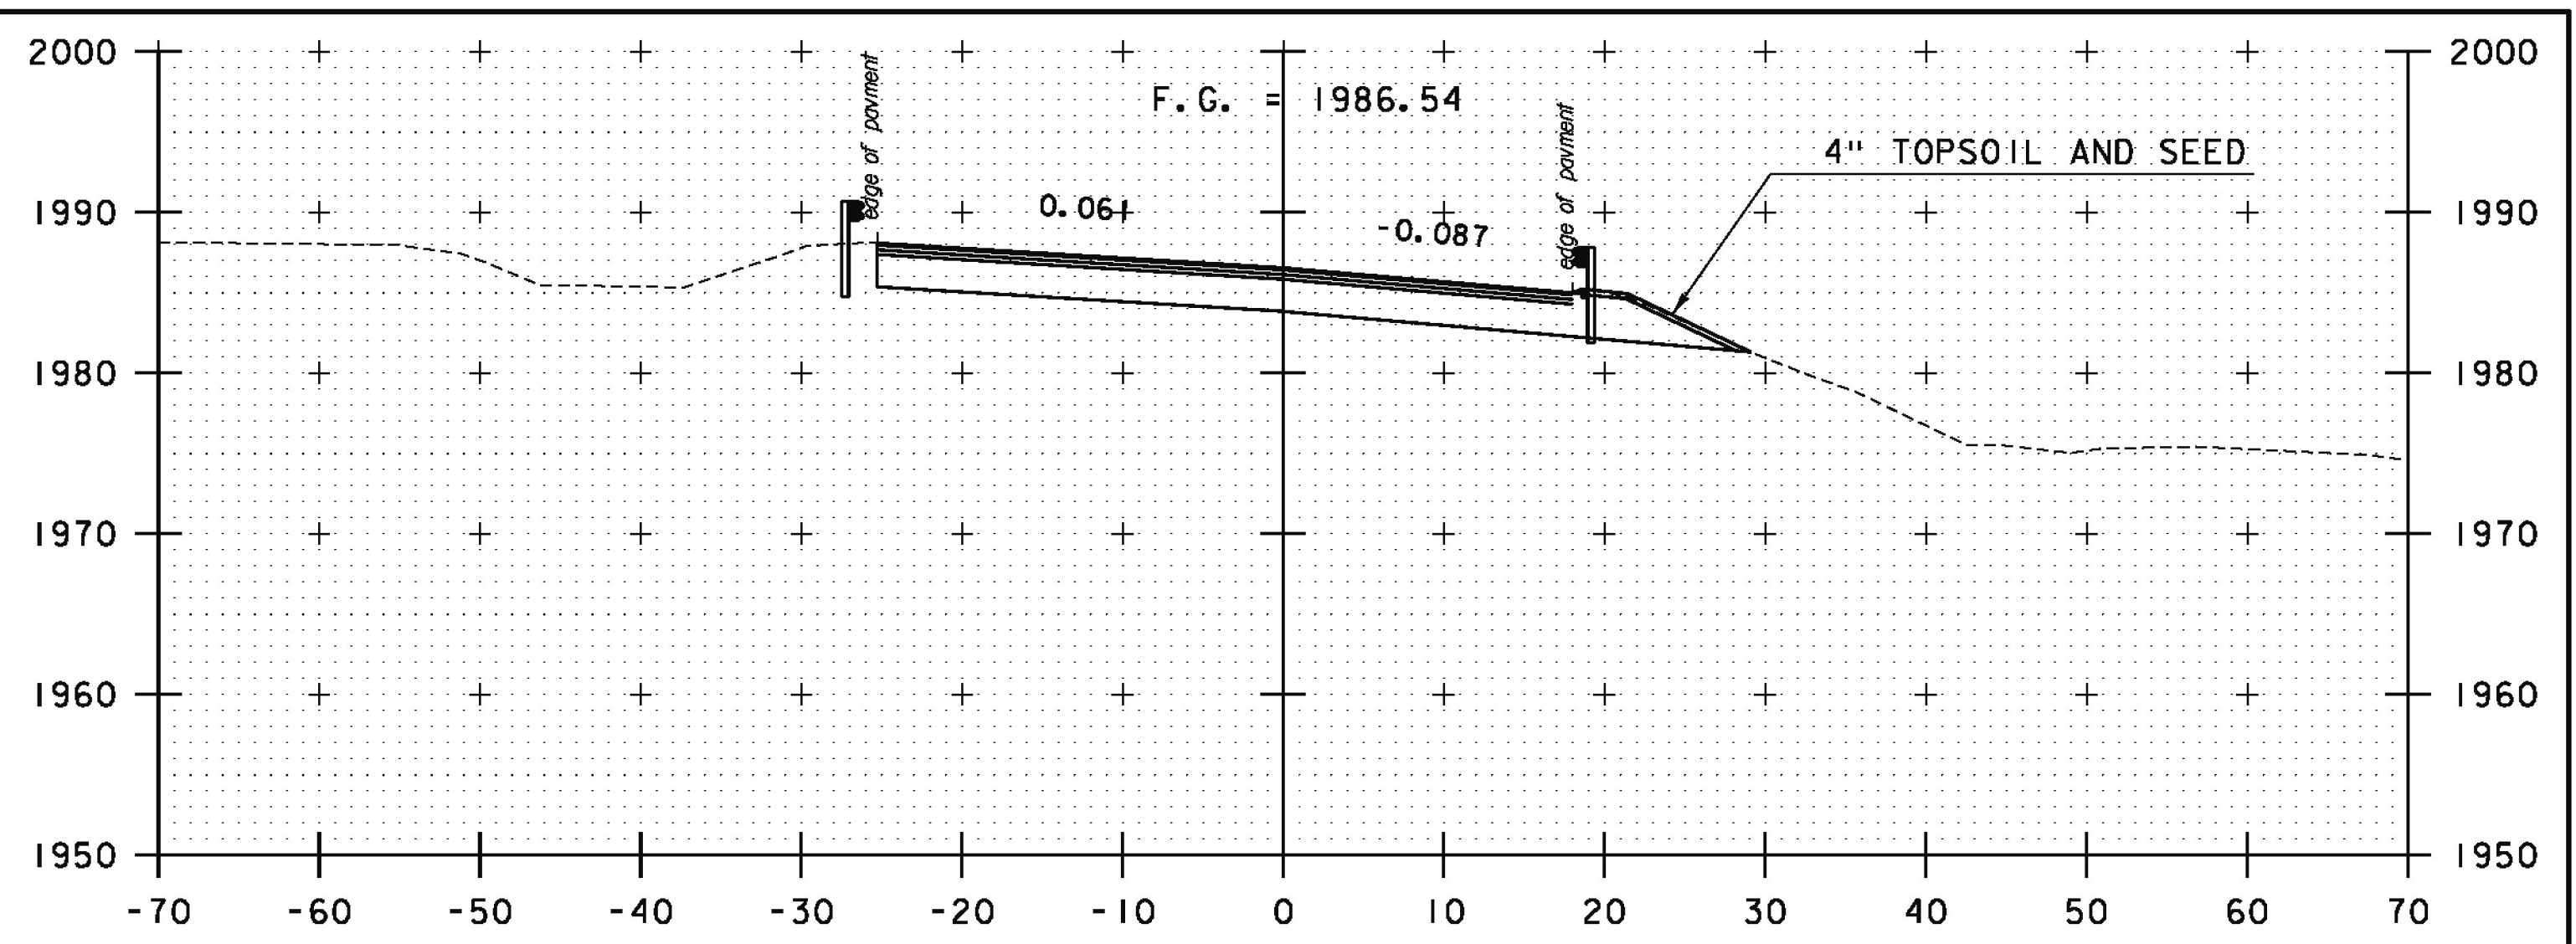

33+79.16 END PERU STP SCRP (4)
BEGIN APPROACH

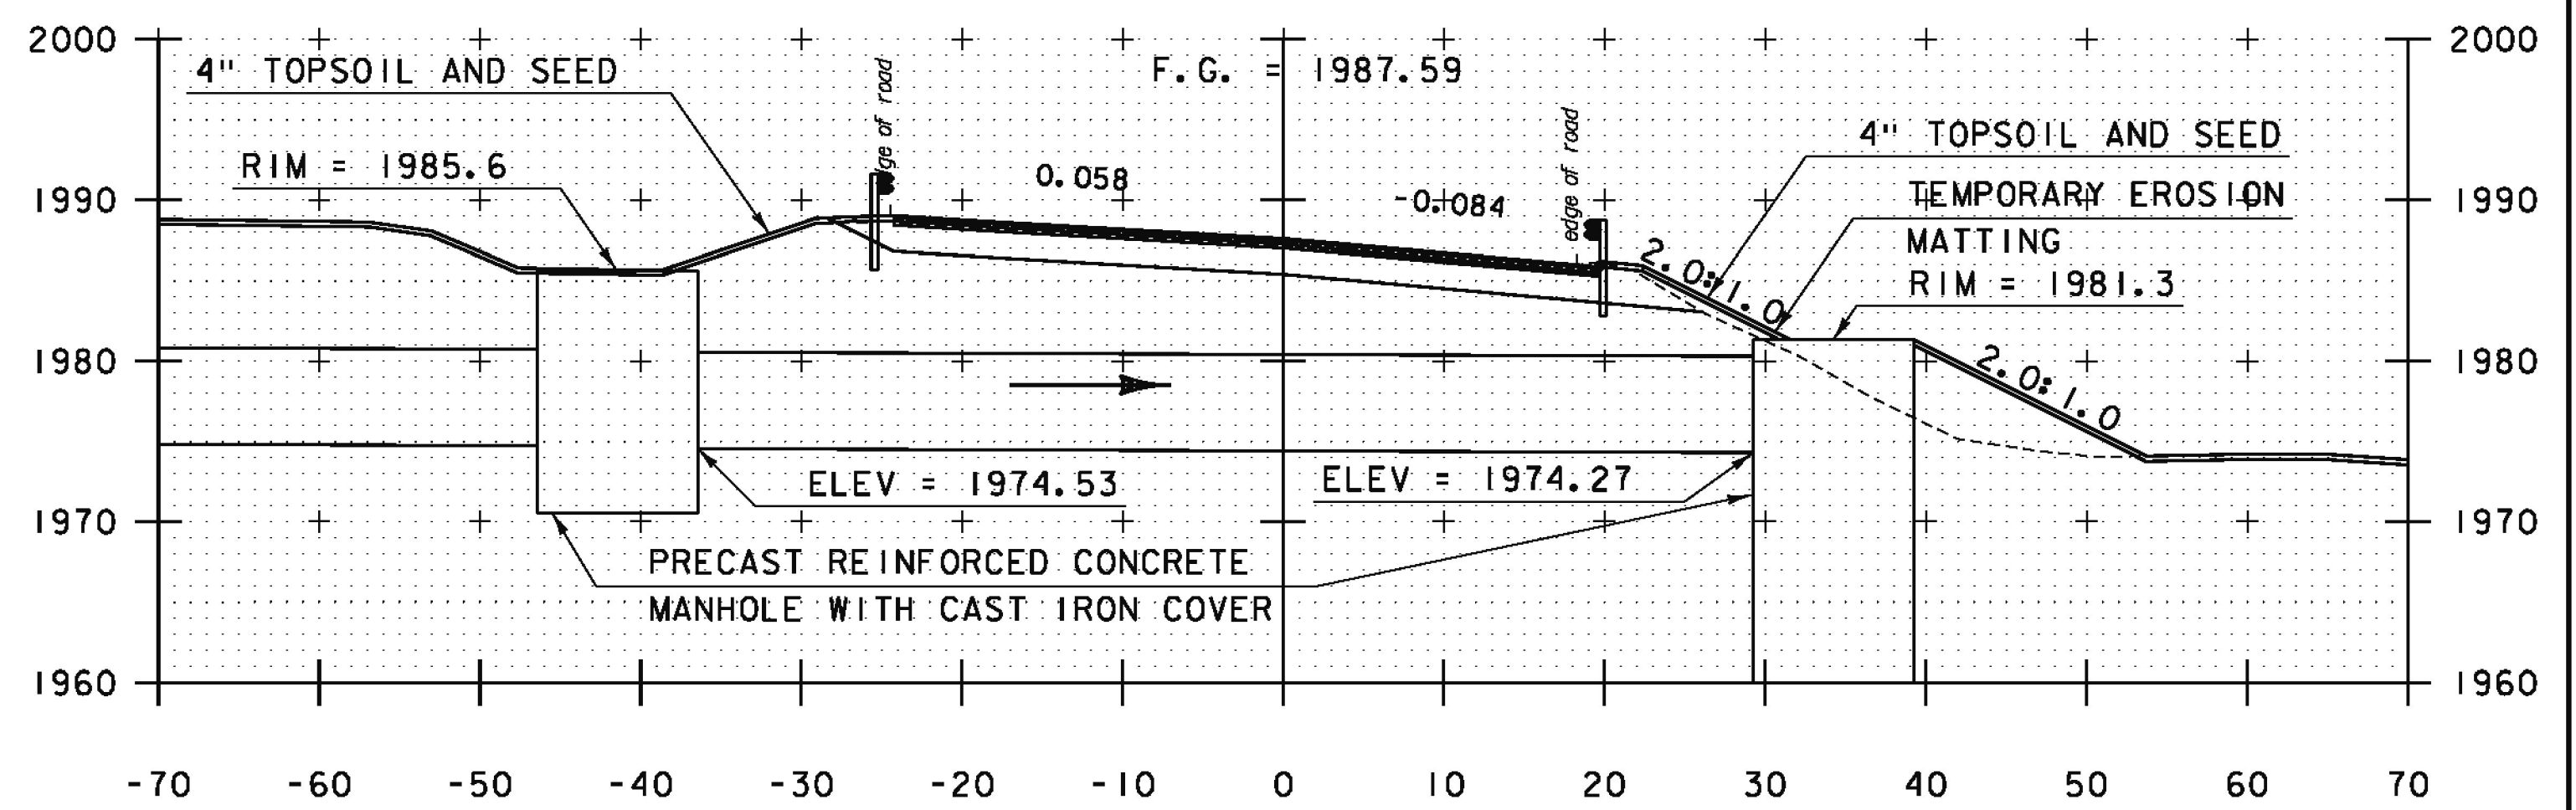

33+57 SPECIAL PROVISION (72" PCCSP/CAAP)
SKEWED 91° 1' 48.00"

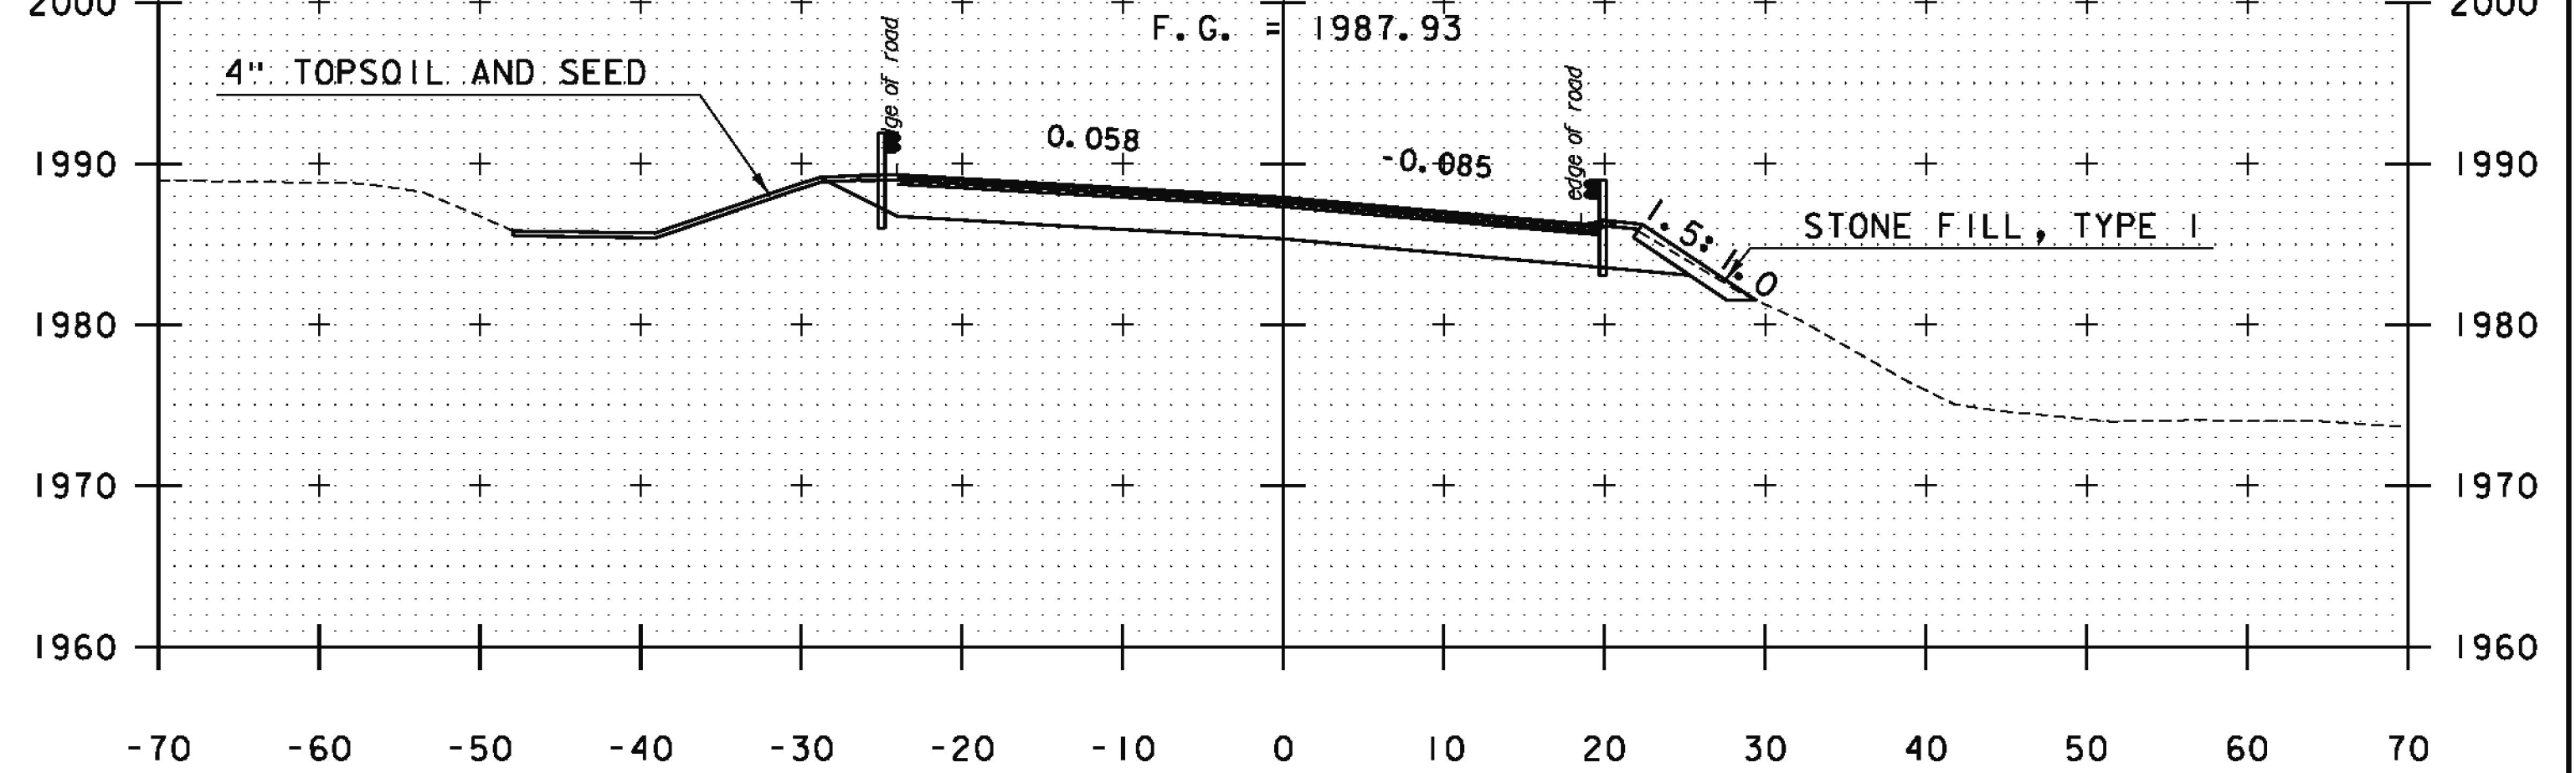

33+50

STA. 33+00 TO STA. 33+79.16

PROJECT NAME: PERU	PLOT DATE: 12/31/2014
PROJECT NUMBER: STP SCRP(4)	DRAWN BY: M. BRADLEY
FILE NAME: z07b106xsl.dgn	CHECKED BY: E. ATKINS
PROJECT LEADER: E. ATKINS	SHEET 39 OF 45
DESIGNED BY: M. BRADLEY	
CROSS SECTION SHEET 2	

