




34+91.66 END APPROACH

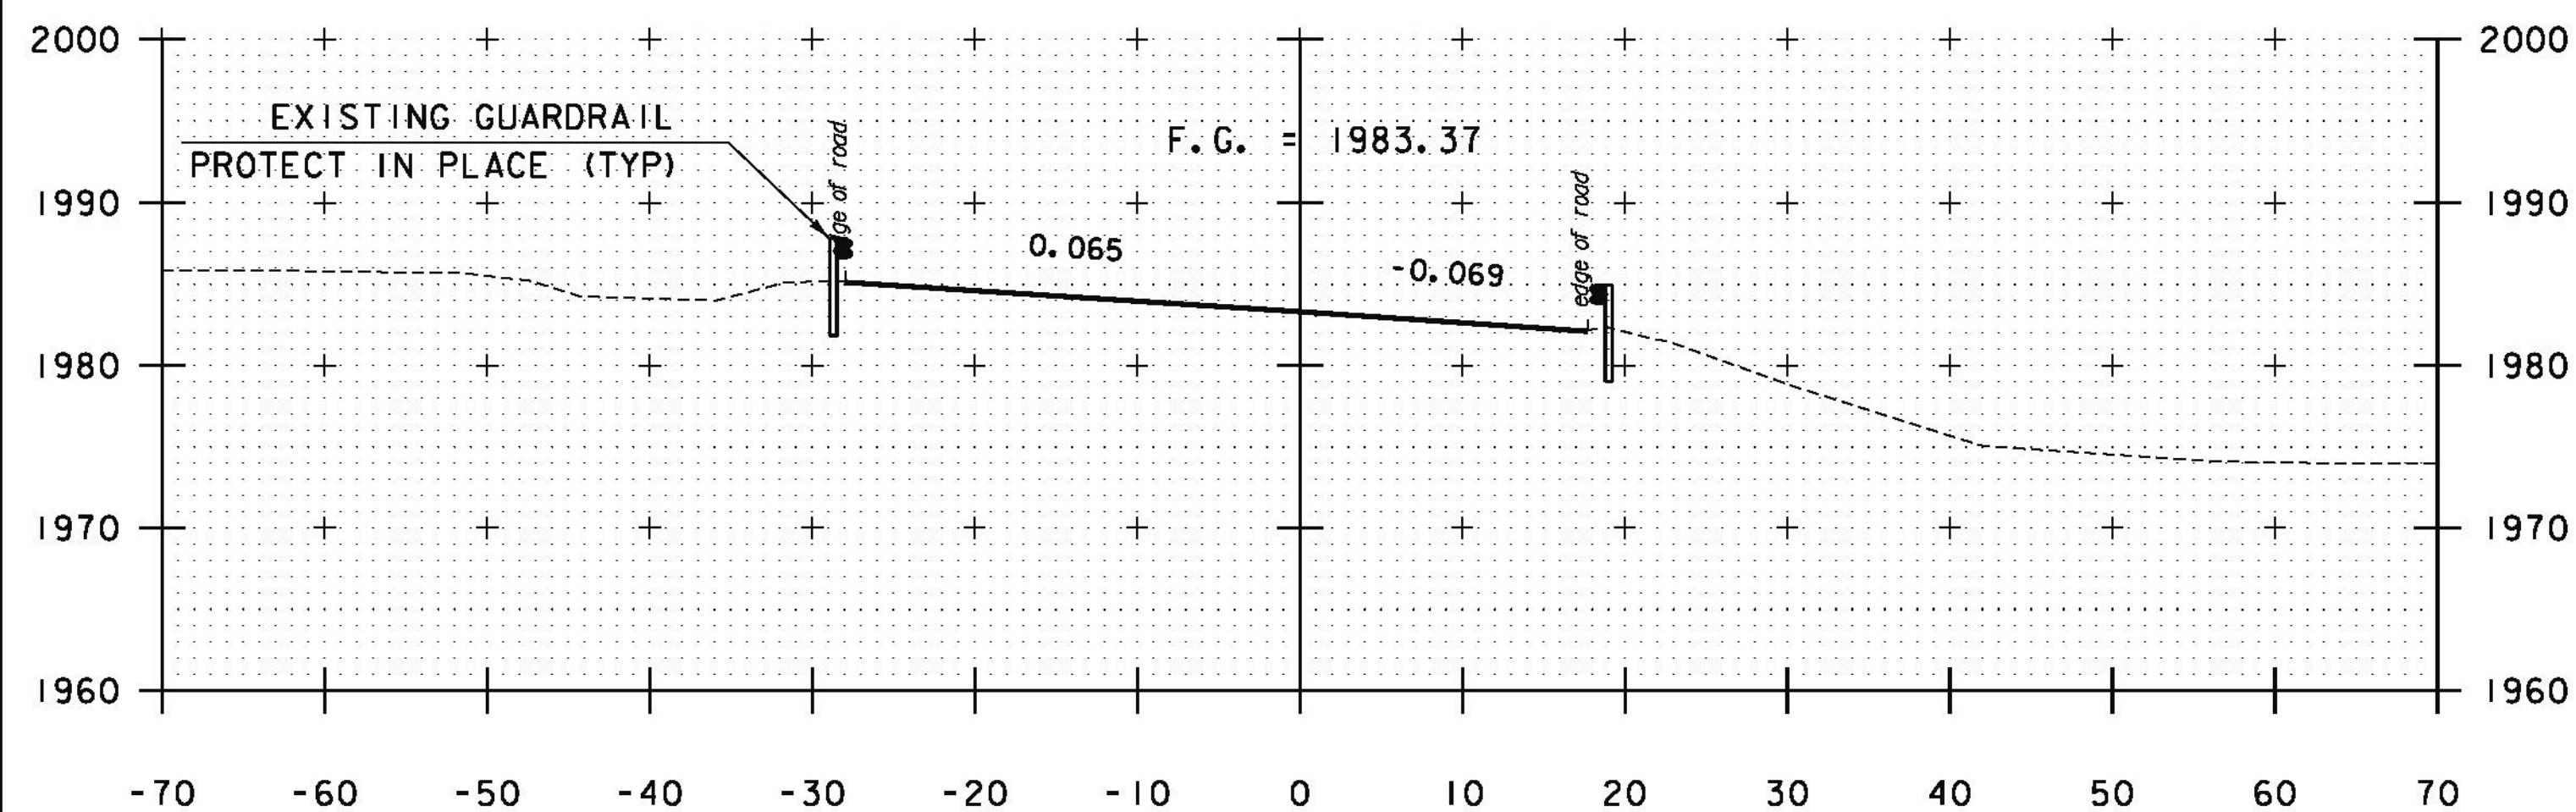

34+50

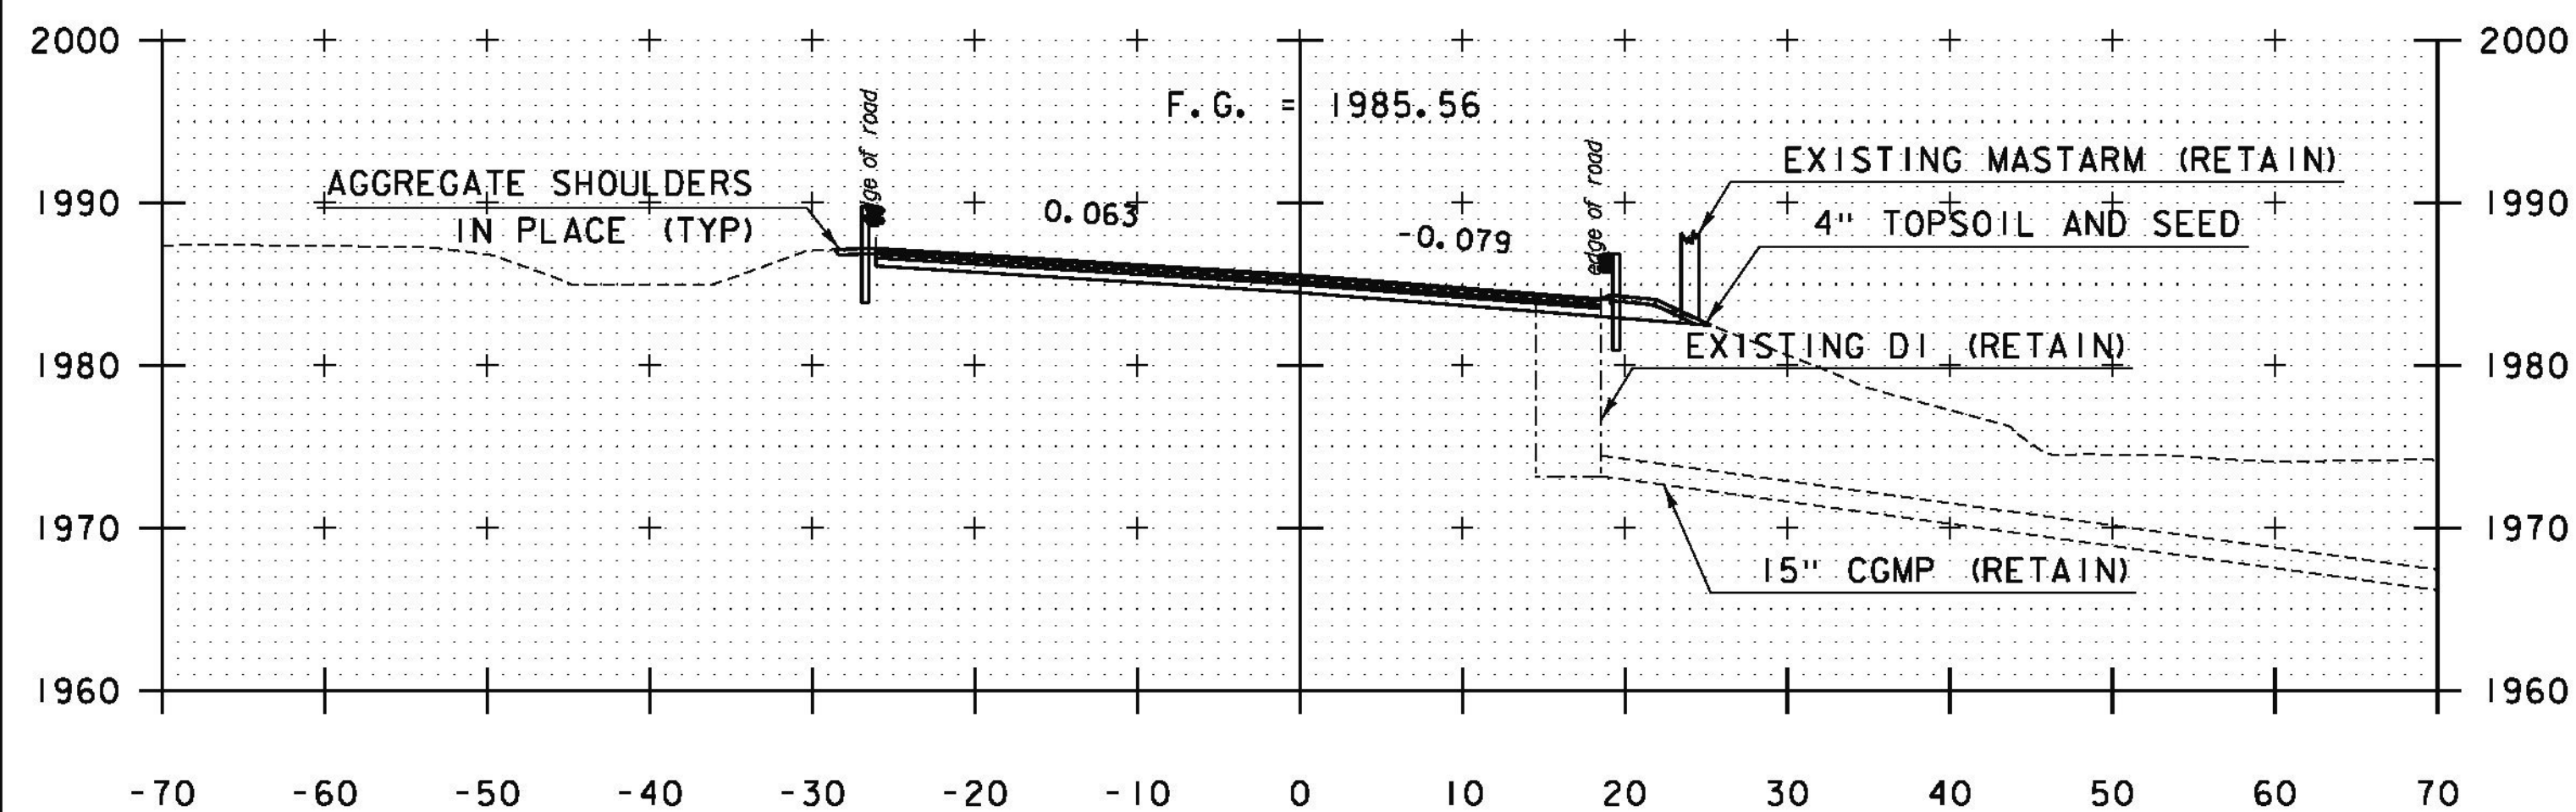

34+00

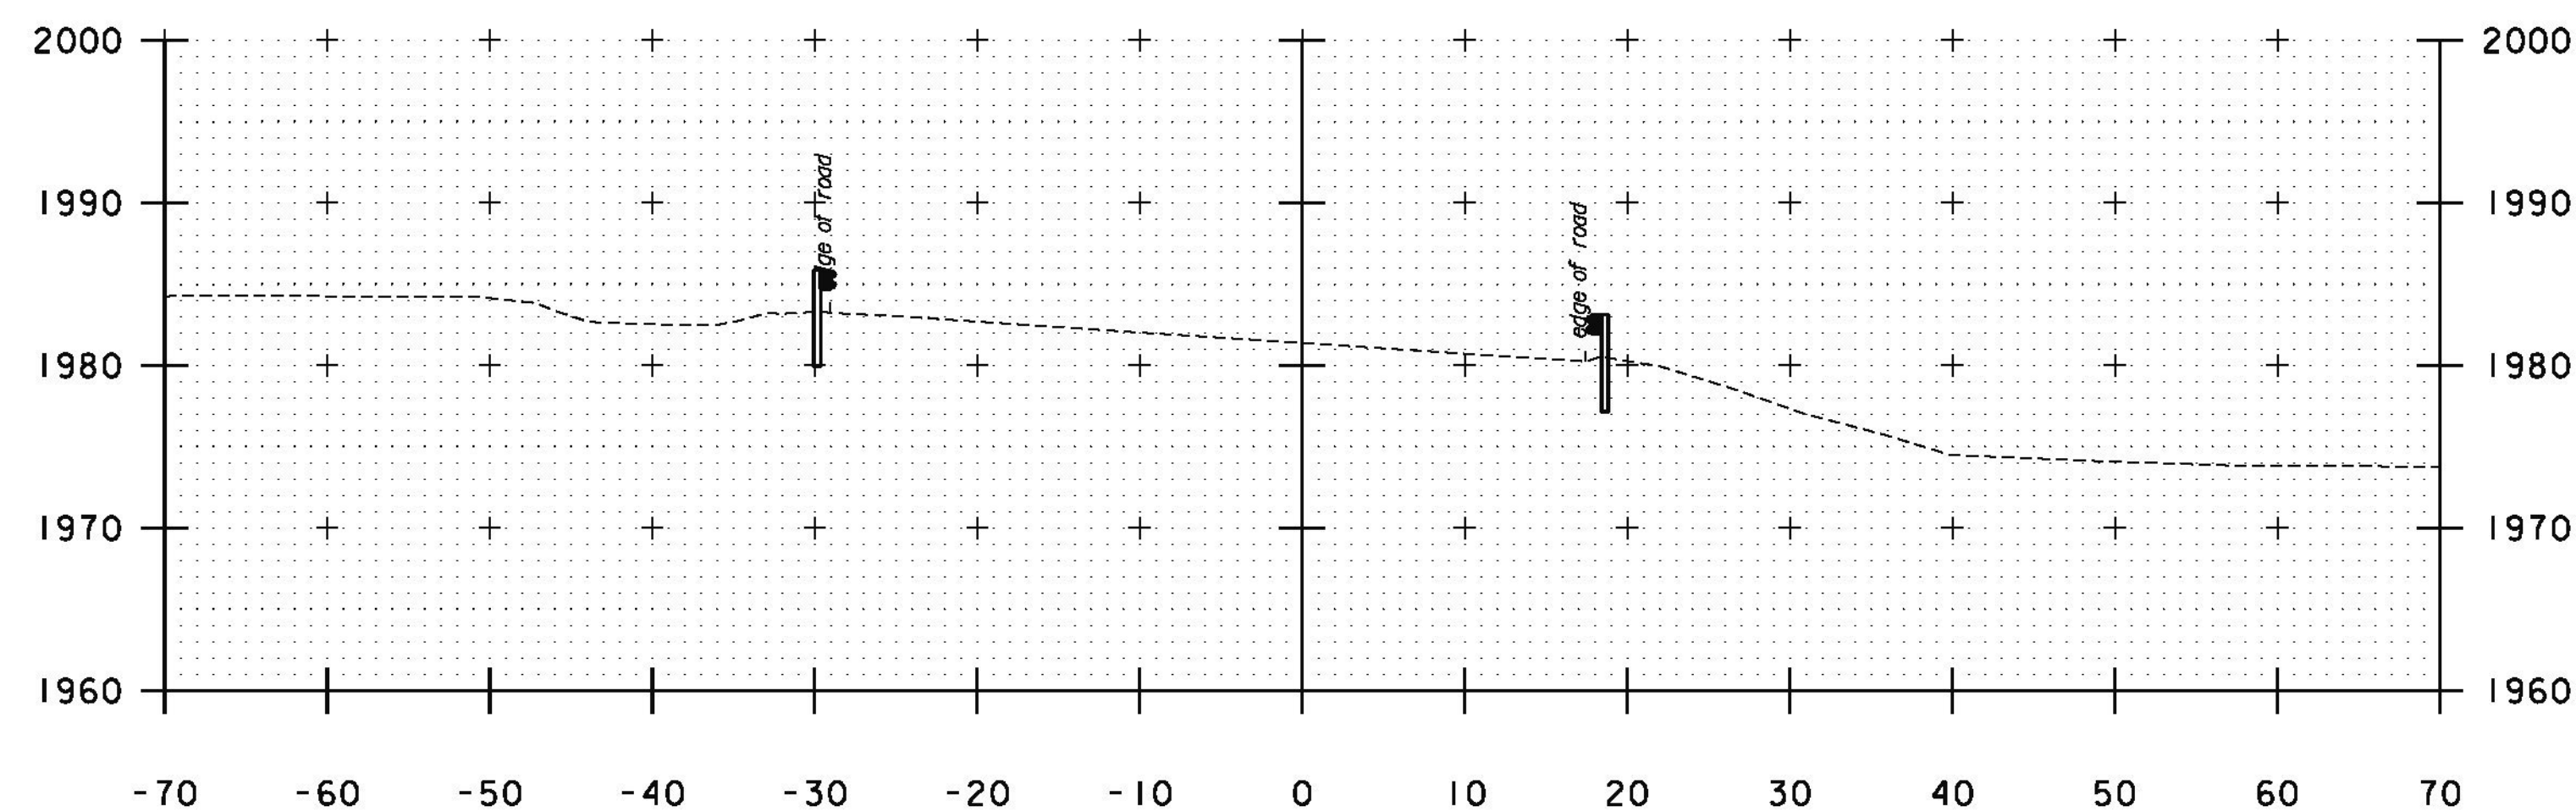

35+00

STA. 34+00 TO STA. 35+00

PROJECT NAME: PERU	PLOT DATE: 12/31/2014
PROJECT NUMBER: STP SCRP(4)	DRAWN BY: M. BRADLEY
FILE NAME: z07bi06xsl.dgn	CHECKED BY: E. ATKINS
PROJECT LEADER: E. ATKINS	SHEET 40 OF 45
DESIGNED BY: M. BRADLEY	
CROSS SECTION SHEET 3	