



Profis Anchor 2.7.5

www.hilti.us

Company: Waterman Industries
 Specifier: Amanuel Wubneh P.E.
 Address: 25500 Road 204
 Phone | Fax: (800) 331-0808 | (559) 562-8629
 E-Mail: amanuel.wubneh@watermanusa.com

Page: 9
 Project: Renaud Bros, Inc.
 Sub-Project | Pos. No.: RB-17-0351 Rev.1
 Date: 11/7/2017


7 Installation data

Anchor plate, steel: -
 Profile: no profile
 Hole diameter in the fixture: $d_f = 0.813$ in.
 Plate thickness (input): 1.000 in.
 Recommended plate thickness: not calculated
 Drilling method: Hammer drilled
 Cleaning: Compressed air cleaning of the drilled hole according to instructions for use is required

Anchor type and diameter: HIT-RE 500 V3 + HAS-R 316 SS 3/4
 Installation torque: 1200.000 in.lb
 Hole diameter in the base material: 0.875 in.
 Hole depth in the base material: 14.000 in.
 Minimum thickness of the base material: 15.750 in.

7.1 Recommended accessories

Drilling	Cleaning	Setting
<ul style="list-style-type: none"> Suitable Rotary Hammer Properly sized drill bit 	<ul style="list-style-type: none"> Compressed air with required accessories to blow from the bottom of the hole Proper diameter wire brush 	<ul style="list-style-type: none"> Dispenser including cassette and mixer Torque wrench

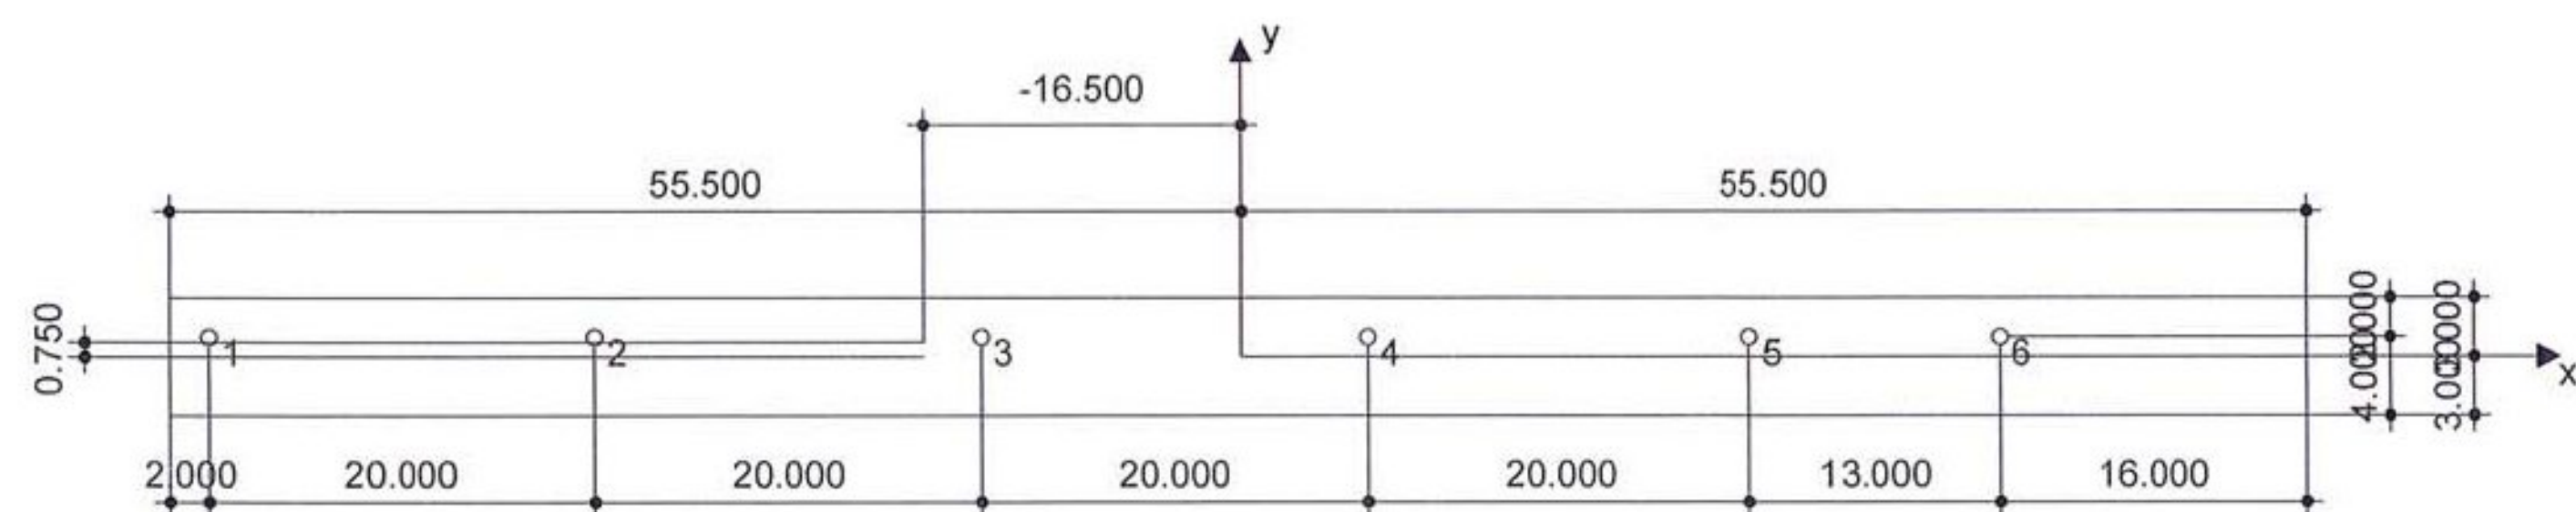

Approved AsNoted

BY: Ken Upmal
 DATE: 11/29/2017
 RESUBMIT: NO
 RECEIVED: November 13, 2017
 CTD BY: DV/BK (Green Int'l)

STATE OF VERMONT
 AGENCY OF TRANSPORTATION

Coordinates Anchor in.

Anchor	x	y	C-x	C+y	C-y	C+yy	Anchor	x	y	C-x	C+y	C-y	C+yy
1	-53.500	1.000	-	-	4.000	-	4	6.500	1.000	-	-	4.000	-
2	-33.500	1.000	-	-	4.000	-	5	26.500	1.000	-	-	4.000	-
3	-13.500	1.000	-	-	4.000	-	6	39.500	1.000	-	-	4.000	-

Input data and results must be checked for agreement with the existing conditions and for plausibility!
 PROFIS Anchor (c) 2003-2009 Hilti AG, FL-9494 Schaan Hilti is a registered Trademark of Hilti AG, Schaan