

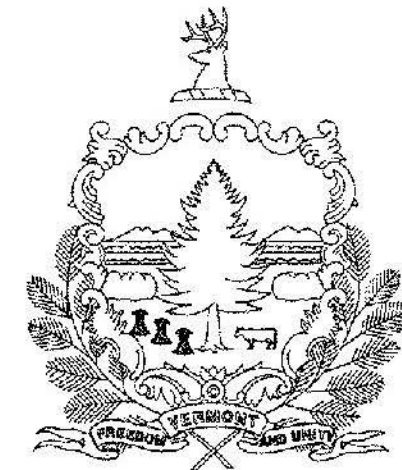


STATE OF VERMONT AGENCY OF TRANSPORTATION

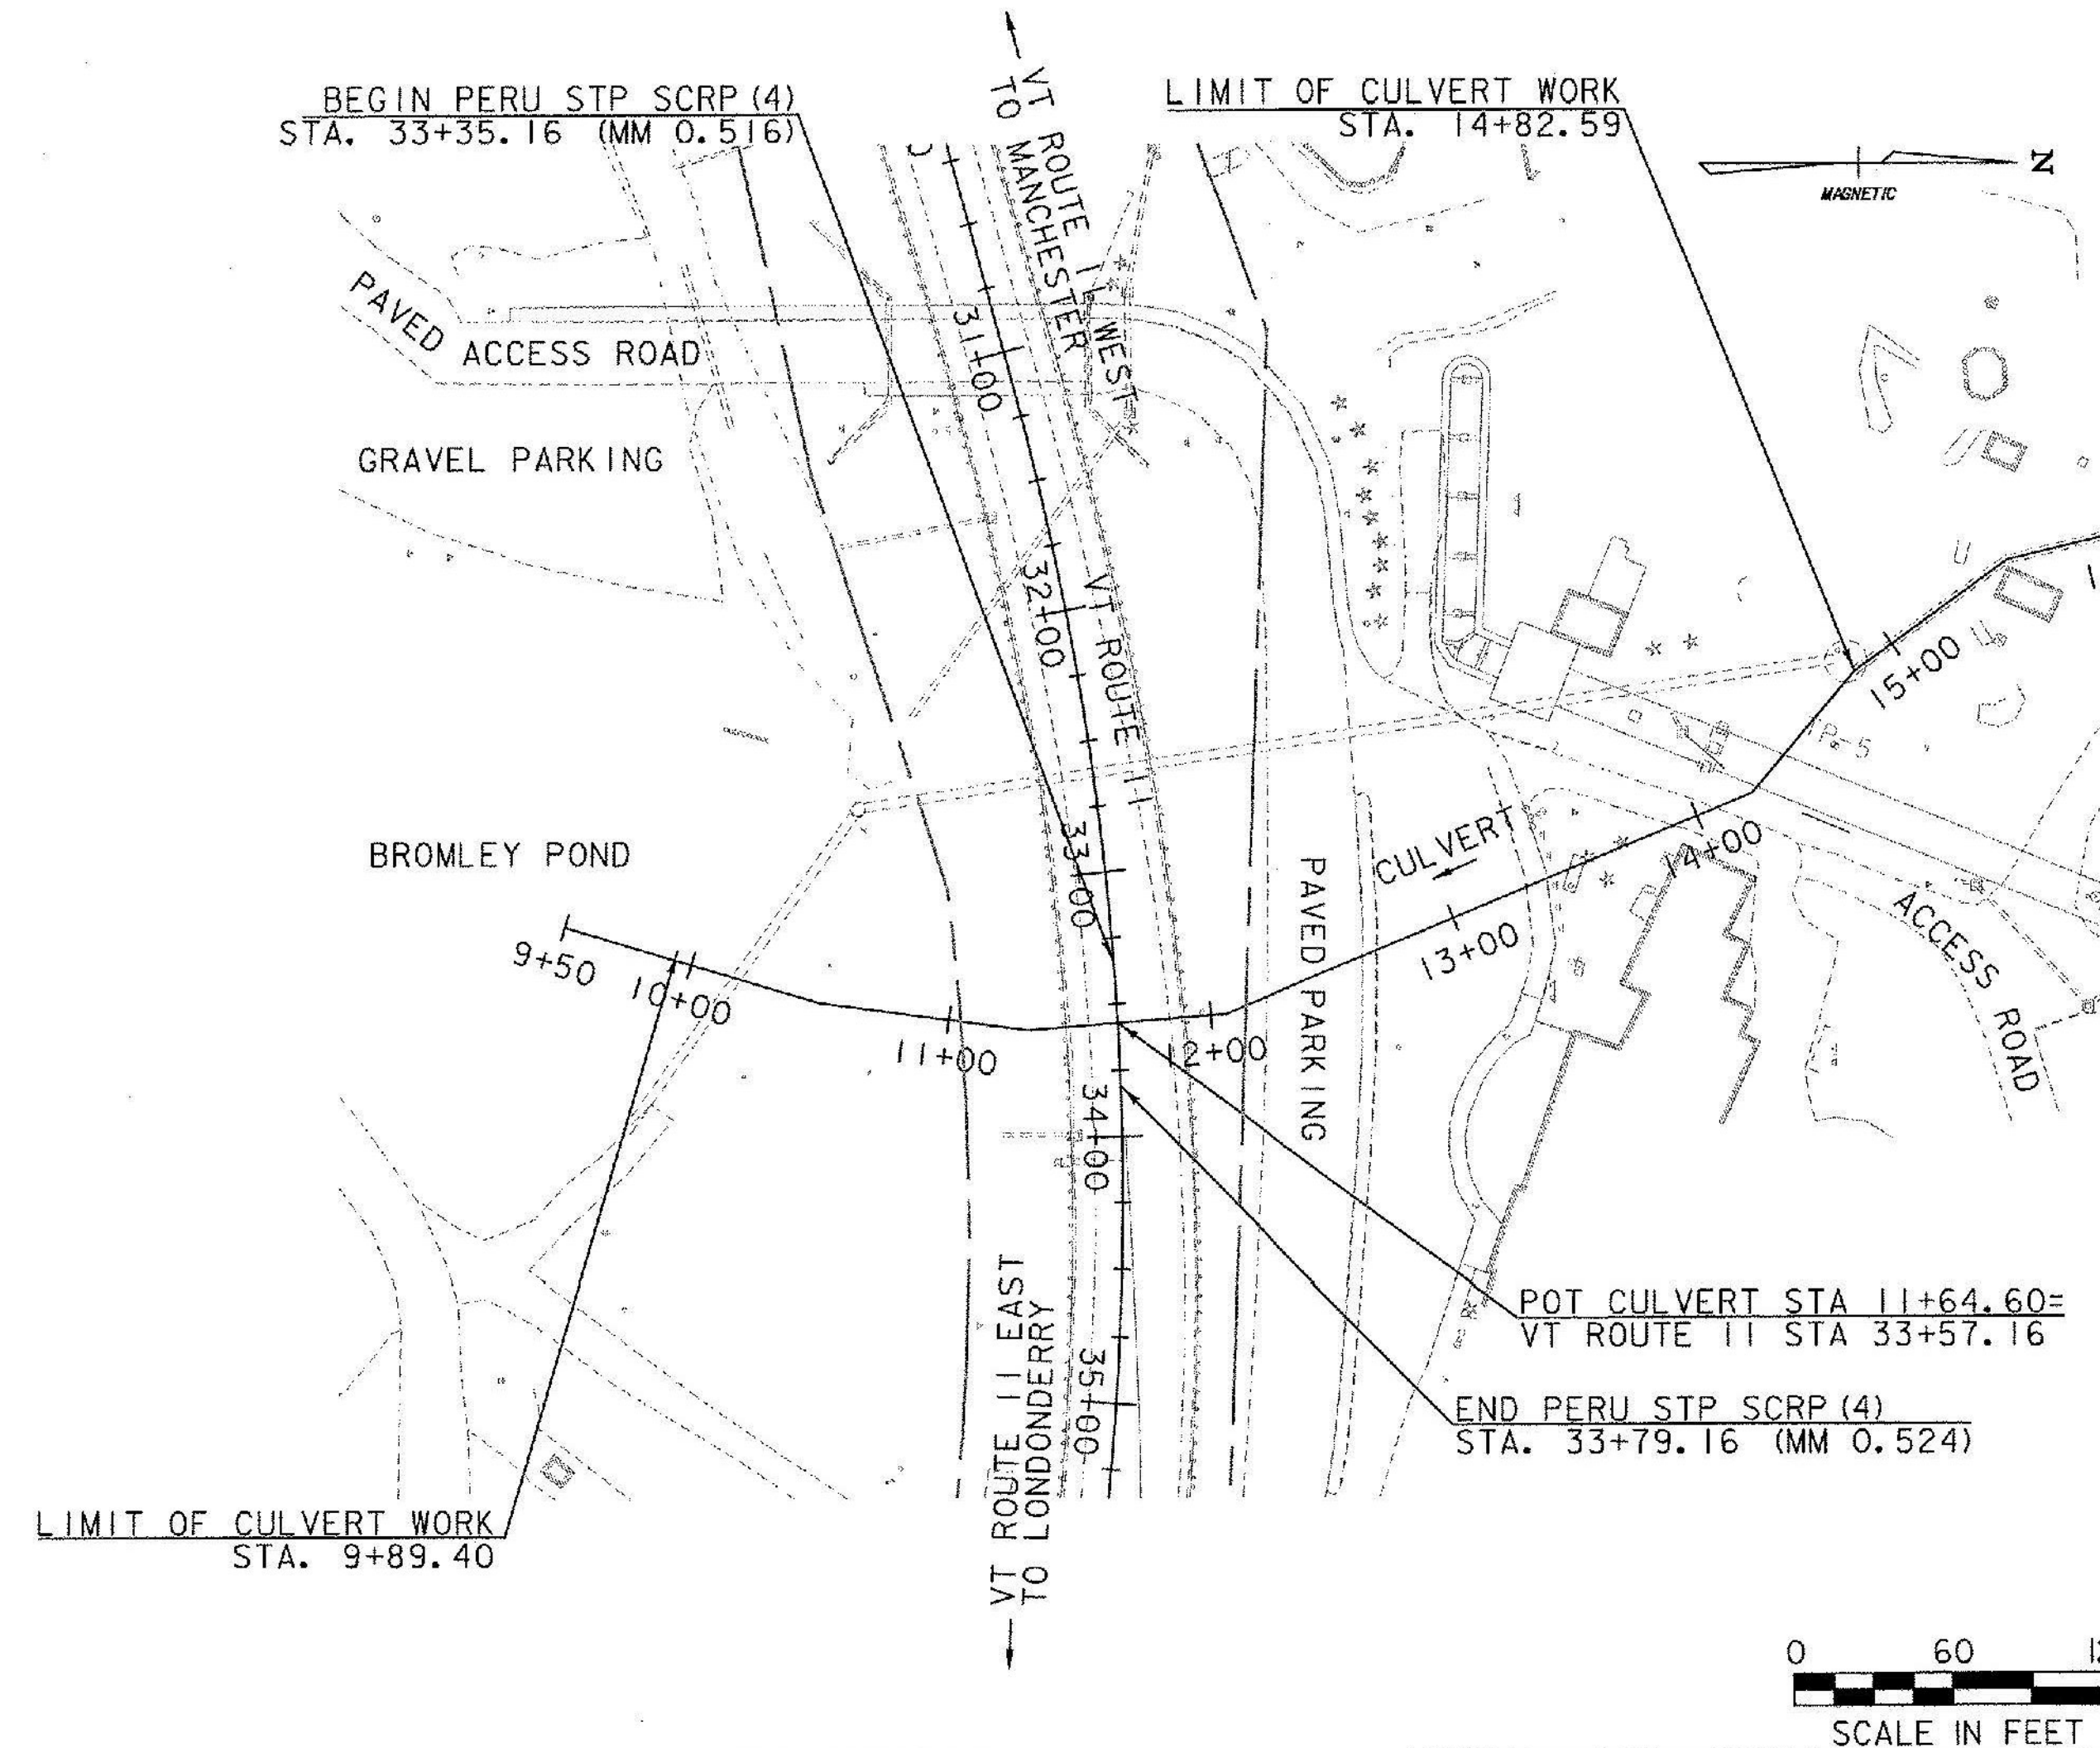

PROPOSED IMPROVEMENT TOWN OF PERU COUNTY OF BENNINGTON VT ROUTE 11 (MINOR ARTERIAL)

PROJECT LOCATION: BEGINNING IN THE TOWN OF PERU ON VT ROUTE 11 AT STATION 33+35.16 (MM 0.516) AND EXTENDING
EASTERLY 44.00 FEET (0.008 MILE) TO STATION 33+79.16 (MM 0.524)
LENGTH OF PROJECT = 44.00 FEET (0.008 MILE)
LENGTH OF CULVERT WORK = 493.19 FEET (0.093 MILE)
PROJECT DESCRIPTION: ABANDON EXISTING CULVERT, CONSTRUCTION OF A NEW CULVERT AND APPURTENANT ROADWAY WORK.

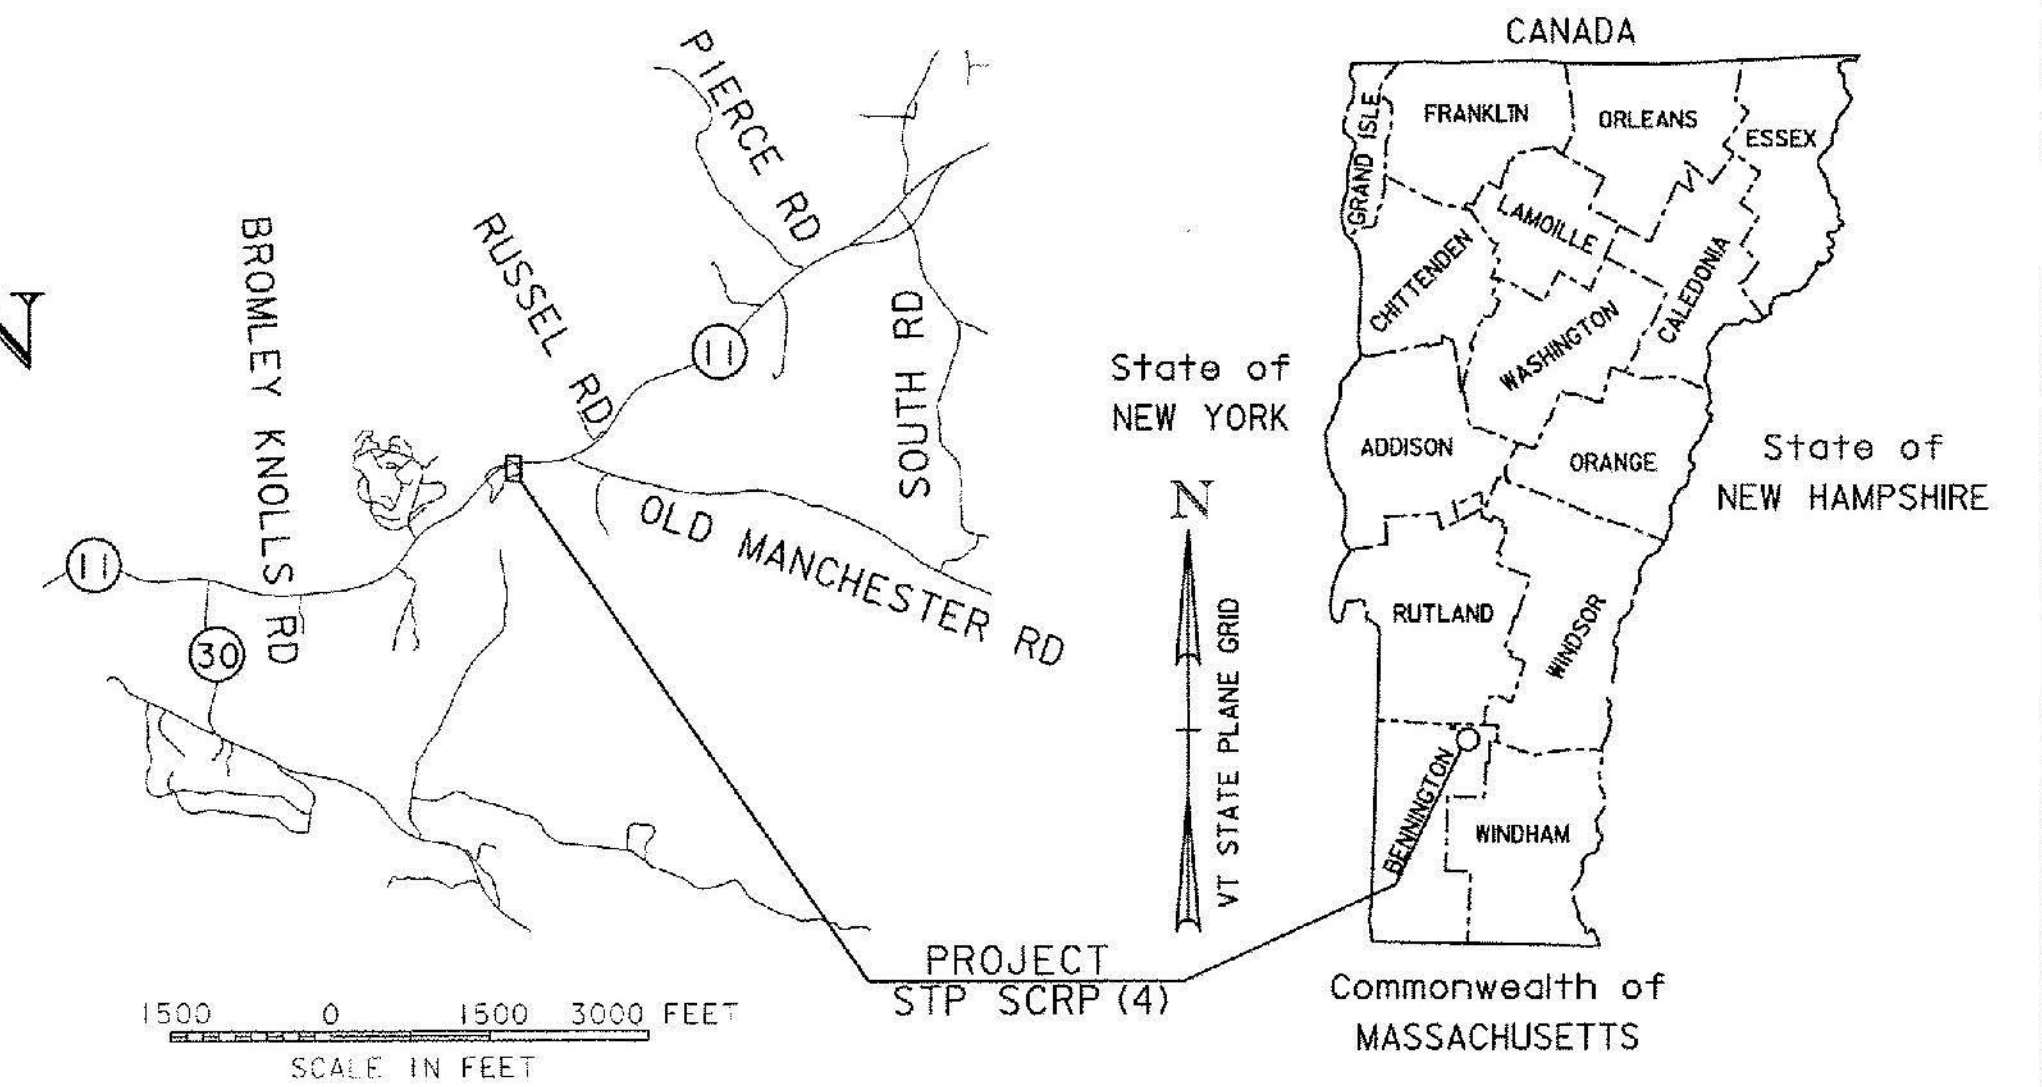

Record Plans

Contractor: RENAUD BROTHERS, INC.
Resident Engineer: RONALD LEMAIRE (2015 - 2017) / JUDY GILMORE (2018)
Construction Began: JUNE 2, 2015
Construction Complete: JUNE 11, 2018
Record Plans By: JUDY GILMORE

I hereby certify that all construction required by this set of drawings has been accomplished as indicated herein.

BY: on 2018-09-20 16:39:33 GMT Resident Engineer

Date: September 20, 2018

NOTE: Any further information concerning final quantities, amounts or other details relative to this project may be found at Central Files in the electronic archives.

CONSTRUCTION IS TO BE CARRIED ON IN ACCORDANCE WITH THESE PLANS AND THE STANDARD SPECIFICATIONS FOR CONSTRUCTION DATED 2011, AS APPROVED BY THE FEDERAL HIGHWAY ADMINISTRATION ON JULY 20, 2011 FOR USE ON THIS PROJECT, INCLUDING ALL SUBSEQUENT REVISIONS AND SUCH REVISED SPECIFICATIONS AND SPECIAL PROVISIONS AS ARE INCORPORATED IN THESE PLANS.

QUALITY ASSURANCE PROGRAM : LEVEL 2
SURVEYED BY : L. ORVIS PC/G. HITCHCOCK
SURVEYED DATE : 5/29/2008, 8/5/2008, 4/3/2012
DATUM
VERTICAL ASSUMED
HORIZONTAL ASSUMED

DIRECTOR OF PROJECT DELIVERY	APPROVED DATE 12/31/2014
PROJECT MANAGER : KEN UPMAL, P.E.	
PROJECT NAME : PERU	
PROJECT NUMBER : STP SCR(4)	
SHEET 1 OF 45 SHEETS	

GREEN INTERNATIONAL AFFILIATES, INC.
CIVIL AND STRUCTURAL ENGINEERS

PRELIMINARY INFORMATION SHEET (CULVERT)

INDEX OF SHEETS

FINAL HYDRAULIC REPORT

PLAN SHEETS

1	TITLE SHEET
2	PRELIMINARY INFORMATION SHEET
3	CONVENTIONAL SYMBOLOLOGY LEGEND SHEET
4	TYPICAL SECTION SHEET
5 - 6	PROJECT NOTES
7 - 12	DETAIL SHEETS
13	REINFORCING STEEL SCHEDULE
14 - 15	TIE SHEETS
16	ALIGNMENT SHEET
17 - 20	BORING SHEETS
21 - 23	QUANTITY SHEETS
24	ITEM DETAIL AND DRAINAGE SHEET
25	EARTHWORKS SHEET
26	PLAN SHEET
27	LANDSCAPE PLAN SHEET
28	UTILITY PLAN SHEET
29 - 30	PROFILE SHEETS
31 - 36	EPSC SHEETS
37	TRAFFIC SIGNS AND MARKINGS SHEET
38 - 40	CROSS SECTION SHEETS
41 - 45	STAGING AND TRAFFIC CONTROL SHEETS

STANDARDS LIST

B-5	SLOPE GRADING, EMBANKMENTS, MUCK	06-01-1994
C-10	CURBING	02-11-2008
D-11	STEEL OR IRON GRATES & COVERS (TYPE A)	06-01-1994
D-15	PRECAST REINF CONC. MH-GRATES, CAST IRON GRATE WITH FRAME, TYPE D & E	06-01-1994
D-20	HIGHWAY CROSSING FOR UNDERGROUND UTILITIES	03-03-2003
D-22	SANITARY SEWER SYSTEMS	03-10-1995
E-119	UTILITY WORK ZONE	03-01-2004
E-121	STANDARD SIGN PLACEMENT - CONVENTIONAL ROAD	08-08-1995
E-171A	TRAFFIC CONTROL SIGNALS GENERAL NOTES & DETAILS	08-09-1995
E-171B	TRAFFIC CONTROL SIGNALS MISC. DETAILS	08-09-1995
E-173	PULL BOXES AND JUNCTION BOXES	08-09-1995
E-175	POWER DROP STANCHIONS	06-08-2009
E-191	PAVEMENT MARKING DETAILS	02-01-1999
E-192	PAVEMENT MARKING DETAILS	10-12-2000
E-193	PAVEMENT MARKING DETAILS	08-18-1995
F-2	CHAIN LINK FENCE, TYPE II DETAILS	06-01-1994
F-4	CHAIN LINK FENCE, TYPE II DETAILS	06-01-1994
G-1	STEEL BEAM GUARDRAIL DETAILS (POST, DELINEATOR, TYPICALS)	02-10-2014
T-1	TRAFFIC CONTROL GENERAL NOTES	08-06-2012
T-10	CONVENTIONAL ROADS CONSTRUCTION APPROACH SIGNING	08-06-2012
T-17	TRAFFIC CONTROL MISCELLANEOUS DETAILS	08-06-2012
T-28	CONSTRUCTION SIGN DETAILS	08-06-2012
T-29	CONSTRUCTION SIGN DETAILS	08-06-2012
T-30	CONSTRUCTION SIGN DETAILS	08-06-2012
T-31	CONSTRUCTION SIGN DETAILS	08-06-2012
T-36	CONSTRUCTION ZONE LONGITUDINAL DROP-OFFS FOR PAVING	08-06-2012
T-45	SQUARE TUBE SIGN POST AND ANCHOR	01-02-2013

STRUCTURES DETAIL SHEETS

- ADDED SHEETS FOLLOWING SHEET 8
 - CHANGE DETAIL #1
 - CHANGE DETAIL #2
 - SINGLE LEAF ACCESS DOOR
- SHEET 9 REPLACED
- SHEET 12 REPLACED
- SHEET 29 REPLACED

HYDROLOGIC DATA

Date: February 2014

DRAINAGE AREA: 120 acres
 CHARACTER OF TERRAIN: Mountainous, open and forested, steep
 STREAM CHARACTERISTICS: Perennial, alluvial and wandering
 NATURE OF STREAMBED: Large boulders and debris

PEAK FLOW DATA

Q 2.33 = 58 cfs Q 50 = 75 cfs
 Q 10 = 125 cfs Q 100 = 225 cfs
 Q 25 = 155 cfs Q 500 = N/A

DATE OF FLOOD OF RECORD: Unknown
 ESTIMATED DISCHARGE: Unknown
 WATER SURFACE ELEV.: Unknown
 NATURAL STREAM VELOCITY: Unknown
 ICE CONDITIONS: Moderate
 DEBRIS: Severe
 DOES THE STREAM REACH MAXIMUM HIGHWATER ELEV. RAPIDLY? N/A
 IS ORDINARY RISE RAPID? N/A
 IS STAGE AFFECTED BY UPSTREAM OR DOWNSTREAM CONDITIONS? Yes
 IF YES, DESCRIBE: Upstream end is controlled by a headwall and 36" CMP, downstream condition is free flow.

WATERSHED STORAGE: 1% HEADWATERS: _____
 UNIFORM: X
 IMMEDIATELY ABOVE SITE: _____

EXISTING STRUCTURE INFORMATION

STRUCTURE TYPE: Corrugated Metal Pipe
 YEAR BUILT: CA 1977
 CLEAR SPAN(NORMAL TO STREAM): 3'
 VERTICAL CLEARANCE ABOVE STREAMBED: 3'
 WATERWAY OF FULL OPENING: 7.07 sq. ft.
 DISPOSITION OF STRUCTURE: Abandon in place
 TYPE OF MATERIAL UNDER SUBSTRUCTURE: N/A

WATER SURFACE ELEVATIONS AT:

Q2.33 = N/A VELOCITY = -
 Q10 = N/A " -
 Q25 = N/A " -
 Q50 = N/A " -
 Q100 = N/A " -

LONG TERM STREAMBED CHANGES: None noted

IS THE ROADWAY OVERTOPPED BELOW Q100: No
 FREQUENCY: N/A
 RELIEF ELEVATION: N/A - Culvert headwall is not in roadway vicinity
 DISCHARGE OVER ROAD @Q100: N/A

UPSTREAM STRUCTURE

TOWN: Peru DISTANCE: _____
 HIGHWAY #: _____ STRUCTURE #: _____
 CLEAR SPAN: _____ CLEAR HEIGHT: _____
 YEAR BUILT: _____ FULL WATERWAY: _____
 STRUCTURE TYPE: Headwall

DOWNSTREAM STRUCTURE

TOWN: Peru DISTANCE: 24'
 HIGHWAY #: _____ STRUCTURE #: _____
 CLEAR SPAN: _____ CLEAR HEIGHT: _____
 YEAR BUILT: _____ FULL WATERWAY: _____
 STRUCTURE TYPE: Discharge to pond

LRFR LOAD RATING FACTORS

LOADING LEVELS	TRUCK						
	H-20	HL-93	3S2	6 AXLE	3A STR.	4A STR.	5A SEM
TONNAGE							
INVENTORY							
POSTING							
OPERATING							
COMMENTS:	TABLE TO BE COMPLETED BY CONTRACTOR'S DESIGNER						

PROPOSED STRUCTURE

STRUCTURE TYPE: 72" PCCSP/CAAP

CLEAR SPAN(NORMAL TO STREAM): 6'
 VERTICAL CLEARANCE ABOVE STREAMBED: 6'
 WATERWAY OF FULL OPENING: 28.3 sq. ft.

WATER SURFACE ELEVATIONS AT: (REPORTED @ OUTFALL)

Q2.33 = 1932.03' VELOCITY= 6.9 FPS
 Q10 = 1932.99' " 8.7 FPS
 Q25 = 1933.35' " 9.4 FPS
 Q50 = 1933.88' " 10.0 FPS
 Q100 = 1934.10' " 10.9 FPS

IS THE ROADWAY OVERTOPPED BELOW Q100: No
 FREQUENCY: _____
 RELIEF ELEVATION: N/A - Culvert headwall is not in roadway vicinity
 DISCHARGE OVER ROAD @Q100: N/A

AVERAGE LOW ELEVATION OF SUPERSTRUCTURE: N/A
 VERTICAL CLEARANCE: @ Q50 = 2.3'

SCOUR: N/A

REQUIRED CHANNEL PROTECTION: Stone Fill, Type II

PERMIT INFORMATION

AVERAGE DAILY FLOW: 0.63 cfs DEPTH OR ELEVATION:
 ORDINARY LOW WATER: 0.20 cfs 0.5'
 ORDINARY HIGH WATER: 25 cfs -2.64'

TEMPORARY BRIDGE REQUIREMENTS

STRUCTURE TYPE: N/A
 CLEAR SPAN (NORMAL TO STREAM): N/A
 VERTICAL CLEARANCE ABOVE STREAMBED: N/A
 WATERWAY AREA OF FULL OPENING: N/A

ADDITIONAL INFORMATION

TRAFFIC MAINTENANCE NOTES

- ONE-WAY ALTERNATING TRAFFIC WITH TEMPORARY TRAFFIC SIGNAL ON VT ROUTE 11
- MAINTAIN PEDESTRIAN ACCESS TO BROMLEY MOUNTAIN SKI RESORT

DESIGN VALUES

- DESIGN LIVE LOAD: N/A
- FUTURE PAVEMENT: d_p : 7.0 INCH
- DESIGN SPAN: L: 6.0 FEET
- MIN. MID-SPAN POS. CAMBER @ RELEASE (PRESTRESSED UNITS): Δ : _____
- PRESTRESSING STRAND: f_y : _____
- PRESTRESSED CONCRETE STRENGTH: f'_c : _____
- PRESTRESSED CONCRETE RELEASE STRENGTH: f'_{ci} : _____
- CONCRETE, HIGH PERFORMANCE CLASS AA: f'_c : _____
- CONCRETE, HIGH PERFORMANCE CLASS A: f'_c : _____
- CONCRETE, HIGH PERFORMANCE CLASS B: f'_c : 3500 PSI
- CONCRETE, CLASS C: f'_c : _____
- REINFORCING STEEL (LEVEL I): f_y : 60 KSI
- STRUCTURAL STEEL AASHTO M270: f_y : _____
- NOMINAL BEARING RESISTANCE OF SOIL: q_n : 19 KSF
- SOIL BEARING RESISTANCE FACTOR (REFER TO AASHTO LRFD): ϕ : 0.45
- NOMINAL BEARING RESISTANCE OF ROCK: q_n : _____
- ROCK BEARING RESISTANCE FACTOR (REFER TO AASHTO LRFD): ϕ : _____
- PILE RESISTANCE FACTOR: ϕ : _____
- LATERAL PILE DEFLECTION: Δ : _____
- BASIC WIND SPEED: V_{3s} : _____
- MINIMUM GROUND SNOW LOAD: p_g : _____
- SEISMIC DATA: PGA: 0 S: _____
 S I: _____
- _____
- _____
- _____
- _____

VT ROUTE 11 TRAFFIC DATA

YEAR	ADT	DHV	%D	%T	ADTT	20 year ESAL for flexible pavement from 2015 to 2035 : 3,703,00	40 year ESAL for flexible pavement from 2015 to 2055 : 8,380,000	Posted Speed: 50 mph
2015	4200	650	53	8.8	480			
2035	4600	710	53	12.8	770			

PROJECT NAME: PERU
 PROJECT NUMBER: STP SCRP(4)

FILE NAME: z07b106pl.dgn PLOT DATE: 12/31/2014
 PROJECT LEADER: E. ATKINS DRAWN BY: M. BRADLEY
 DESIGNED BY: M. BRADLEY CHECKED BY: E. ATKINS
 PRELIMINARY INFORMATION SHEET SHEET 2 OF 45

GENERAL INFORMATION

SYMBOLY LEGEND NOTE

THE SYMBOLY ON THIS SHEET IS INTENDED TO COVER STANDARD CONVENTIONAL SYMBOLY. THE SYMBOLY IS USED FOR EXISTING & PROPOSED FEATURES WITH HEAVIER LINEWEIGHT, IN COMBINATION WITH PROJECT ANNOTATION, AS NOTED ON PROJECT PLAN SHEETS. THIS LEGEND SHEET COVERS THE BASICS. SYMBOLY ON PLANS MAY VARY, PLAN ANNOTATIONS AND NOTES SHOULD BE USED TO CLARIFY AS NEEDED.

PROJECT SPECIFIC LEGEND

CODE	DESCRIPTION
	DUST CONTROL 609.10 & 15
	CONSTRUCTION BASELINE

R.O.W. ABBREVIATIONS (CODES) & SYMBOLS

POINT CODE	DESCRIPTION
CH	CHANNEL EASEMENT
CONST	CONSTRUCTION EASEMENT
CUL	CULVERT EASEMENT
D&C	DISCONNECT & CONNECT
DIT	DITCH EASEMENT
DR	DRAINAGE EASEMENT
DRIVE	DRIVEWAY EASEMENT
EC	EROSION CONTROL
HWY	HIGHWAY EASEMENT
I&M	INSTALL & MAINTAIN EASEMENT
LAND	LANDSCAPE EASEMENT
R&RES	REMOVE & RESET
R&REP	REMOVE & REPLACE
SR	SLOPE RIGHT
UE	UTILITY EASEMENT
(P)	PERMANENT EASEMENT
(T)	TEMPORARY EASEMENT
■	BNDNS BOUND SET
▣	BNDNS BOUND TO BE SET
●	IPNS IRON PIN SET
⊙	IPNS IRON PIN TO BE SET
⊠	CALC EXISTING ROW POINT
○	PROW PROPOSED ROW POINT
[LENGTH]	LENGTH CARRIED ON NEXT SHEET

COMMON TOPOGRAPHIC POINT SYMBOLS

POINT CODE	DESCRIPTION
⊛	APL BOUND APPARENT LOCATION
◻	BM BENCH MARK
◻	BND BOUND
⊠	CB CATCH BASIN
⊕	COMB COMBINATION POLE
⊠	DITHR DROP INLET THROATED DNC
⊕	EL ELECTRIC POWER POLE
◦	FPOLE FLAGPOLE
○	GASFIL GAS FILLER
○	GP GUIDE POST
×	GSO GAS SHUT OFF
◦	GUY GUY POLE
◦	GUYW GUY WIRE
×	GV GATE VALVE
⊙	H TREE HARDWOOD
△	HCTRL CONTROL HORIZONTAL
△	HVCTRL CONTROL HORIZ. & VERTICAL
◇	HYD HYDRANT
◦	IP IRON PIN
◦	IPIPE IRON PIPE
⊕	LI LIGHT - STREET OR YARD
⊕	MB MAILBOX
◦	MH MANHOLE (MH)
◻	MM MILE MARKER
◦	PM PARKING METER
◻	PMK PROJECT MARKER
◦	POST POST STONE/WOOD
⊕	RRSIG RAILROAD SIGNAL
⊕	RRSL RAILROAD SWITCH LEVER
⊕	S TREE SOFTWOOD
⊕	SAT SATELLITE DISH
⊕	SHRUB SHRUB
⊕	SIGN SIGN
⊕	STUMP STUMP
⊕	TEL TELEPHONE POLE
◦	TIE TIE
⊕	TSIGN SIGN W/DOUBLE POST
⊕	VCTRL CONTROL VERTICAL
◦	WELL WELL
×	WSO WATER SHUT OFF

THESE ARE COMMON VAOT SURVEY POINT SYMBOLS FOR EXISTING FEATURES, ALSO USED FOR PROPOSED FEATURES WITH HEAVIER LINEWEIGHT, IN COMBINATION WITH PROPOSED ANNOTATION.

PROPOSED GEOMETRY CODES

CODE	DESCRIPTION
PC	POINT OF CURVATURE
PI	POINT OF INTERSECTION
CC	CENTER OF CURVE
PT	POINT OF TANGENCY
PCC	POINT OF COMPOUND CURVE
PRC	POINT OF REVERSE CURVE
POB	POINT OF BEGINNING
POE	POINT OF ENDING
STA	STATION PREFIX
AH	AHEAD STATION SUFFIX
BK	BACK STATION SUFFIX
D	CURVE DEGREE OF (100FT)
R	CURVE RADIUS OF
T	CURVE TANGENT LENGTH
L	CURVE LENGTH OF
E	CURVE EXTERNAL DISTANCE

UTILITY SYMBOLY

UNDERGROUND UTILITIES	
— UT —	TELEPHONE
— UE —	ELECTRIC
— UC —	CABLE (TV)
— UEC —	ELECTRIC+CABLE
— UET —	ELECTRIC+TELEPHONE
— UCT —	CABLE+TELEPHONE
— UECT —	ELECTRIC+CABLE+TELEP.
— G —	GAS LINE
— W —	WATER LINE
— S —	SANITARY SEWER (SEPTIC)

ABOVE GROUND UTILITIES (AERIAL)

— T —	TELEPHONE
— E —	ELECTRIC
— C —	CABLE (TV)
— EC —	ELECTRIC+CABLE
— ET —	ELECTRIC+TELEPHONE
— AER E&T —	ELECTRIC+TELEPHONE
— CT —	CABLE+TELEPHONE
— ECT —	ELECTRIC+CABLE+TELEP.
—	UTILITY POLE GUY WIRE

PROJECT CONSTRUCTION SYMBOLY

PROJECT DESIGN & LAYOUT SYMBOLY	
— — — CZ — — —	CLEAR ZONE
— — — — —	PLAN LAYOUT MATCHLINE

PROJECT CONSTRUCTION FEATURES

▲ —▲—▲—▲—▲	TOP OF CUT SLOPE
○ —○—○—○—○	TOE OF FILL SLOPE
⊕ —⊕—⊕—⊕—⊕	STONE FILL
⊕ —⊕—⊕—⊕—⊕	BOTTOM OF DITCH
— — — — —	CULVERT PROPOSED
— — — — —	STRUCTURE SUBSURFACE
PDF — PDF —	PROJECT DEMARCATION FENCE
BF — BF —	BARRIER FENCE
XXXXXXXXXXXX	TREE PROTECTION ZONE (TPZ)
//////	STRIPING LINE REMOVAL
~~~~~	SHEET PILES

**CONVENTIONAL BOUNDARY SYMBOLY**

BOUNDARY LINES	
— TOWN LINE —	TOWN BOUNDARY LINE
— COUNTY LINE —	COUNTY BOUNDARY LINE
— STATE LINE —	STATE BOUNDARY LINE
— — — — —	PROPOSED STATE R.O.W. (LIMITED ACCESS)
— — — — —	PROPOSED STATE R.O.W.
— — — — —	STATE ROW (LIMITED ACCESS)
— — — — —	STATE ROW
— — — — —	TOWN ROW
— — — — —	PERMANENT EASEMENT LINE (P)
— — — — —	TEMPORARY EASEMENT LINE (T)
— — — — —	SURVEY LINE
— P — — — — —	PROPERTY LINE (P/L)
— SR — SR — SR —	SLOPE RIGHTS
6f — 6f —	6F PROPERTY BOUNDARY
4f — 4f —	4F PROPERTY BOUNDARY
HAZ — HAZ —	HAZARDOUS WASTE

**EPSC LAYOUT PLAN SYMBOLY**

EPSC MEASURES	
ONNOONNOONNO	FILTER CURTAIN
— — — — —	SILT FENCE
— — — — —	SILT FENCE WOVEN WIRE
— — — — —	CHECK DAM
— — — — —	DISTURBED AREAS REQUIRING RE-VEGETATION
— — — — —	EROSION MATTING

**ENVIRONMENTAL RESOURCES**

— — — — —	WETLAND BOUNDARY
— — — — —	RIPARIAN BUFFER ZONE
— — — — —	WETLAND BUFFER ZONE
— — — — —	SOIL TYPE BOUNDARY
— T&E —	THREATENED & ENDANGERED SPECIES
— HAZ — HAZ —	HAZARDOUS WASTE AREA
— AG —	AGRICULTURAL LAND
— HABITAT —	FISH & WILDLIFE HABITAT
— FLOOD PLAIN —	FLOOD PLAIN
— OHW —	ORDINARY HIGH WATER (OHW)
— — — — —	STORM WATER
— — — — —	USDA FOREST SERVICE LANDS
— — — — —	WILDLIFE HABITAT SUIT/CONN

**ARCHEOLOGICAL & HISTORIC**

— ARCH —	ARCHEOLOGICAL BOUNDARY
— HISTORIC DIST —	HISTORIC DISTRICT BOUNDARY
— HISTORIC —	HISTORIC AREA
Ⓜ	HISTORIC STRUCTURE

**CONVENTIONAL TOPOGRAPHIC SYMBOLY**

EXISTING FEATURES	
— — — — —	ROAD EDGE PAVEMENT
— — — — —	ROAD EDGE GRAVEL
— — — — —	DRIVEWAY EDGE
— — — — —	DITCH
— — — — —	FOUNDATION
— — — — —	FENCE (EXISTING)
— — — — —	FENCE WOOD POST
— — — — —	FENCE STEEL POST
— — — — —	GARDEN
— — — — —	ROAD GUARDRAIL
— — — — —	RAILROAD TRACKS
— — — — —	CULVERT (EXISTING)
— — — — —	STONE WALL
— — — — —	WALL
— — — — —	WOOD LINE
— — — — —	BRUSH LINE
— — — — —	HEDGE
— — — — —	BODY OF WATER EDGE
— — — — —	LEDGE EXPOSED


PROJECT NAME:	PERU
PROJECT NUMBER:	STP SCRP(4)
FILE NAME:	z07bi061gnd.dgn
PROJECT LEADER:	E. ATKINS
DESIGNED BY:	M. BRADLEY
CONVENTIONAL SYMBOLY LEGEND SHEET	PLOT DATE: 12/31/2014
	DRAWN BY: M. BRADLEY
	CHECKED BY: E. ATKINS
	SHEET 3 OF 45

# TYPICAL SECTIONS


MATERIAL ITEM	THICKNESS	TOLERANCE
PAVEMENT (TOTAL DEPTH ALL LAYERS)		+/- 1/4"
SUBBASE (TOTAL DEPTH ALL LAYERS)		+/- 1"

VT ROUTE 11 FULL DEPTH RECONSTRUCTION:  
 1 1/2" TYPE IVS - WEARING COURSE  
 3 1/2" TYPE IIS - INTERMEDIATE COURSE  
 3 1/2" TYPE IIS - BASE COURSE  
 24" SUBBASE OF DENSE GRADED CRUSHED STONE

TACK COAT: EMULSIFIED ASPHALT IS TO BE APPLIED AT THE RATE OF 0.025 GAL/SY BETWEEN SUCCESSIVE COURSES OF PAVEMENT AS DIRECTED BY THE ENGINEER.

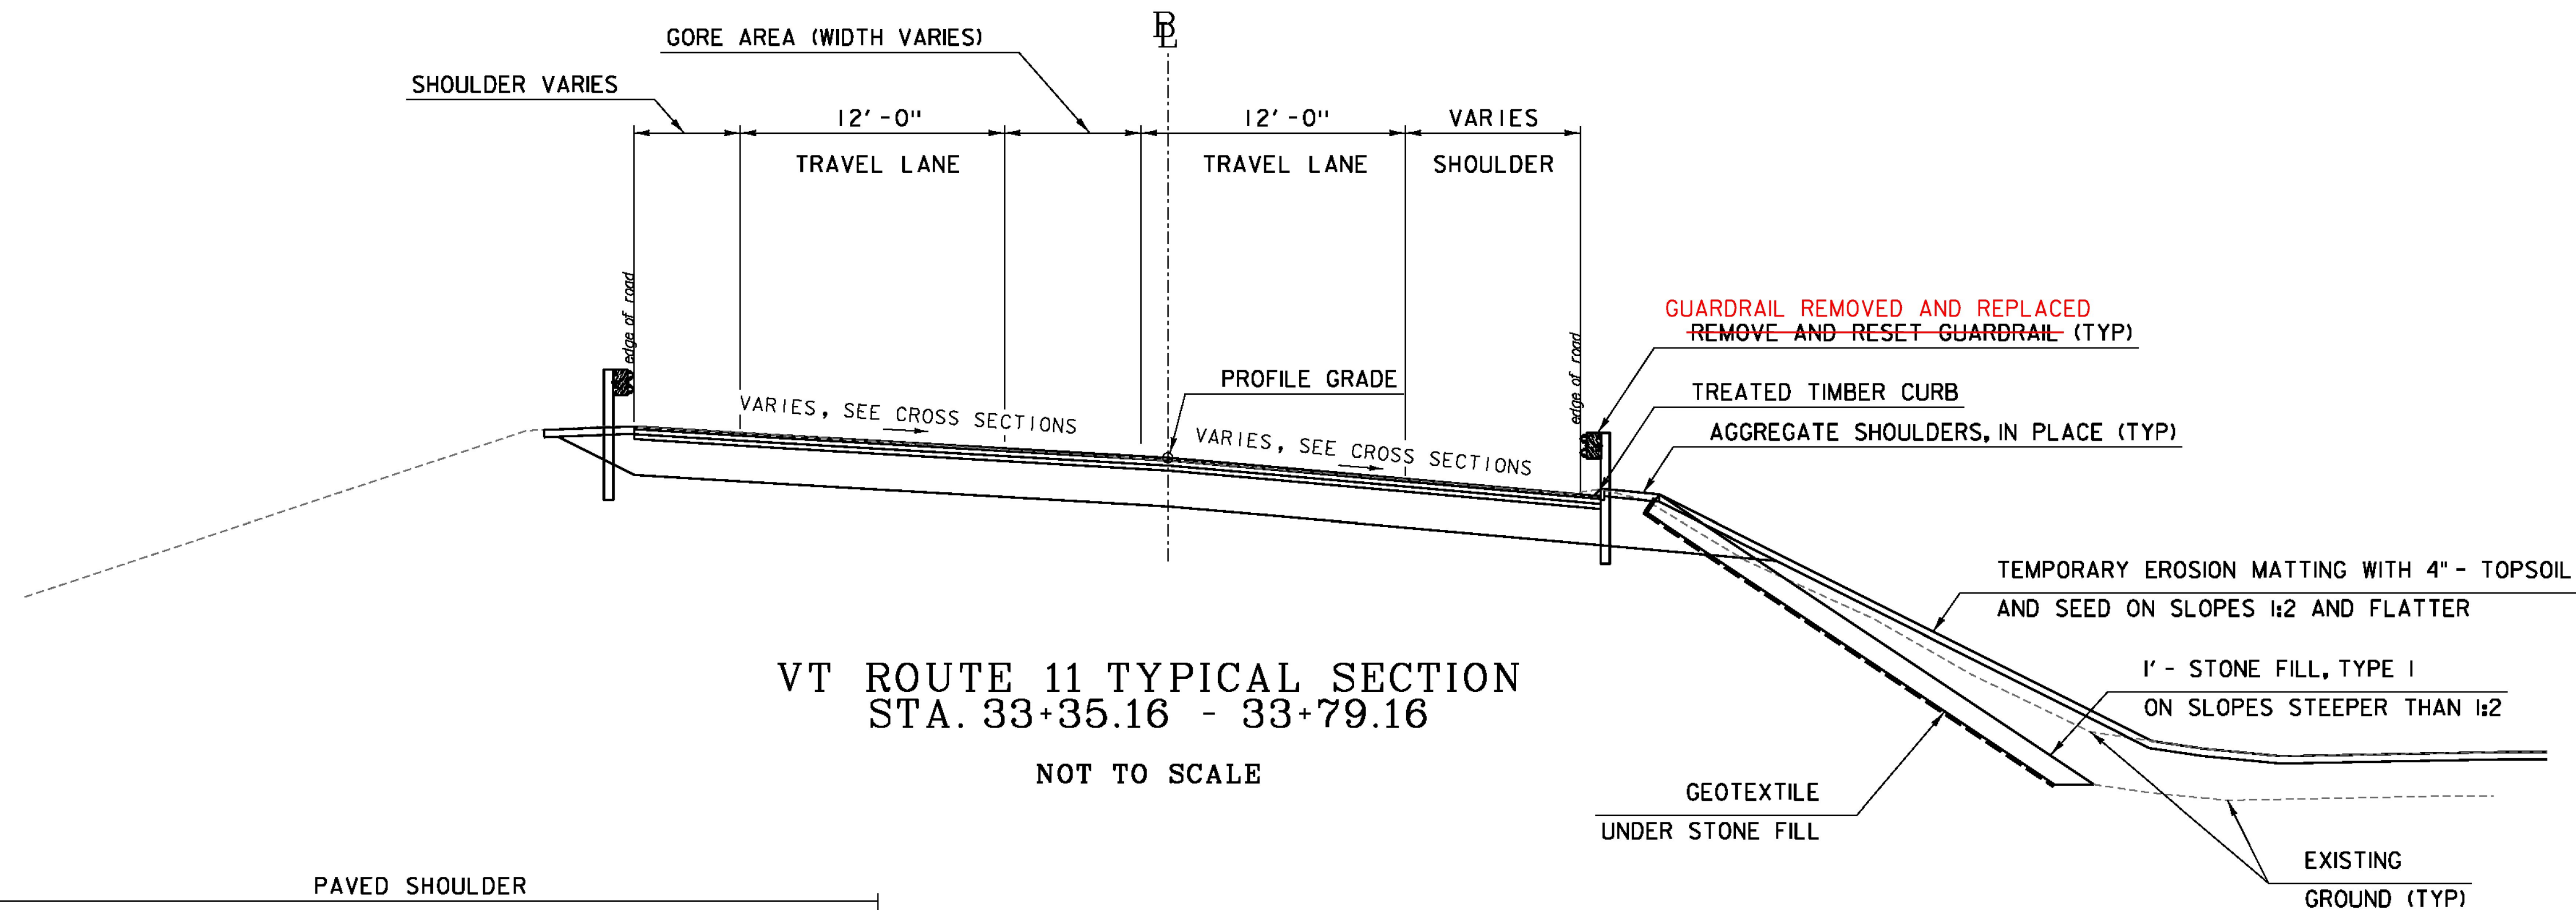


VT ROUTE 11 TYPICAL SECTION  
 STA. 33+35.16 - 33+79.16  
 NOT TO SCALE

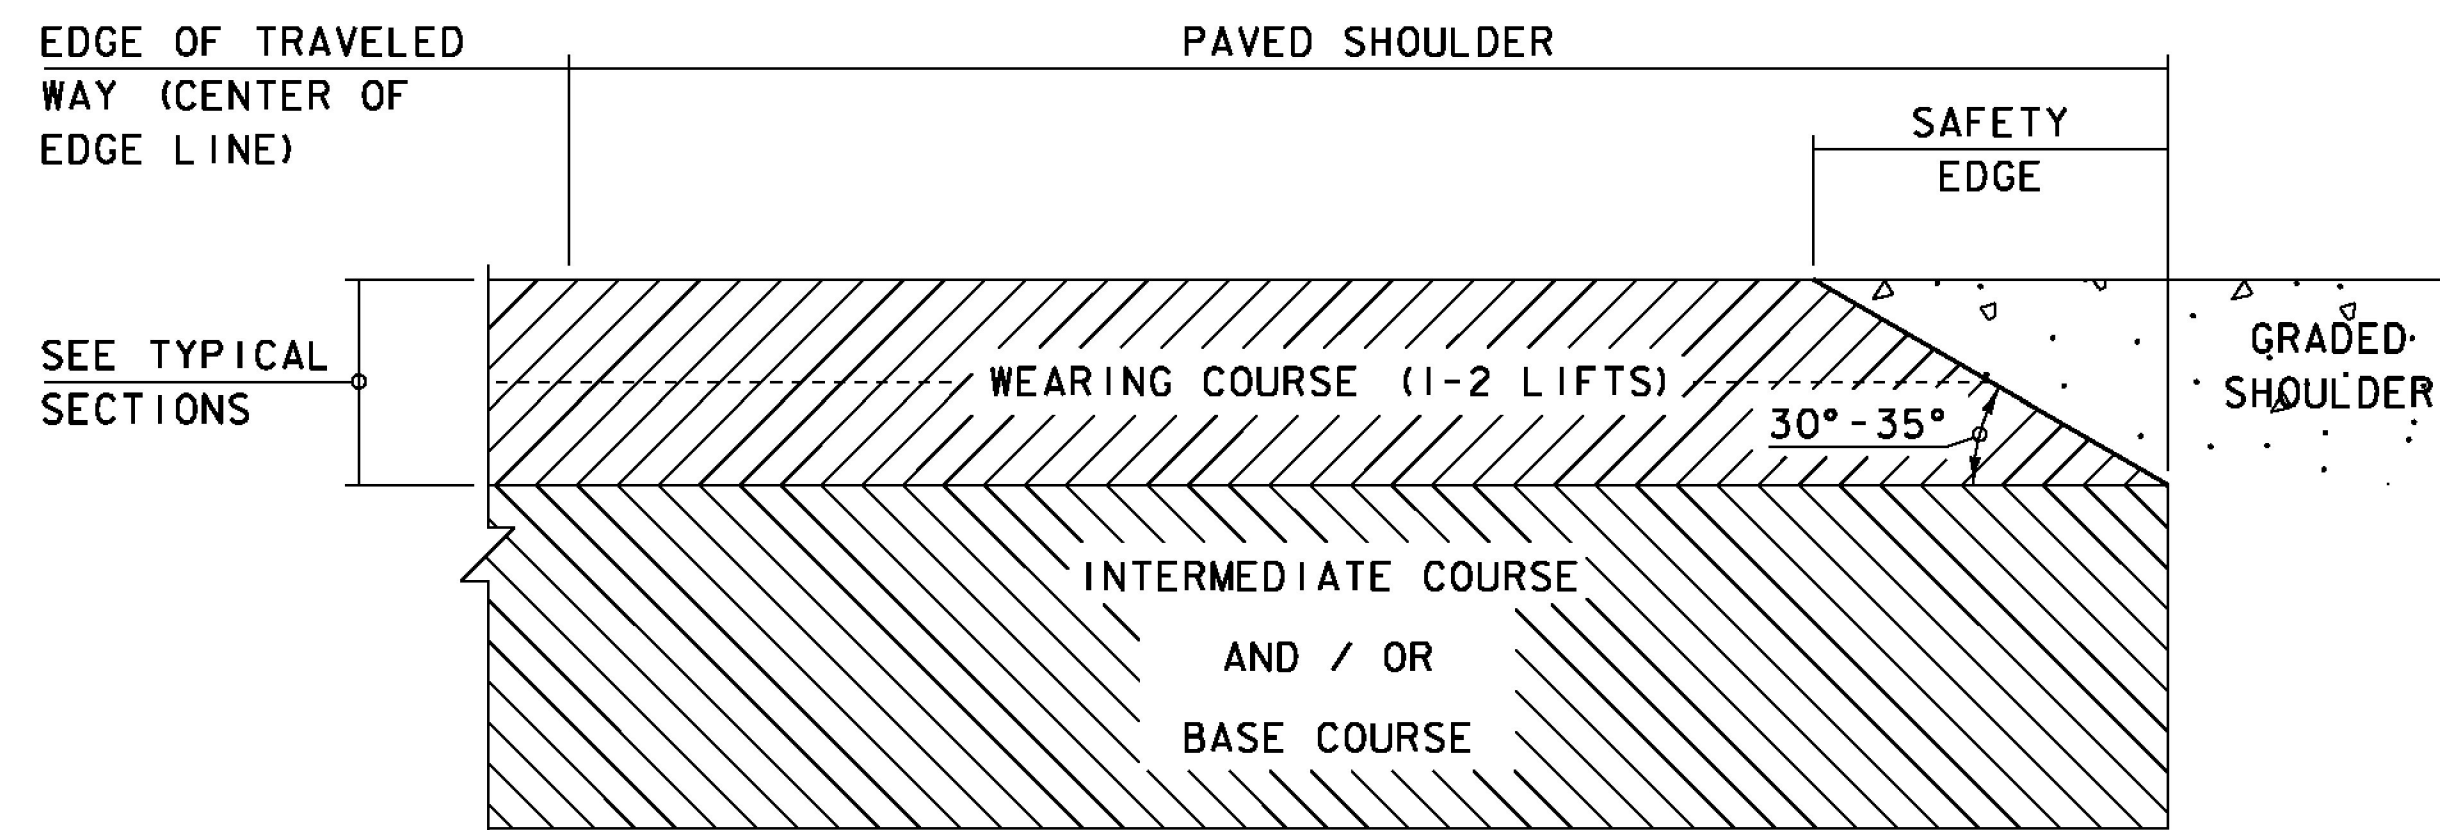

SAFETY EDGE DETAIL  
 NOT TO SCALE

1. THE EDGE OF PAVEMENT SHALL BE FORMED IN SUCH A WAY THAT THE BITUMINOUS CONCRETE PAVEMENT IS EXTRUDED OR COMPRESSED TO FORM THE 30 TO 35 DEGREE ANGLE. DEVICES THAT SIMPLY STRIKE-OFF THE MIX WITHOUT PROVIDING ANY COMPACTIVE EFFORT WILL NOT BE ALLOWED.
2. THE PAVED SHOULDER EXTENDS FROM THE EDGE OF TRAVELED WAY TO THE EDGE OF THE WEARING COURSE, INCLUDING THE "SAFETY EDGE".

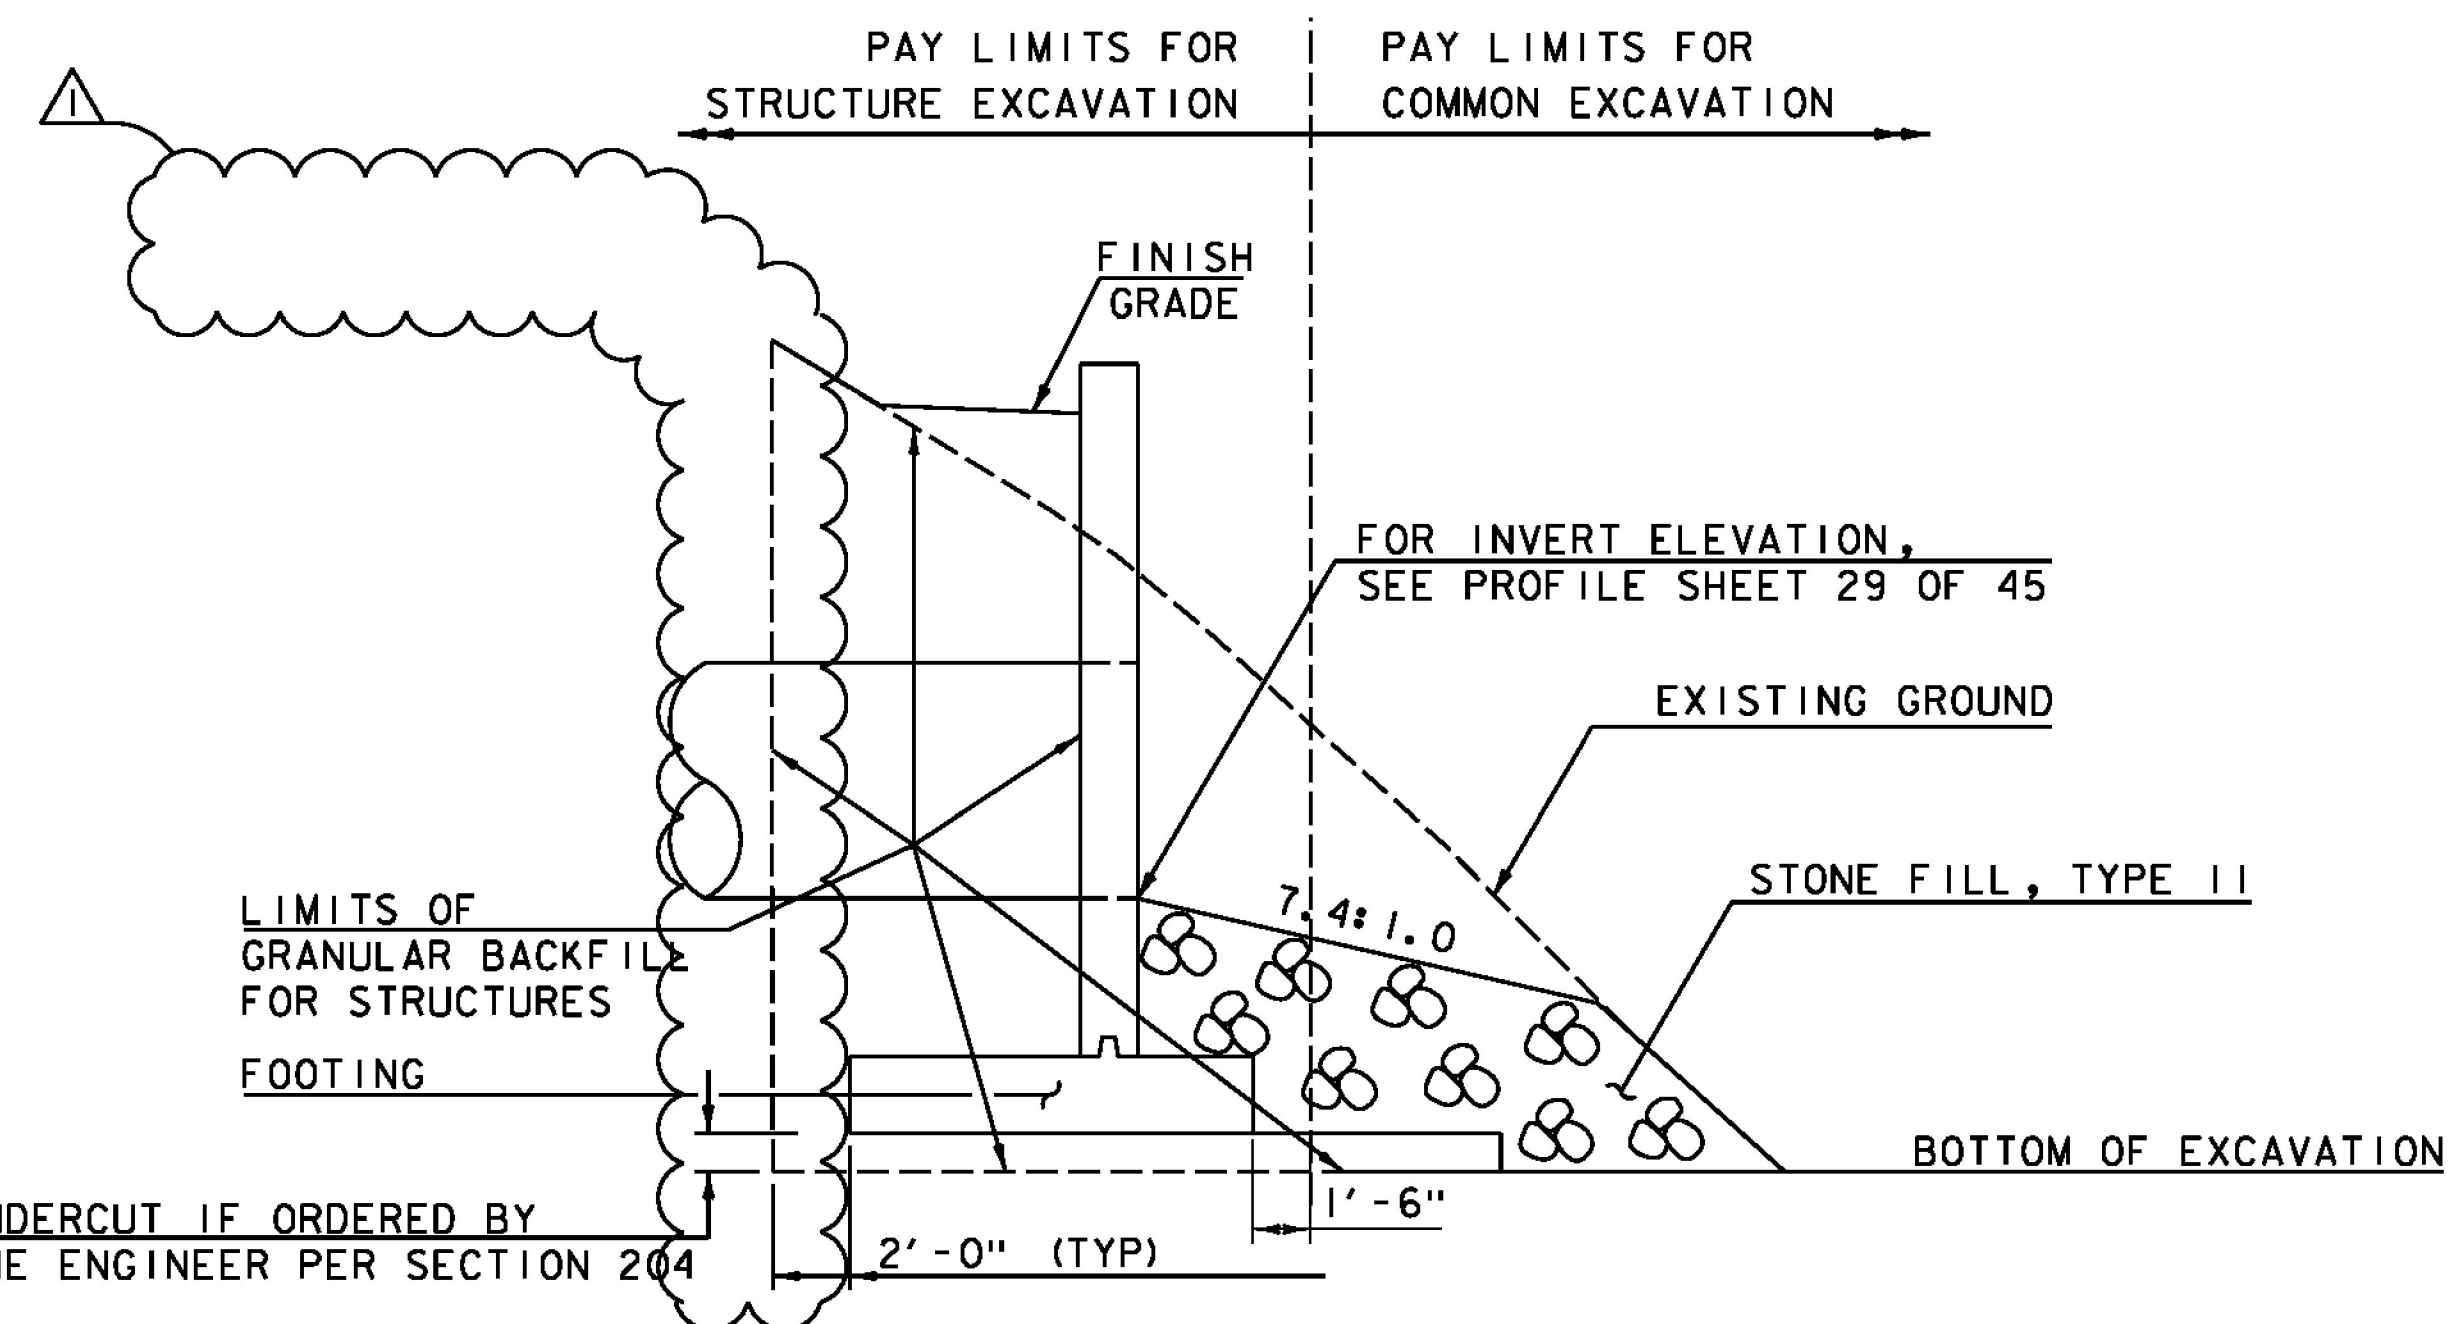

EARTHWORK SECTION AT CULVERT OUTLET  
 NOT TO SCALE

REVISION	BY	DATE
△ DELETED REFERENCE TO TEMPORARY SUPPORT OF EXCAVATION	MAB	2/10/2015

PROJECT NAME: PERU	PLOT DATE: 12/31/2014
PROJECT NUMBER: STP SCRP(4)	DRAWN BY: M. BRADLEY
FILE NAME: z07b106typ.dgn	CHECKED BY: E. ATKINS
PROJECT LEADER: E. ATKINS	SHEET 4 OF 45
DESIGNED BY: M. BRADLEY	
TYPICAL SECTION SHEET	

**GENERAL:**

- ALL MATERIALS AND CONSTRUCTION SHALL CONFORM TO THE STATE OF VERMONT AGENCY OF TRANSPORTATION STANDARD SPECIFICATIONS FOR CONSTRUCTION DATED 2011, AND ITS LATEST REVISIONS, THE AASHTO LRFD BRIDGE DESIGN SPECIFICATIONS, DATED 2012, AND ITS LATEST REVISIONS.
- PRIOR TO ANY EARTH DISTURBANCE, INCLUDING BUT NOT LIMITED TO REMOVAL OF EXISTING CONCRETE PAVERS, THE CONTRACTOR SHALL PROVIDE TO THE ENGINEER PHOTOGRAPHS AND DOCUMENTATION OF EXISTING CONDITIONS.
- THERE ARE EXISTING BELOW GRADE AND ABOVE GRADE, PRIVATELY OWNED, UTILITIES WITHIN THE PROJECT LIMITS. THE CONTRACTOR SHALL TAKE ALL NECESSARY PRECAUTIONS WHEN WORKING IN THE VICINITY OF THESE UTILITIES.

**CAST-IN-PLACE CONCRETE HEADWALL, WINGWALL AND FOOTING:**

**GENERAL**

- ALL CONCRETE SHALL BE CAST-IN-PLACE.
- ALL DIMENSIONS ARE HORIZONTAL OR VERTICAL, AND ARE GIVEN AT 68 DEGREES FAHRENHEIT, UNLESS NOTED OTHERWISE.
- ALL HARDWARE SHALL BE STEEL.
- ALL STEEL WITH THE EXCEPTION OF REINFORCING SHALL BE HOT DIPPED GALVANIZED.

**CONCRETE AND REINFORCING STEEL**

- WATER REPELLENT, SILANE SHALL BE APPLIED TO ALL EXPOSED CONCRETE SURFACES ON THE HEADWALL AND WINGWALLS. WATER REPELLENT, SILANE IS NOT NEEDED FOR OTHER CONCRETE ELEMENTS UNLESS DIRECTED BY THE ENGINEER.
- ALL REINFORCING STEEL SHALL BE DETAILED AND FABRICATED USING PROCEDURES AND TOLERANCES IN ACCORDANCE WITH APPLICABLE PUBLICATIONS OF THE "CONCRETE REINFORCING STEEL INSTITUTE".
- REINFORCING STEEL IN THE HEADWALL, WINGWALLS AND FOOTING SHALL MEET THE REQUIREMENTS OF SECTION 507 FOR UNCOATED LEVEL 1 REINFORCING STEEL.
- ALL EXPOSED EDGES ON CONCRETE SHALL BE CHAMFERED 1" X 1".
- MINIMUM CLEAR COVER FOR REINFORCING STEEL SHALL BE AS FOLLOWS:
  - ALONG BACK FACES OF WALLS AGAINST EARTH - 2 INCHES
  - ELSEWHERE UNLESS OTHERWISE INDICATED - 3 INCHES
- DESIGN VALUES
  - HIGH PERFORMANCE CLASS B CONCRETE COMPRESSIVE STRENGTH:  $f_c = 3500$  PSI.

**SPECIAL PROVISION (STOP LOG SYSTEM):**

- ONCE THE PROJECT HAS BEEN COMPLETED, SPECIAL PROVISION (STOP LOG SYSTEM) WILL BE UTILIZED BY BROMLEY TO DIVERT WATER FLOW INTO AN EXISTING 42" DIVERSION PIPE. WATER WILL BE DIVERTED BY INSERTING 2" X 10" SELECT STRUCTURAL SOUTHERN PINE BOARDS INTO THE GALVANIZED STEEL CHANNEL THAT SHALL BE CONSTRUCTED AT THE FACE OF THE WINGWALL.
- ALL MOUNTING HARDWARE NECESSARY TO INSTALL THE SPECIAL PROVISION (STOP LOG SYSTEM) SHALL BE CONSIDERED INCIDENTAL TO ITEM NUMBER 900.645 SPECIAL PROVISION (STOP LOG SYSTEM).
- TIMBER FOR SPECIAL PROVISION (STOP LOG SYSTEM)
  - TIMBER SHALL BE IN ACCORDANCE WITH AASHTO LRFD AND ANSI/AF&PA NDS, NATIONAL DESIGN SPECIFICATION (NDS) FOR WOOD CONSTRUCTION WITH COMMENTARY AND NDS SUPPLEMENT-DESIGN VALUES FOR WOOD STRUCTURES LATEST EDITION AND THE USDA FOREST SERVICE TIMBER MANUAL.
  - THE MAXIMUM ALLOWABLE MOISTURE CONTENT IS 19 PERCENT FOR ALL SAWN MEMBERS AT INSTALLATION.
  - ALL LUMBER SHALL BE TREATED IN ACCORDANCE WITH AASHTO M133 AND AWPA STANDARD C14 WITH MATERIALS APPROVED BY THE ENGINEER.
  - THE MINIMUM DESIGN VALUE OF SOUTHERN PINE SHALL BE:
    - $E_{90} = 2.05$  KSI
    - $E_o = 1.600$  KSI

**TRAFFIC CONTROL:**

SEE TRAFFIC CONTROL SHEETS FOR APPLICABLE TRAFFIC AND STAGING NOTES.

**EPSC:**

SEE EPSC SHEETS FOR APPLICABLE EPSC NOTES.

**UTILITIES:**

- THE WEEK OF 10/07/2013 TO 10/11/2013 BSI ENGINEERING PERFORMED TRACING AND EXPLORATORY TEST PITS TO DETERMINE THE LOCATION AND DEPTHS OF EXISTING UTILITIES ALONG THE PROPOSED CULVERT ALIGNMENT. THE RESULTS HAVE BEEN PLOTTED ONTO THE BASEMAP.
- UNLESS OTHERWISE NOTED ON THE PLANS, ALL UTILITIES HAVE BEEN PLOTTED TO QUALITY LEVEL "C"; SEE BELOW.
- UTILITY QUALITY LEVEL INFORMATION INDEX (SEE ASCE/C1 38-02):

**UTILITY QUALITY LEVEL (QL-A):**

PRECISE HORIZONTAL AND VERTICAL LOCATION OF UTILITIES OBTAINED BY THE ACTUAL EXPOSURE (OR VERIFICATION OF PREVIOUSLY EXPOSED AND SURVEYED UTILITIES) AND SUBSEQUENT MEASUREMENT OF SUBSURFACE UTILITIES, USUALLY AT A SPECIFIC POINT. MINIMALLY INTRUSIVE EXCAVATION EQUIPMENT IS TYPICALLY USED TO MINIMIZE THE POTENTIAL FOR UTILITY DAMAGE. A PRECISE HORIZONTAL AND VERTICAL LOCATION, AS WELL AS OTHER UTILITY ATTRIBUTES, IS SHOWN ON PLAN DOCUMENTS. ACCURACY IS TYPICALLY SET TO 0.05 FEET (15-MM) VERTICAL AND TO APPLICABLE HORIZONTAL SURVEY AND MAPPING ACCURACY AS DEFINED OR EXPECTED BY THE PROJECT OWNER. INFORMATION IS ONLY VALID WITHIN THE VISIBLE LIMITS OF THE TEST HOLE.

**UTILITY QUALITY LEVEL (QL-B):**

INFORMATION OBTAINED THROUGH THE APPLICATION OF APPROPRIATE SURFACE GEOPHYSICAL METHODS TO DETERMINE THE EXISTENCE AND APPROXIMATE HORIZONTAL POSITION OF SUBSURFACE UTILITIES. QUALITY LEVEL B DATA SHOULD BE REPRODUCIBLE BY SURFACE GEOPHYSICS AT ANY POINT OF THEIR DEPICTION. THIS INFORMATION IS SURVEYED TO APPLICABLE TOLERANCES DEFINED BY THE PROJECT AND REDUCED ONTO PLAN DOCUMENTS.

**UTILITY QUALITY LEVEL (QL-C):**

INFORMATION OBTAINED BY SURVEYING AND PLOTTING VISIBLE ABOVE-GROUND UTILITY FEATURES AND BY USING PROFESSIONAL JUDGMENT IN CORRELATING THIS INFORMATION TO QUALITY LEVEL D INFORMATION.

**UTILITY QUALITY LEVEL (QL-D):**

INFORMATION DERIVED FROM EXISTING RECORDS OR ORAL RECOLLECTIONS.

- EXISTING BROMLEY OWNED WATER AND SEWER LINES EXIST AND WILL BE REQUIRED TO BE SUPPORTED AND/OR BYPASSED DURING CONSTRUCTION OF THIS PROJECT AS SPECIFIED ON THE PLANS OR AS DIRECTED BY THE ENGINEER. ALL WORK SHALL BE PERFORMED IN ACCORDANCE WITH SECTIONS 628 AND 629 OF THE STANDARD SPECIFICATIONS AND AS DIRECTED BY THE ENGINEER.
- SEE THE UTILITIES SECTION OF THE SPECIAL PROVISIONS FOR ADDITIONAL INFORMATION AND REQUIREMENTS

**PARKING LOT RESTORATION:**

- ANY AREA OF THE PARKING LOT DAMAGED BY THE CONTRACTOR SHALL BE RESTORED TO THE SATISFACTION OF THE ENGINEER BY THE CONTRACTOR AT NO ADDITIONAL COST TO THE STATE.
- PARKING LOT PATCHING SHALL BE AS SPECIFIED IN THE TRENCH DETAIL.
- ALL PARKING LOT STRIPING SHALL BE REPLACED AS SPECIFIED ON THE TRAFFIC SIGNS AND MARKING SHEET.

**PIPE INSTALLATION:**

- THE CONTRACTOR SHALL NOTIFY BROMLEY MOUNTAIN SKI RESORT (BROMLEY) AT LEAST 30-DAYS PRIOR TO COMMENCING WITH ANY WORK WITHIN THE NON-PARTICIPATING AREA SO THAT BROMLEY CAN REMOVE ALL MINIATURE GOLF FEATURES. BROMLEY WILL RESTORE THE MINIATURE GOLF FEATURES AT THE COMPLETION OF CONSTRUCTION.
- STANDARD PIPE LENGTHS OF THE 72" PIPE SHALL BE A MINIMUM OF 20-FEET. ALL JOINTS SHALL BE RUBBER GASKETED, AND NO JOINT SHALL BE LOCATED WITHIN 10-FEET OF THE SKI RESORT BUILDING CORNER AT STA. 13+91

- THE CONTRACTOR SHALL TAKE NOTE THAT TEMPORARY SUPPORT OF EXCAVATION IS ANTICIPATED TO BE REQUIRED TO COMPLETE THE WORK UNDER THIS CONTRACT. SPECIAL PRECAUTIONS SHALL BE TAKEN WHEN EXCAVATING IN THE VICINITY OF THE SKI LIFT TOWER #1 (TOWER #1) FOUNDATION AND THE BROMLEY BUILDING. THE USE OF TRENCH BOXES FOR TEMPORARY SUPPORT OF EXCAVATION WITHIN 30-FEET OF THE BROMLEY BUILDING CORNER AND TOWER #1 FOUNDATION IS PROHIBITED.
- THE CONTRACTOR SHALL SUBMIT CONSTRUCTION DRAWINGS FOR THE ENGINEER'S APPROVAL AT LEAST 30 DAYS PRIOR TO THE ANTICIPATED START OF ANY WORK WITHIN 30-FEET OF THE BUILDING CORNER AND TOWER #1 FOUNDATION. IN ADDITION TO THE REQUIREMENTS SET FORTH UNDER SECTIONS 105 AND 204, THE CONSTRUCTION DRAWINGS SHALL DETAIL THE PROPOSED METHOD FOR EXCAVATION SUPPORT WITHIN 30-FEET OF THE BUILDING CORNER AND TOWER #1 FOUNDATION, PROCEDURE FOR PERFORMING A PRE- AND POST-CONSTRUCTION SURVEY AND PROCEDURES FOR SETTLEMENT AND VIBRATION MONITORING AS DISCUSSED FURTHER BELOW. THE SUPPORT OF EXCAVATION WITHIN THE AREA OF THE BUILDING CORNER AND TOWER #1 FOUNDATION SHALL MEET THE FOLLOWING CRITERIA:
  - THE SUPPORT OF EXCAVATION WITHIN 15- FEET OF THE TOWER #1 FOUNDATION AND THE BUILDING SHALL BE LEFT IN PLACE WHERE SHOWN ON THE PLANS. THE TOP OF THE SUPPORT OF EXCAVATION ELEVATION SHALL BE NO LOWER THAN 12-INCHES ABOVE THE TOP OF THE TOWER #1 FOOTING (SEE SHEET 29) OR THE TOP OF THE BUILDING FOOTING (THE BUILDING HAS A WALKOUT BASEMENT AND THE TOP OF FOOTING ELEVATION IS NOT KNOWN, BUT CAN BE APPROXIMATED TO BE AT ELEVATION 1993)
  - NO WOOD PRODUCTS SHALL BE ALLOWED FOR THE EXCAVATION SUPPORT TO BE LEFT IN PLACE.
  - SUPPORT OF EXCAVATION SYSTEMS MAY INCLUDE BUT ARE NOT LIMITED TO STEEL SHEETING, SOLDIER PILE AND LAGGING (WOOD LAGGING IS PROHIBITED), AND BUILDING UNDER PINNING.
  - THE BUILDING LOAD AT THE BUILDING FOOTING IS 3.6 KIPS/LF. TEMPORARY SUPPORT OF EXCAVATION DESIGN SHALL ACCOUNT FOR THIS ADDITIONAL LOAD.
  - SETTLEMENT AND VIBRATION MONITORING SHALL BE PROVIDED AS DISCUSSED BELOW. THE COST OF ALL EXCAVATION SUPPORT SHALL BE CONSIDERED INCIDENTAL TO ITEM 204.25 STRUCTURE EXCAVATION.
- IN THE VICINITY OF THE BUILDING AND TOWER #1 FOUNDATION AS SHOWN ON THE PLANS OR AS OTHERWISE DIRECTED BY THE ENGINEER, THE PIPE TRENCH SHALL BE BACKFILLED USING CONTROLLED DENSITY (FLOWABLE) FILL MEETING THE MATERIAL REQUIREMENTS OF CONTROLLED DENSITY (FLOWABLE) FILL PROVIDED BELOW. BACKFILL THE 72" PIPE TRENCH WITH CONTROLLED DENSITY (FLOWABLE) FILL IN ACCORDANCE WITH THE DETAIL ON SHEET 7 TO THE LIMITS OF THE EXCAVATION SUPPORT TO BE LEFT IN PLACE. BACKFILL THE 12" PIPE TRENCH IN ACCORDANCE WITH THE PLANS. THE CONTRACTOR SHALL RESTRAIN THE PIPES TO RESIST BUOYANCY WHEN BACKFILLING THE TRENCH. THE COST FOR THE CONTROLLED DENSITY (FLOWABLE) FILL SHALL BE INCLUDED FOR PAYMENT UNDER ITEM 541.45 CONTROLLED DENSITY (FLOWABLE) FILL.

CLASS	MINIMUM CEMENT (LBS/CY)	MAX WATER-CEMENT RATIO	RANGE IN SLUMP (IN)	AIR CONTENT (%)	COARSE AGGREGATE TABLE	28-DAY COMP. STRENGTH (PSI)
CONTROLLED DENSITY (FLOWABLE) FILL	100 & 300 LBS OF *FLY ASH, CLASS F	3	8 MIN.	10 MIN.	704.01 (FINE AGGREGATE)	125 MAX.

- A PRE-CONSTRUCTION SURVEY OF THE SKI RESORT BUILDING AND SKI LIFT TOWER #1 FOUNDATION SHALL BE CONDUCTED AND SHALL INCLUDE:
  - VIDEOS, PHOTOGRAPHS, AND A LEVEL SURVEY GIVING ELEVATIONS (ON THE PROJECT DATUM) OF SPECIFIC LOCATIONS WHICH SHALL BE NOTED ON PRINTS SUBMITTED TO THE ENGINEER. A SURVEY BENCHMARK SHALL BE ESTABLISHED ON TOWER #1 AND AT LEAST AT FIVE APPROVED LOCATIONS ALONG THE BUILDING FOUNDATION WALL: THE SOUTHWEST CORNER OF THE BUILDING FOUNDATION, AT 10- FEET AND 20- FEET NORTHERLY ALONG THE BUILDING FOUNDATION, THE BULKHEAD FOUNDATION, AND 20- FEET EASTERLY ALONG THE BUILDING FOUNDATION.
  - ALL SURVEYS SHALL BE PERFORMED IN THE PRESENCE OF THE ENGINEER AND PROPERTY OWNER OR THEIR DESIGNEE.
  - NOTATION AND MEASUREMENTS OF ANY EXISTING ARCHITECTURAL, STRUCTURAL, COSMETIC, PLUMBING OR ELECTRICAL DAMAGE OR ANY OTHER DAMAGE.
  - DOCUMENTATION OF ANY VIBRATION OR MOVEMENT SENSITIVE EQUIPMENT.
  - WHERE BUILDING STRUCTURAL ELEMENTS AND ALL RELATED ARCHITECTURAL AND BUILDING FACILITIES ARE INVOLVED, A STATE OF VERMONT LICENSED STRUCTURAL ENGINEER SHALL BE IN RESPONSIBLE CHARGE OF THE SURVEY.
  - ALL DOCUMENTATION FROM THE PRE-CONSTRUCTION SURVEY SHALL BE PROVIDED TO THE ENGINEER AT LEAST 30 DAYS PRIOR TO BEGINNING ANY EXCAVATION WORK WITHIN 30- FEET OF THESE STRUCTURES. THE COST OF THE PRE-CONSTRUCTION SURVEY SHALL BE CONSIDERED INCIDENTAL TO ITEM 204.25 STRUCTURE EXCAVATION.

REVISION	BY	DATE
NOTE 4a REVISED	MAB	2/10/2015

PROJECT NAME: PERU	PLOT DATE: 12/31/2014
PROJECT NUMBER: STP SCRP(4)	DRAWN BY: M. BRADLEY
FILE NAME: z07bl06det.dgn	CHECKED BY: B. KHALIFA
PROJECT LEADER: E. ATKINS	SHEET 5 OF 45
DESIGNED BY: B. KHALIFA	
PROJECT NOTES SHEET 1	



**PIPE INSTALLATION (CONTINUED):**

7. A CORRECTIVE ACTION PLAN SHALL BE SUBMITTED TO THE ENGINEER FOR APPROVAL A MINIMUM OF 21-DAYS PRIOR TO BEGINNING ANY CONSTRUCTION ACTIVITIES WITHIN 30-FEET OF THE TOWER #1 FOUNDATION AND THE BUILDING. THE CORRECTIVE ACTION PLAN SHALL INCLUDE, AT A MINIMUM, MEASURES TO STOP ANY MOVEMENT AND RESTORE ANY AREA DAMAGED BY MOVEMENT OR VIBRATION WHICH EXCEEDED THE ALLOWABLE THRESHOLDS PROVIDED BELOW. THE COST FOR THE PREPARATION AND EXECUTION OF THE CORRECTIVE ACTION PLAN SHALL BE CONSIDERED INCIDENTAL TO ITEM 204.25 STRUCTURE EXCAVATION UNLESS OTHERWISE NOTED IN NOTE 8.

8. THE MAXIMUM ALLOWABLE HORIZONTAL OR VERTICAL MOVEMENT OF THE TOWER #1 FOUNDATION OR THE BUILDING IS 0.25-INCHES. THE MAXIMUM LATERAL MOVEMENT OF THE EXCAVATION SUPPORT AT THE TOWER #1 AND BUILDING LOCATION SHALL BE LIMITED TO 0.50 INCHES. THE CONTRACTOR SHALL MONITOR AND MEASURE THE MOVEMENTS OF THE EXCAVATION SUPPORT, TOWER #1 FOUNDATION AND THE BUILDING DURING EXCAVATION ACTIVITIES EVERY 2-FEET OF EXCAVATED DEPTH UNTIL THE BOTTOM OF EXCAVATION IS REACHED; DAILY THEREAFTER FOR A PERIOD OF 1 MONTH AFTER THE EXCAVATION HAS BEEN BACKFILLED. THE CONTRACTOR SHALL ESTABLISH AT LEAST FIVE MONITORING LOCATIONS ALONG THE FACE OF THE EXCAVATION SUPPORT ALONG THE TOP AND THEN IN THE VERTICAL DIRECTION AS THE EXCAVATION PROGRESSES DEEPER TO CREATE A 5X5 ARRAY OF MEASUREMENT POINTS WHEN FULLY EXCAVATED. THE MONITORING LOCATIONS FOR TOWER #1 AND THE BUILDING SHALL BE AS DESCRIBED IN NOTE 6 ABOVE.

THE CONTRACTOR SHALL IMMEDIATELY STOP WORK AND NOTIFY THE ENGINEER OF ANY MOVEMENTS. IF THE ENGINEER DETERMINES THAT THE MOVEMENTS EXCEED THOSE SPECIFIED AND REQUIRE CORRECTIVE ACTION, THE CONTRACTOR SHALL TAKE CORRECTIVE ACTIONS NECESSARY TO STOP THE MOVEMENT AND PERFORM REPAIRS. WHEN DUE TO THE CONTRACTOR'S METHODS OR OPERATIONS OR FAILURE TO FOLLOW THE SPECIFIED/APPROVED CONSTRUCTION SEQUENCE, AS DETERMINED BY THE ENGINEER, THE COSTS OF PROVIDING CORRECTIVE ACTIONS SHALL BE BORNE BY THE CONTRACTOR. WHEN DUE TO DIFFERING SITE CONDITIONS, AS DETERMINED BY THE ENGINEER, THE COSTS OF PROVIDING CORRECTIVE ACTIONS SHALL BE PAID AS EXTRA WORK.

9. THE CONTRACTOR SHALL MONITOR VIBRATIONS WITH AN APPROVED SEISMOGRAPH(S) LOCATED, AS APPROVED, BETWEEN THE WORK AREA AND THE CLOSEST STRUCTURE SUBJECT TO VIBRATION DAMAGE. THE SEISMOGRAPH USED SHALL BE CAPABLE OF RECORDING PARTICLE VELOCITY FOR THREE MUTUALLY PERPENDICULAR COMPONENTS OF VIBRATION IN THE FREQUENCY RANGE GENERALLY FOUND WITH CONSTRUCTION ACTIVITIES GENERATING VIBRATIONS SUCH AS COMPACTING, SHEET PILING, ETC. THE VIBRATION MONITORING EQUIPMENT SHALL HAVE A SAMPLING RATE SUFFICIENT TO ACCURATELY RECORD HIGH FREQUENCY VIBRATIONS CLOSE TO THE WORK AREA. THE COST FOR ALL VIBRATION MONITORING SHALL BE CONSIDERED INCIDENTAL TO ITEM 204.25 STRUCTURE EXCAVATION.

PEAK PARTICLE VELOCITY OF EACH COMPONENT SHALL NOT BE ALLOWED TO EXCEED THE SAFE LIMITS OF THE NEAREST STRUCTURE SUBJECT TO VIBRATION DAMAGE. SAFE VIBRATION LIMITS WILL BE CONSIDERED THOSE SHOWN IN TABLE 1, UNLESS THE CONTRACTOR PROVIDES EVIDENCE, TO THE ENGINEER'S SATISFACTION, THAT DIFFERENT LIMITS SHOULD BE USED. DATA RECORDED FOR ALL SHOTS SHALL BE FURNISHED TO THE ENGINEER, AND SHALL INCLUDE THE FOLLOWING:

- IDENTIFICATION OF INSTRUMENT USED.
- NAME OF QUALIFIED OBSERVER AND INTERPRETER.
- DISTANCE AND DIRECTION OF RECORDING STATION FROM WORK AREA.
- TYPE OF GROUND AT RECORDING STATION AND MATERIAL ON WHICH THE INSTRUMENT IS SITTING.
- MAXIMUM PARTICLE VELOCITY IN EACH COMPONENT.
- MAXIMUM DYNAMIC GROUND DISPLACEMENT.
- A DATED AND SIGNED COPY OF PHOTOGRAPHIC RECORDS OF SEISMOGRAPH READINGS.

**TABLE 1**

STRUCTURE TYPE	MAXIMUM ALLOWABLE PEAK PARTICLE VELOCITY (PPV) (1)	MAXIMUM DYNAMIC GROUND DISPLACEMENT (2)
STANDARD CONSTRUCTION TIMBER FRAME, BRICK AND CONCRETE BUILDINGS	50 MM/SEC (2.0 IN/SEC)	2 MM
REINFORCED CONCRETE STRUCTURES	100 MM/SEC (4.0 IN/SEC)	2 MM
STEEL STRUCTURES	100 MM/SEC (4.0 IN/SEC)	2 MM
BURIED UTILITIES/WELLS	50 MM/SEC (2.0 IN/SEC)	2 MM
GREEN CONCRETE	DEPENDS ON STRENGTH OF CONCRETE AND AS APPROVED BY ENGINEER	DEPENDS ON STRENGTH OF CONCRETE AND AS APPROVED BY ENGINEER

**NOTES:**

1. MAXIMUM PPV SHALL BE THE MAXIMUM OF THREE COMPONENTS MEASURED IN THREE MUTUALLY PERPENDICULAR DIRECTIONS (TRANSVERSE, VERTICAL AND LONGITUDINAL). THE CONTRACTOR SHALL MONITOR VIBRATIONS AT THE NEAREST STRUCTURE FOR ALL CONSTRUCTION ACTIVITIES GENERATING VIBRATIONS AND OTHER SENSITIVE STRUCTURES AS DESIGNATED BY ENGINEER.
2. DYNAMIC GROUND DISPLACEMENT EVALUATED ASSUMING SINUSOIDAL WAVE PATTERN AND USING THE FOLLOWING FORMULA:

$$D = PPV / 2\pi F$$

WHERE: D = DISPLACEMENT (MM);  
PPV = PEAK PARTICLE VELOCITY (MM/SECOND) AND;  
F = FREQUENCY (HZ)


10. THE CONTRACTOR SHALL REPORT ALL RESULTS OF THE VIBRATION AND EXCAVATION SUPPORT, TOWER #1 FOUNDATION AND BUILDING MOVEMENT MONITORING TO THE ENGINEER IN WRITING DAILY.

11. AT THE COMPLETION OF THE CONSTRUCTION ACTIVITIES WITHIN 30-FEET OF THE TOWER #1 FOUNDATION AND THE BUILDING A POST-CONSTRUCTION SURVEY SHALL BE CONDUCTED THAT MEETS ALL OF THE CRITERIA FROM THE PRE-CONSTRUCTION SURVEY FOR THE TOWER AND BUILDING. THE CONTRACTOR SHALL CONTINUE TO MONITOR THE ESTABLISHED BENCHES FOR MOVEMENT 1-MONTH AFTER THE COMPLETION OF THE CONSTRUCTION ACTIVITIES WITHIN 30-FEET OF THE TOWER #1 FOUNDATION AND THE BUILDING. AFTER 1-MONTH OF ADDITIONAL MOVEMENT MONITORING THE CONTRACTOR SHALL SUBMIT WRITTEN DOCUMENTATION OF THE MOVEMENT, IF ANY, TO THE ENGINEER. THE COST OF POST-CONSTRUCTION SURVEY AND REPORTING SHALL BE CONSIDERED INCIDENTAL TO ITEM 204.25 STRUCTURE EXCAVATION.

PROJECT NAME: PERU  
PROJECT NUMBER: STP SCRP(4)


FILE NAME: z07b106de+.dgn  
PROJECT LEADER: E. ATKINS  
DESIGNED BY: B. KHALIFA  
PROJECT NOTES SHEET 2

PLOT DATE: 12/31/2014  
DRAWN BY: M. BRADLEY  
CHECKED BY: B. KHALIFA  
SHEET 6 OF 45

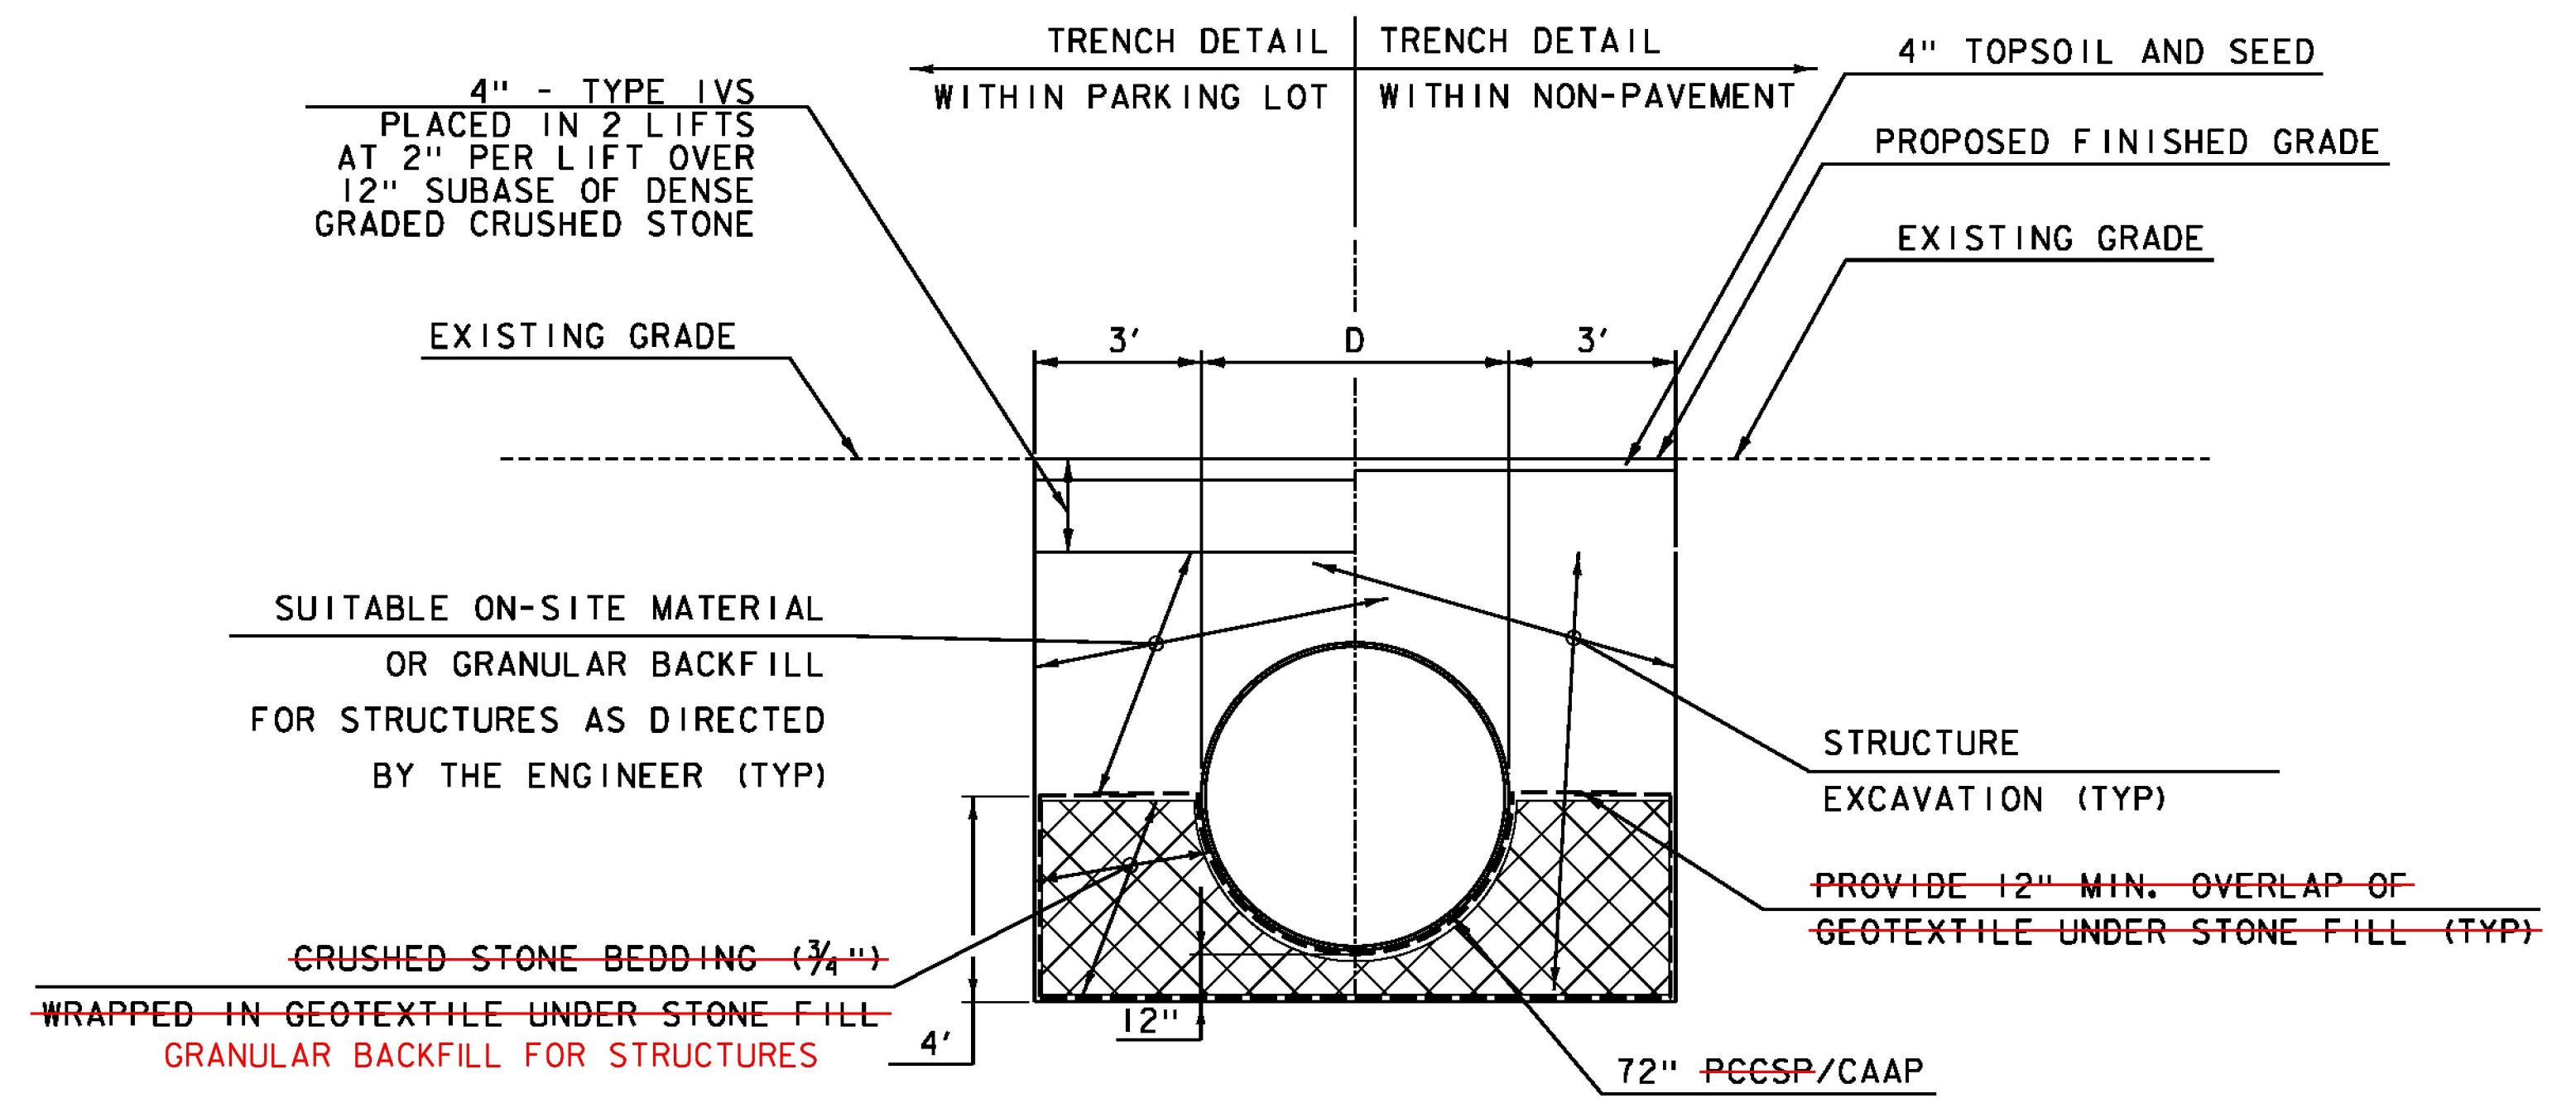


TYPICAL TRENCH DETAIL FOR 72" PCCSP/CAAP PIPE

NOT TO SCALE

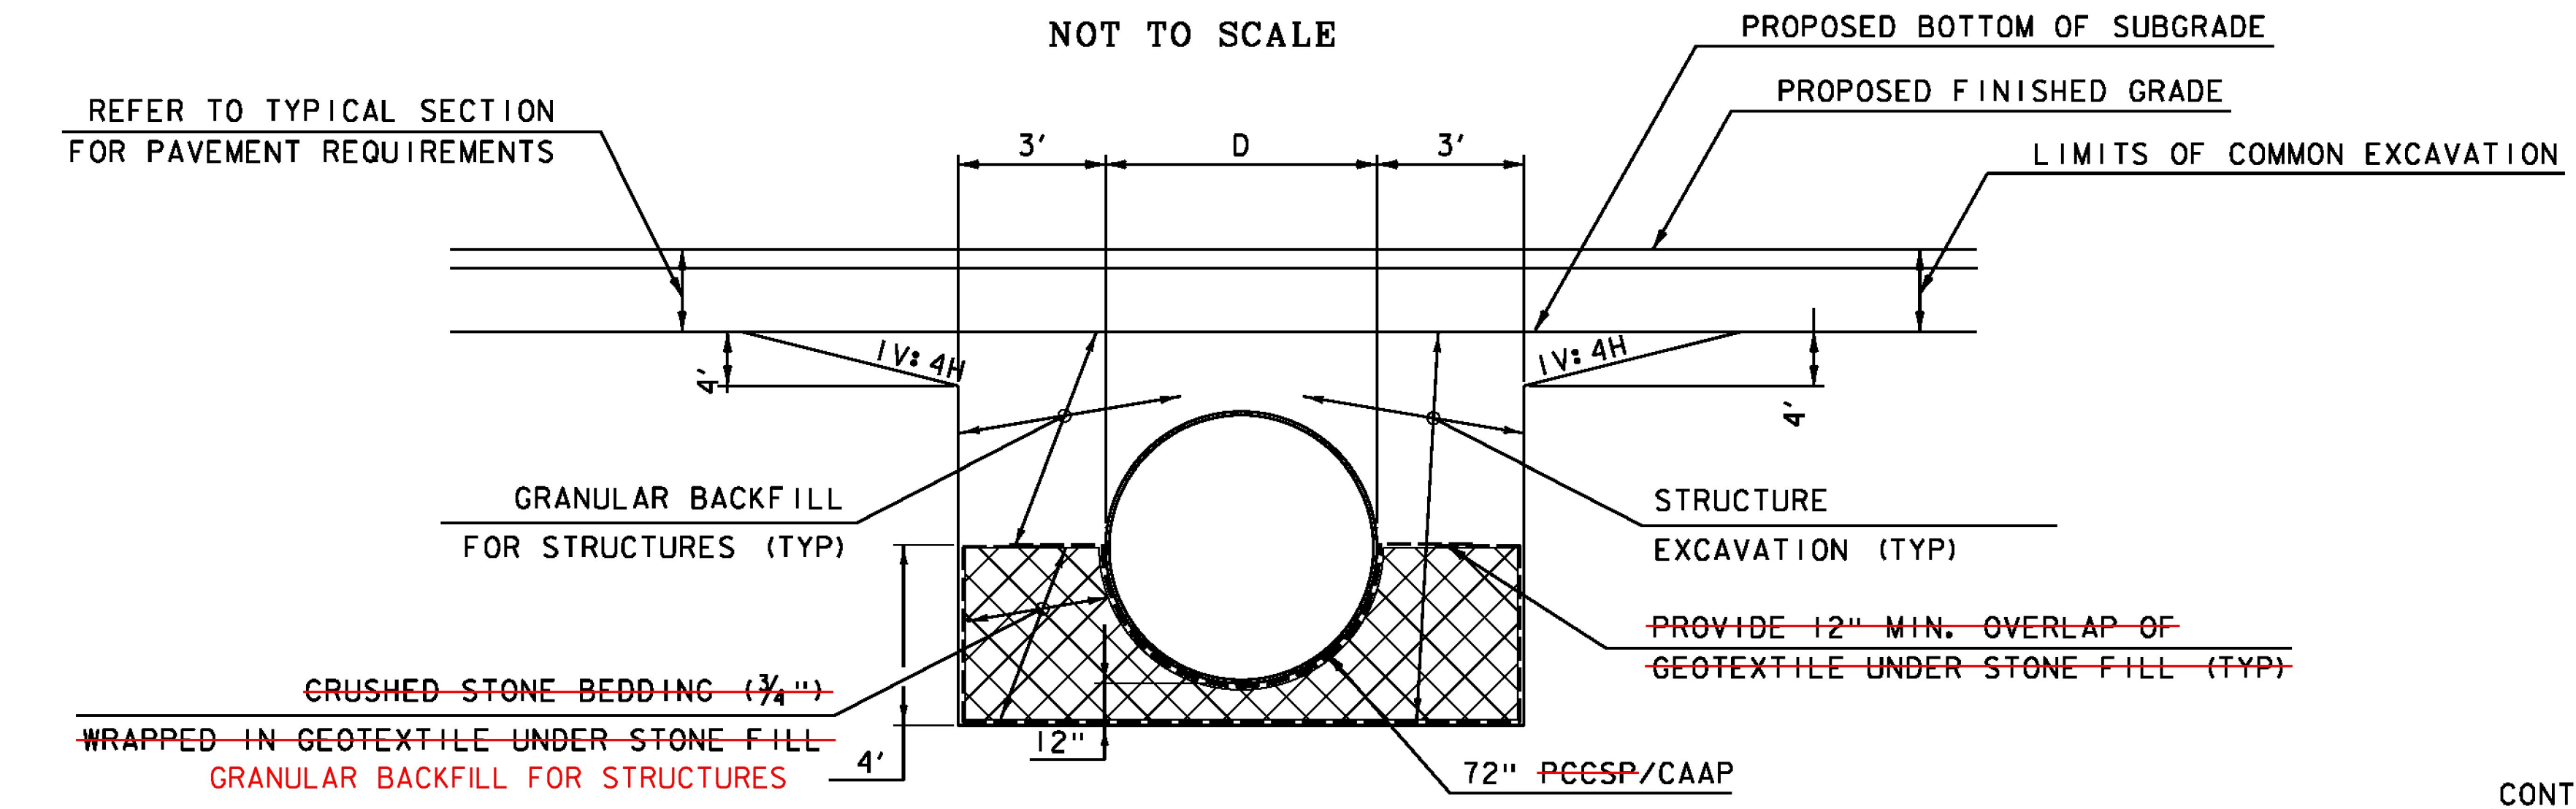


TYPICAL TRENCH DETAIL FOR 72" PCCSP/CAAP PIPE  
WITHIN VT ROUTE 11

NOT TO SCALE

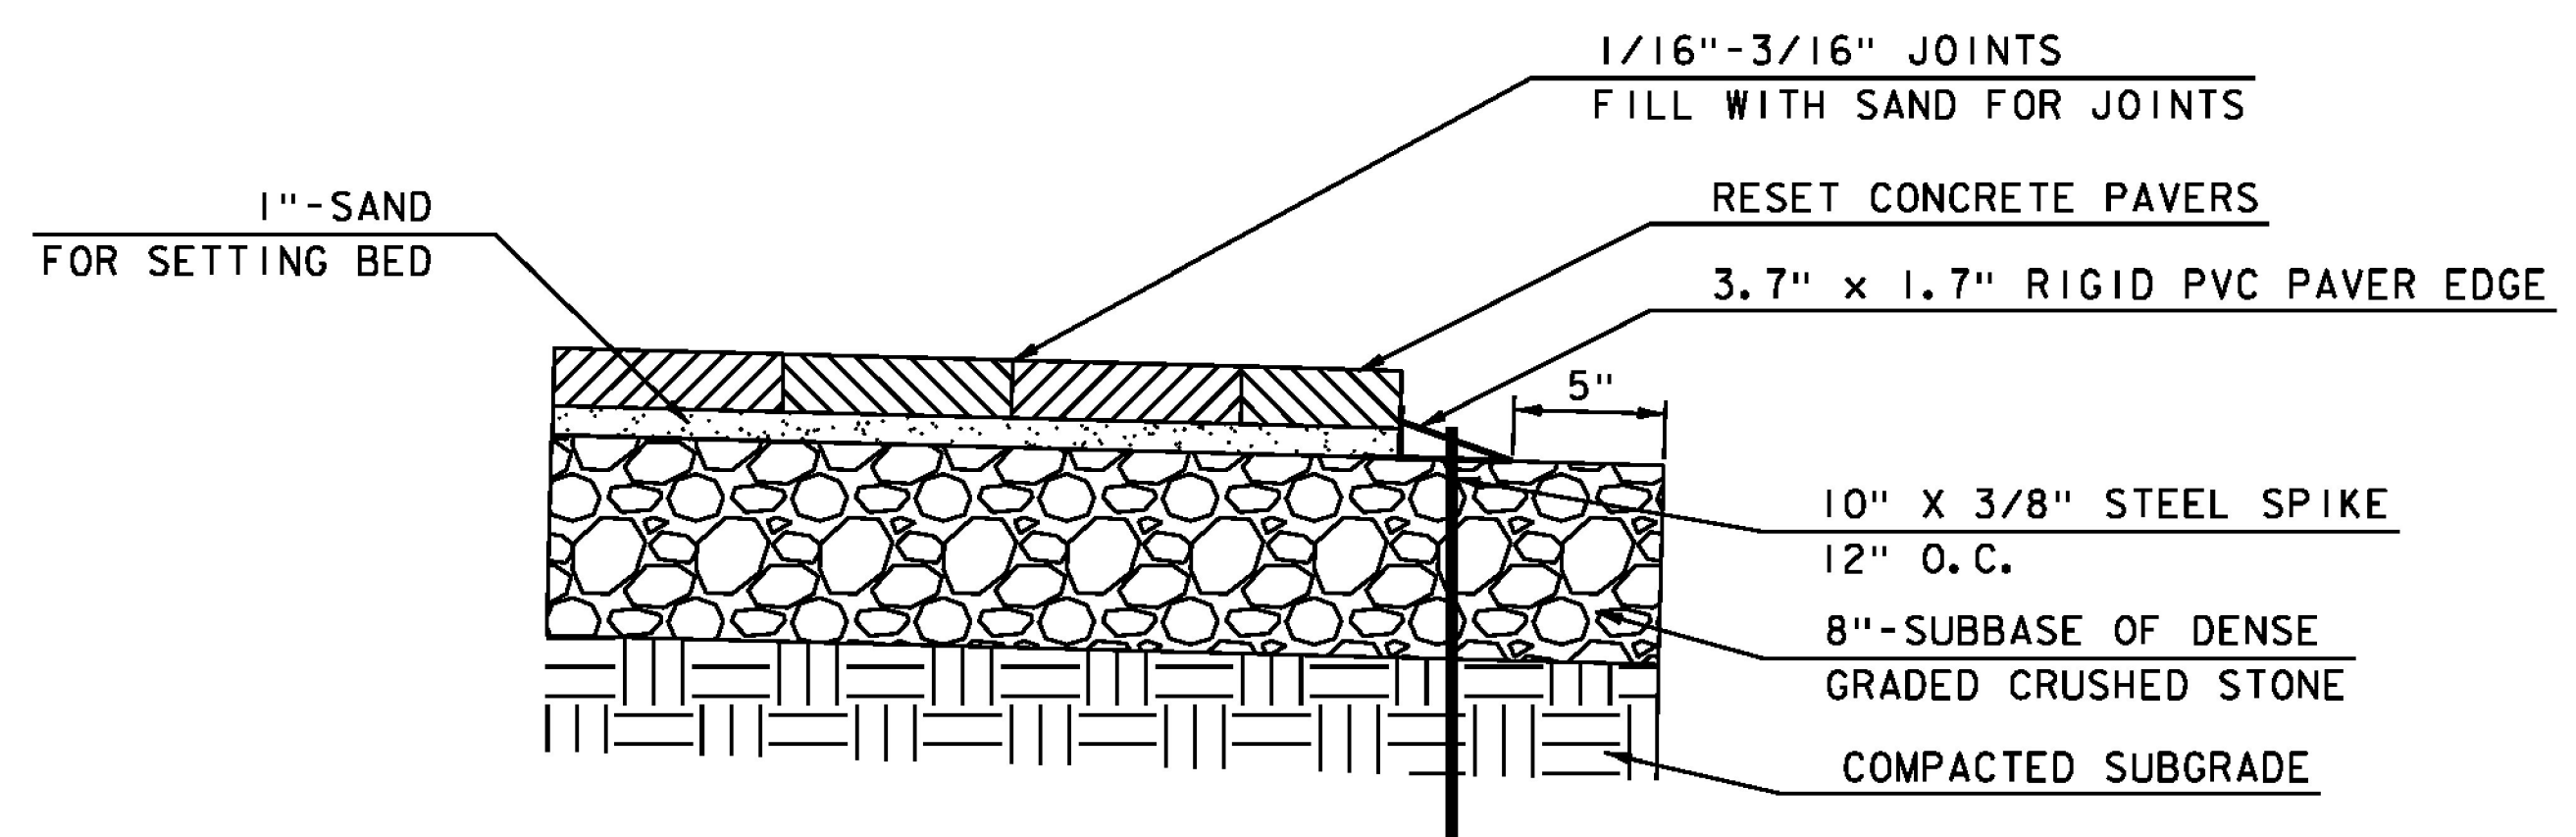

SPECIAL PROVISION (REMOVE AND  
RESET CONCRETE PAVERS)

NOT TO SCALE

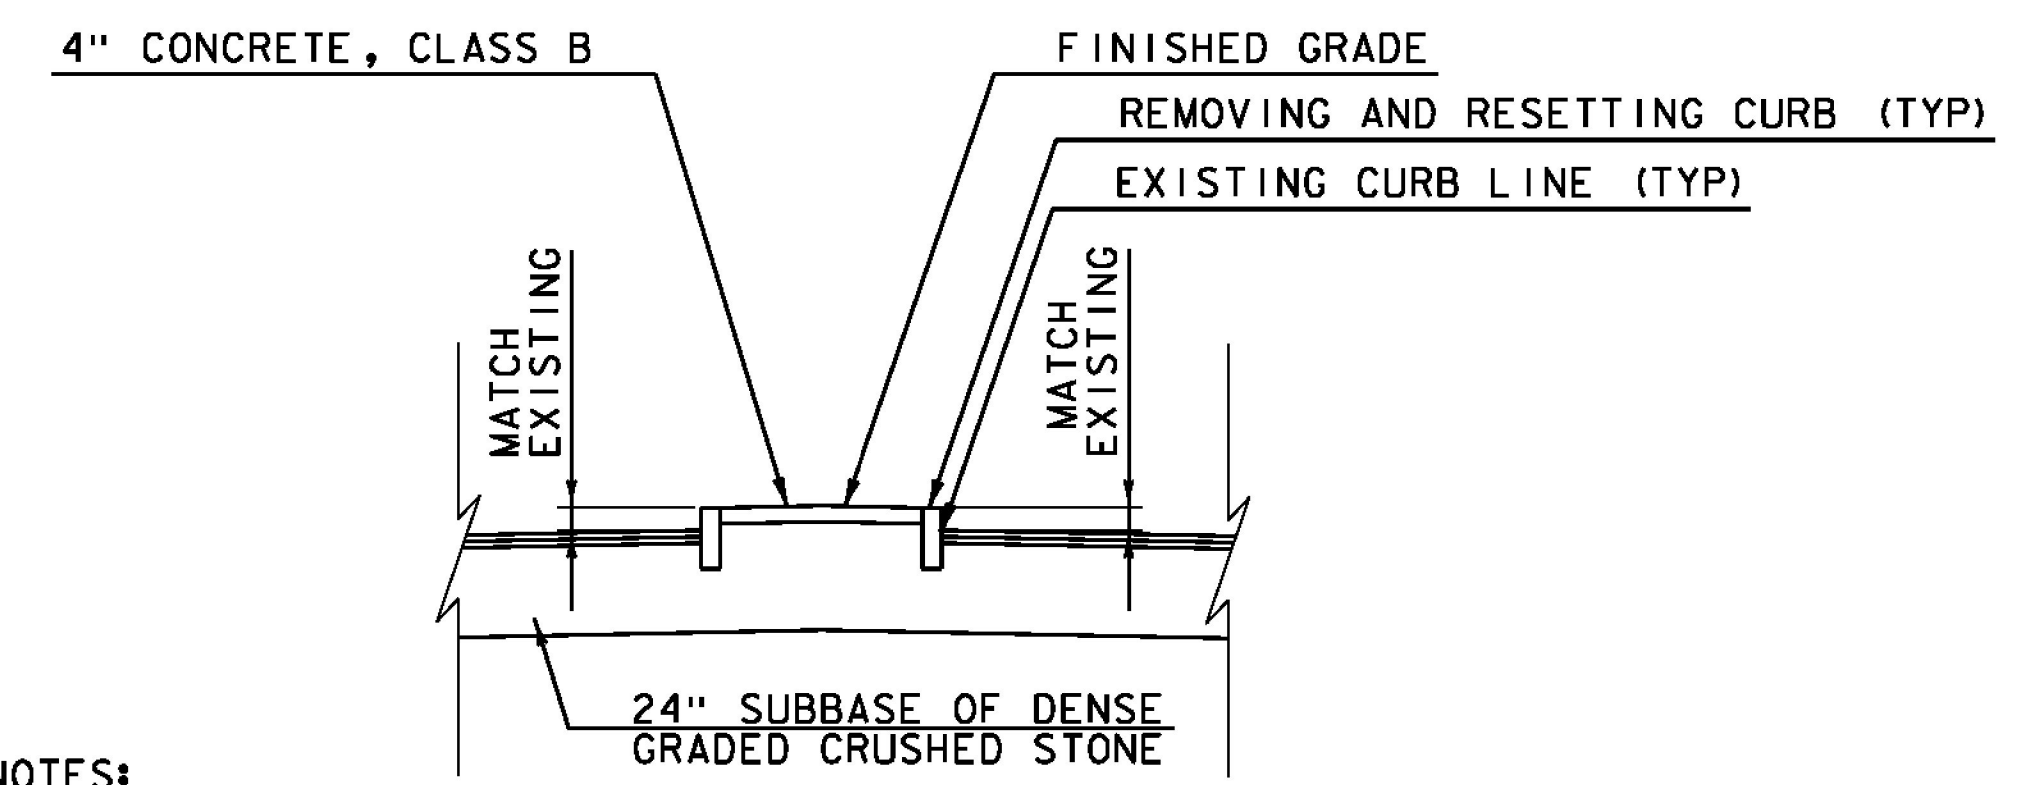


NOTES:

PAYMENT FOR FURNISHING, GRADING AND PLACING THE CONCRETE FOR THE MEDIAN ISLAND WILL BE INCLUDED IN THE UNIT PRICE BID FOR ITEM 900.675 SPECIAL PROVISION (PORTLAND CEMENT CONCRETE ISLAND TREATMENT, 4 INCH.)

SPECIAL PROVISION  
(PORTLAND CEMENT CONCRETE ISLAND  
TREATMENT, 4-INCH)


NOT TO SCALE

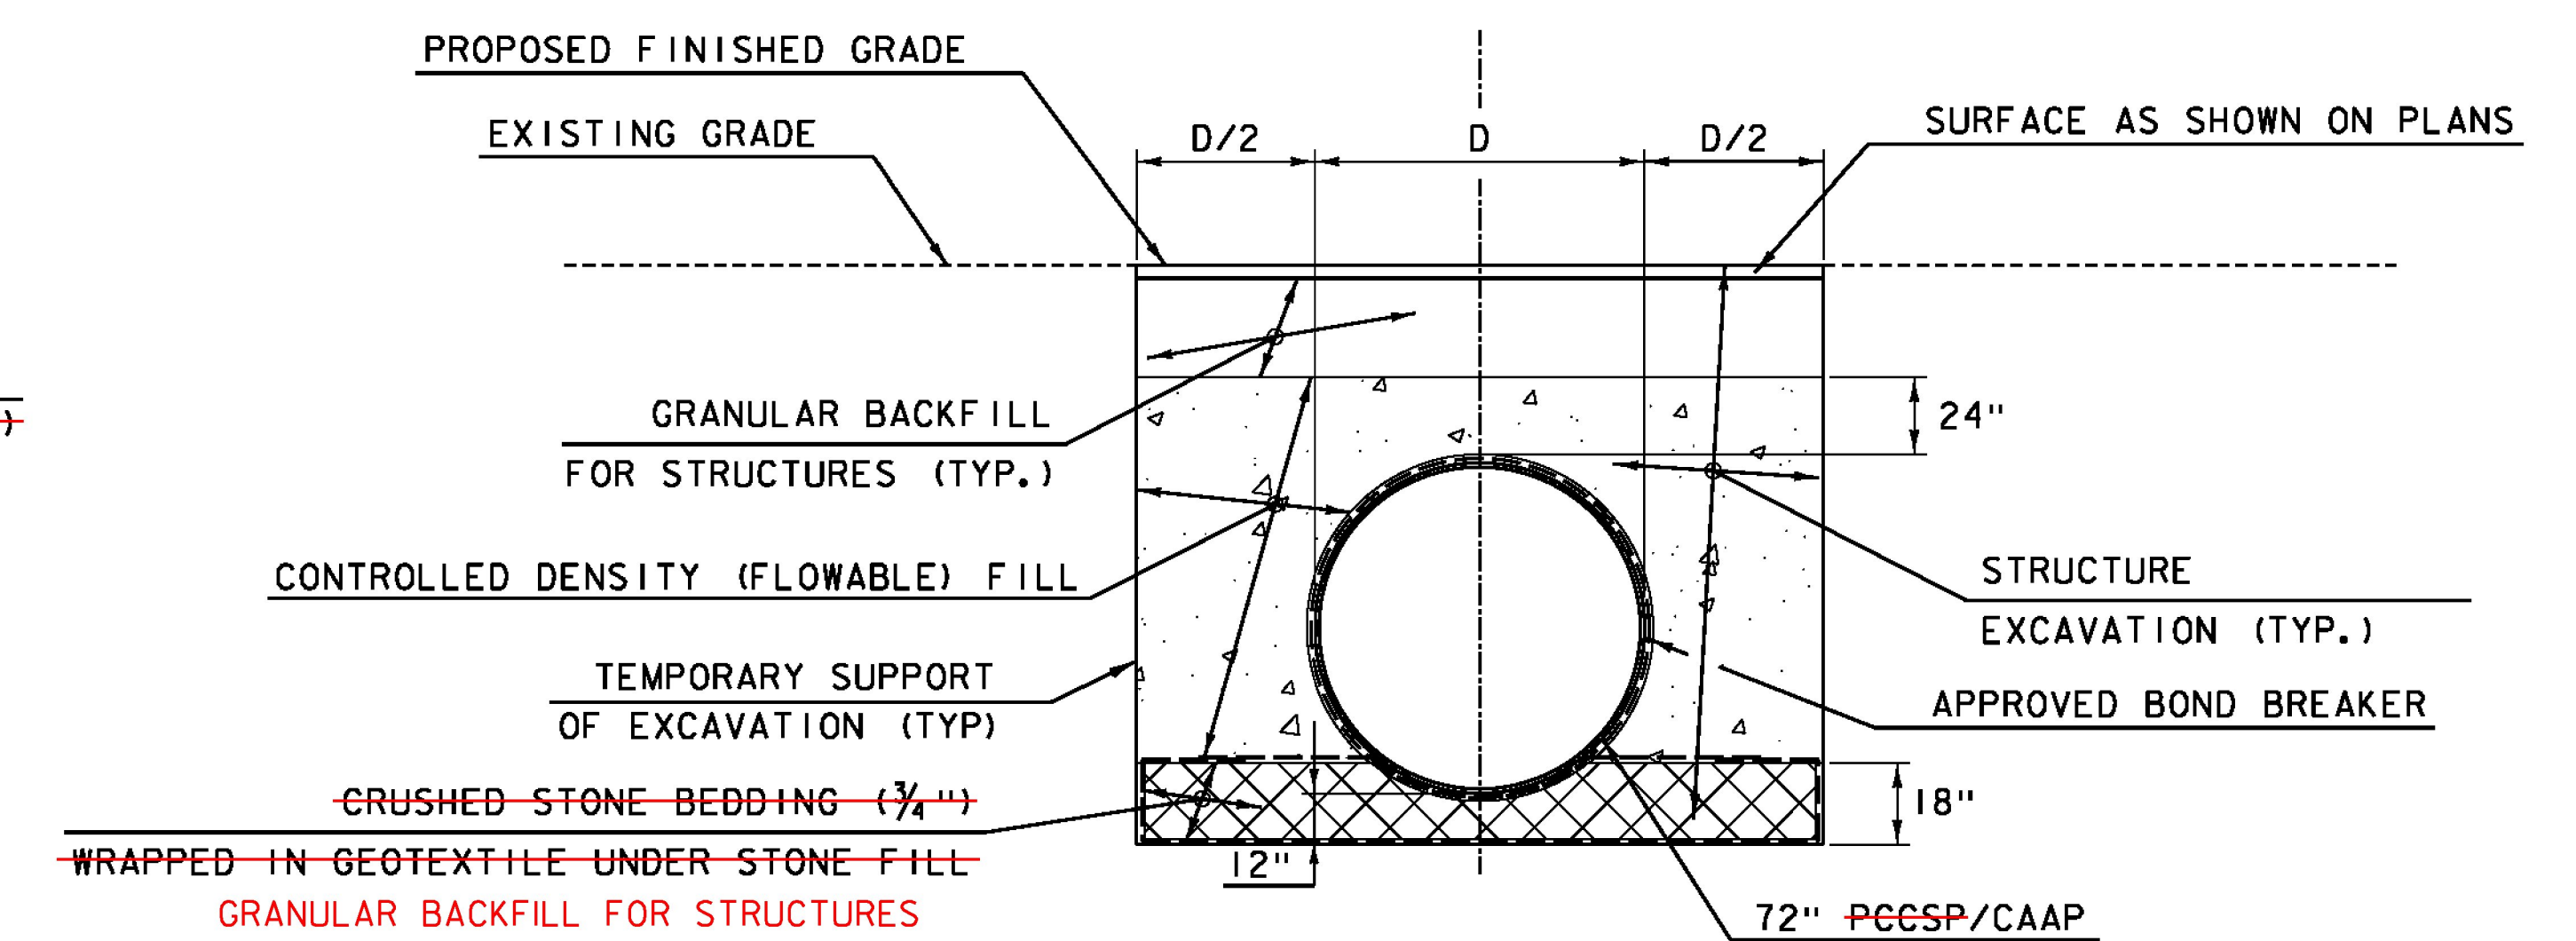


TYPICAL TRENCH DETAIL FOR 72" PCCSP/CAAP  
WITH CONTROLLED DENSITY (FLOWABLE) FILL

NOT TO SCALE

PROJECT NAME: PERU	PLOT DATE: 12/31/2014
PROJECT NUMBER: STP SCR(4)	DRAWN BY: M. BRADLEY
FILE NAME: z07b106det.dgn	DESIGNED BY: M. BRADLEY
PROJECT LEADER: E. ATKINS	CHECKED BY: E. ATKINS
DETAIL SHEET 1	SHEET 7 OF 45

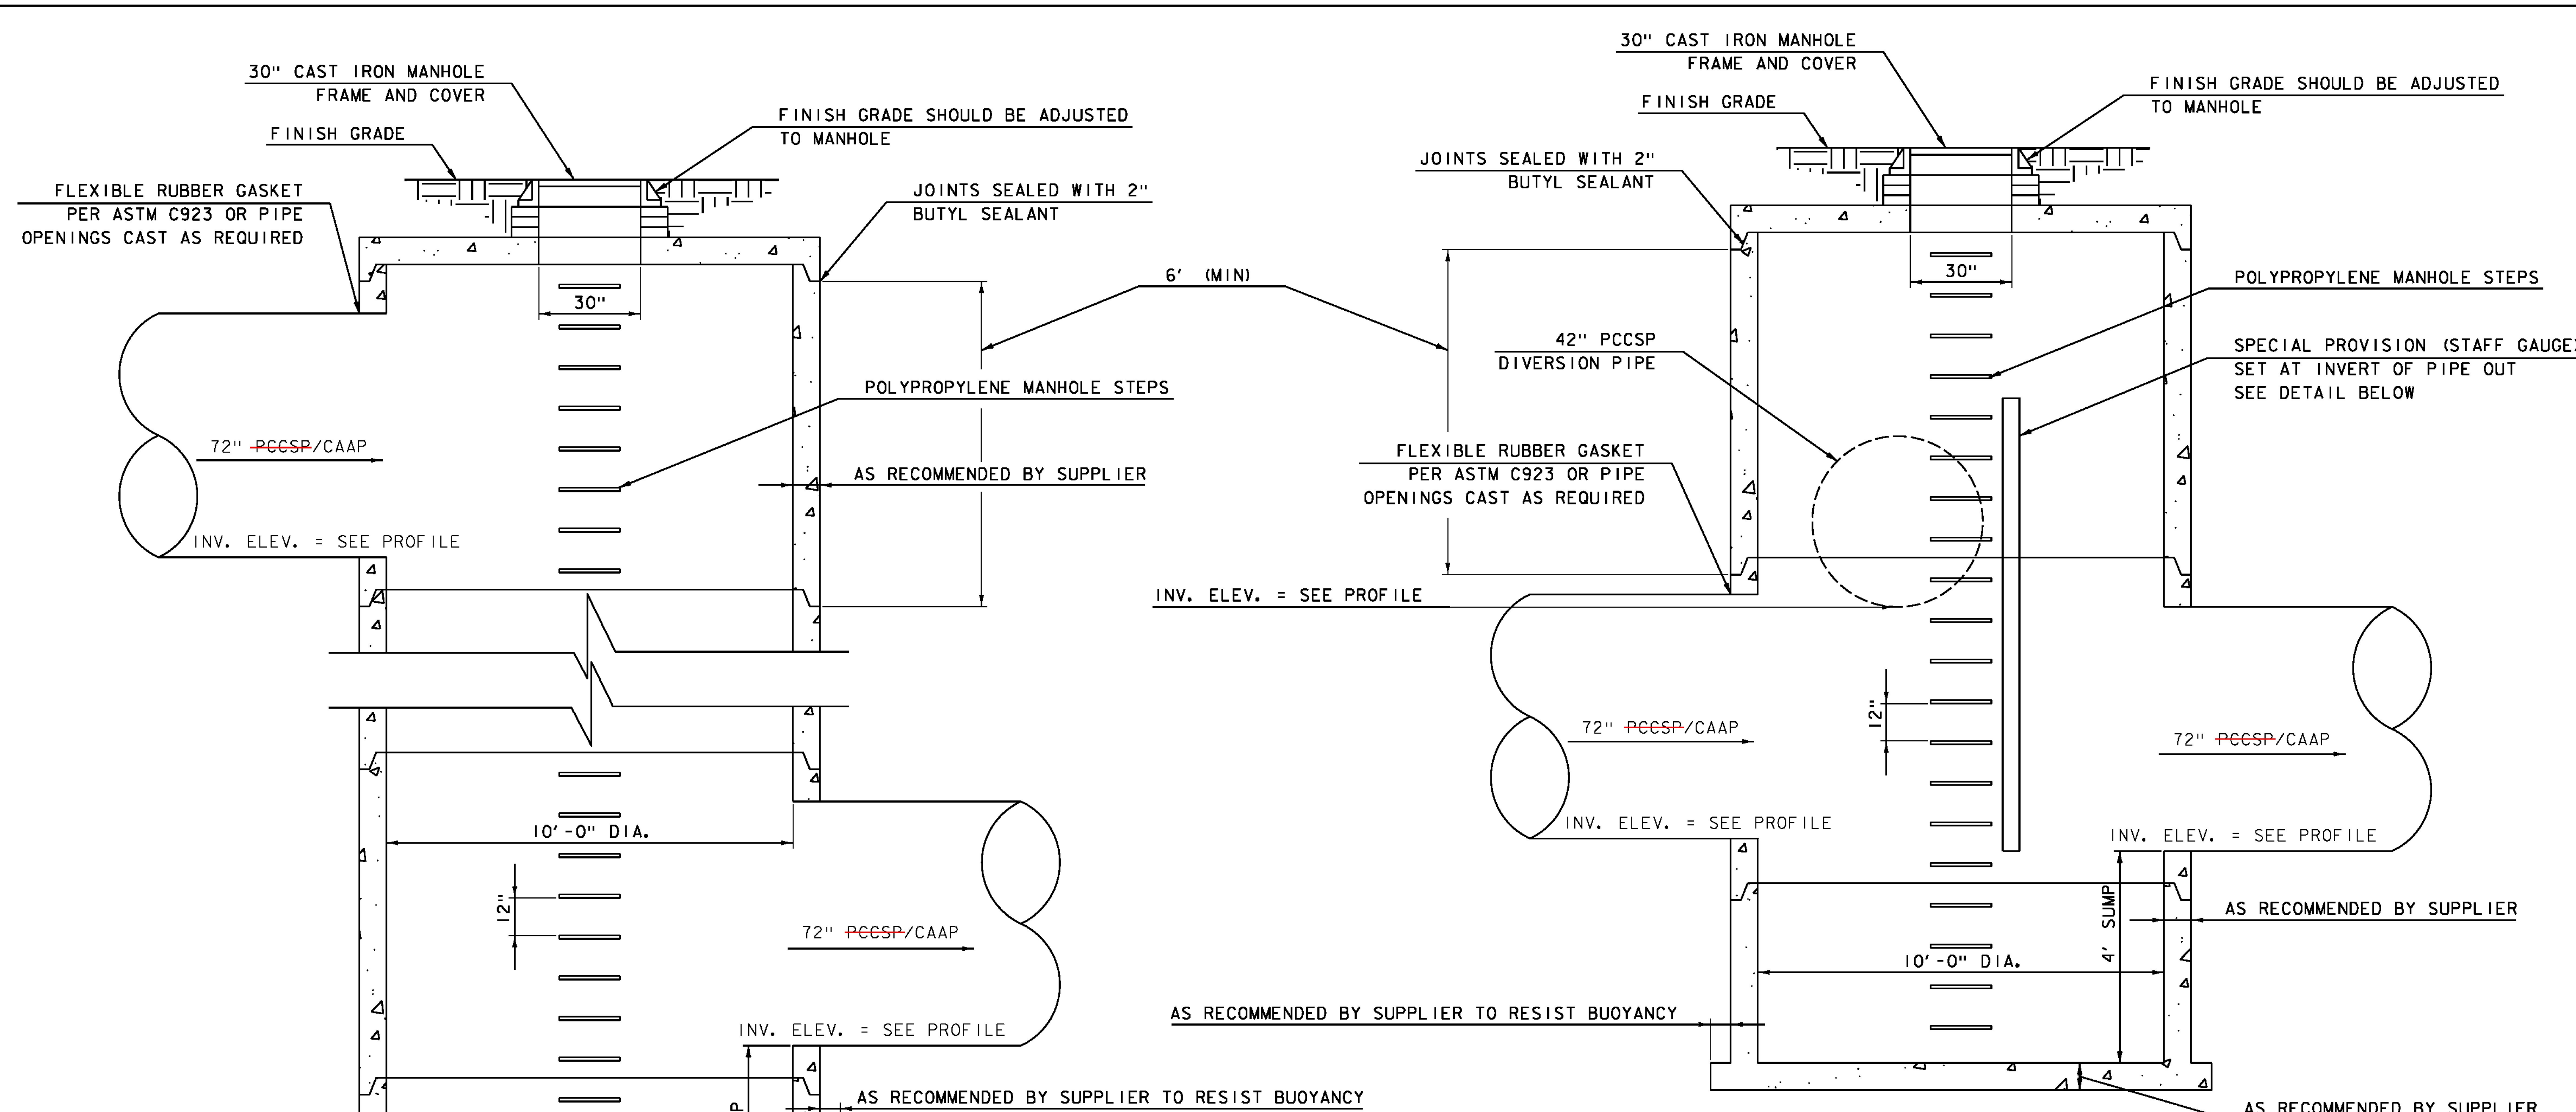


**10' DIA. MANHOLE W/ EXTENDED BASE DETAIL**  
NOT TO SCALE

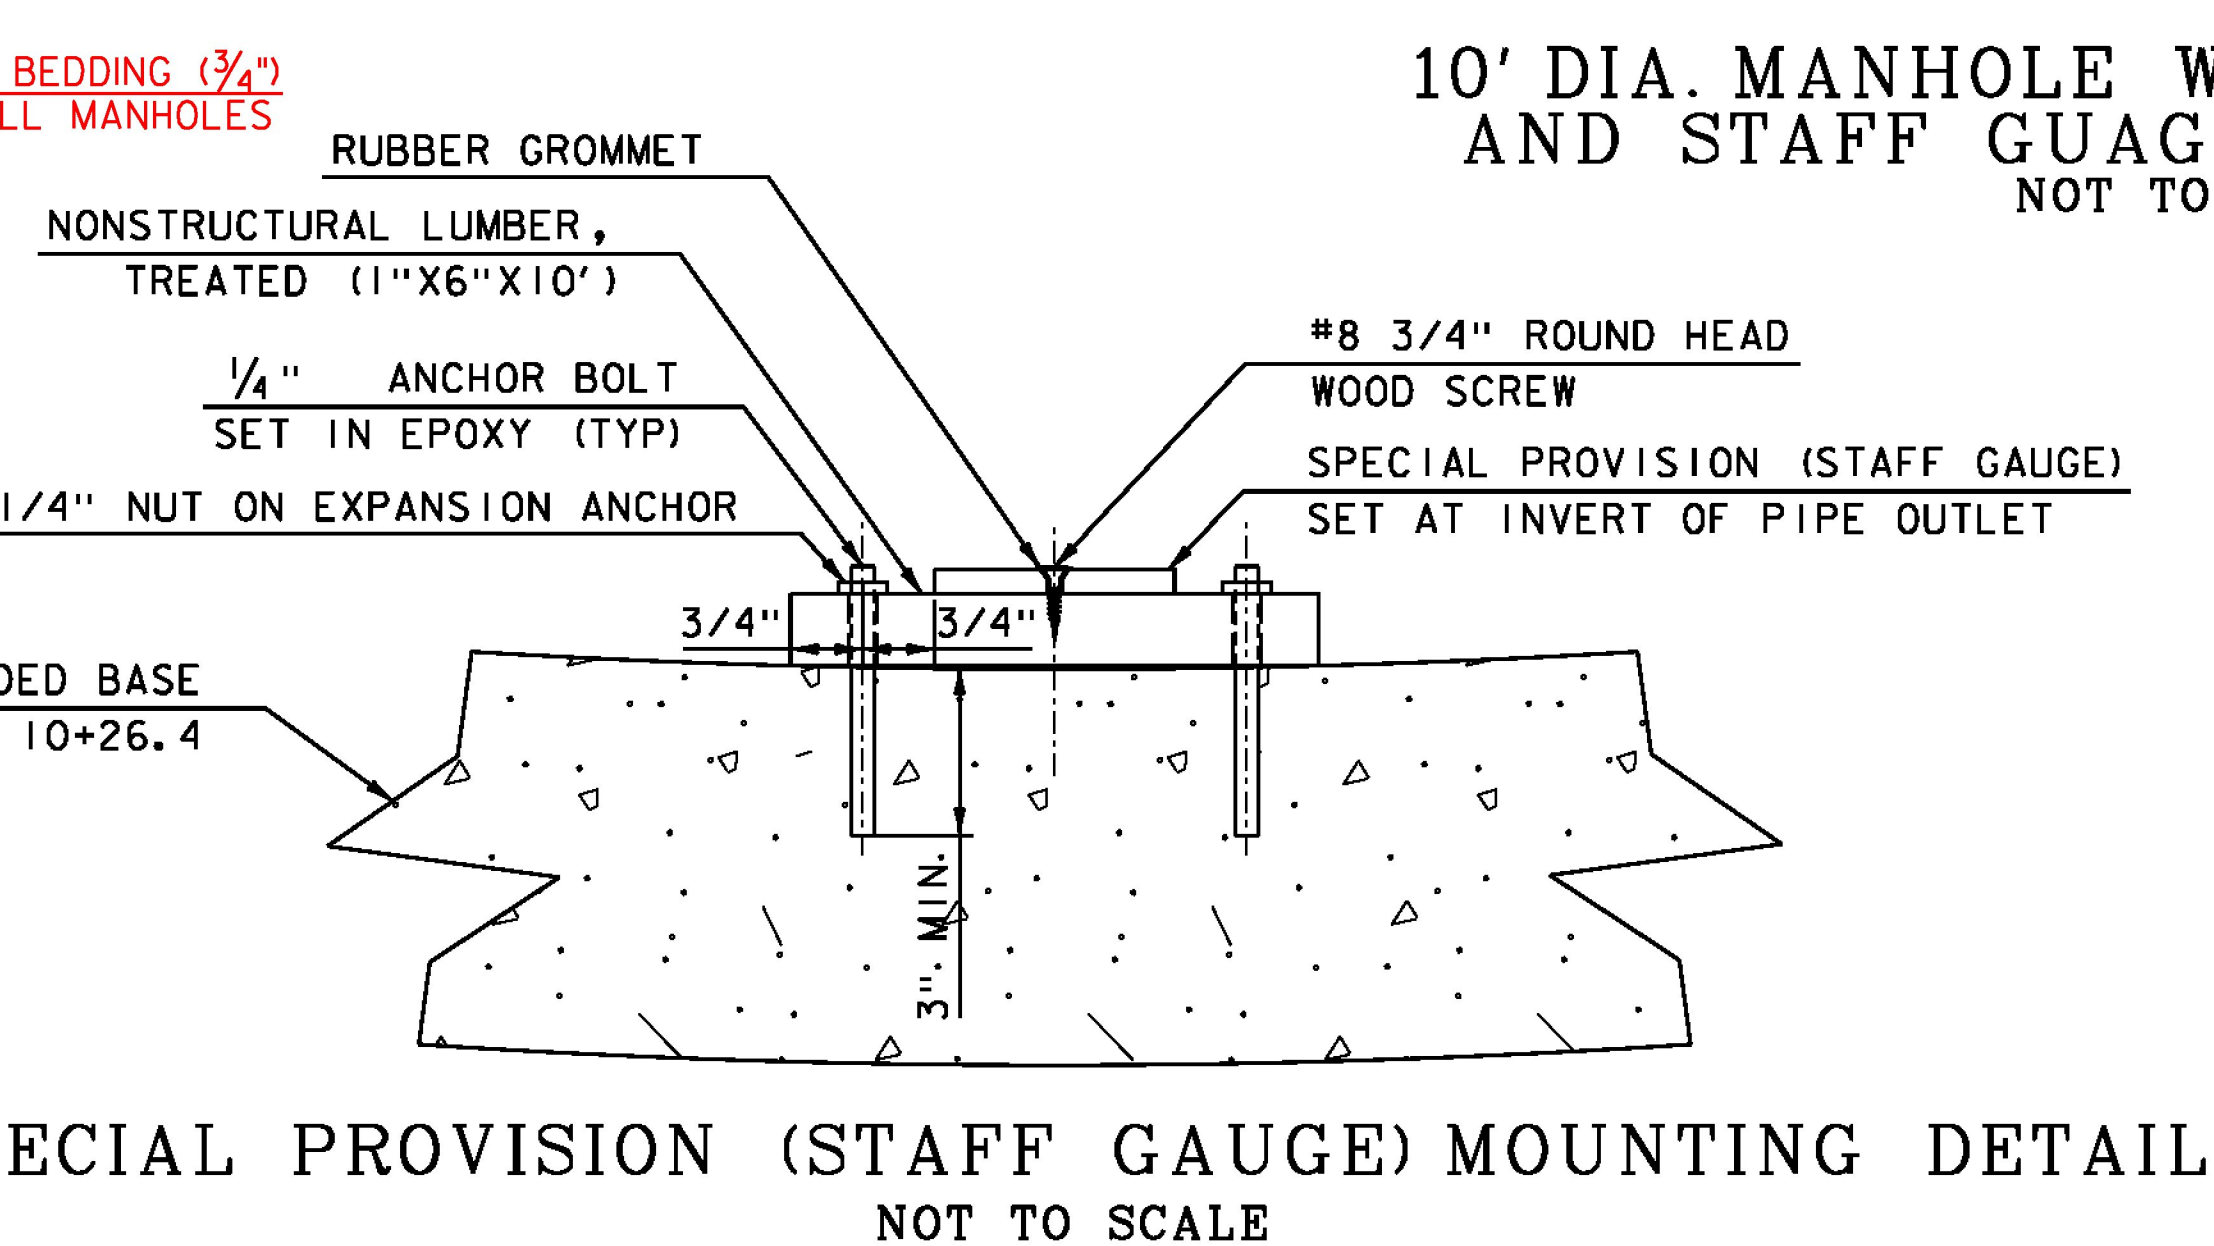


**SPECIAL PROVISION (STAFF GAUGE) MOUNTING DETAIL**  
NOT TO SCALE

**10' DIA. MANHOLE W/ EXTENDED BASE AND STAFF GAUGE AT STA. 10+26.4**  
NOT TO SCALE


PROJECT NAME: PERU	PLOT DATE: 12/31/2014
PROJECT NUMBER: STP SCRP(4)	DRAWN BY: M. BRADLEY
FILE NAME: z07b106det.dgn	DESIGNED BY: M. BRADLEY
PROJECT LEADER: E. ATKINS	CHECKED BY: E. ATKINS
DETAIL SHEET 2	SHEET 8 OF 45

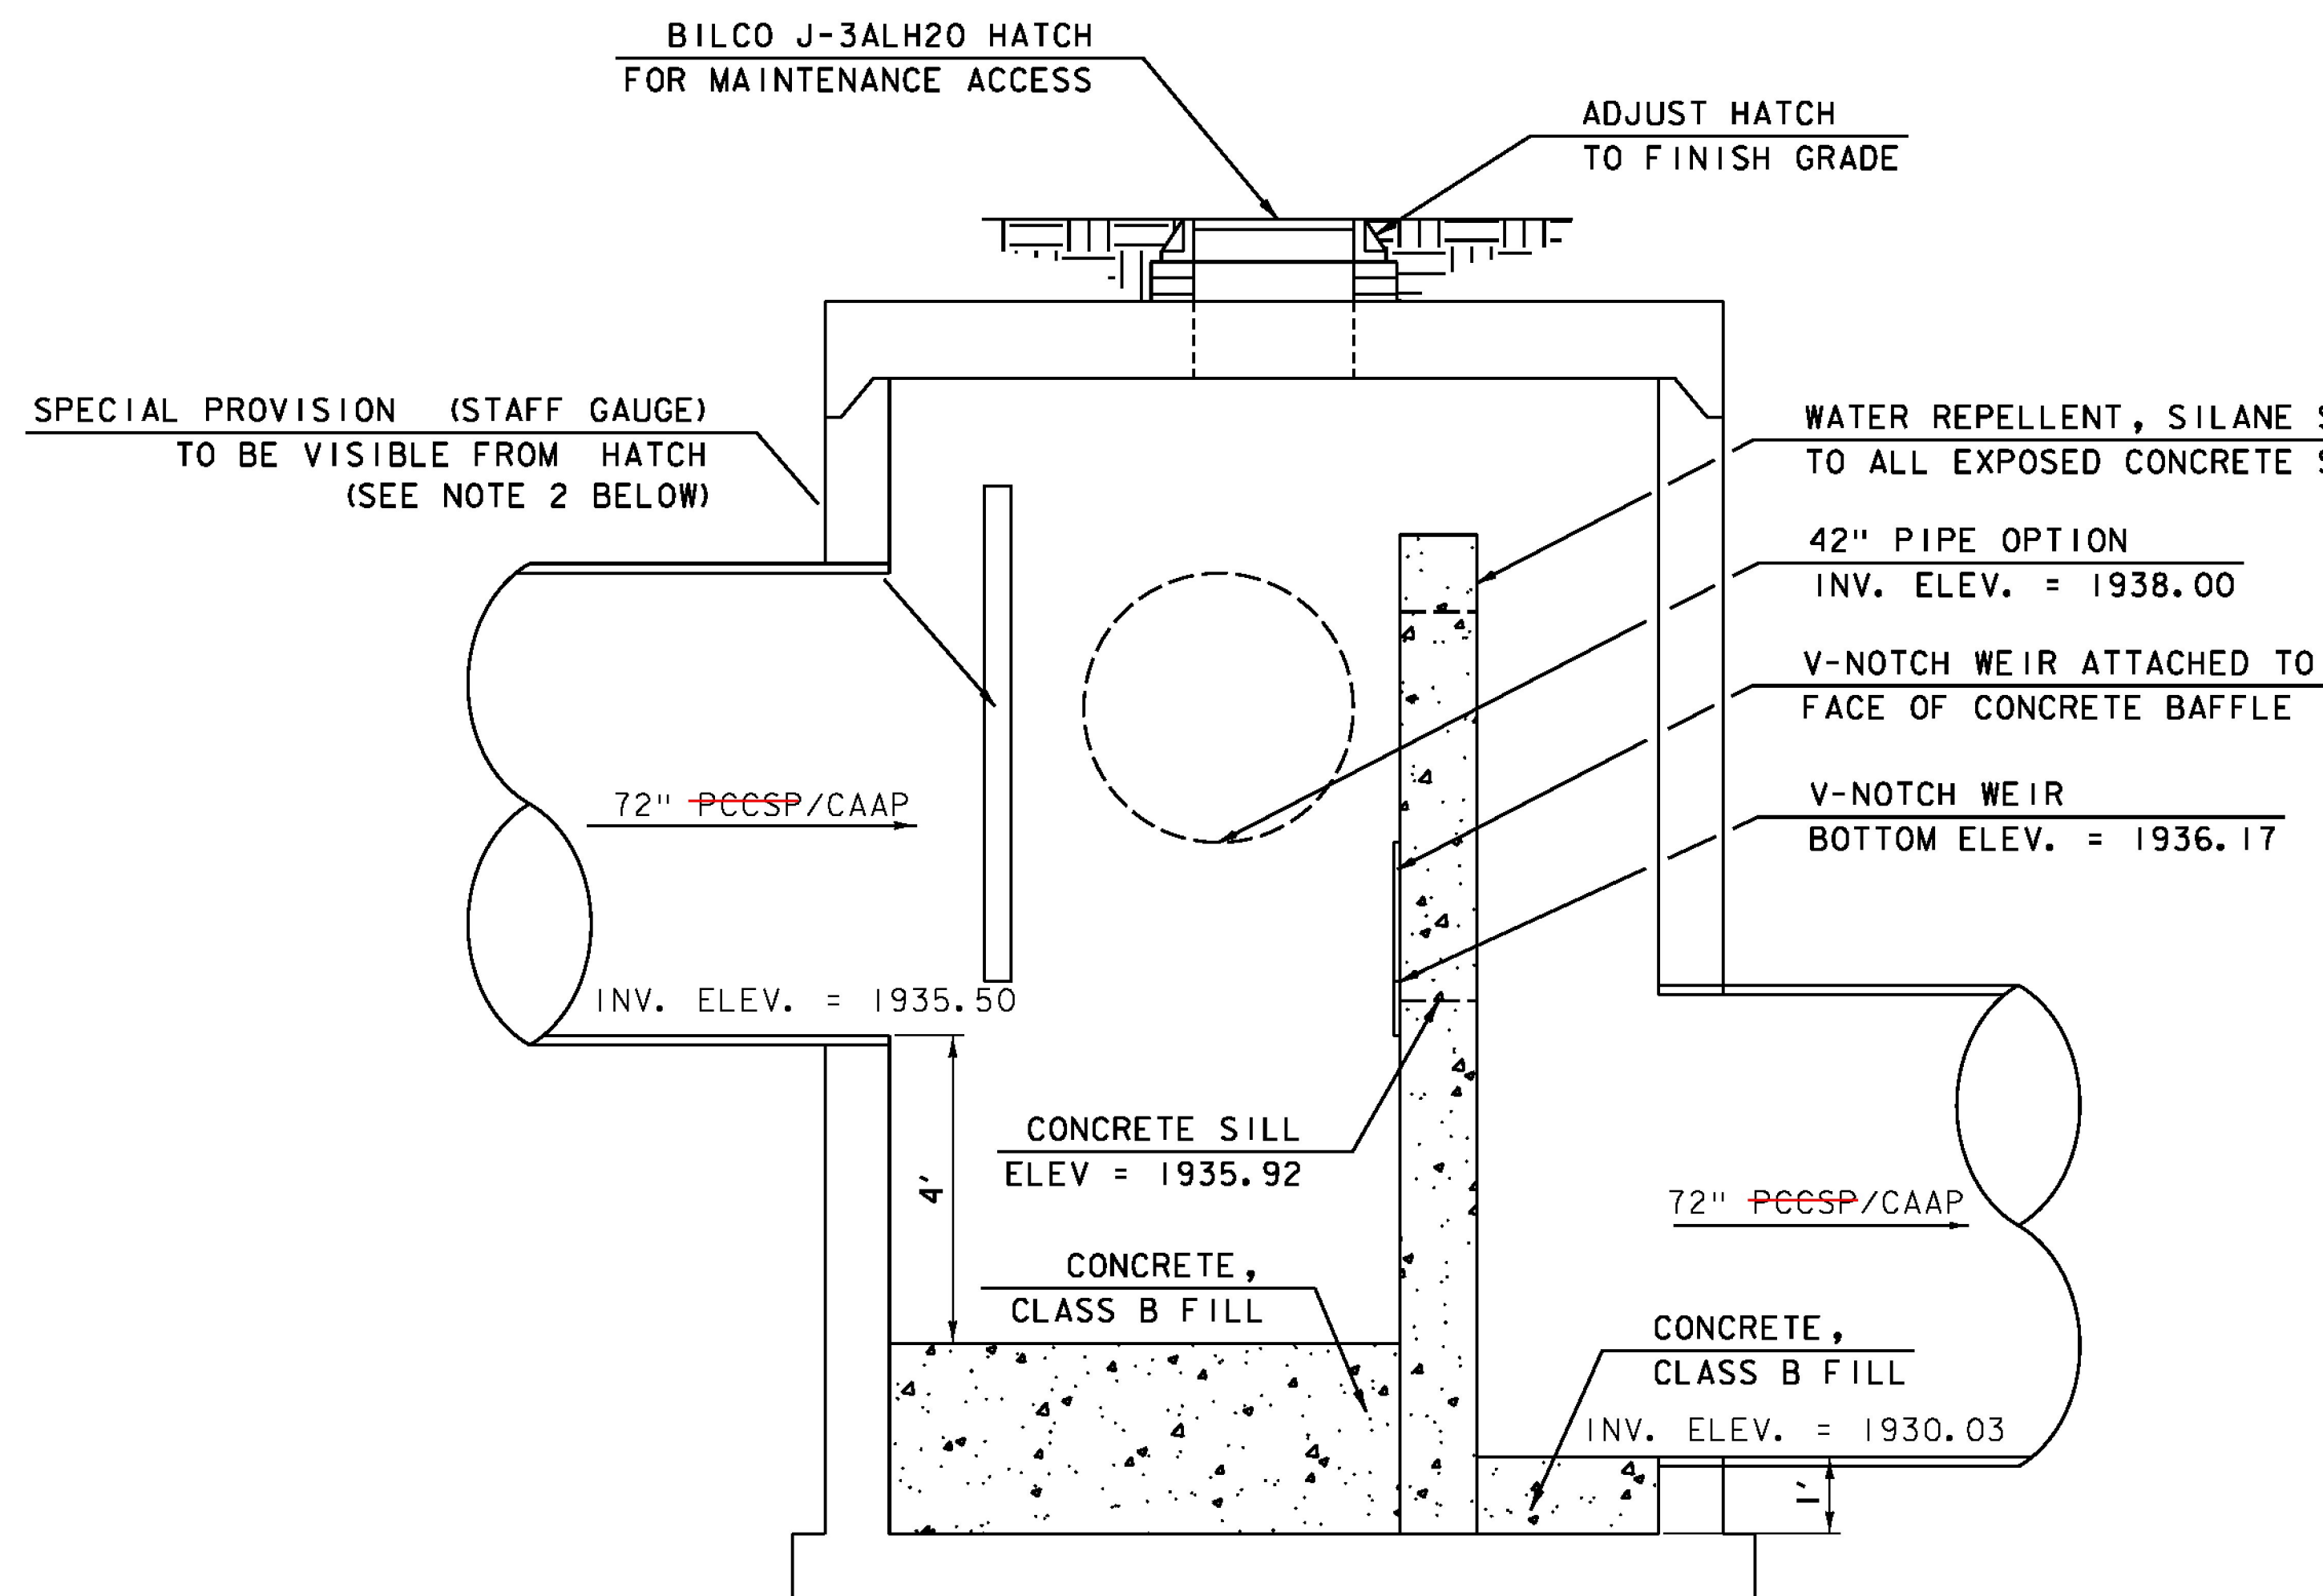

10' DIA. MANHOLE W/ EXTENDED BASE, BAFFLE AND STAFF GAUGE AT STA. 10+26.4  
NOT TO SCALE

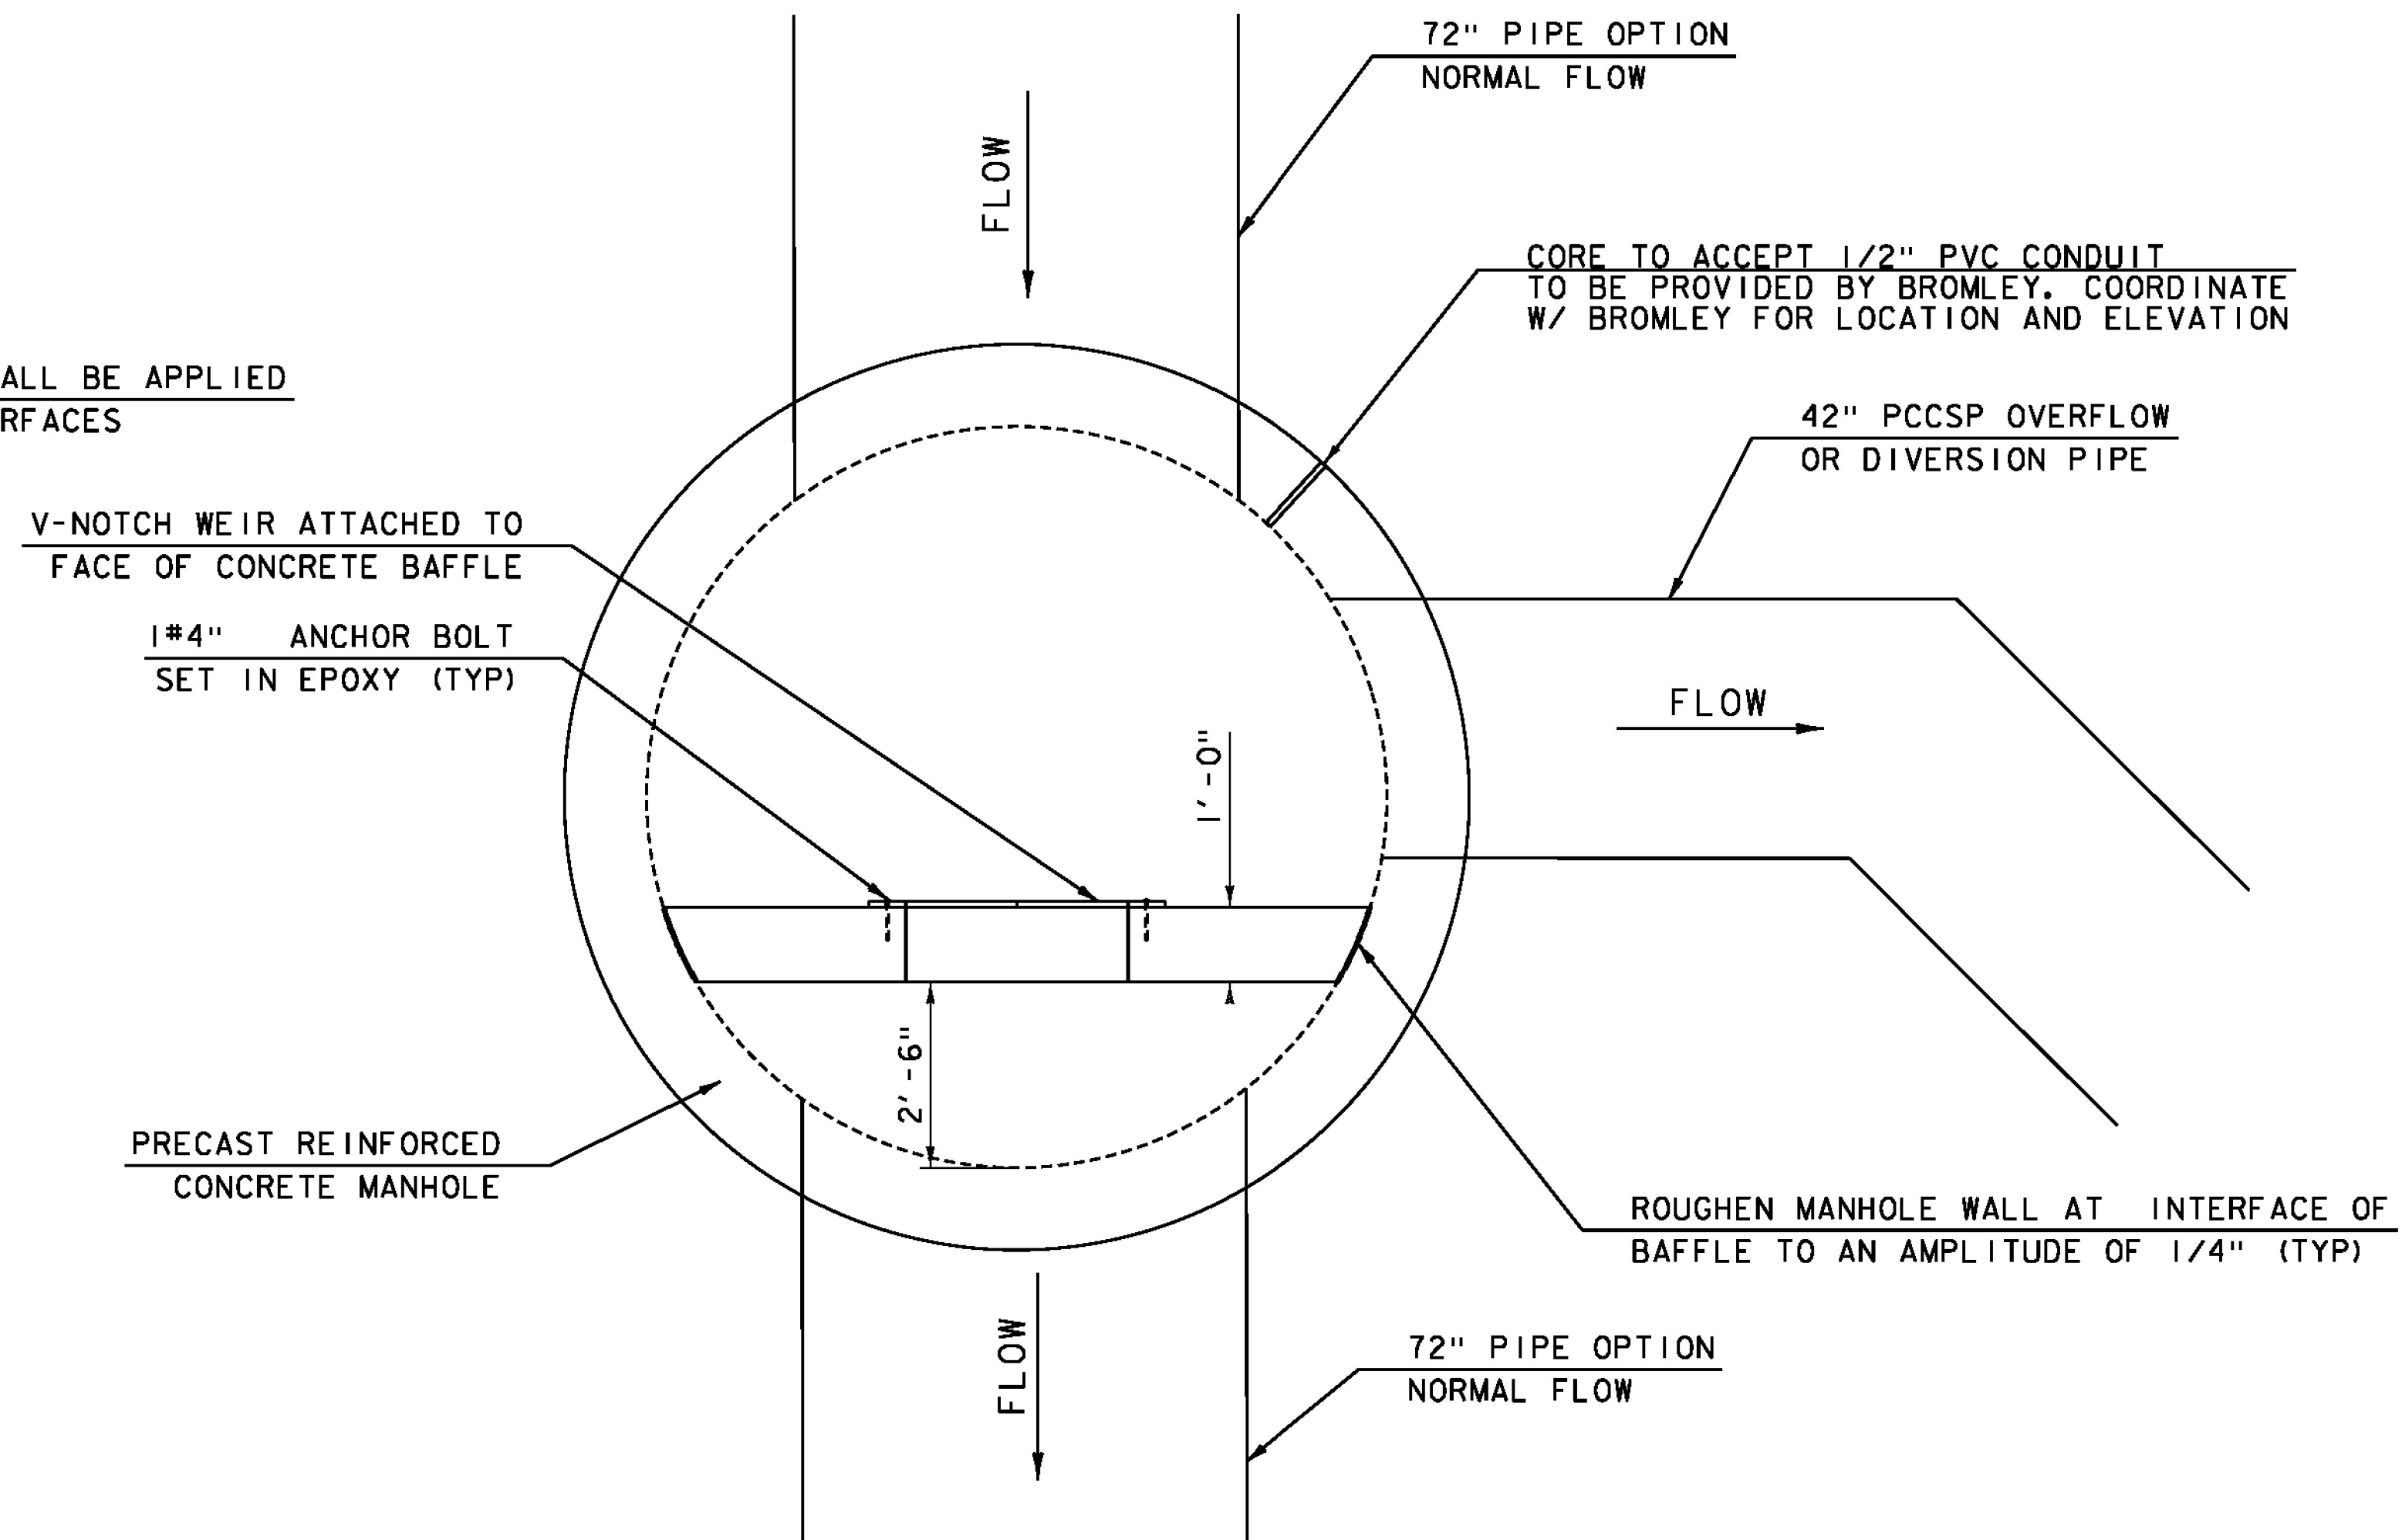

PLAN  
NOT TO SCALE

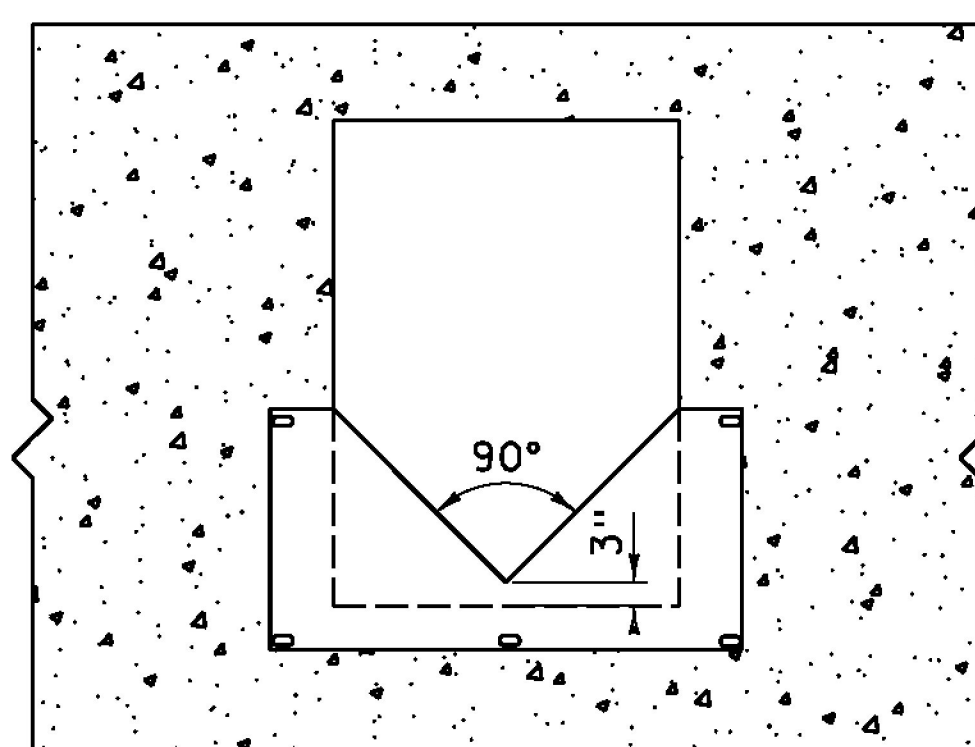

BAFFLE CUTOUT DETAIL  
NOT TO SCALE

NOTES:



- 1.) STEPS SHALL BE INCLUDED INSIDE THE MANHOLE AND SHALL BE POSITIONED BELOW THE ACCESS HATCH
- 2.) SET "0.00" AT ELEVATION 1936.17 (BOTTOM OF V-NOTCH WEIR)
- 3.) PIPES SHALL RUN AT 0.4%, THE CORRESPONDING OUTLET ELEVATION FOR THE STRUCTURE LOCATED AT 10+50.68 IS 1935.56

ADDED SHEET  
STR #1 DETAILS


PROJECT NAME: PERU  
PROJECT NUMBER: STP SCRP(4)

FILE NAME: z07b106det.dgn  
PROJECT LEADER: E. ATKINS  
DESIGNED BY: M. BRADLEY  
CHANGE DETAIL #1

PLOT DATE: 12/31/2014  
DRAWN BY: M. BRADLEY  
CHECKED BY: E. ATKINS  
SHEET +8A OF 245

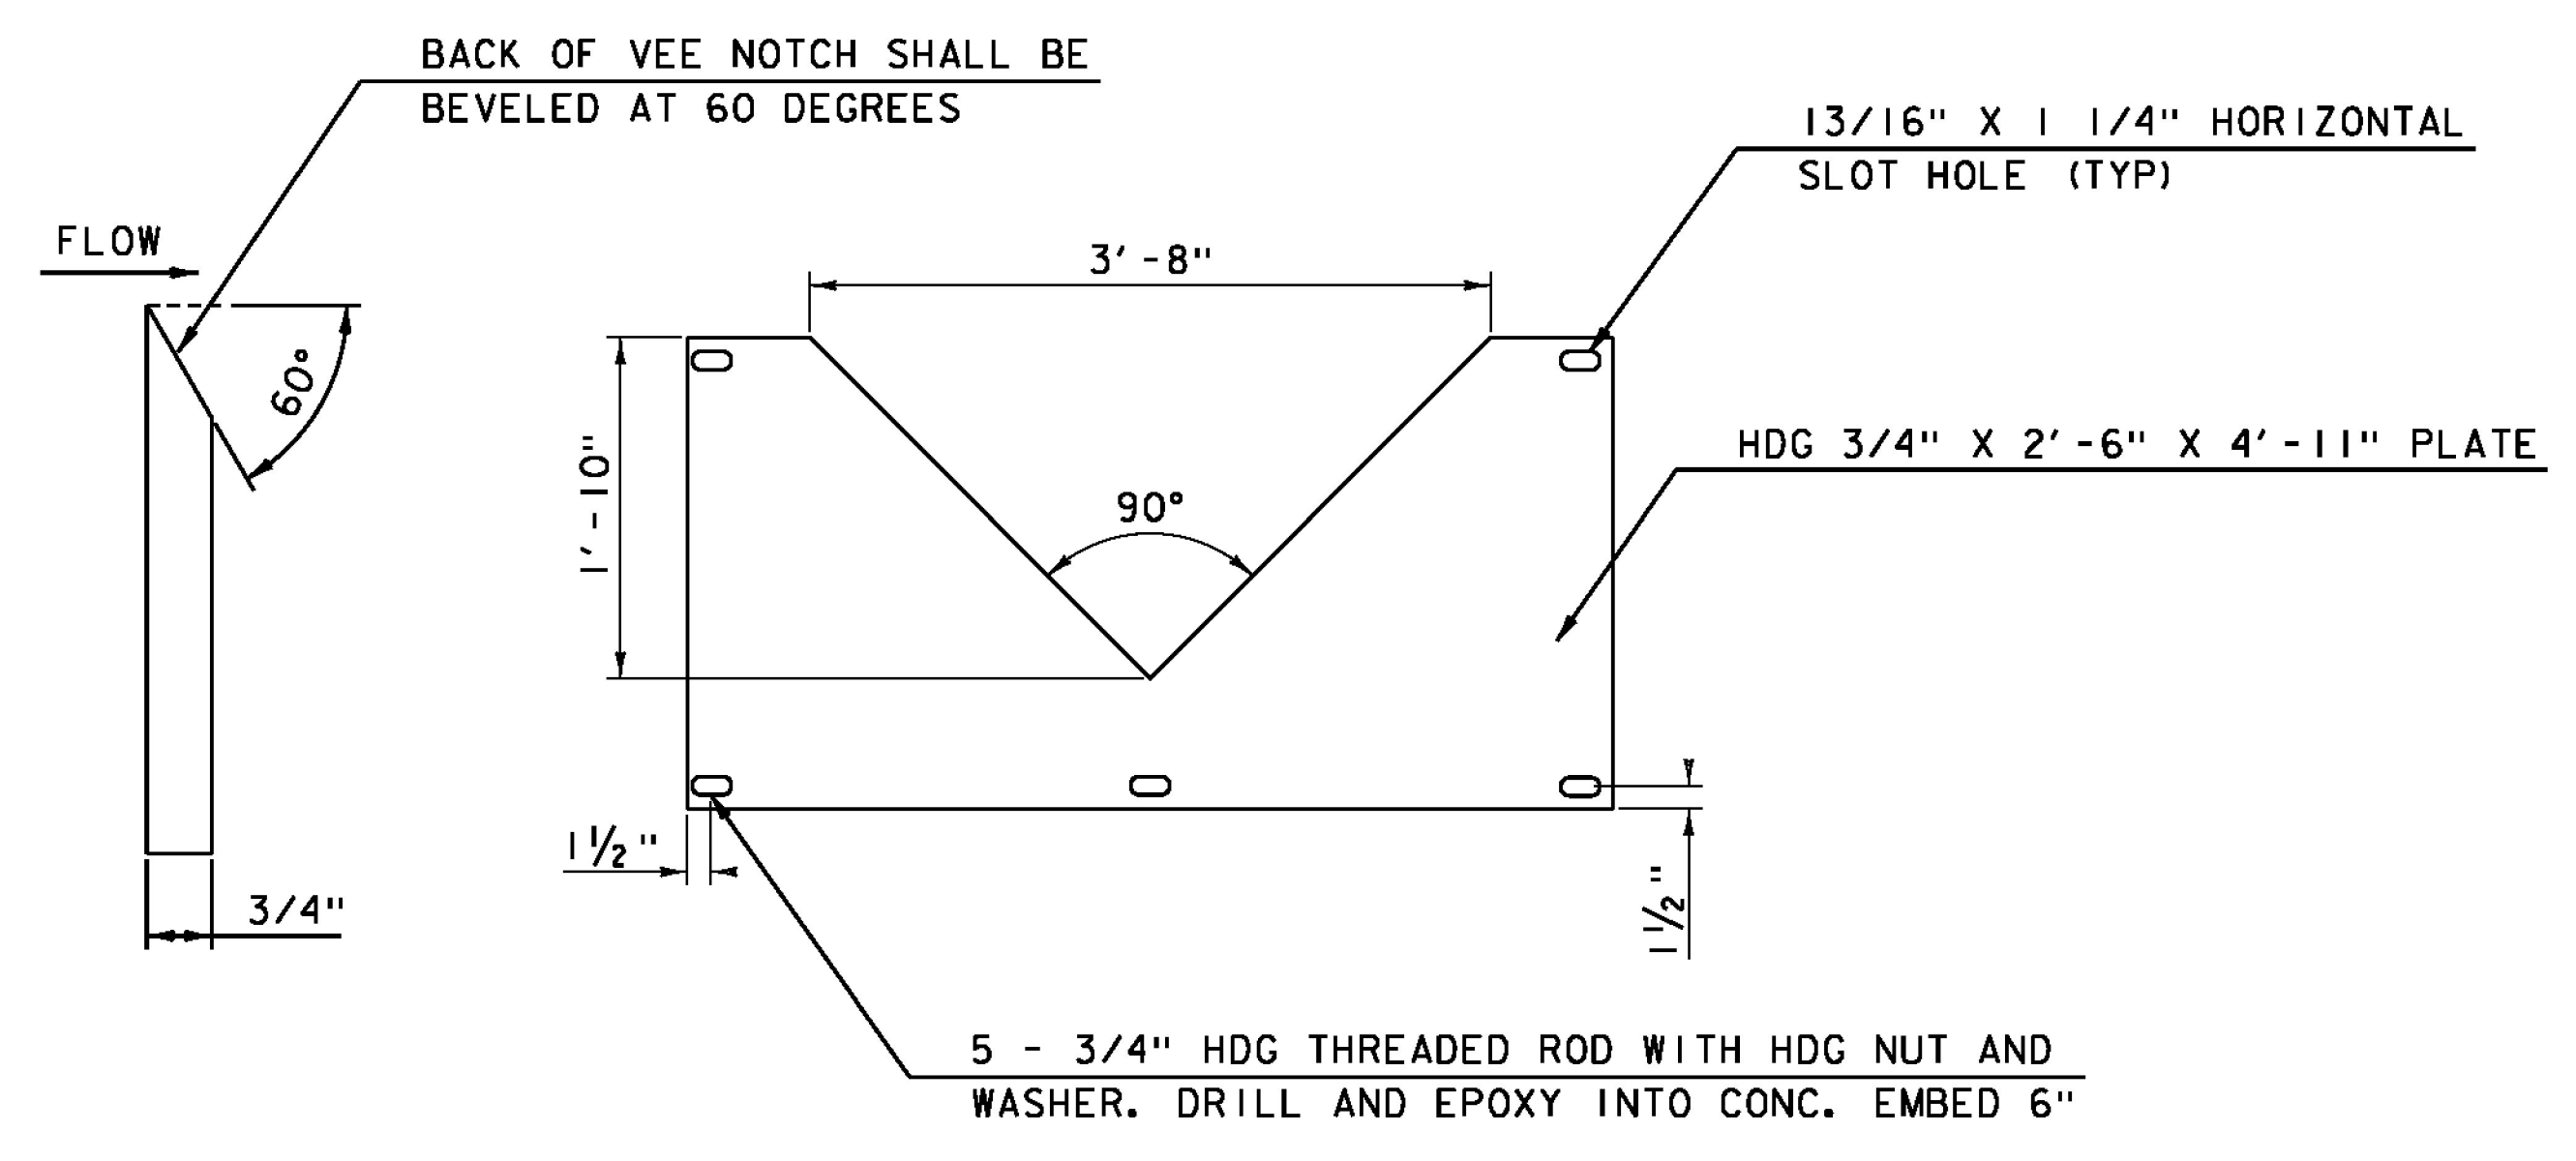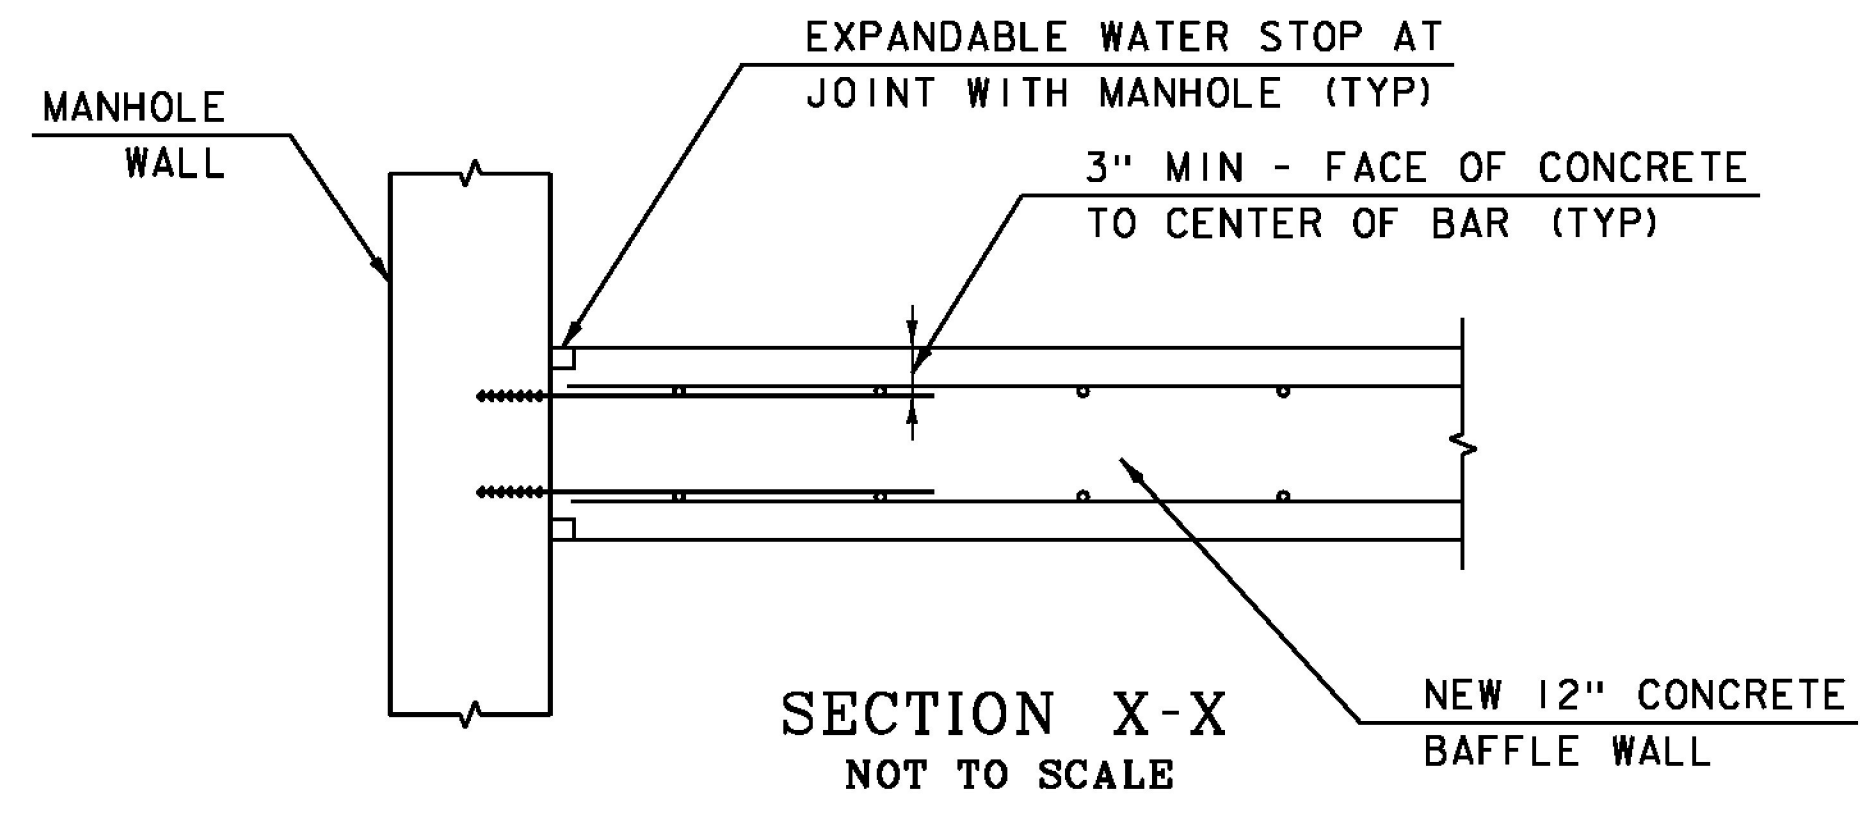

**WEIR DETAIL**  
NOT TO SCALE

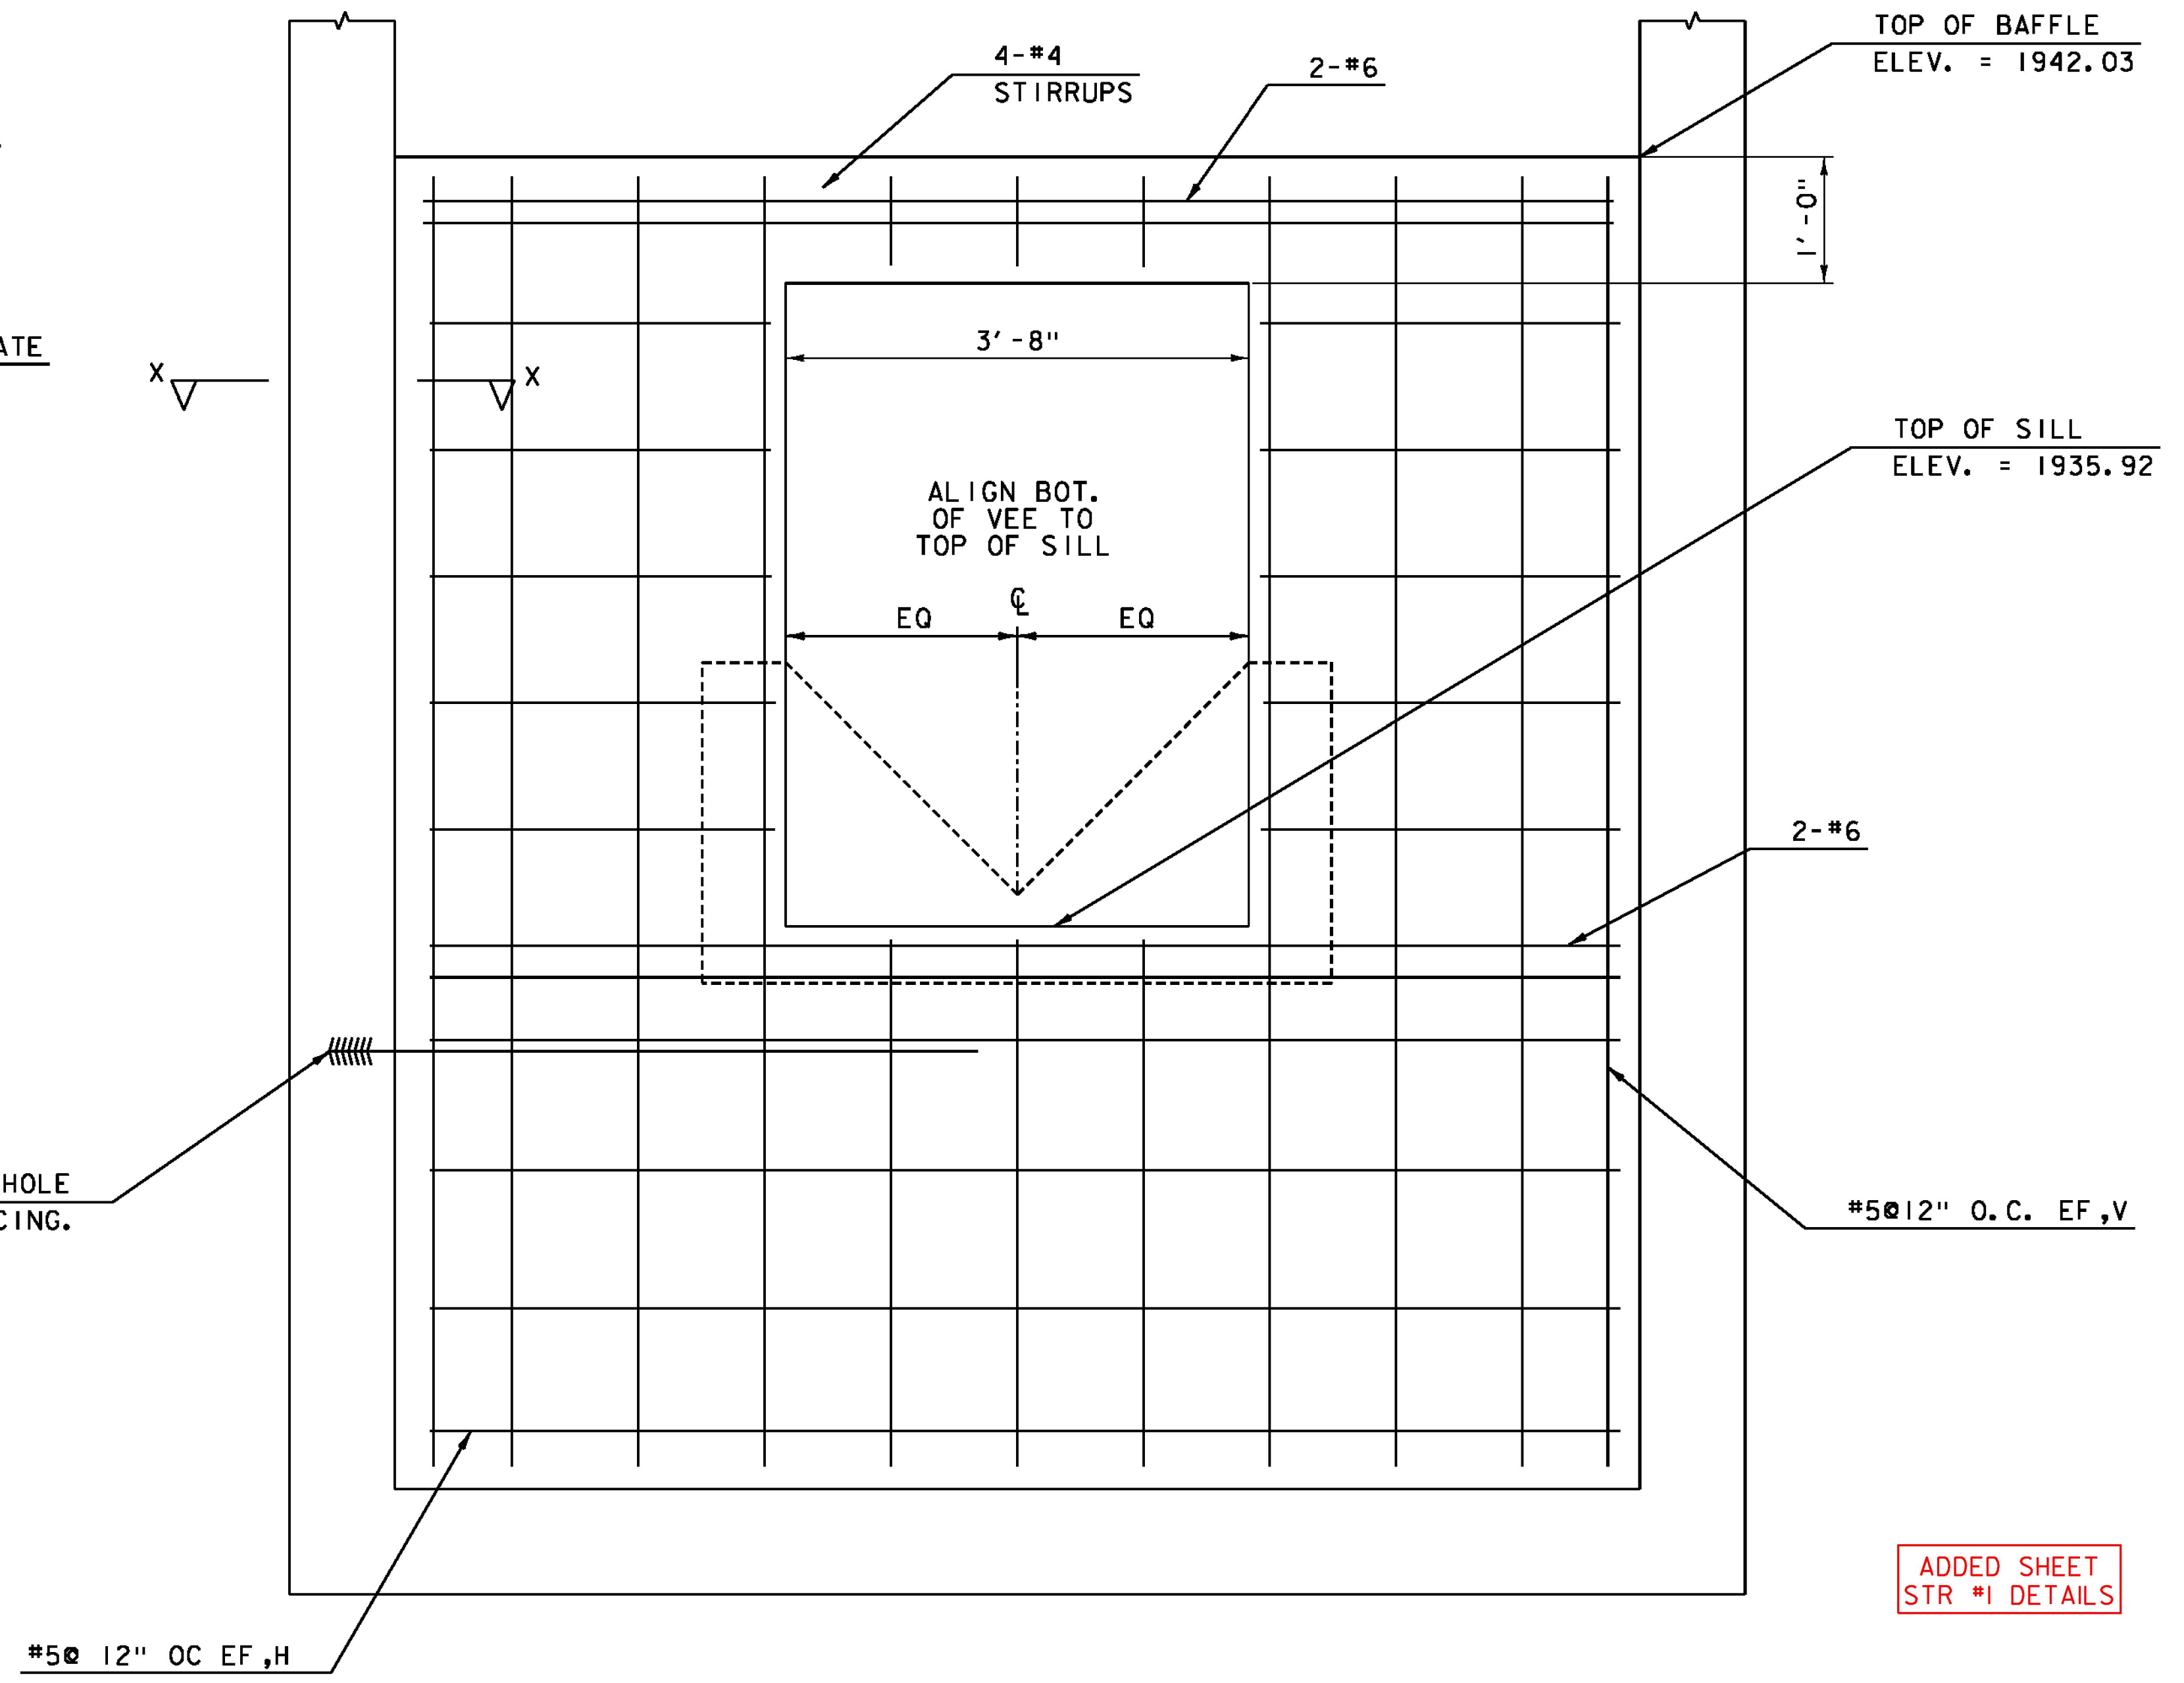


**BAFFLE ELEVATION**  
NOT TO SCALE

**NOTES:**


- 1.) CONCRETE AND REINFORCING STEEL FOR THE BAFFLE SHALL MEET THE REQUIREMENTS OF SHEET 5 OF THE CONCRAC T PLANS
- 2.) HDG = HOT DIPPED GALVANIZED

ADDED SHEET STR #1 DETAILS

PROJECT NAME: PERU	PLOT DATE: 12/31/2014
PROJECT NUMBER: STP SCRP(4)	DRAWN BY: M. BRADLEY
FILE NAME: z07b106det.dgn	CHECKED BY: E. ATKINS
PROJECT LEADER: E. ATKINS	SHEET 28 OF 25
DESIGNED BY: M. BRADLEY	
CHANGE DETAIL #2	


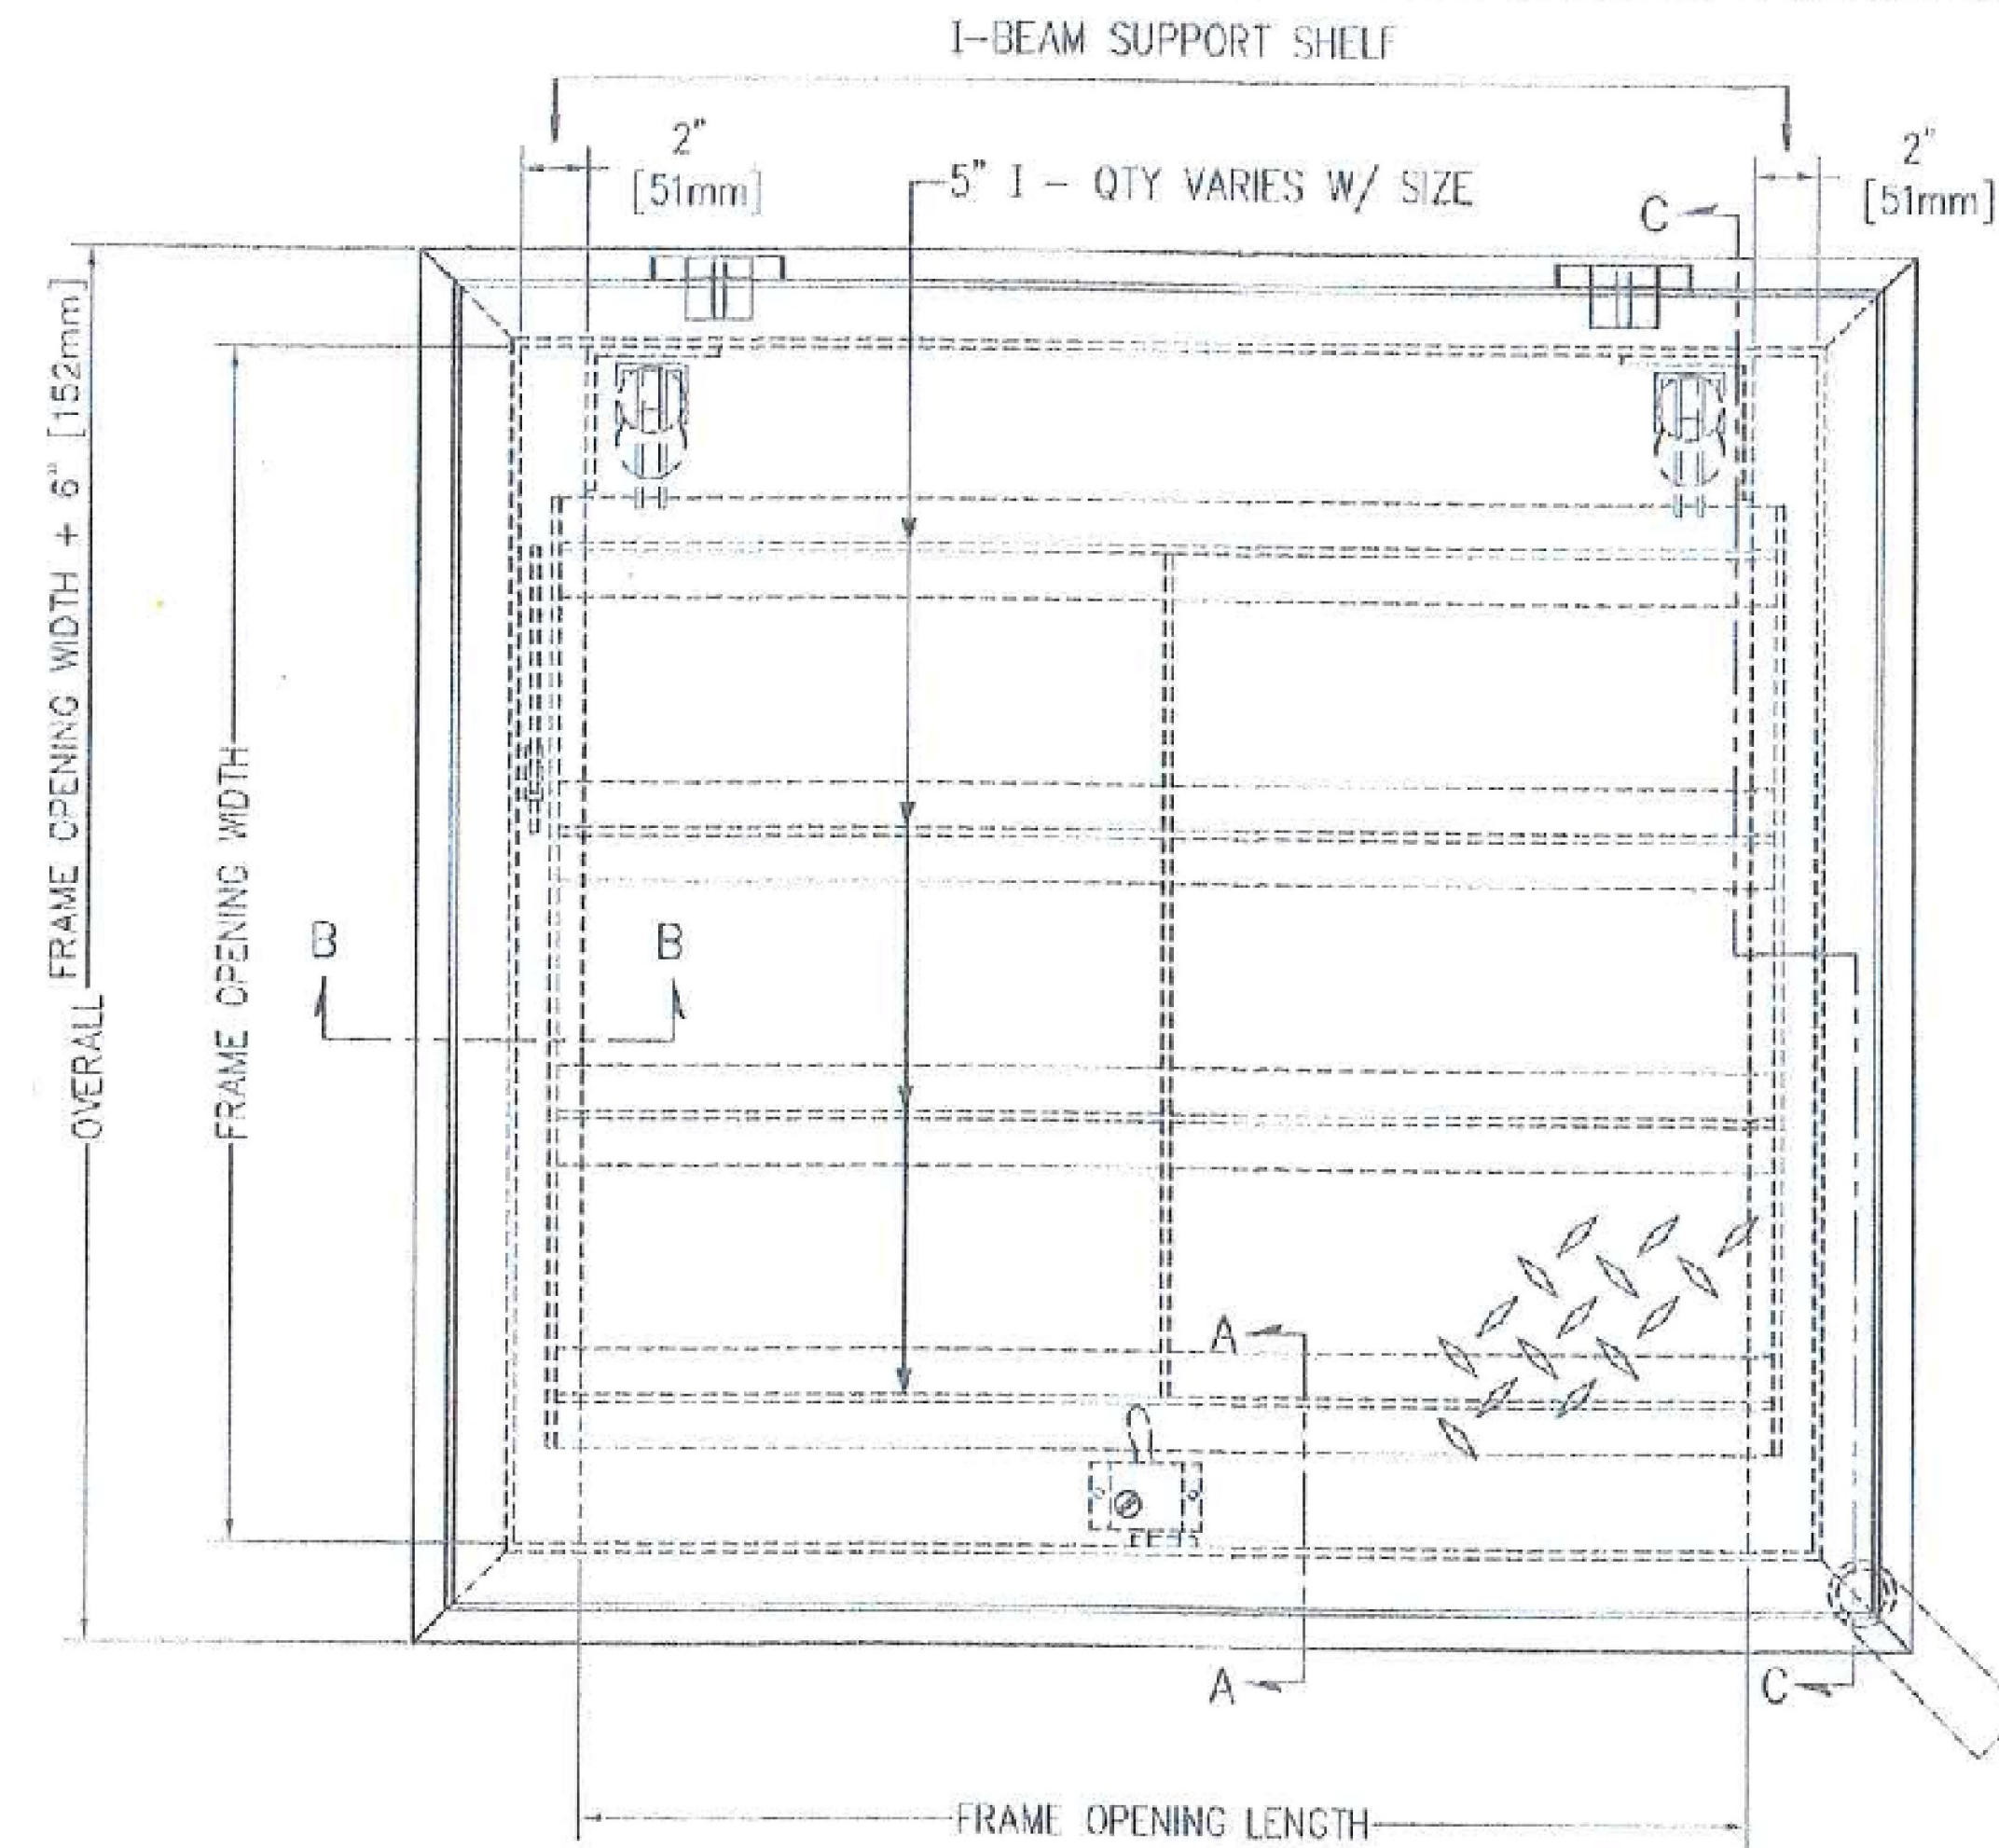


NOTE:  
DESIGNED TO WITHSTAND H-20 WHEEL  
LOADINGS SUITABLE FOR USE IN OFF-  
STREET LOCATIONS WHERE NOT SUBJECTED  
TO HIGH DENSITY TRAFFIC

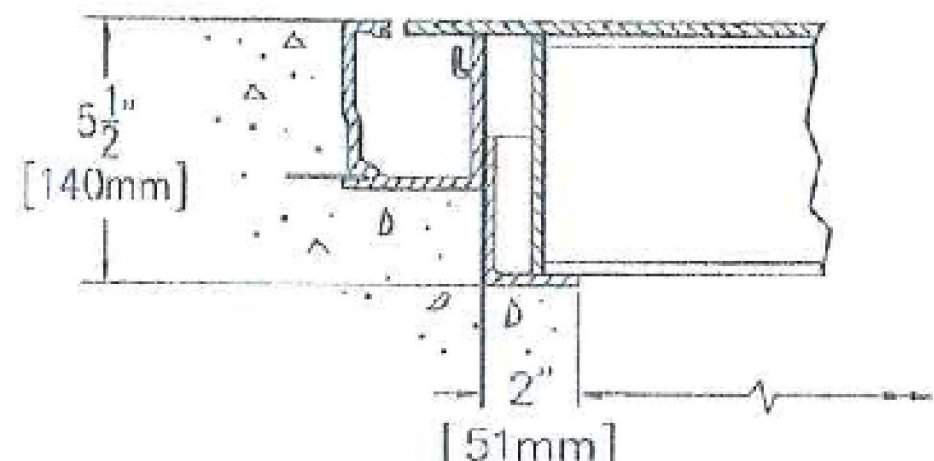


CHANNEL SUPPORT SHELF MUST  
BE SUPPORTED BY CONCRETE OR  
STEEL TO CARRY H-20 LOADING

SECTION B-B

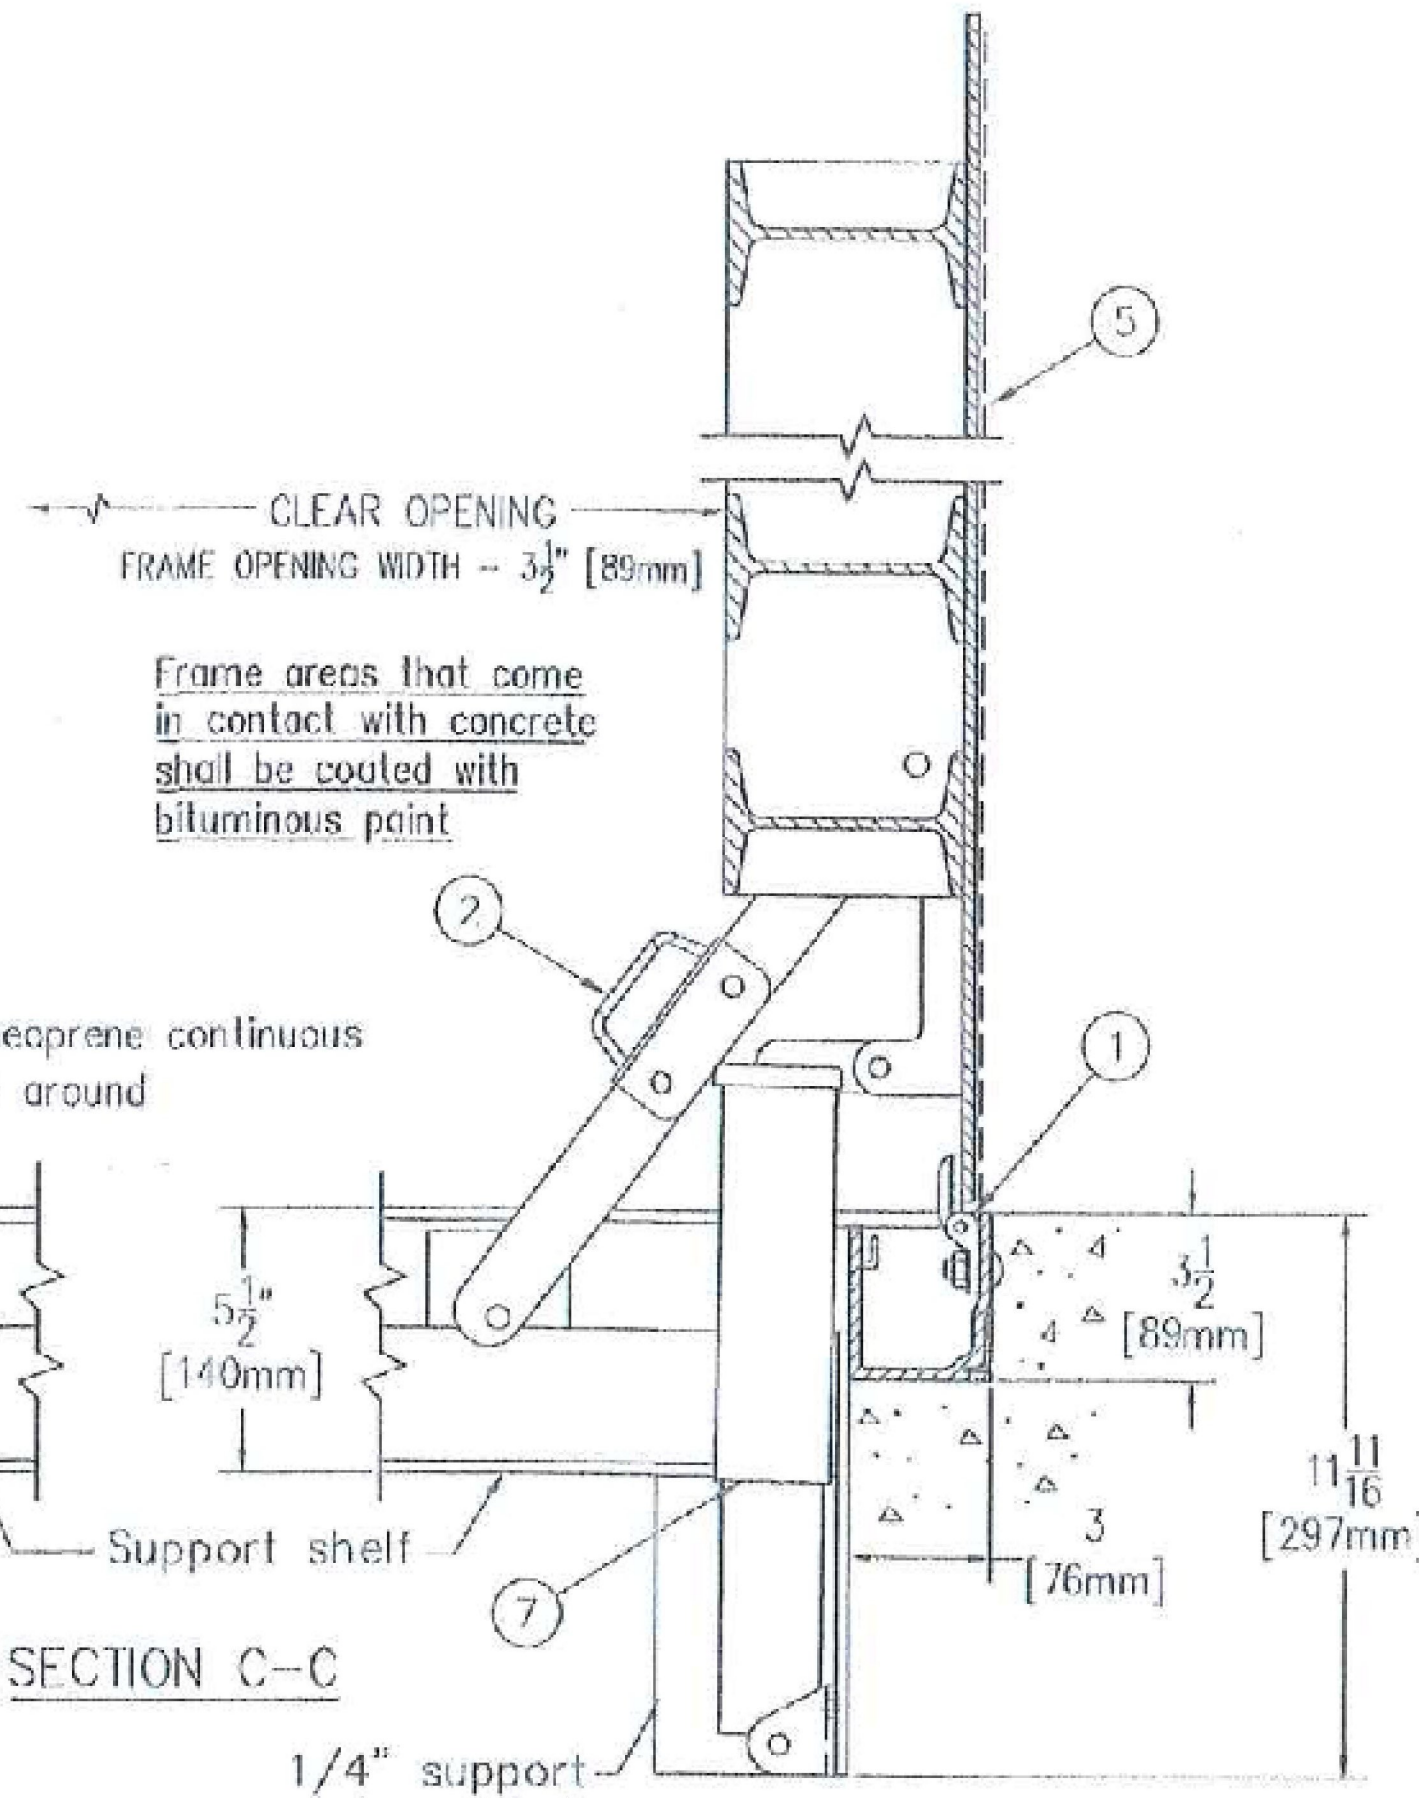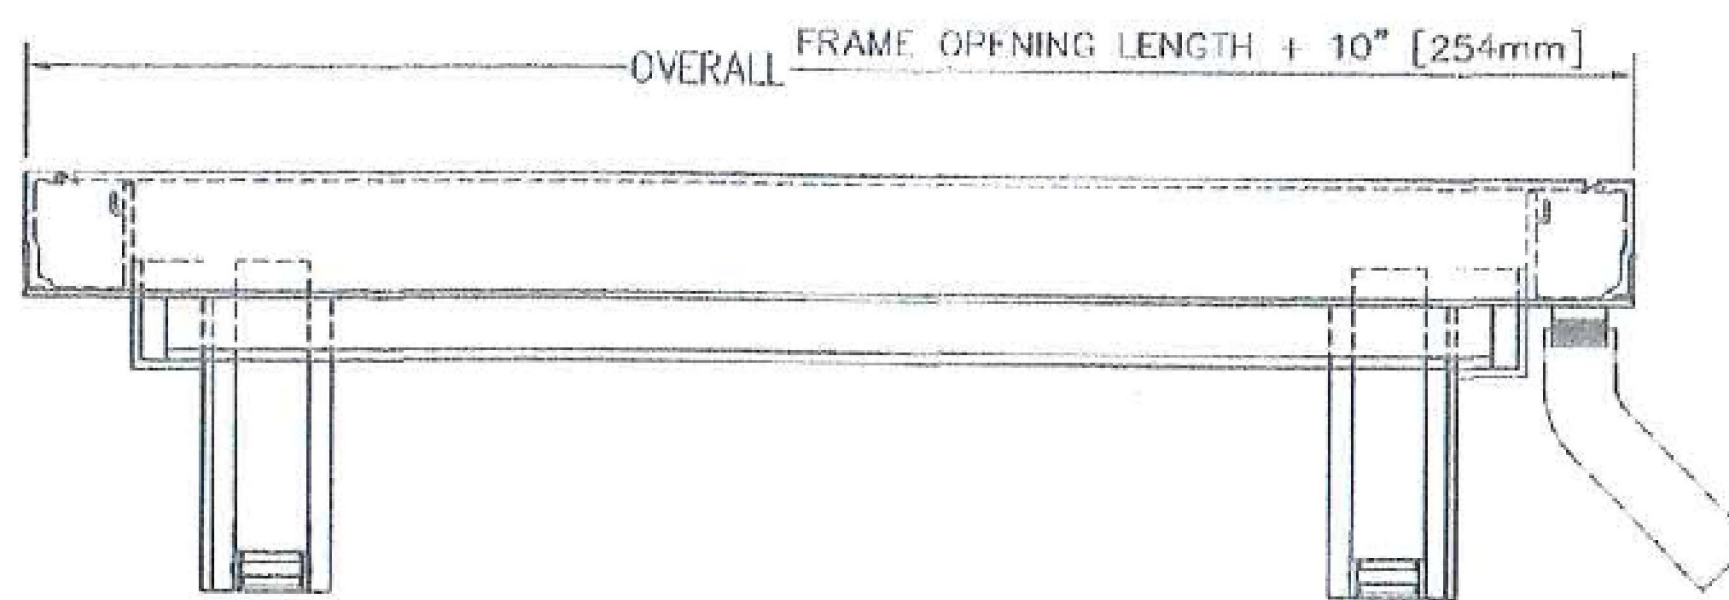

SECTION C-C

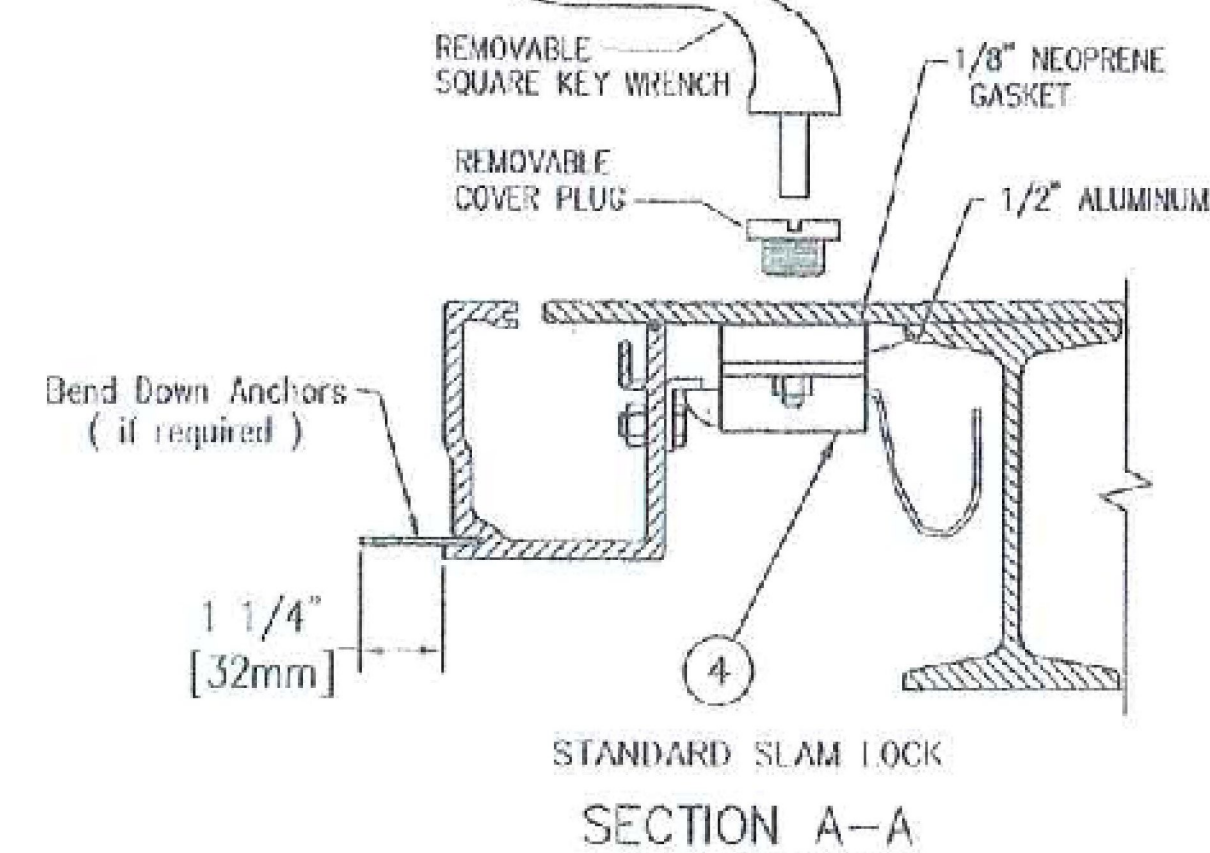

SECTION A-A

THIS DRAWING IS THE PROPERTY OF THE BILCO COMPANY  
AND INCORPORATES INFORMATION WHICH IS PROPRIETARY.  
PUBLICATION AND/OR PUBLIC DISTRIBUTION IN WHOLE OR  
IN PART IS EXPRESSLY PROHIBITED WITHOUT THE PRIOR  
WRITTEN CONSENT OF THE BILCO COMPANY. THE  
INFORMATION CONTAINED HEREIN REMAINS THE PROPERTY  
OF THE BILCO COMPANY. ALL RIGHTS RESERVED.

**SPECIFICATIONS**

1. Bilco heavy duty forged stainless steel hinges with stainless steel pins
2. Bilco automatic hold open arm
3. 1-1/2" drain coupling
4. Standard slam lock
5. 1/4" aluminum diamond pattern plate cover
6. Bilco 1/4" aluminum channel frame with recessed anchors
7. Stainless steel spring lifting mechanism

SHOP FINISH:  
ALUMINUM: MILL FINISH  
HARDWARE: TYPE 316 STAINLESS STEEL  
(unless otherwise specified)

REINFORCED FOR H20 LOADING

**INSTALLER NOTES:**

- A. Use caution. Cover is spring loaded. Do not remove safety shipping bolt until unit is to be installed and in normal horizontal operating position.
- B. Be sure unit is set on slight pitch toward drain corner.
- C. Before anchoring in place open and close door. Check to see that the door in the closed position rests on the frame all around. If not, shim under the frame at the proper corner.
- D. Do not reduce 1 1/2" drain pipe to dry wall or disposal system.
- E. Bend down anchors if required

Customer:

P.O. N°

Job:

Sales Rep:



Manufacturers of Doors for Special Services  
**Bilco** THE BILCO COMPANY  
New Haven, Connecticut 06505

**SINGLE LEAF ACCESS DOOR  
TYPE J-ALH20 - EXTERIOR**


QTY	TYPE	SIZE
		WIDTH x LENGTH
	J-1ALH20	2'-0" x 2'-0" [610mm] x [610mm]
	J-2ALH20	2'-6" x 2'-6" [762mm] x [762mm]
1	J-3ALH20	3'-0" x 2'-6" [914mm] x [762mm]
	J-4ALH20	3'-0" x 3'-0" [914mm] x [914mm]
	J-5ALH20	3'-6" x 3'-6" [1065mm] x [1065mm]

ADDED SHEET  
STR #1 DETAILS

© 11-16-09 THE BILCO COMPANY

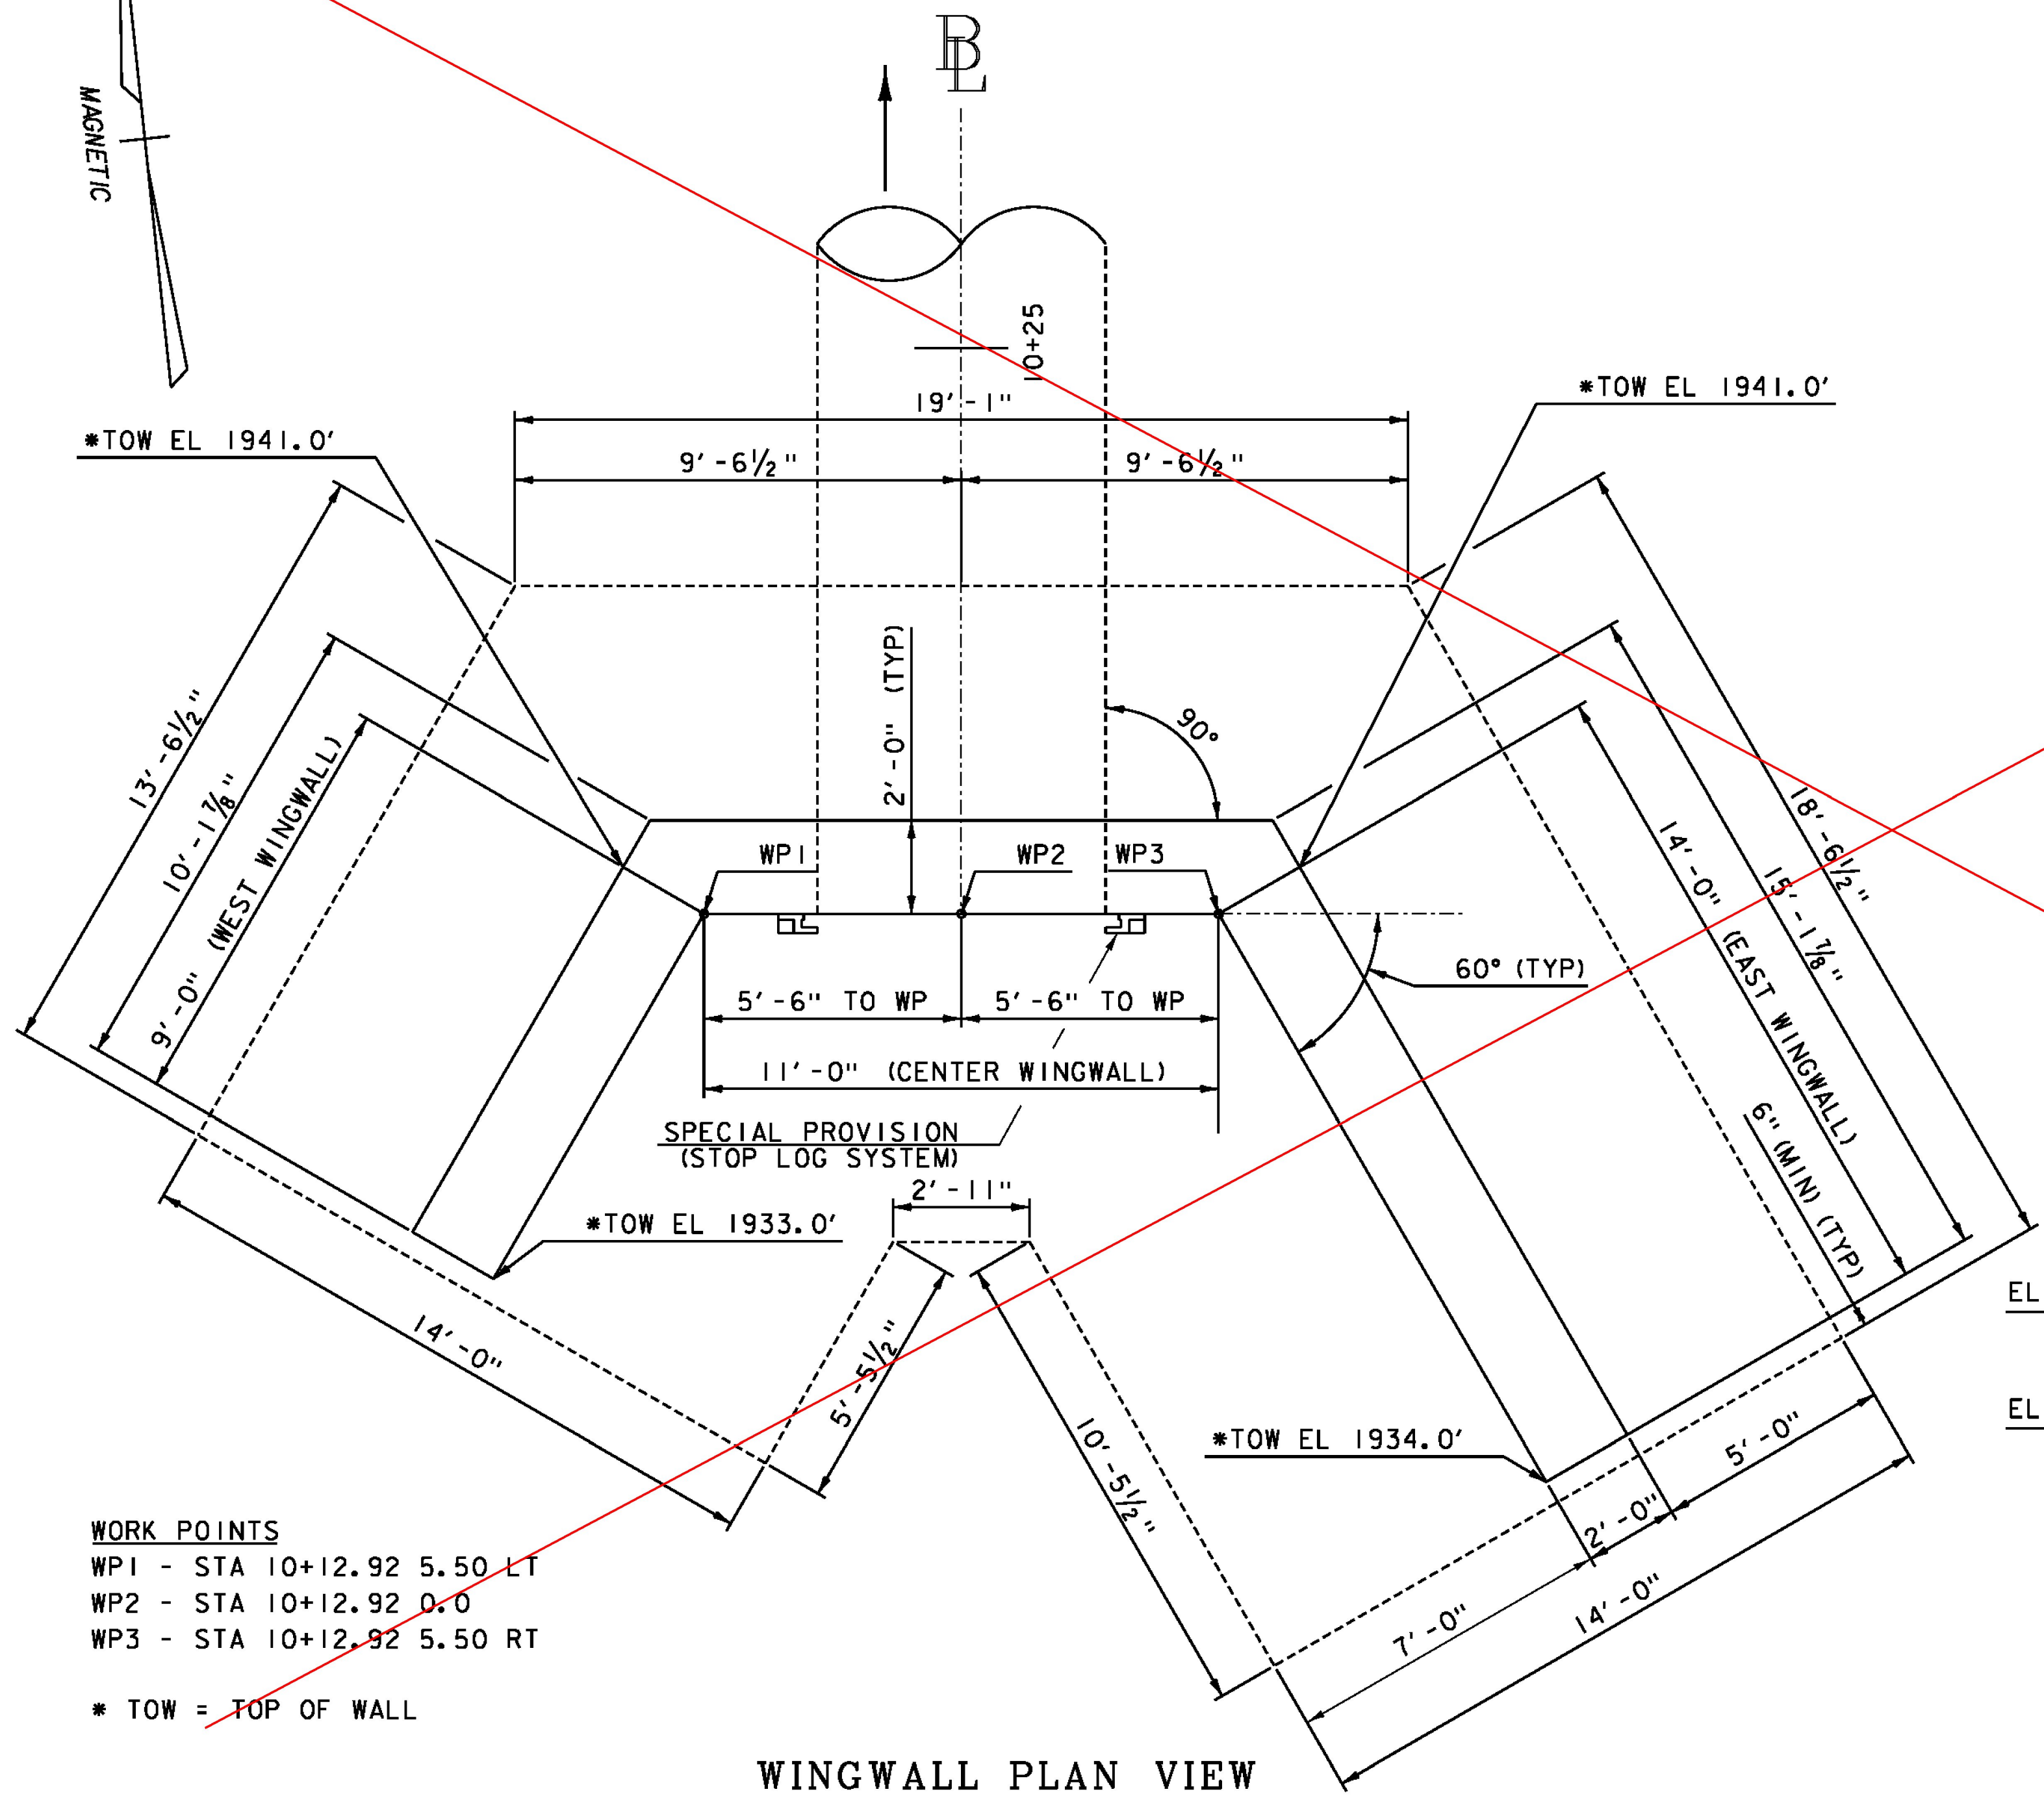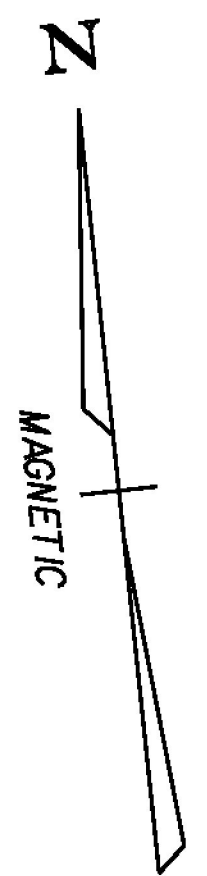

WINGWALL PLAN VIEW  
SCALE 3/8" = 1'


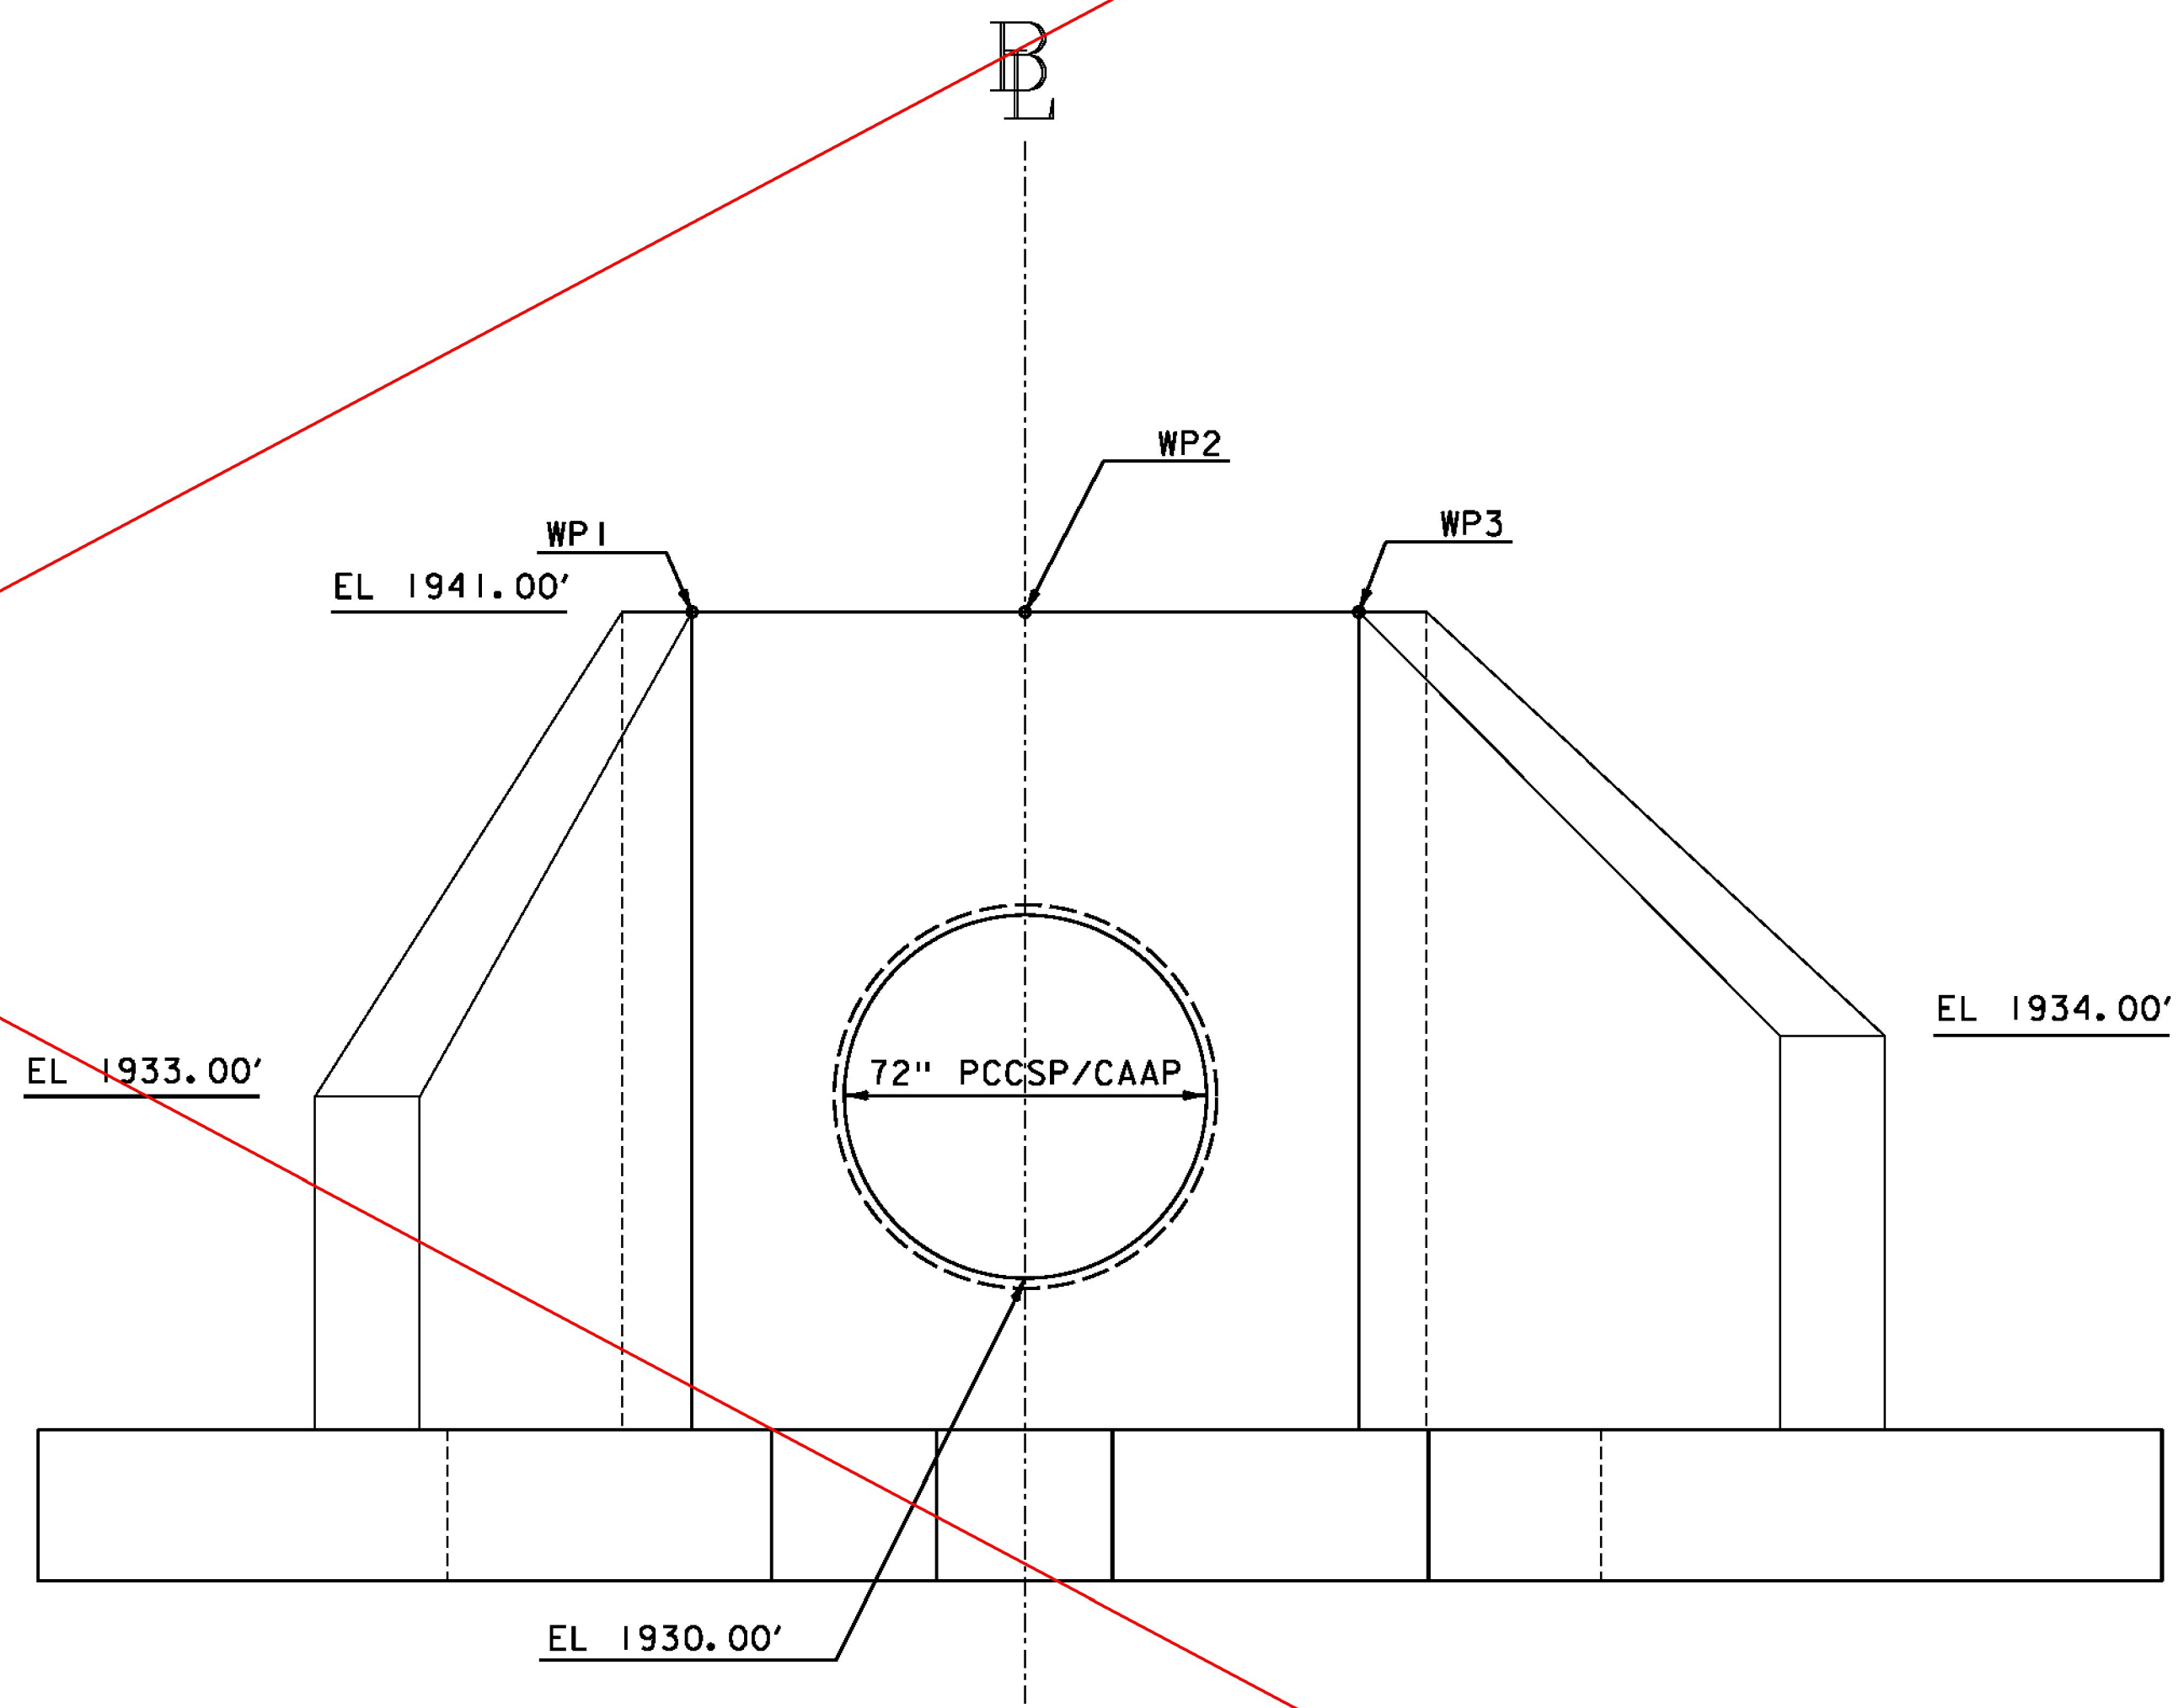


WINGWALL ELEVATION VIEW  
SCALE 3/8" = 1'

WORK POINTS  
 WP1 - STA 10+12.92 5.50 LT  
 WP2 - STA 10+12.92 0.0  
 WP3 - STA 10+12.92 5.50 RT  
 * TOW = TOP OF WALL


THIS SHEET REPLACED  
 BY FOLLOWING SHEET

PROJECT NAME: PERU	PLOT DATE: 12/31/2014
PROJECT NUMBER: STP SCR(4)	DRAWN BY: M. BRADLEY
FILE NAME: z07bi06det.dgn	CHECKED BY: B. KHALIFA
PROJECT LEADER: E. ATKINS	SHEET 9 OF 45
DESIGNED BY: B. KHALIFA	
DETAIL SHEET 3	

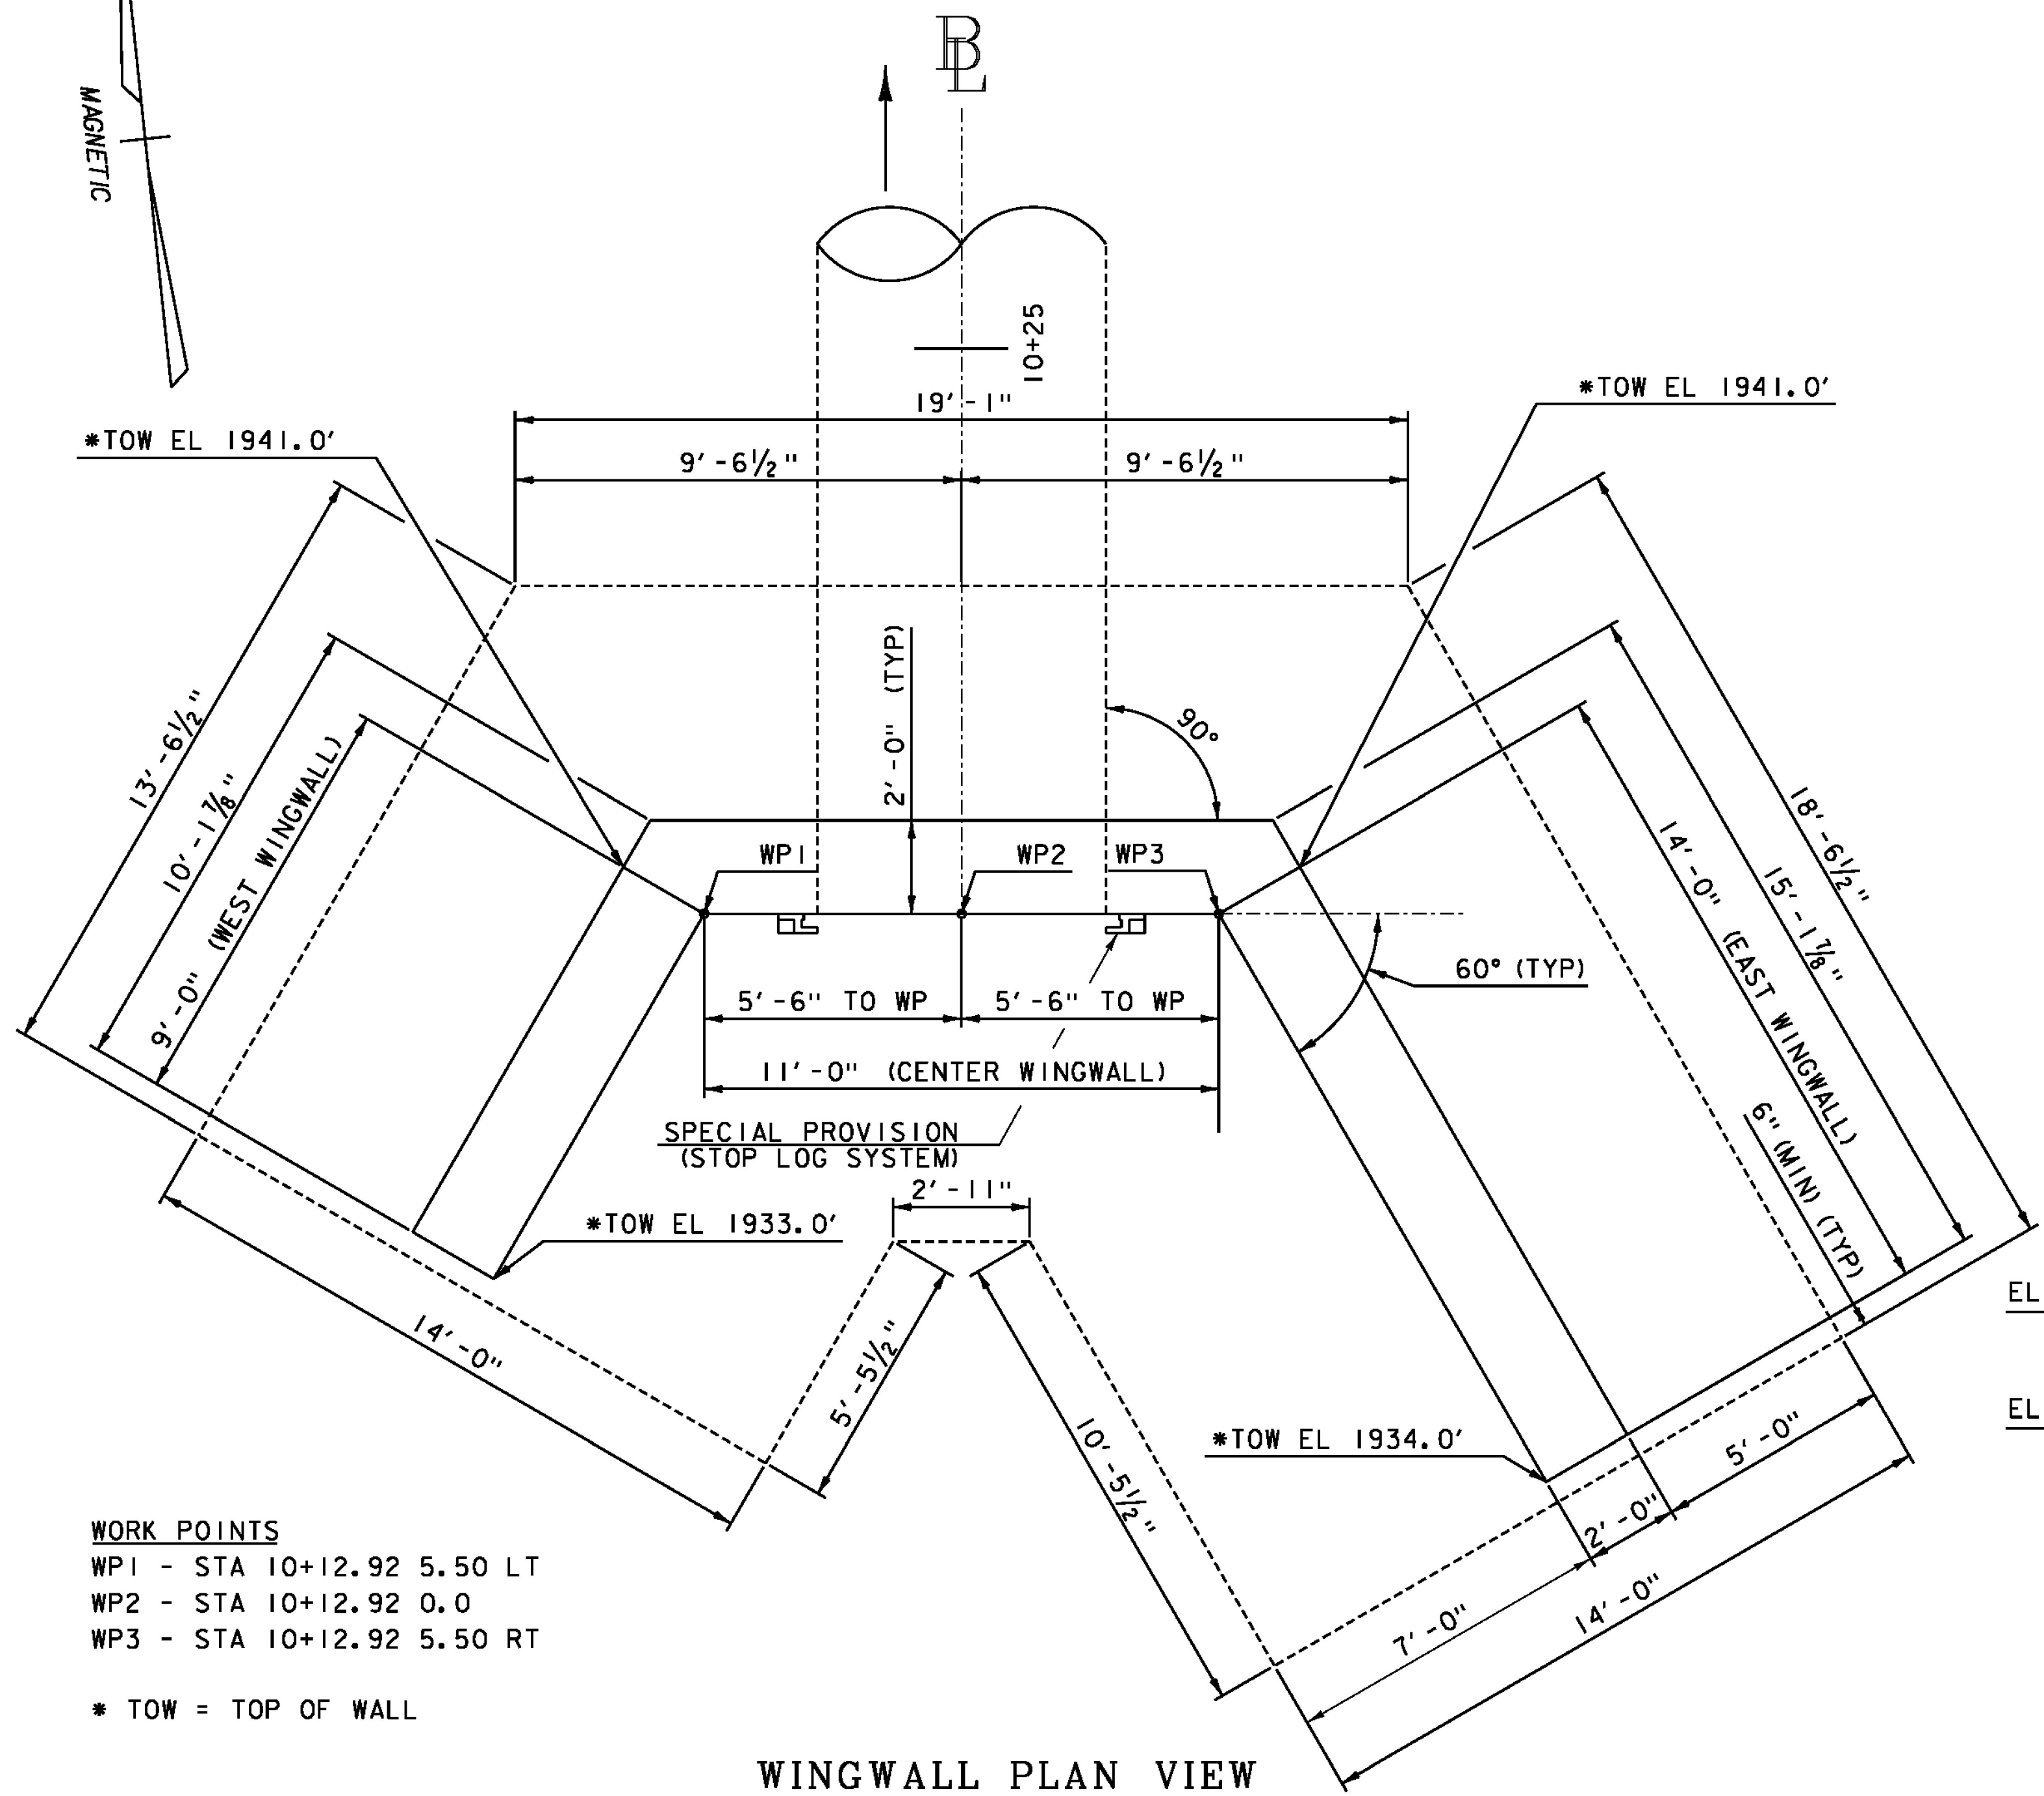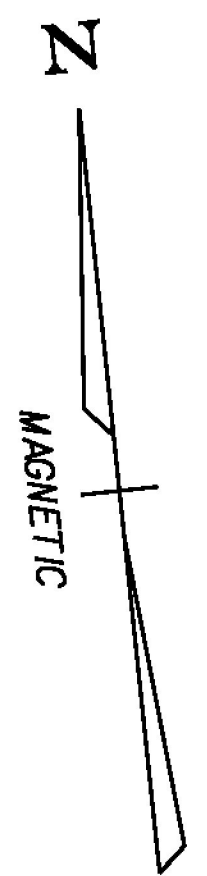

WINGWALL PLAN VIEW  
SCALE 3/8" = 1'

WORK POINTS  
 WP1 - STA 10+12.92 5.50 LT  
 WP2 - STA 10+12.92 0.0  
 WP3 - STA 10+12.92 5.50 RT  
 * TOW = TOP OF WALL

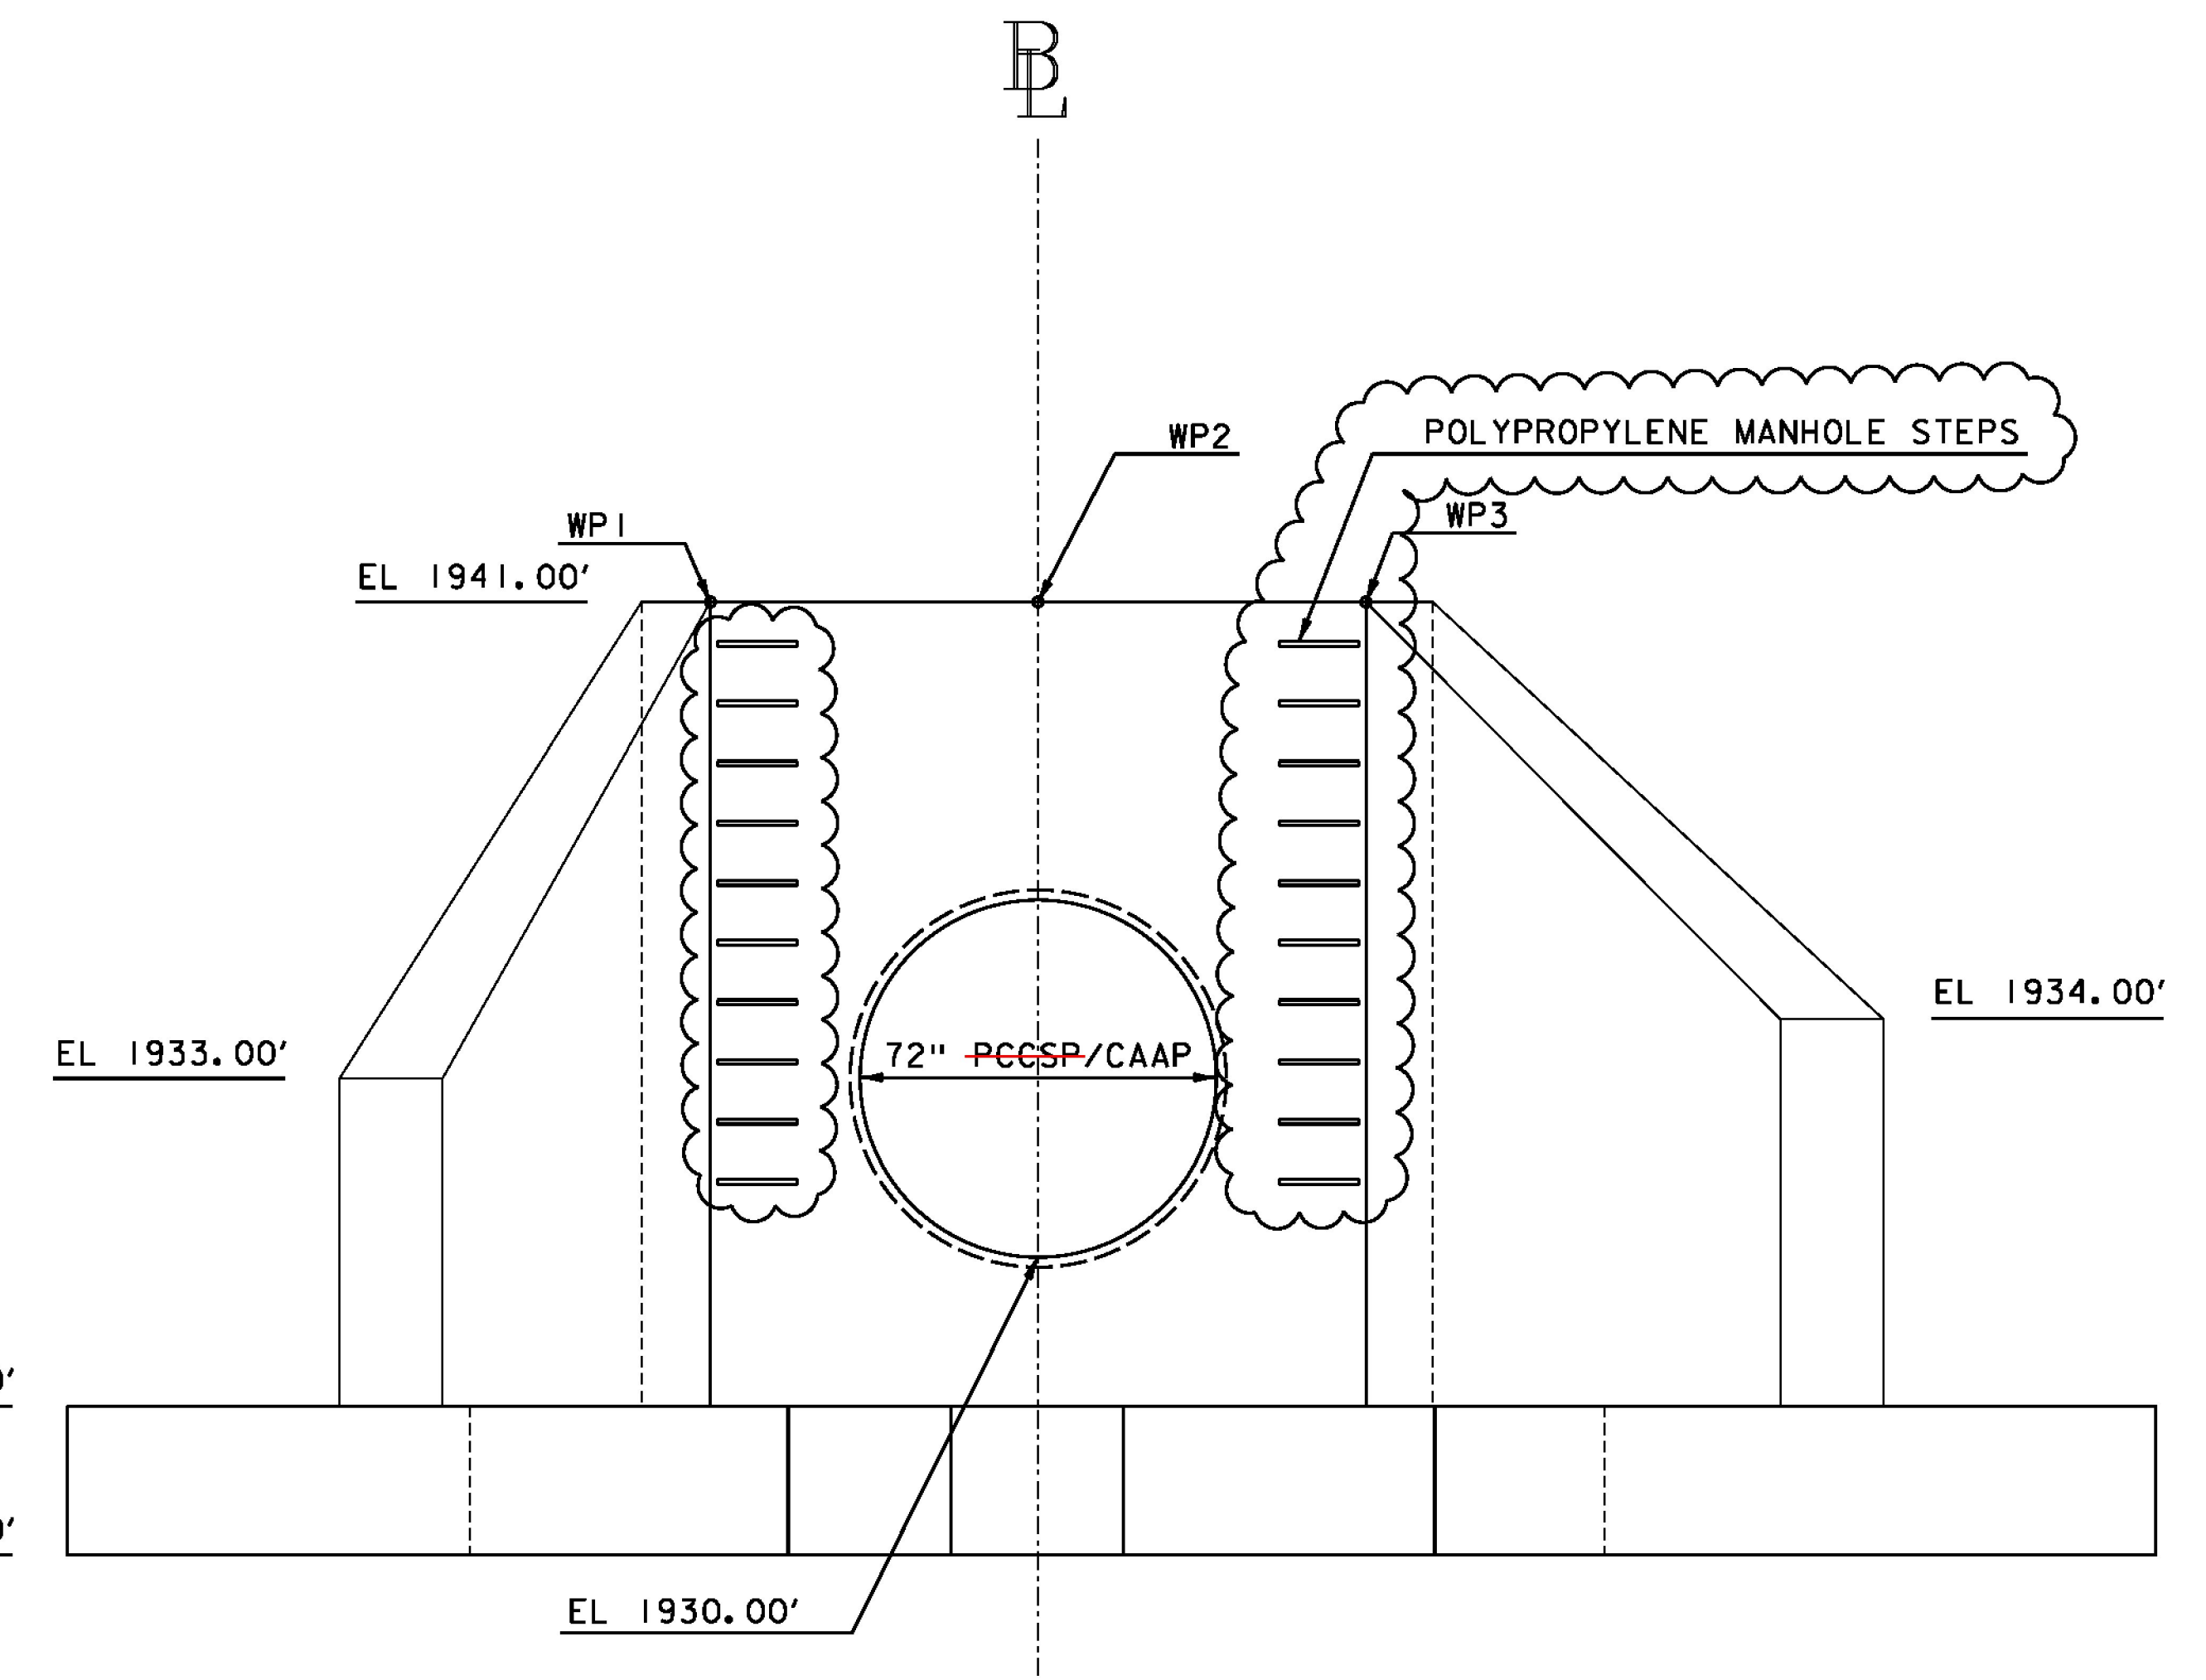


WINGWALL ELEVATION VIEW  
SCALE 3/8" = 1'

THIS SHEET REPLACES  
PRECEDING SHEET





PROJECT NAME: PERU	PLOT DATE: 12/31/2014
PROJECT NUMBER: STP SCRP(4)	DRAWN BY: M. BRADLEY
FILE NAME: z07bi06det.dgn	CHECKED BY: B. KHALIFA
PROJECT LEADER: E. ATKINS	SHEET 9R OF 45
DESIGNED BY: B. KHALIFA	
DETAIL SHEET 3	

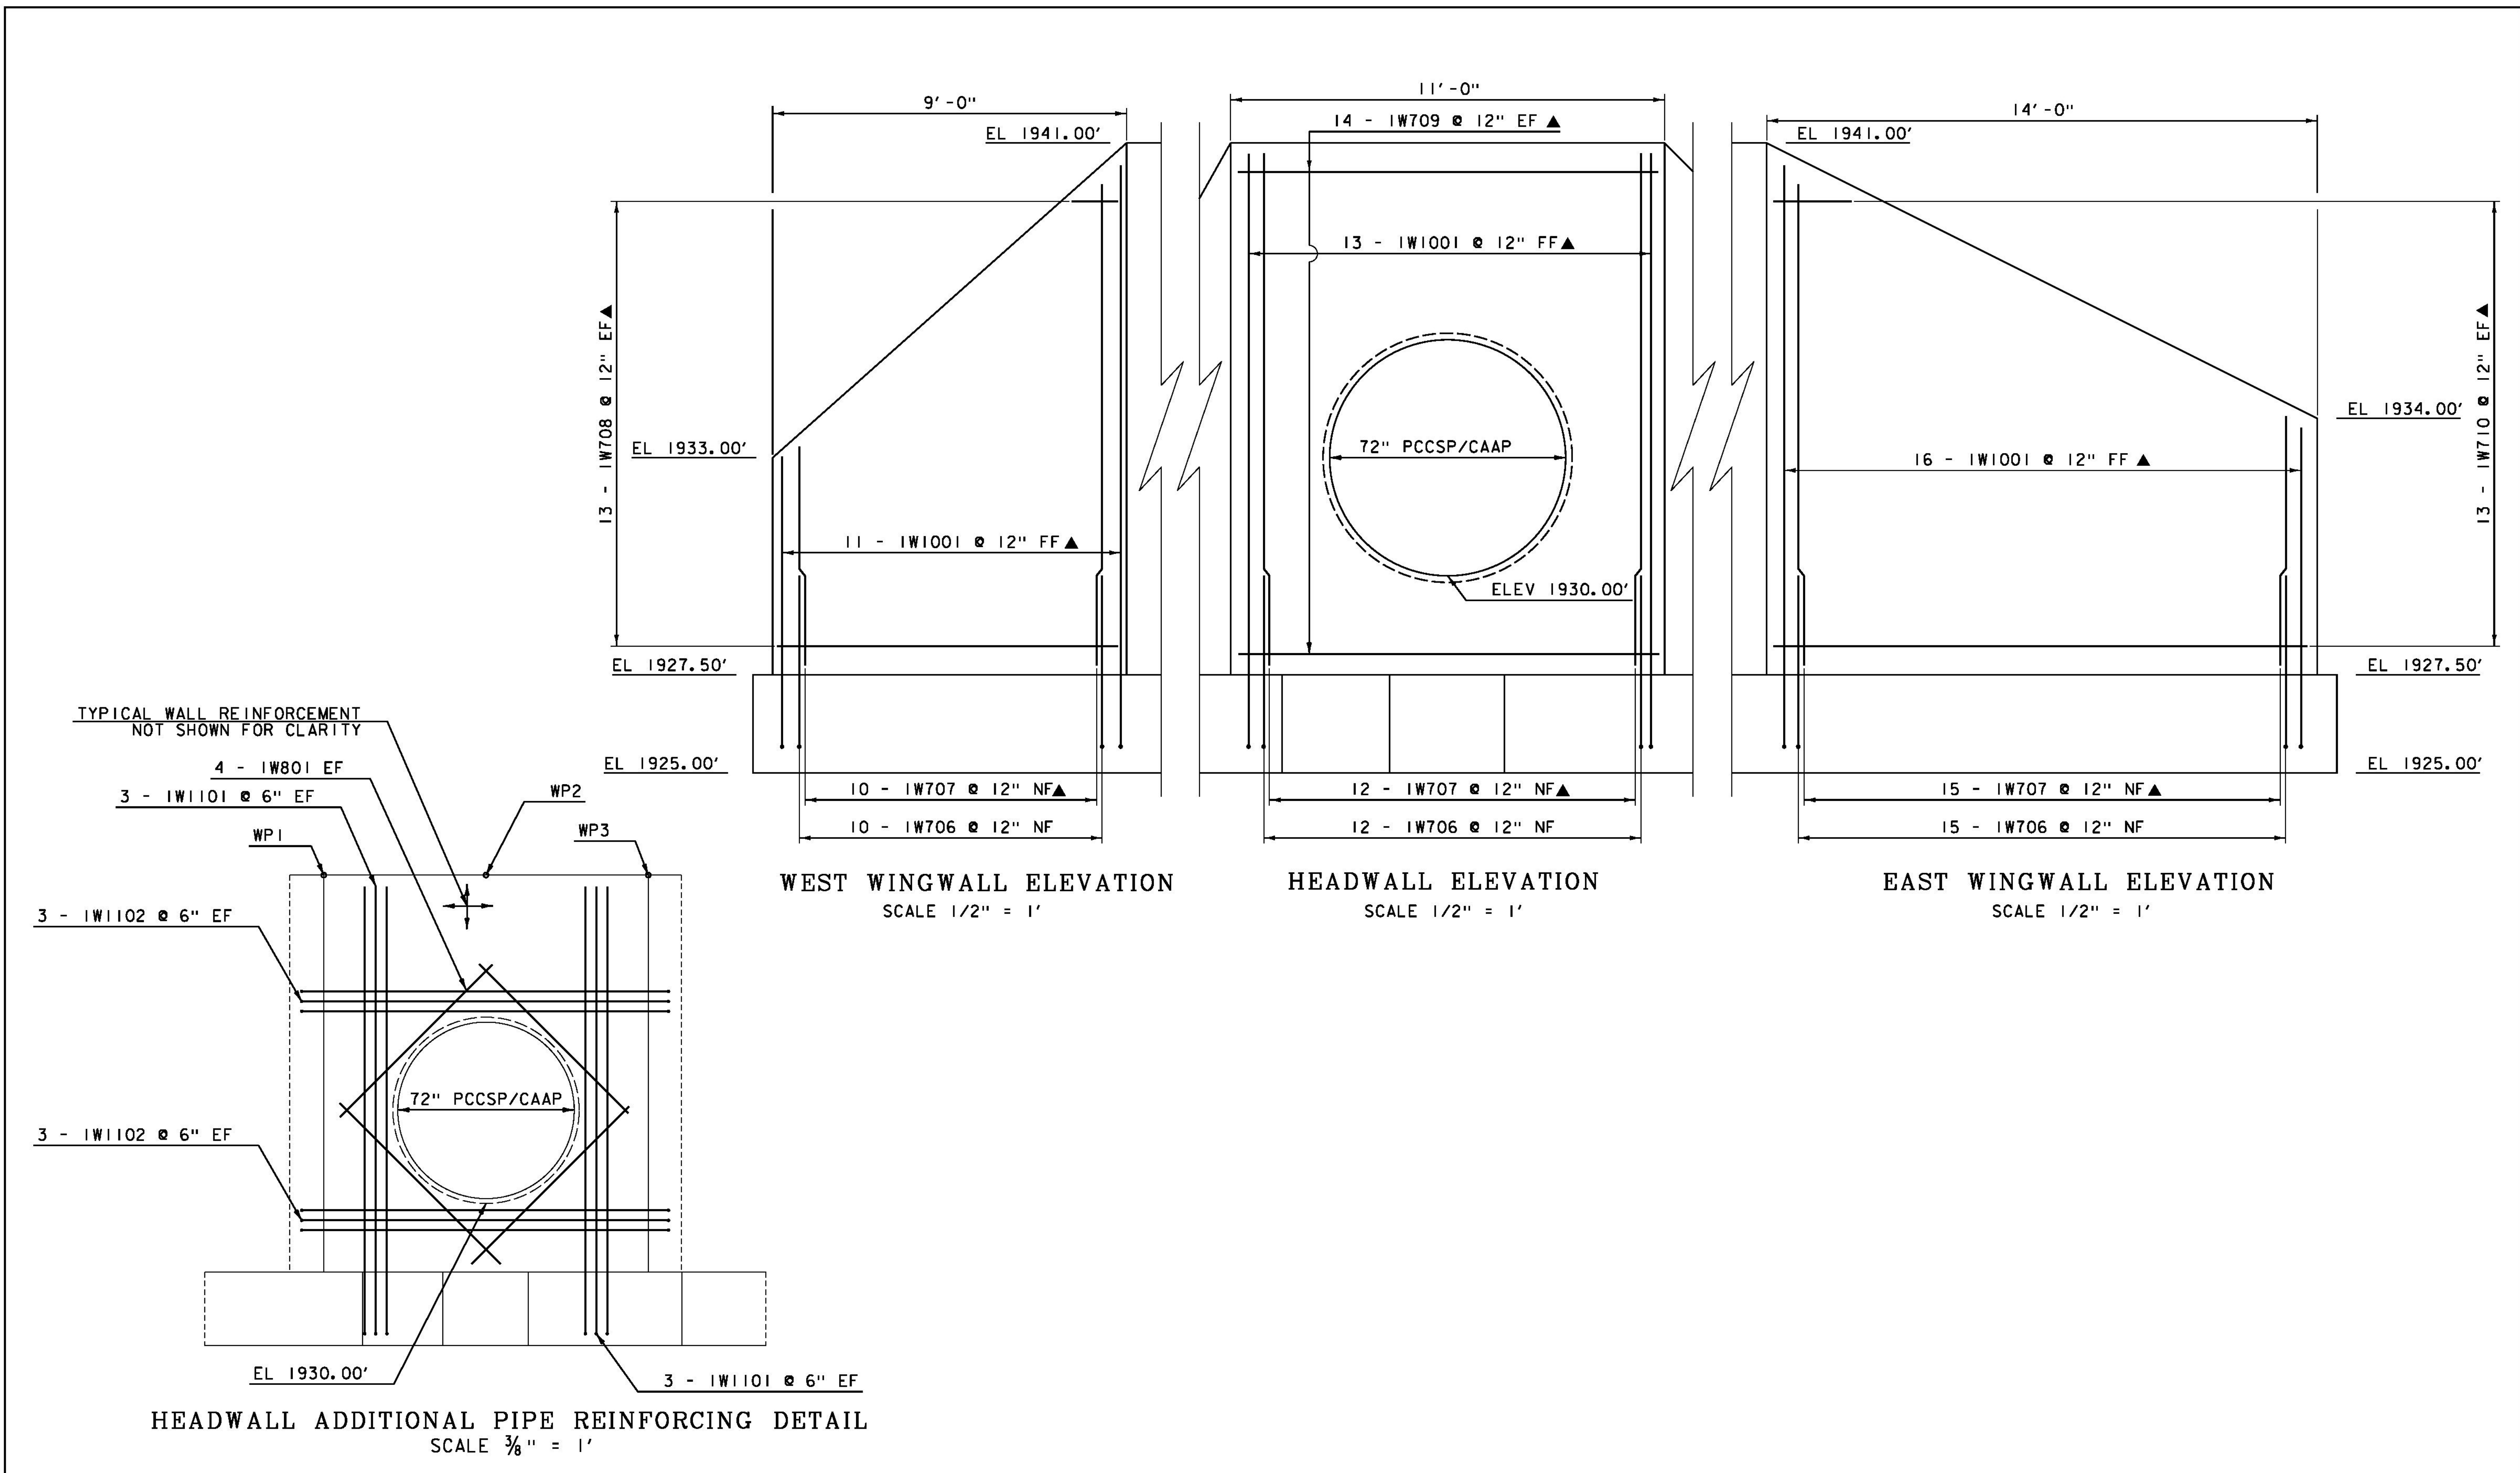


**WALL AND FOOTING REINFORCING DETAILS**

PROJECT NAME: PERU	
PROJECT NUMBER: STP SCRP(4)	
FILE NAME: z07bi06det.dgn	PLOT DATE: 12/31/2014
PROJECT LEADER: E. ATKINS	DRAWN BY: M. BRADLEY
DESIGNED BY: B. KHALIFA	CHECKED BY: B. KHALIFA
DETAIL SHEET 4	SHEET 10 OF 45

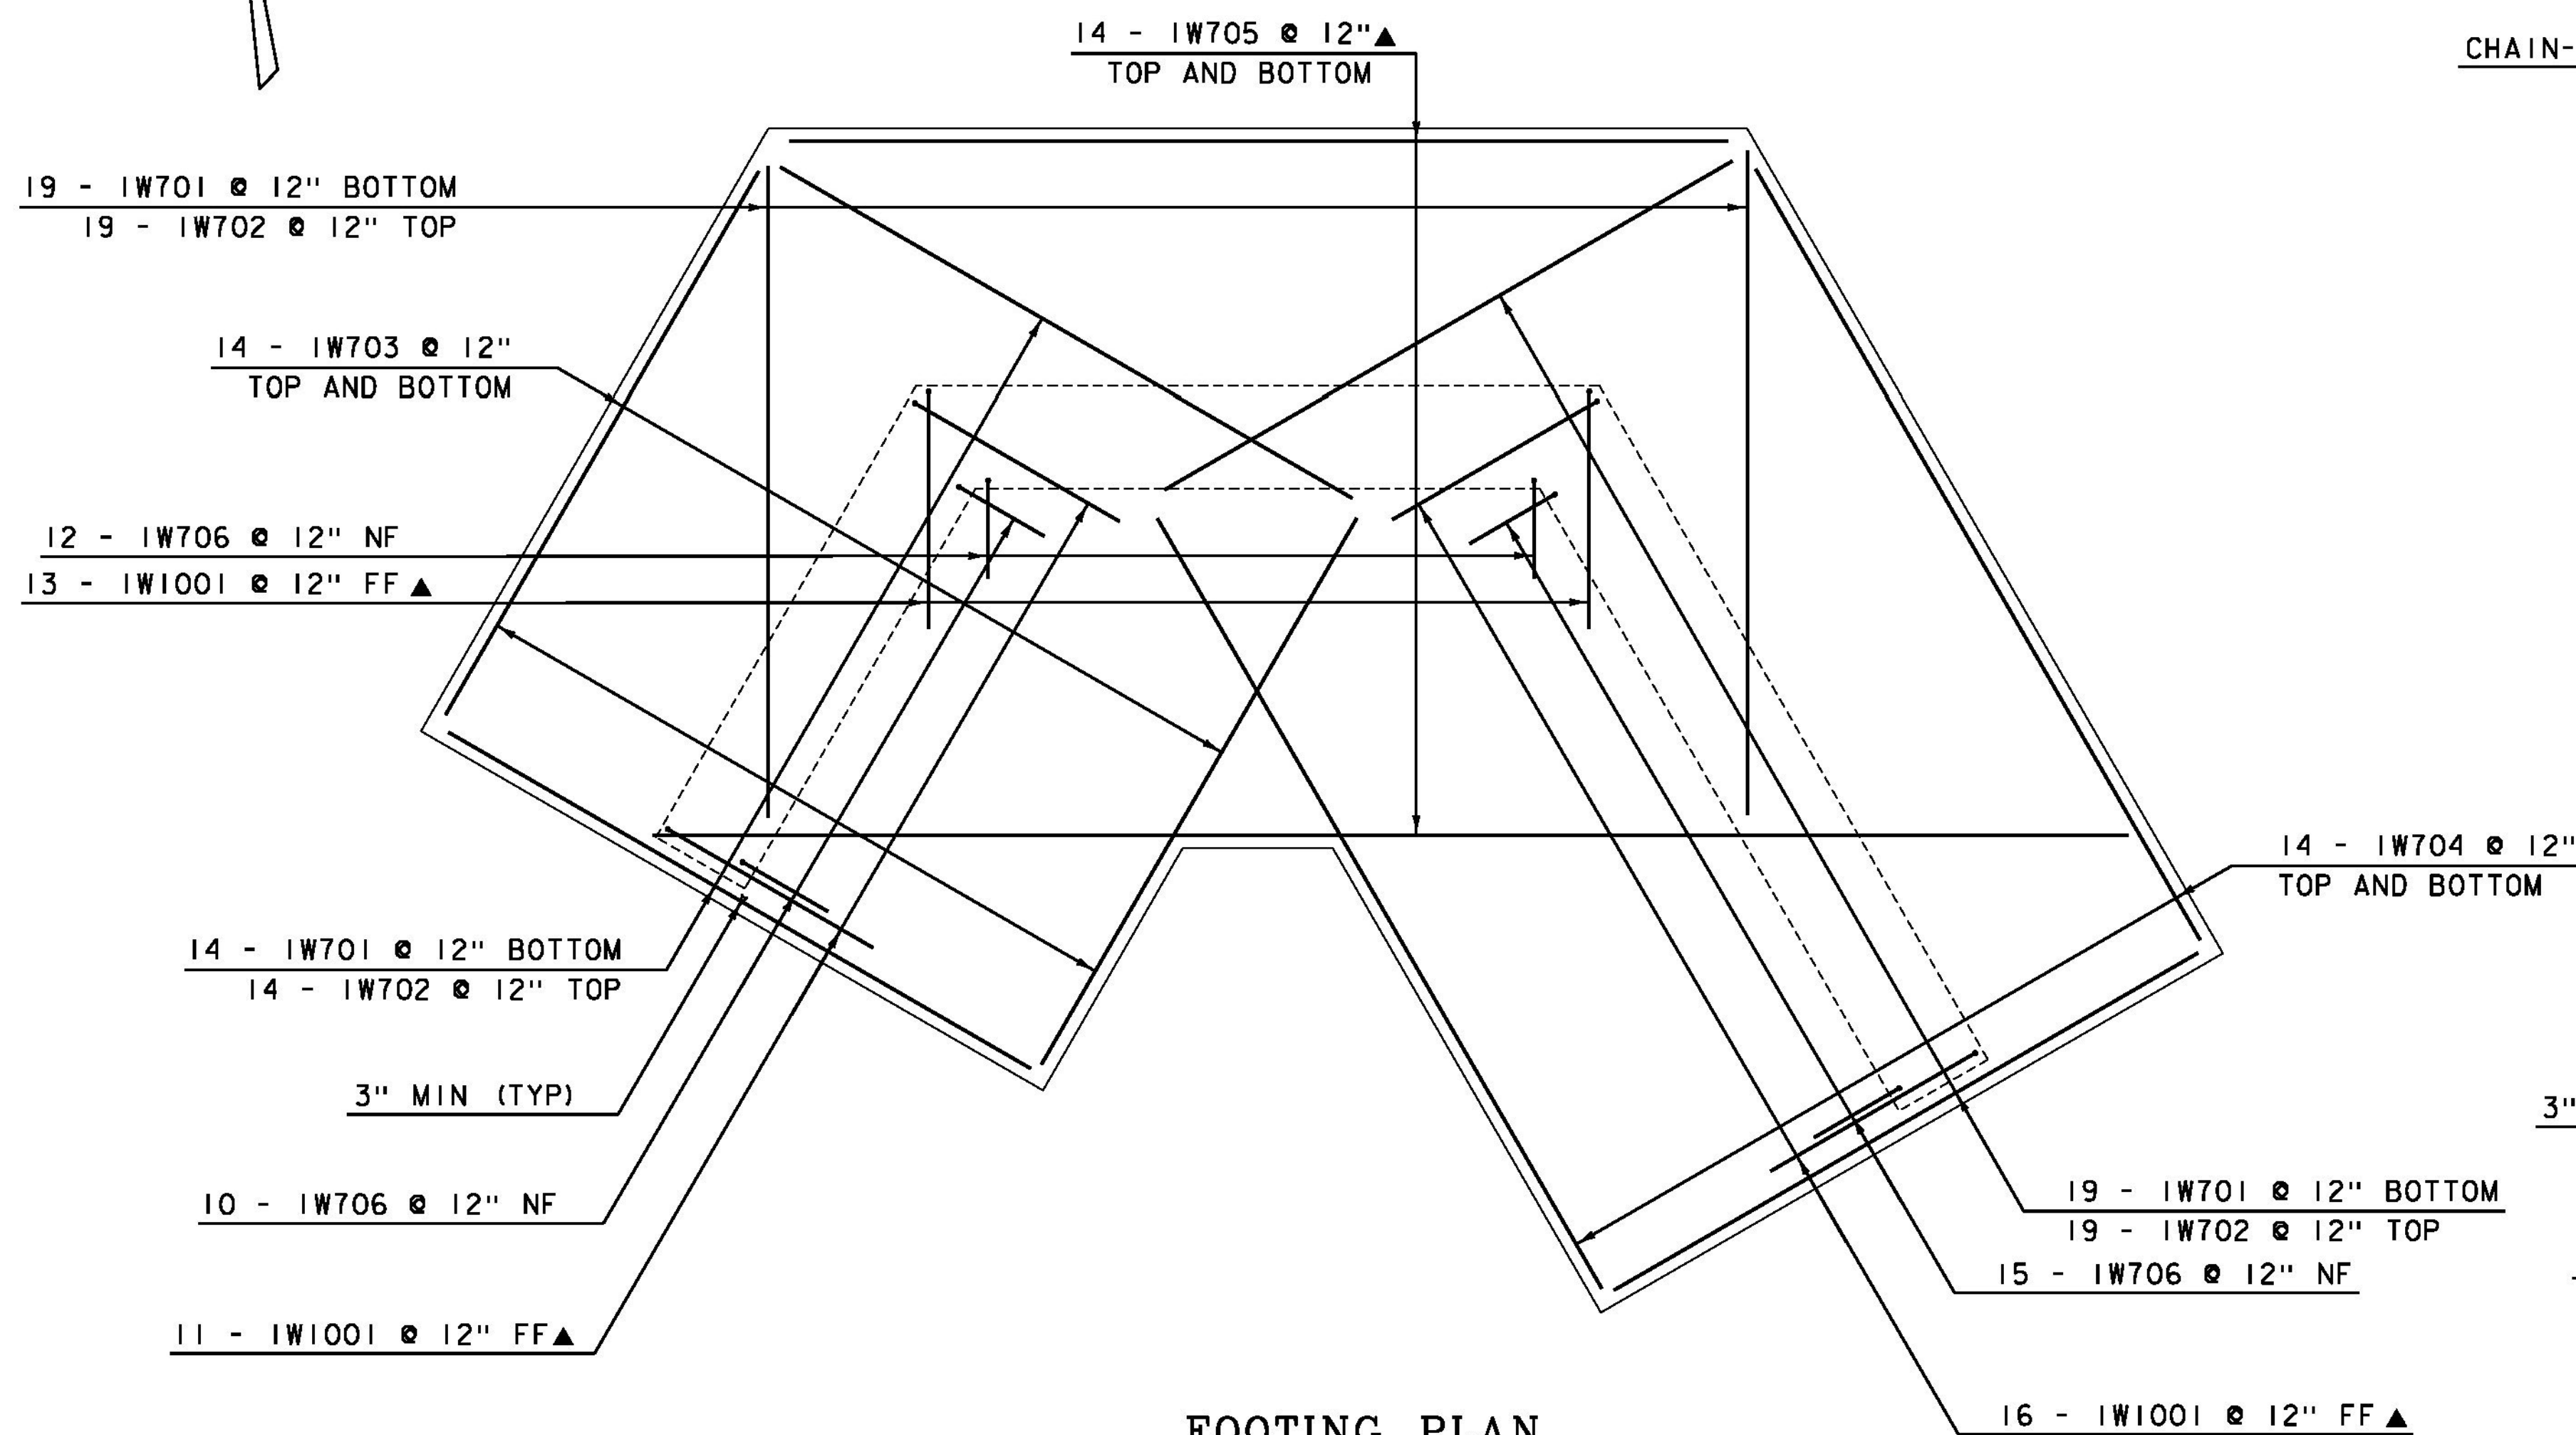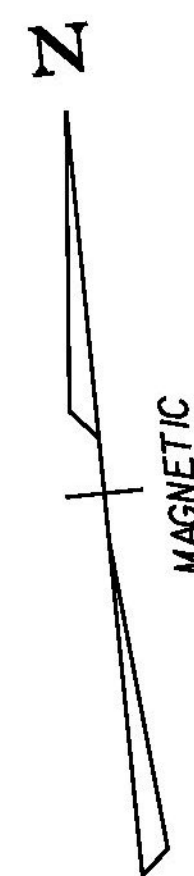

FOOTING PLAN  
(BOTTOM REINFORCEMENT SHOWN, TOP SIMILAR)  
SCALE 3/8" = 1'

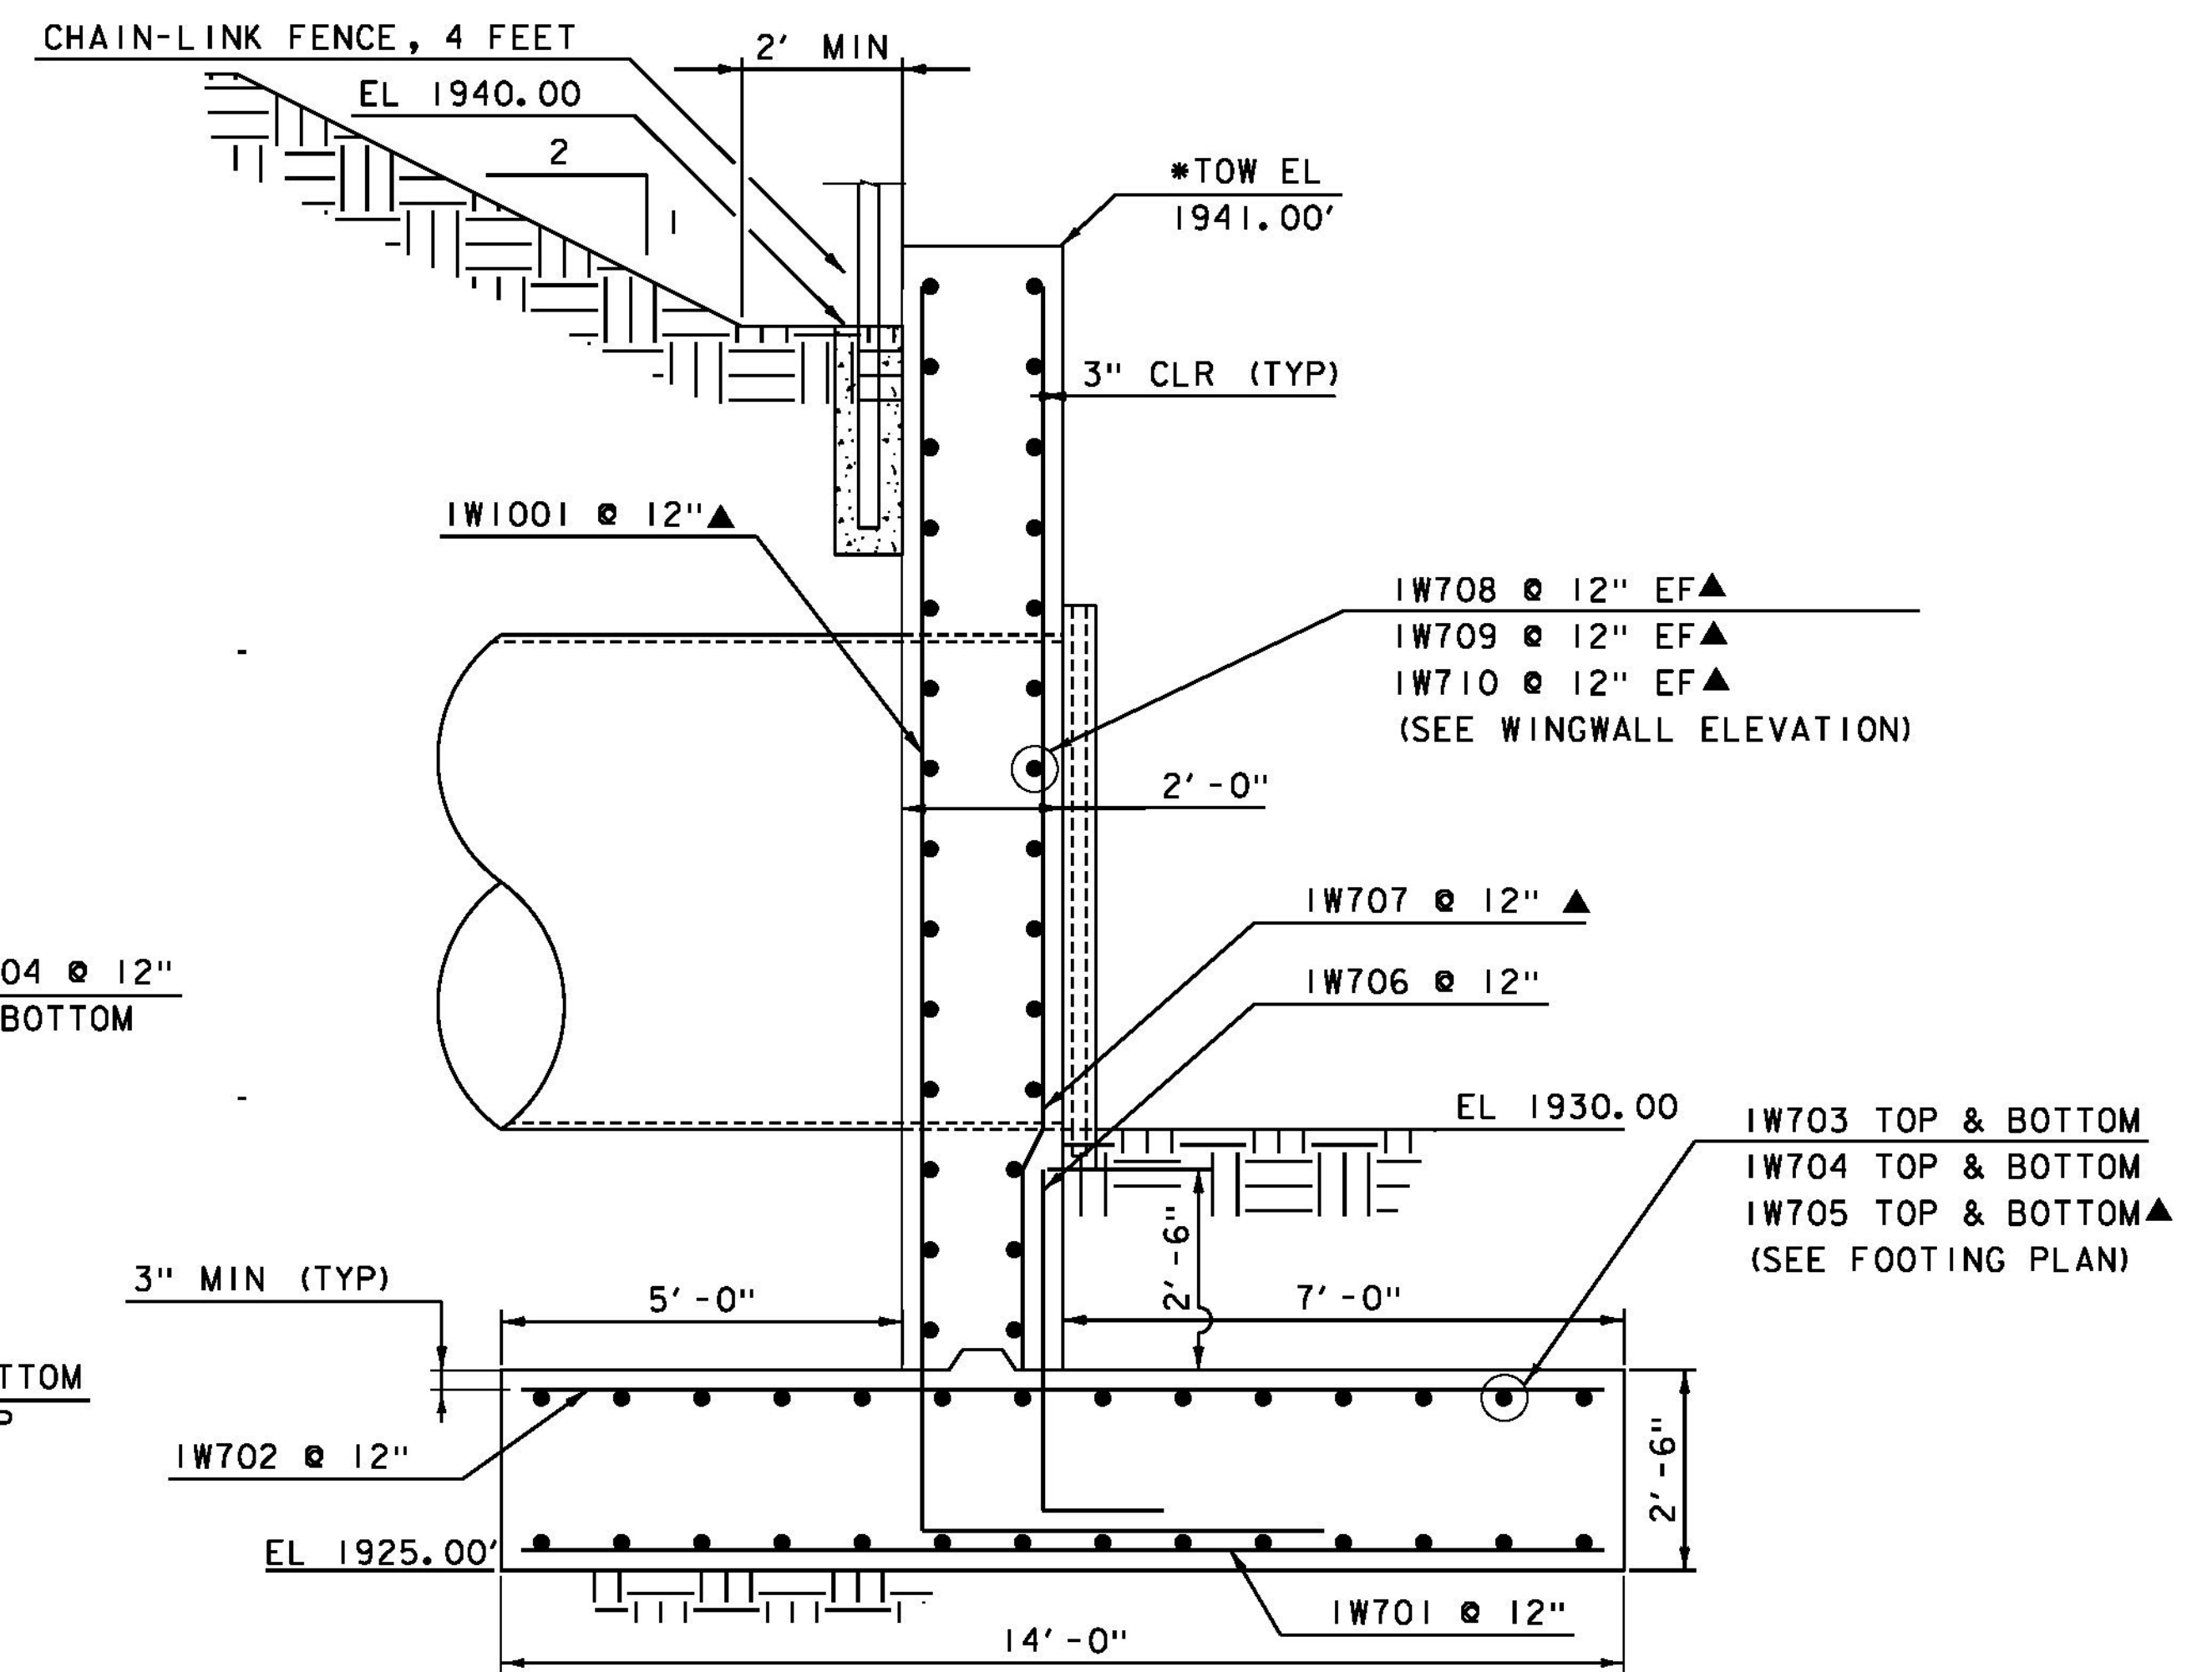


HEADWALL/WINGWALL SECTION  
SCALE 1/2" = 1' *TOW = TOP OF WALL


WALL AND FOOTING REINFORCING DETAILS

PROJECT NAME: PERU	PLOT DATE: 12/31/2014
PROJECT NUMBER: STP SCRP(4)	DRAWN BY: M. BRADLEY
FILE NAME: z07b106det.dgn	CHECKED BY: B. KHALIFA
PROJECT LEADER: E. ATKINS	SHEET II OF 45
DESIGNED BY: B. KHALIFA	
DETAIL SHEET 5	




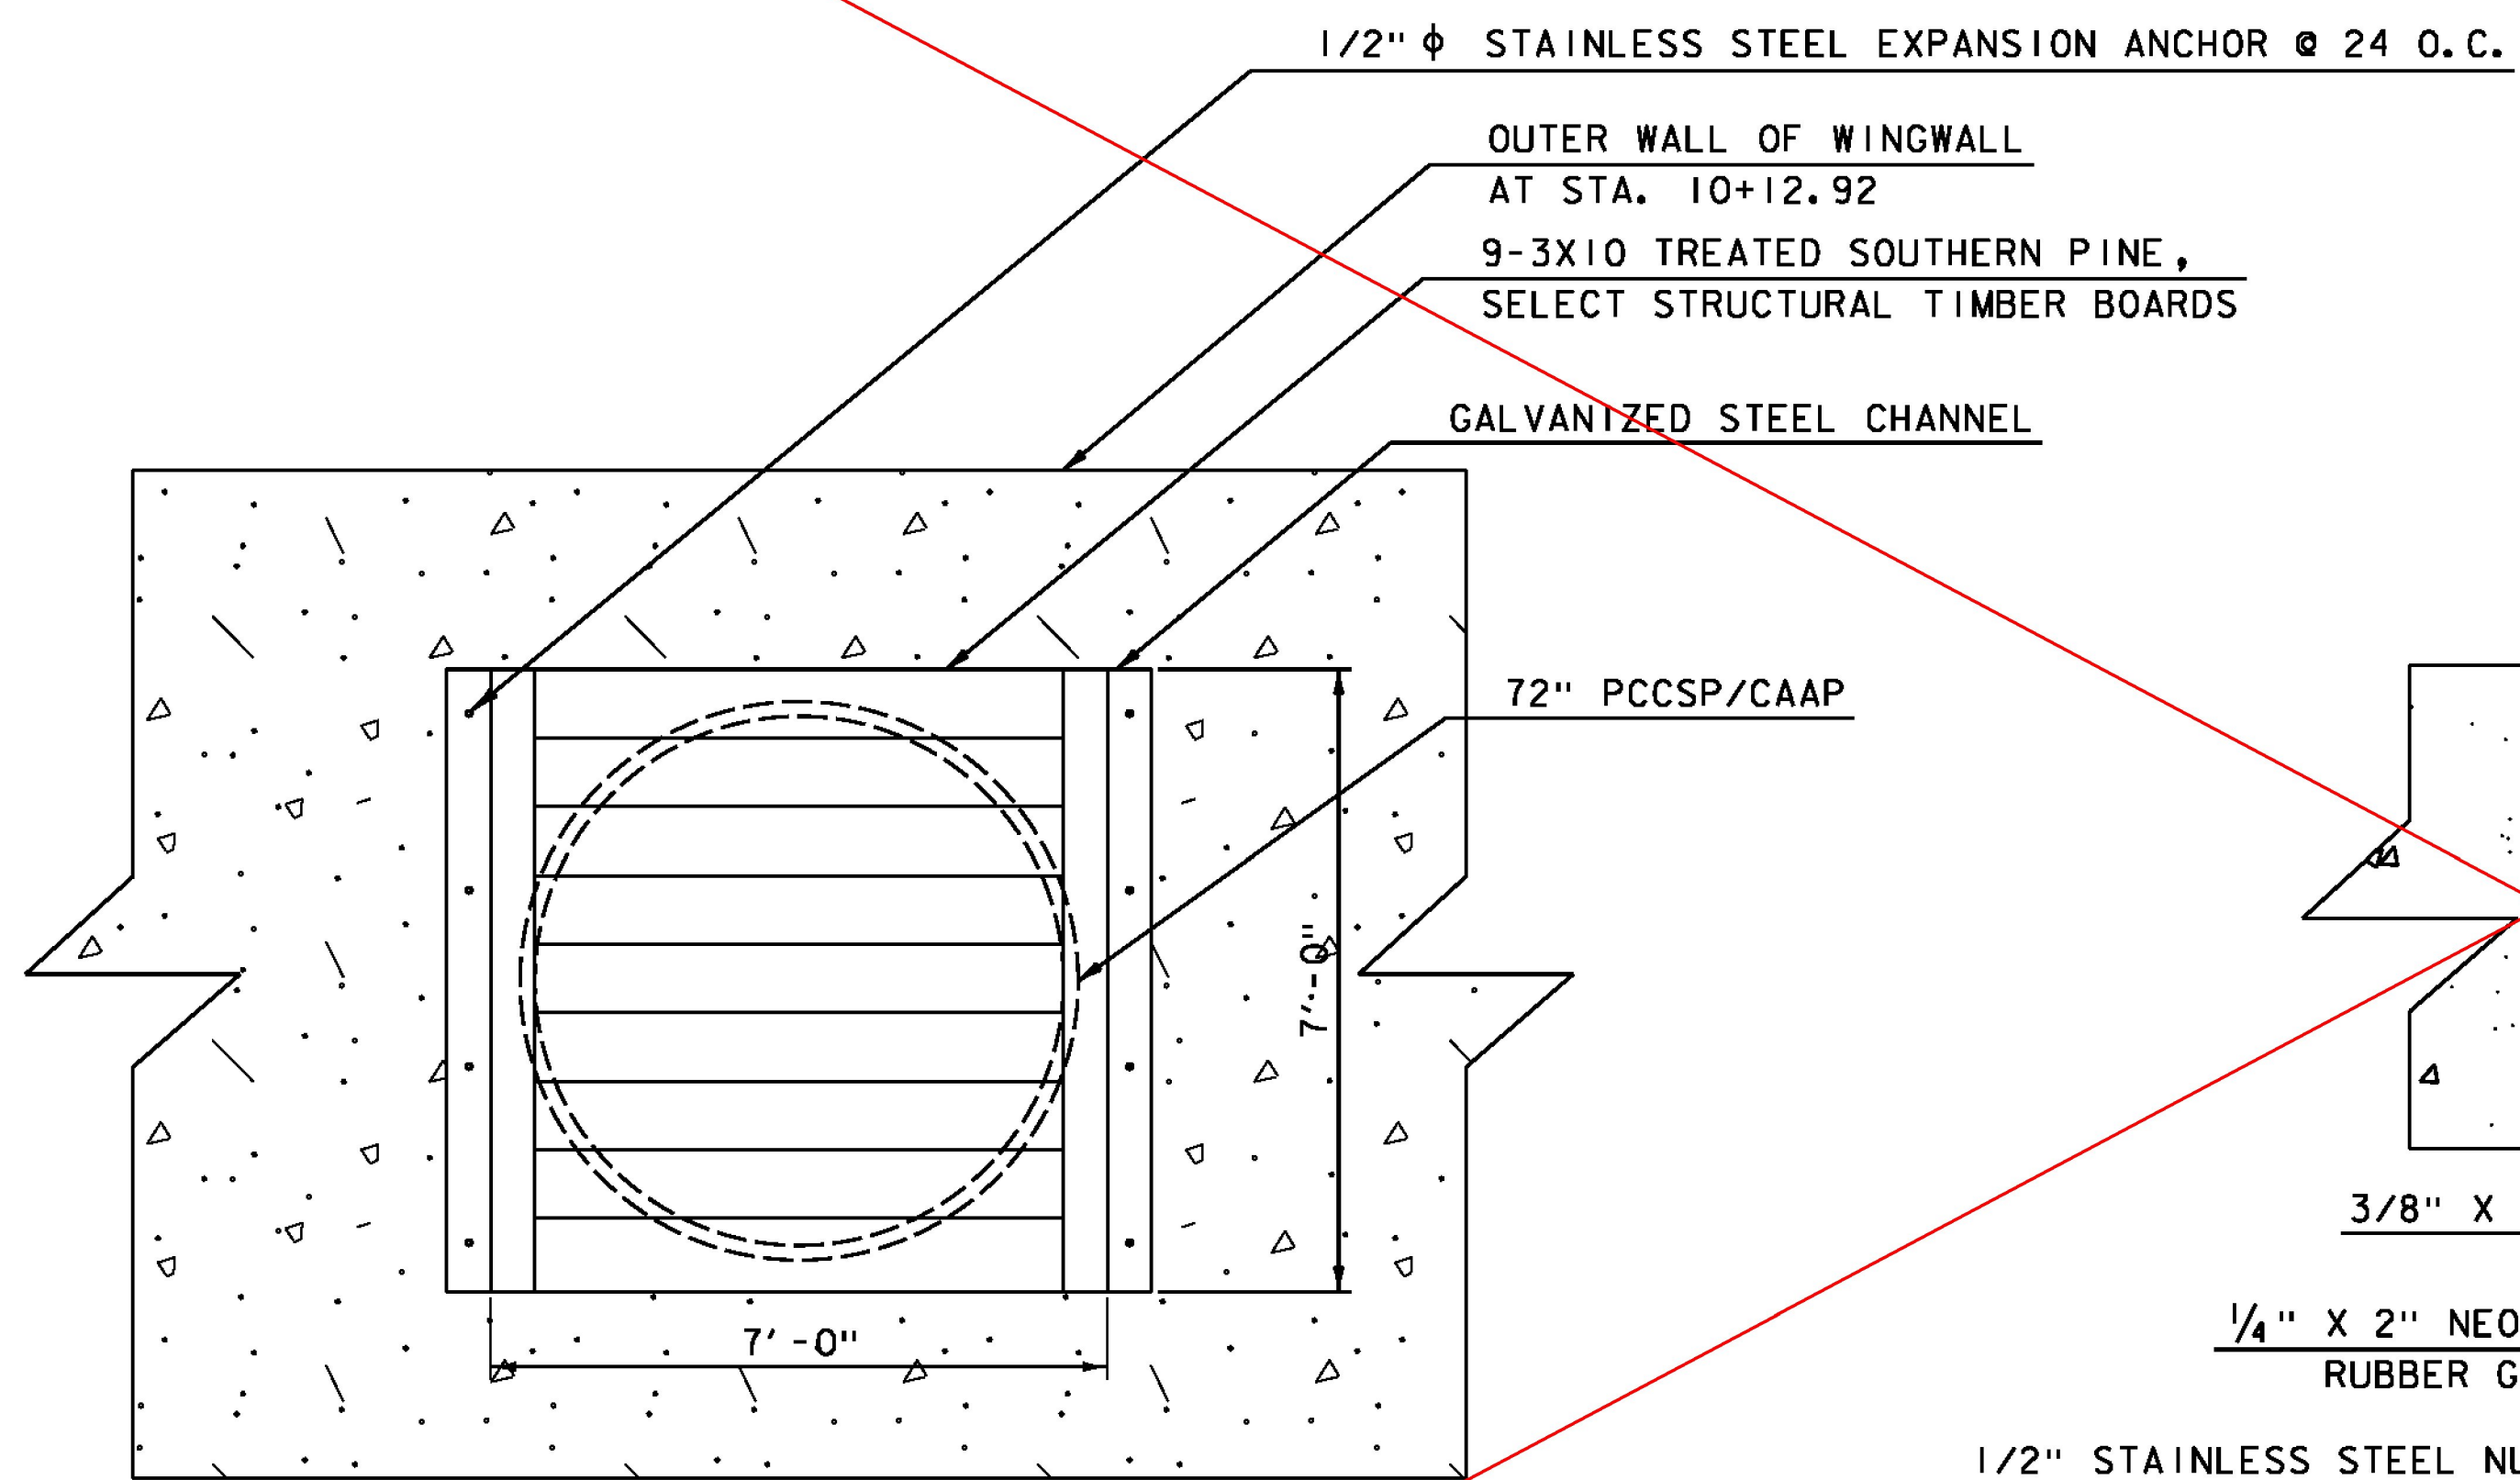

FRONT VIEW - SPECIAL PROVISION (STOP LOG SYSTEM)  
NOT TO SCALE

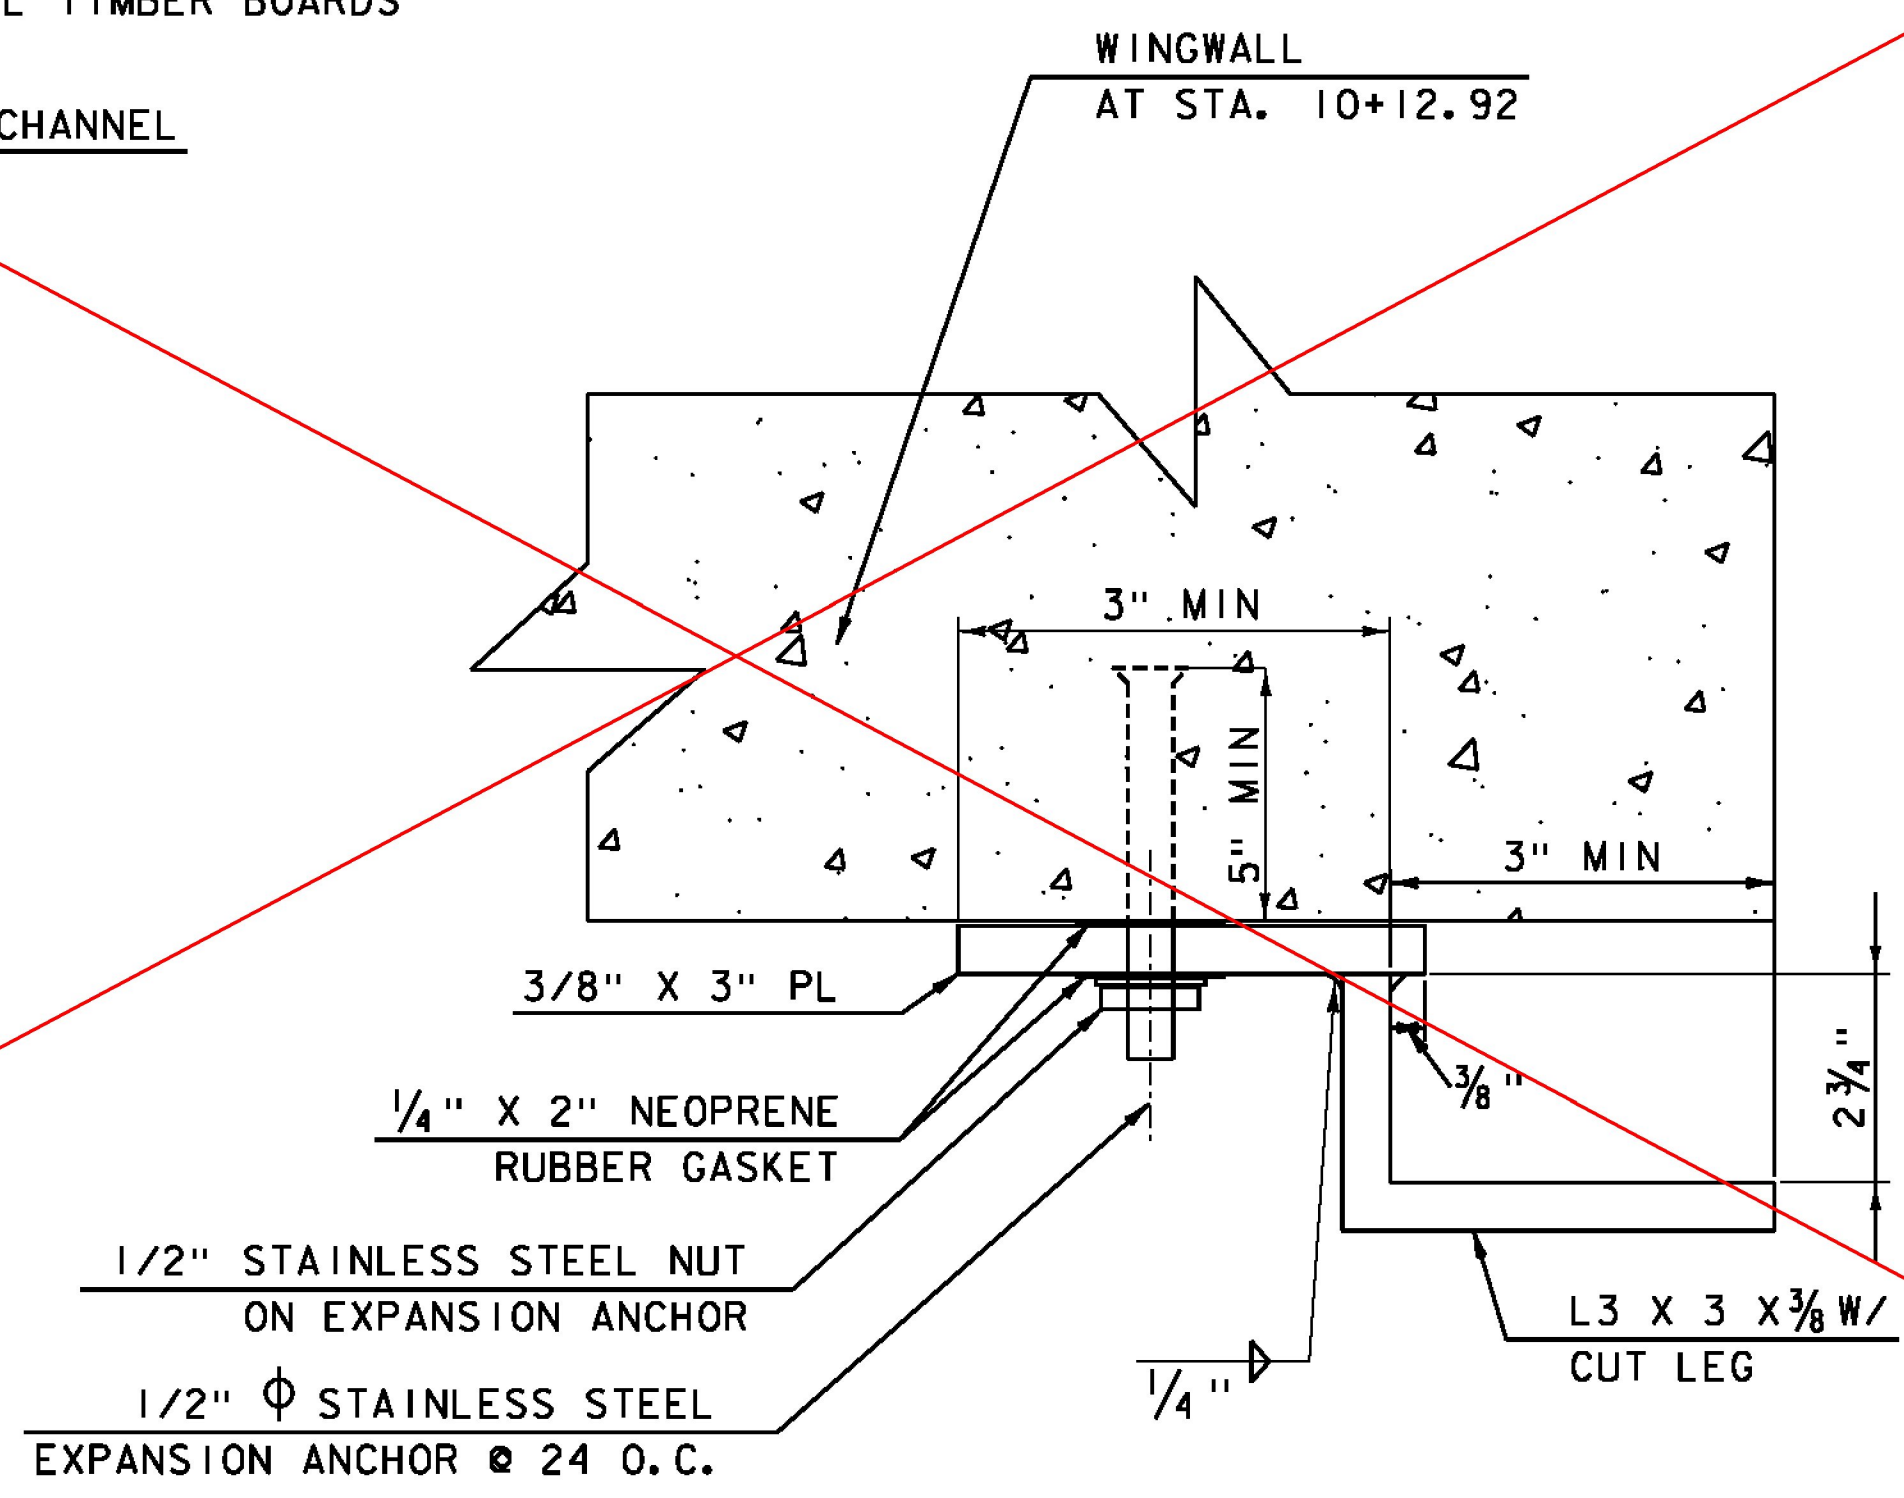

GALVANIZED STEEL CHANNEL  
SECTION A-A  
NOT TO SCALE

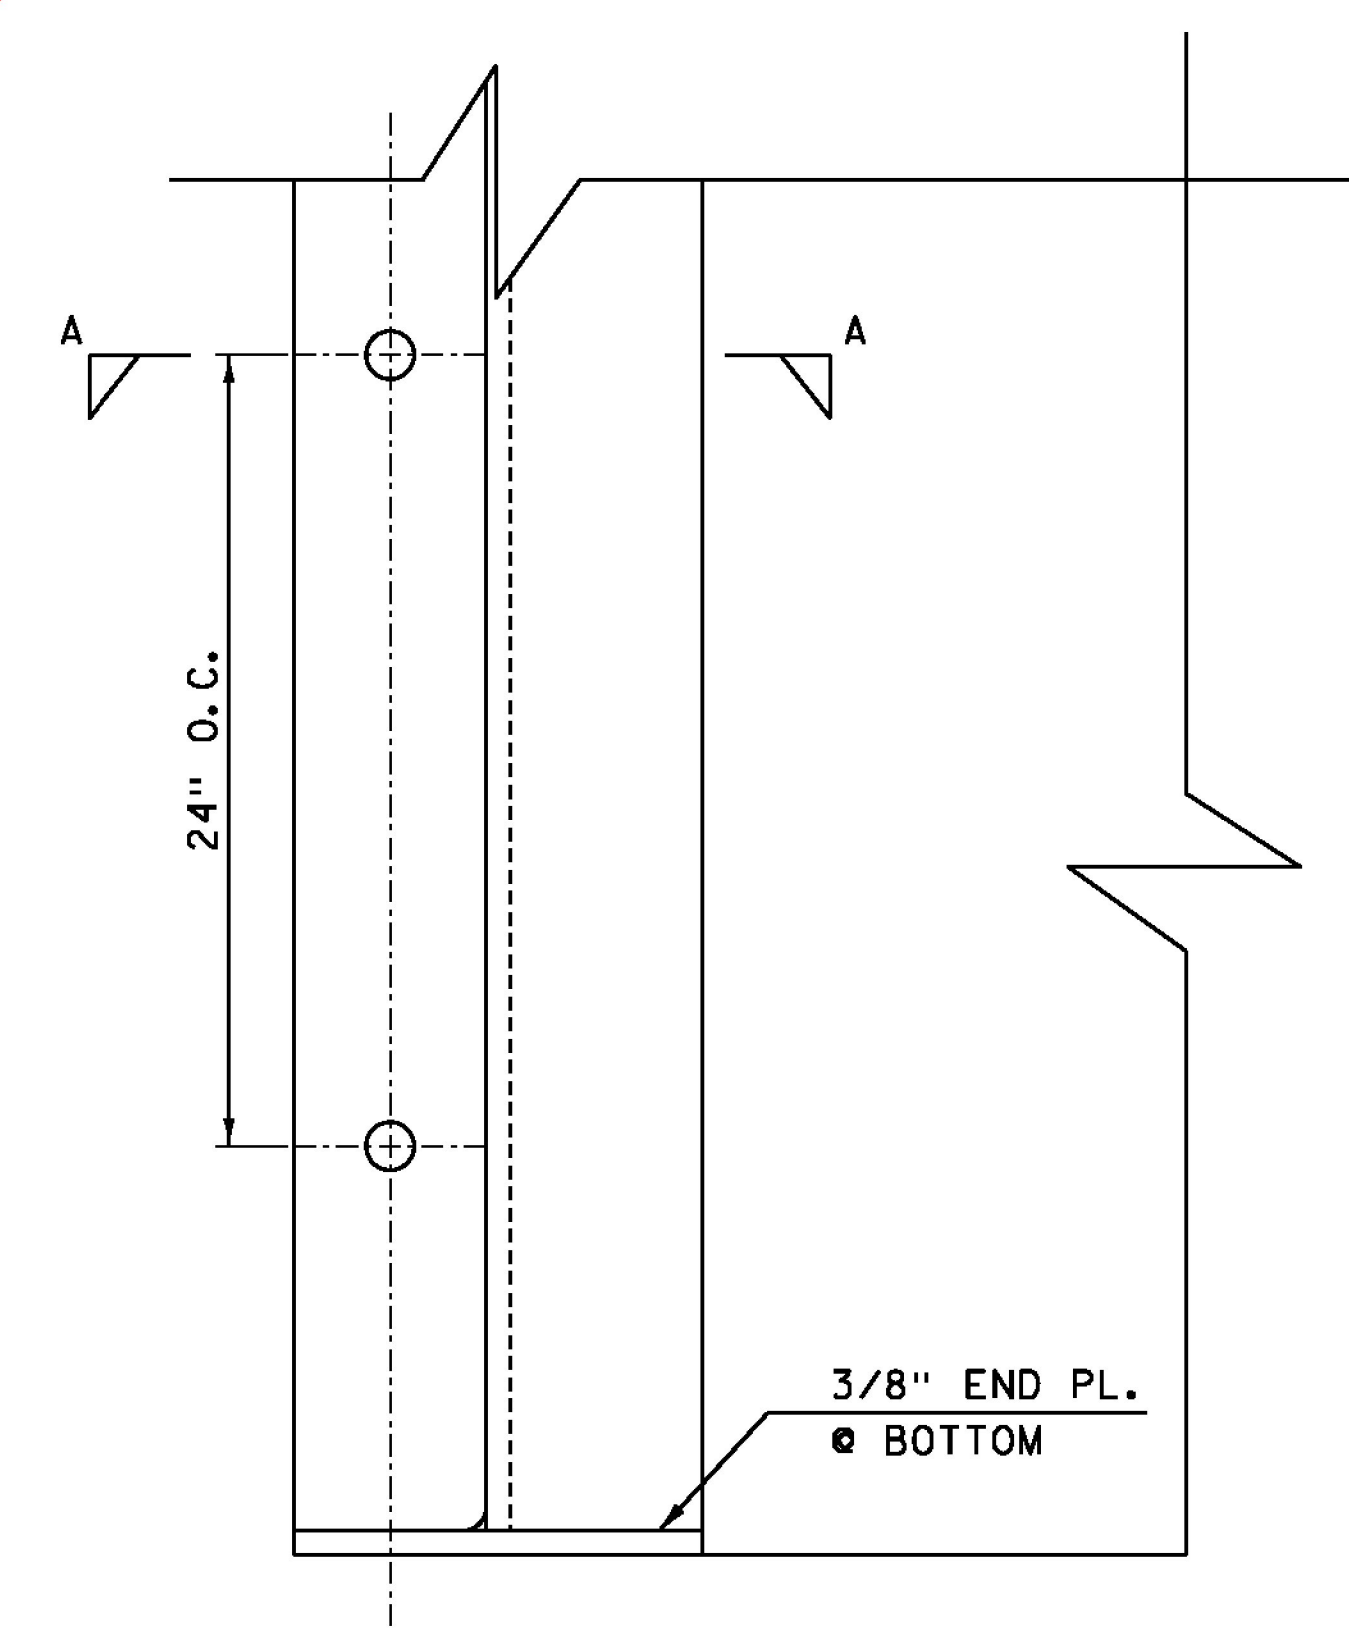


GALVANIZED STEEL CHANNEL  
NOT TO SCALE

SPECIAL PROVISION (STOP LOG SYSTEM)


THIS SHEET REPLACED  
BY FOLLOWING SHEET

PROJECT NAME: PERU	PLOT DATE: 12/31/2014
PROJECT NUMBER: STP SCRP(4)	DRAWN BY: M. BRADLEY
FILE NAME: z07b106det.dgn	DESIGNED BY: B. KHALIFA
PROJECT LEADER: E. ATKINS	CHECKED BY: B. KHALIFA
DETAIL SHEET 6	SHEET 12 OF 45

**NOTE:**  
 STOP LOG SYSTEM INITIALLY INSTALLED; DUE TO FAILURE,  
 SYSTEM WAS REPLACED IN JUNE 2018 WITH A SLUICE GATE.  
 SEE FOLLOWING SHEETS FOR SLUICE GATE SYSTEM.


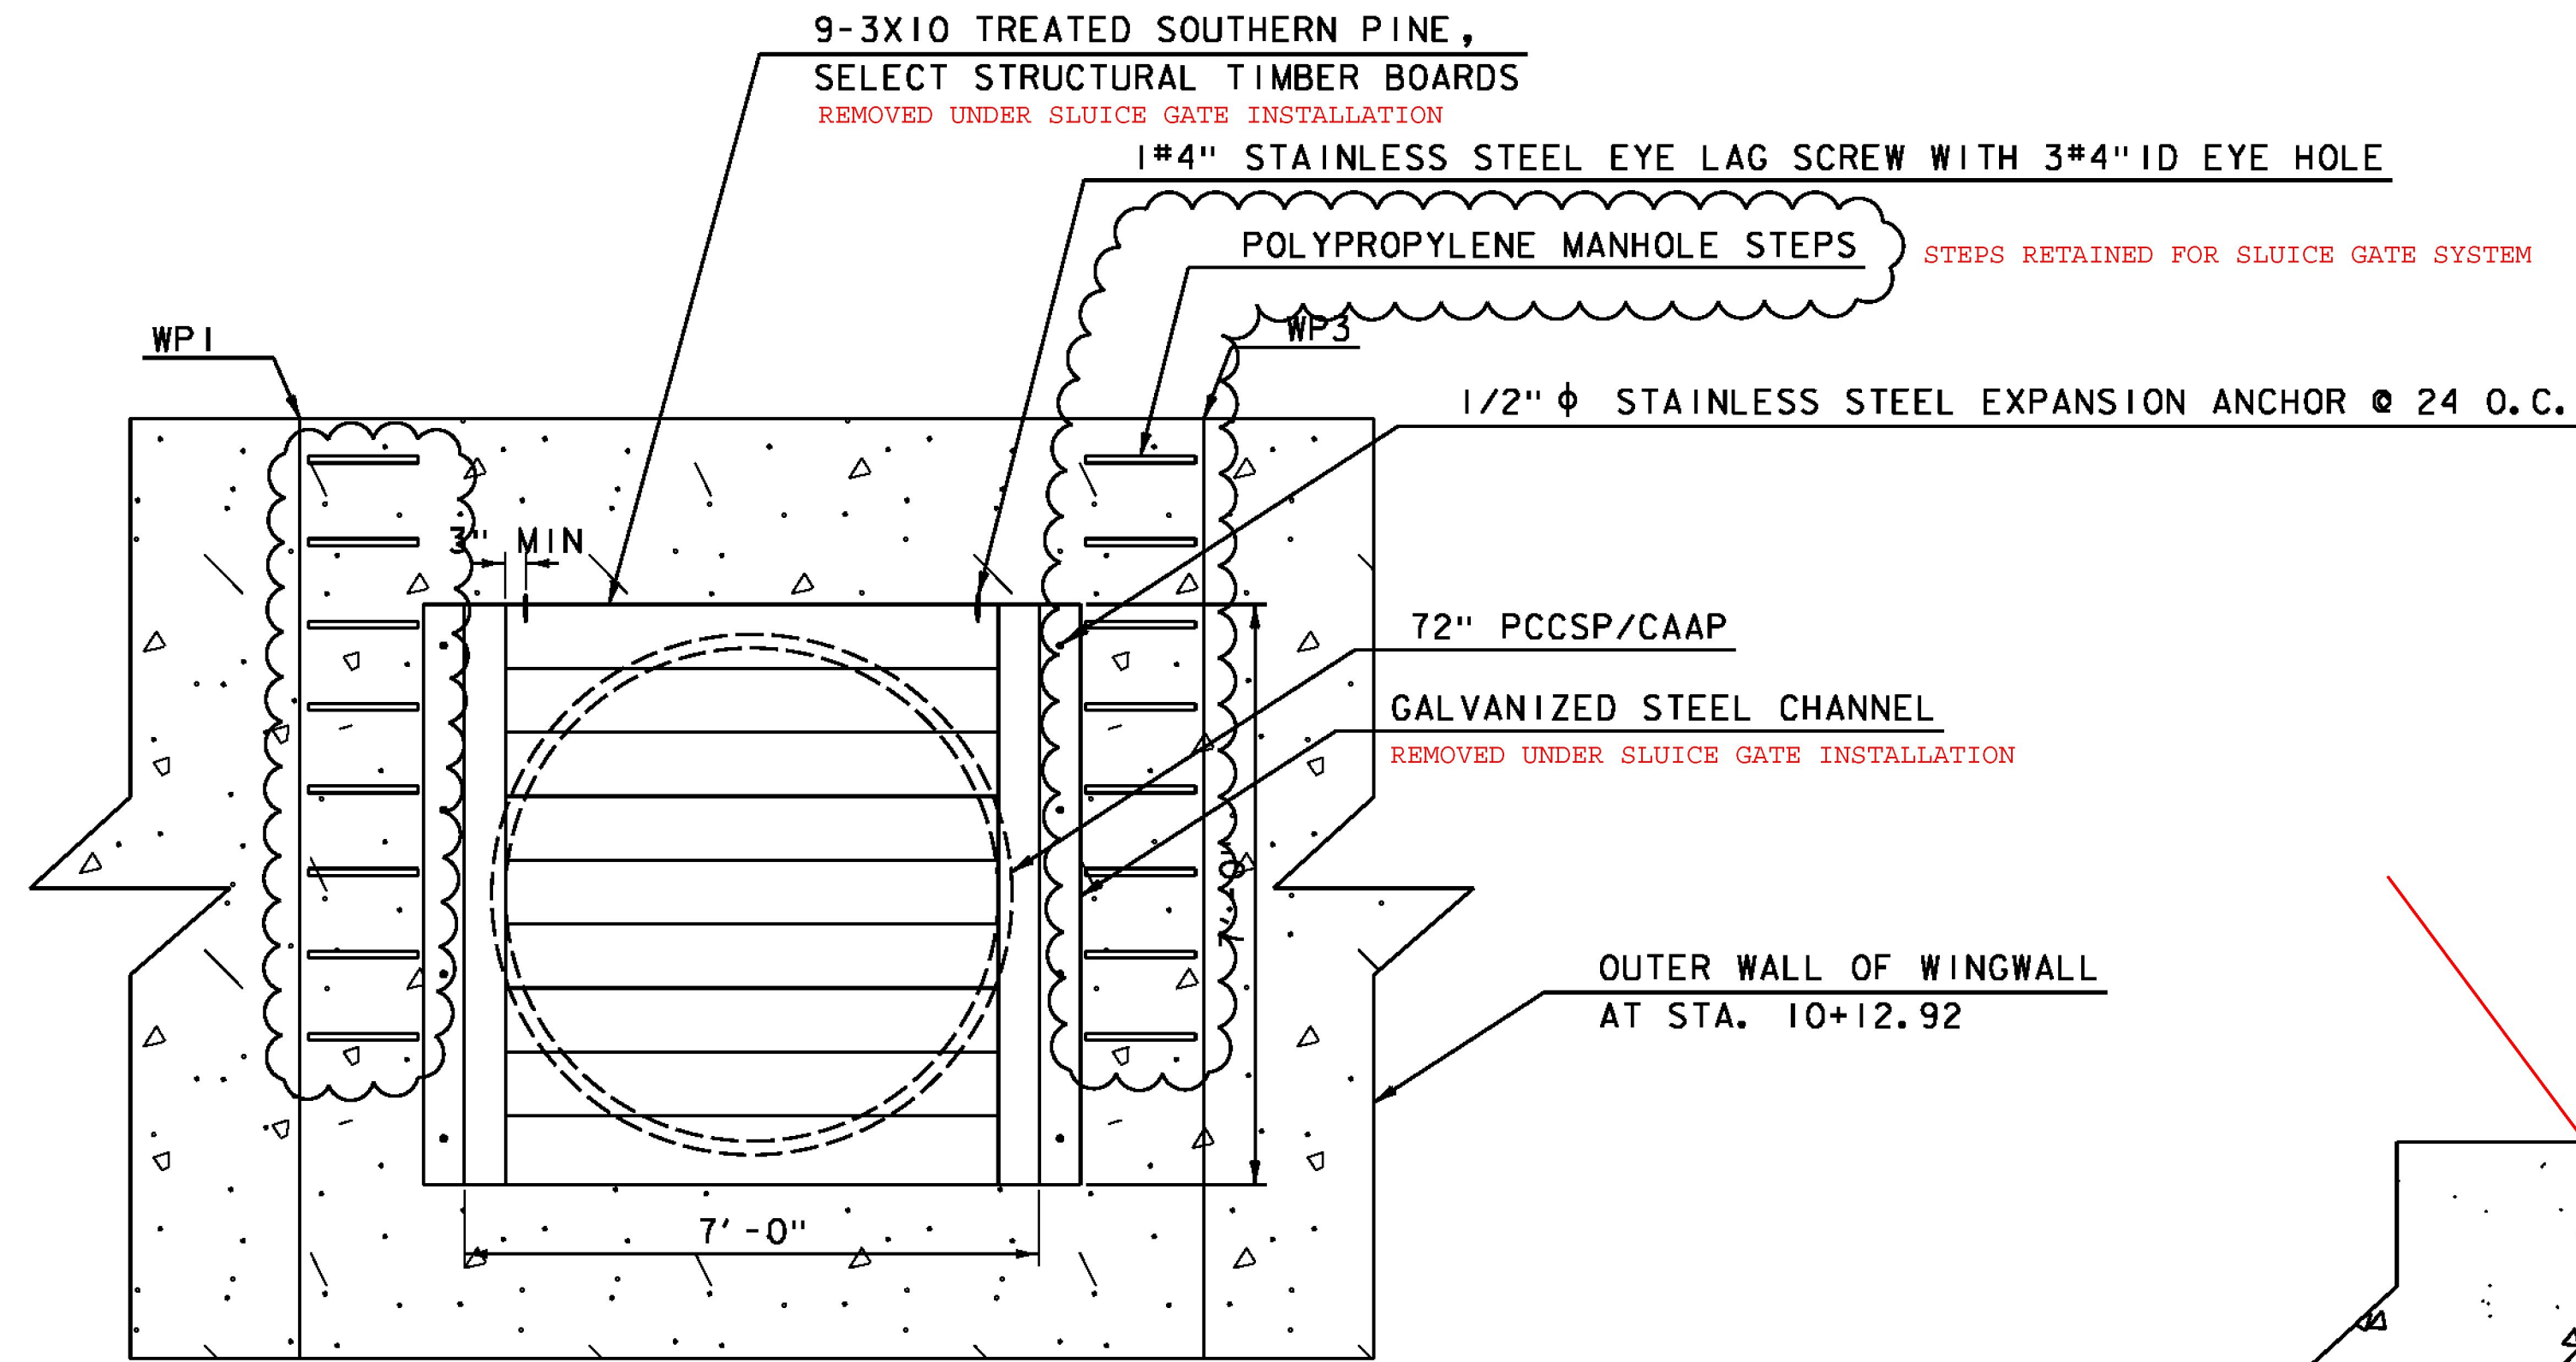


FRONT VIEW - SPECIAL PROVISION (STOP LOG SYSTEM)  
 NOT TO SCALE

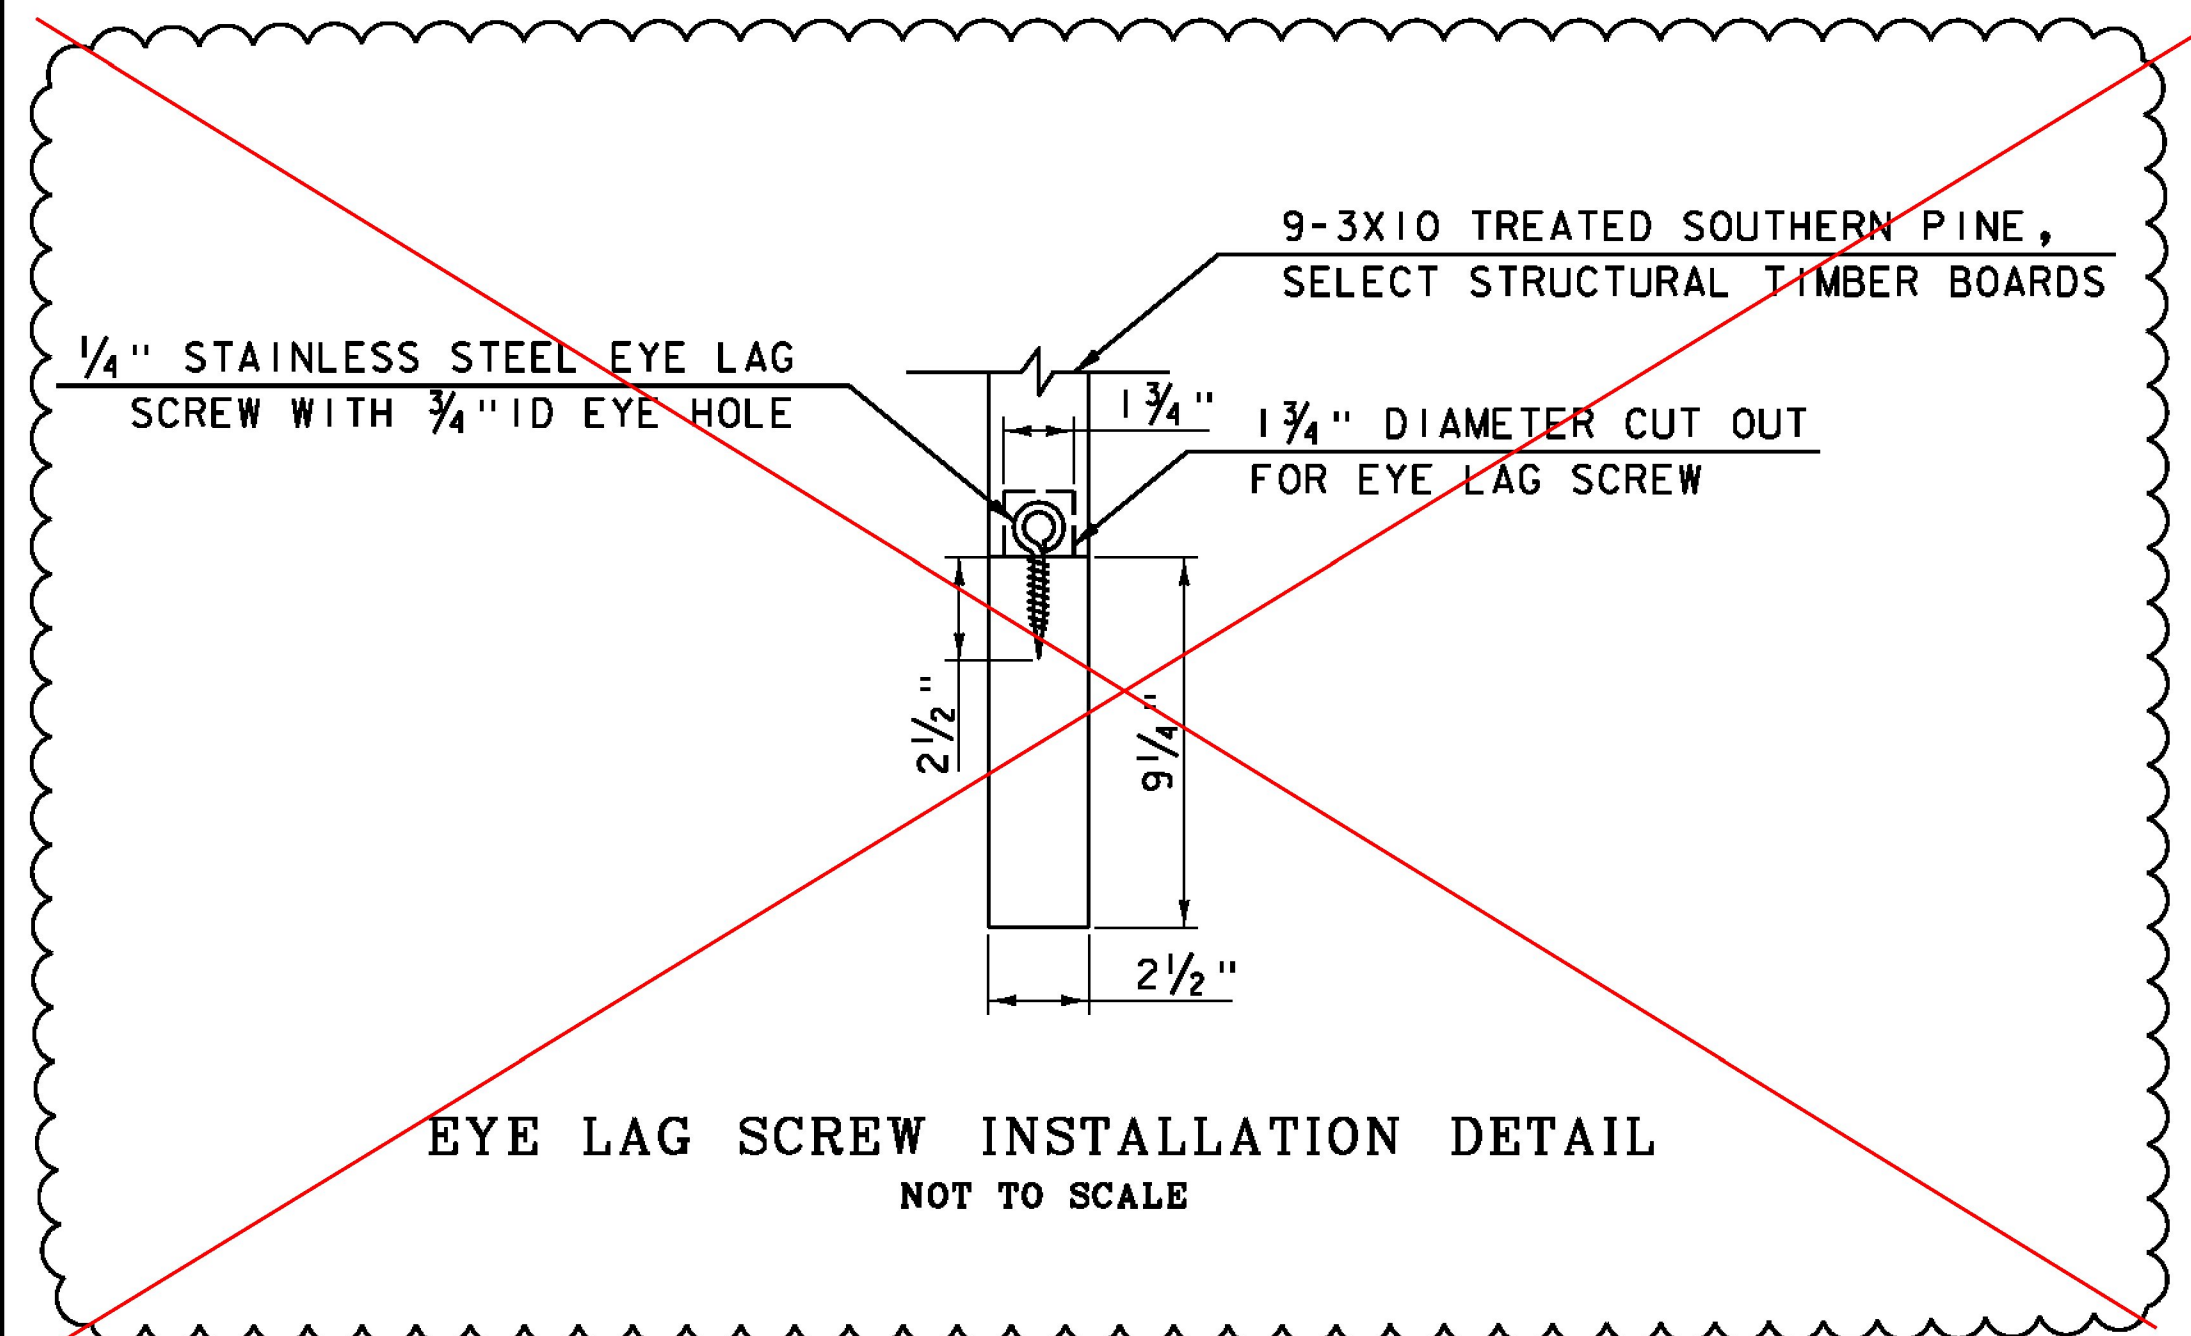

EYE LAG SCREW INSTALLATION DETAIL  
 NOT TO SCALE

**SPECIAL PROVISION (STOP LOG SYSTEM)**

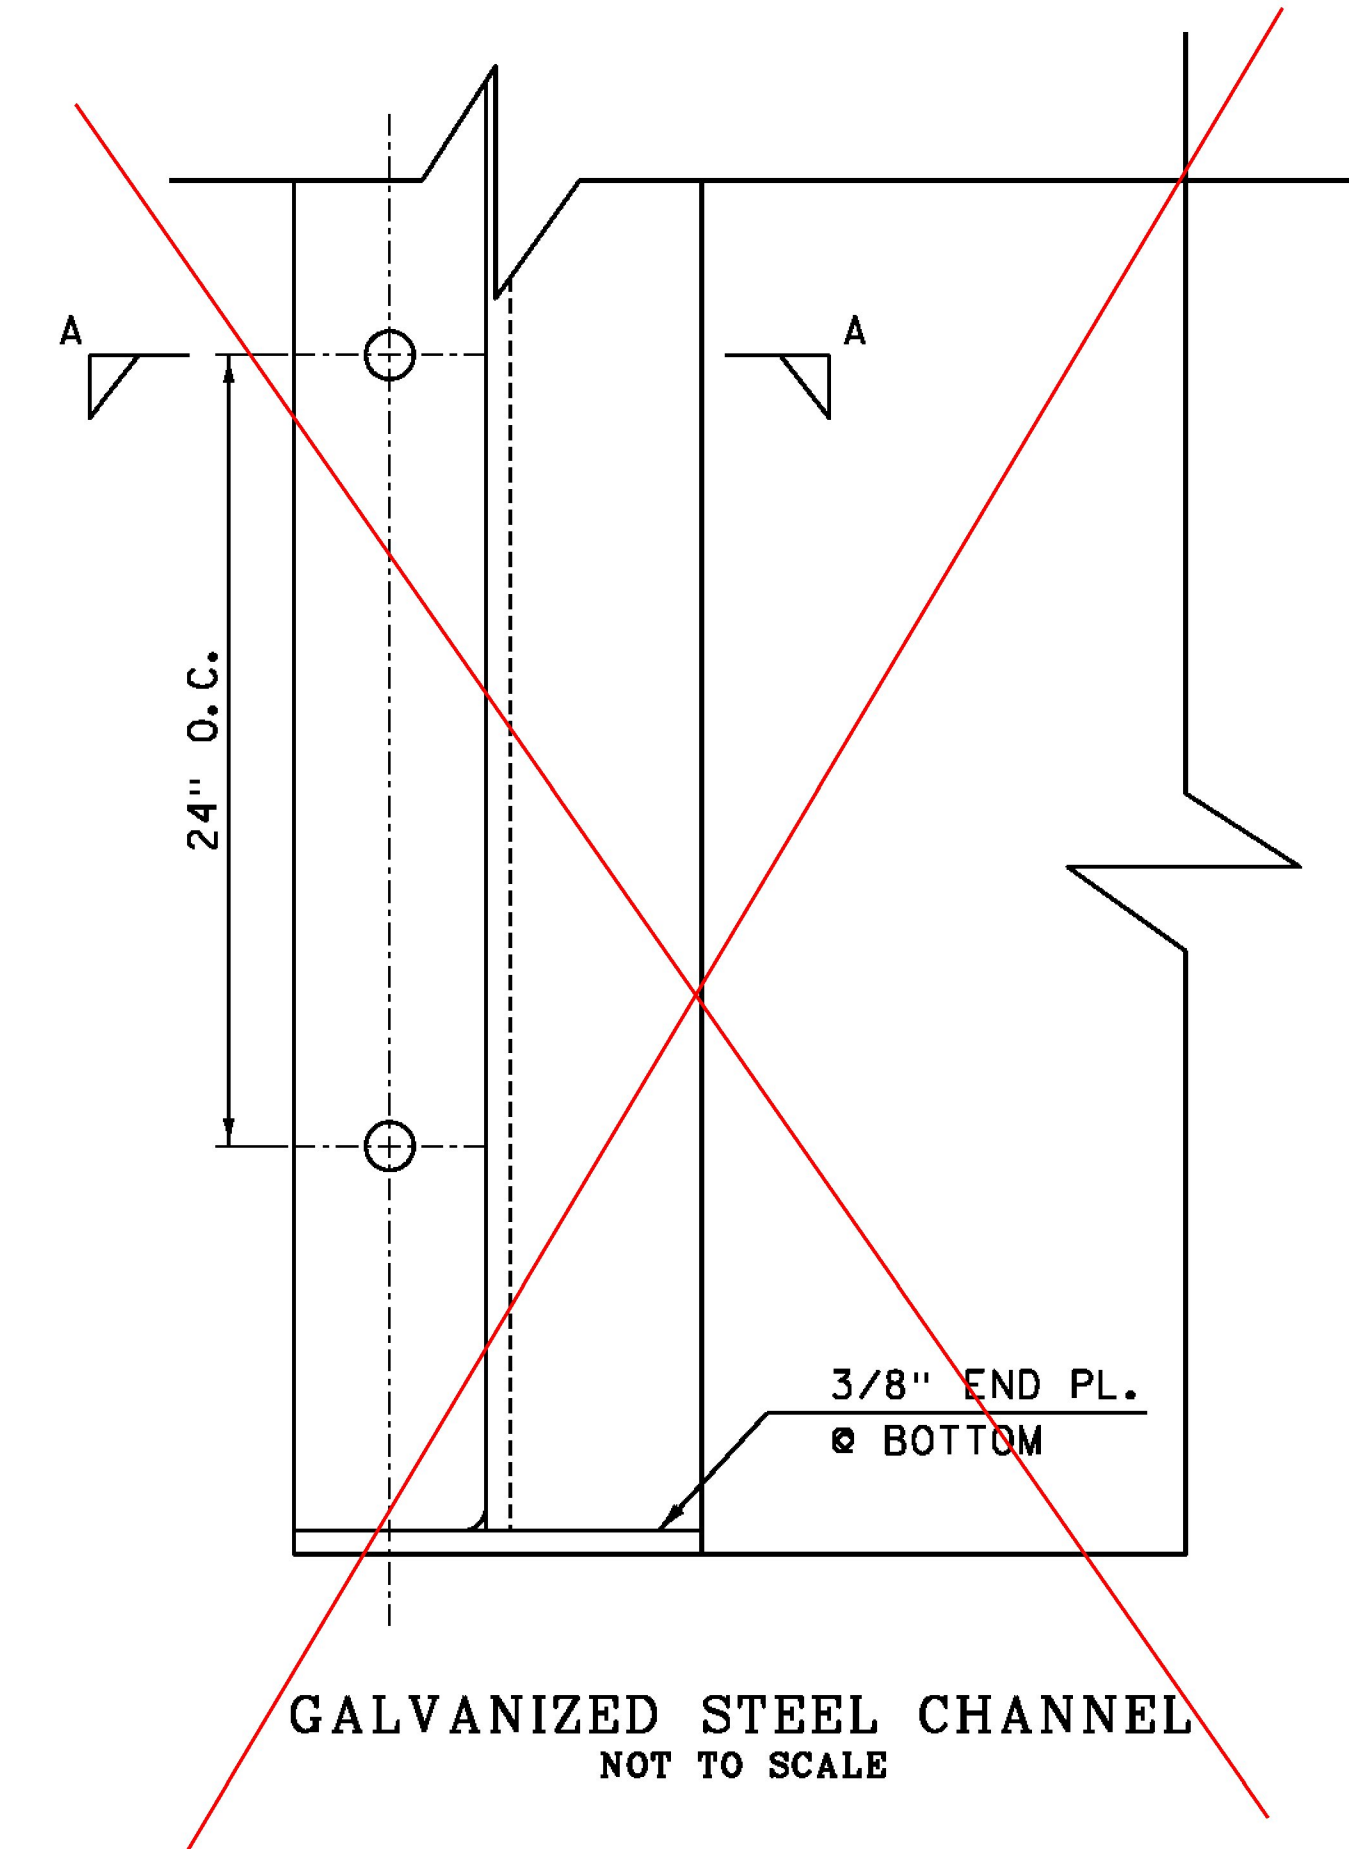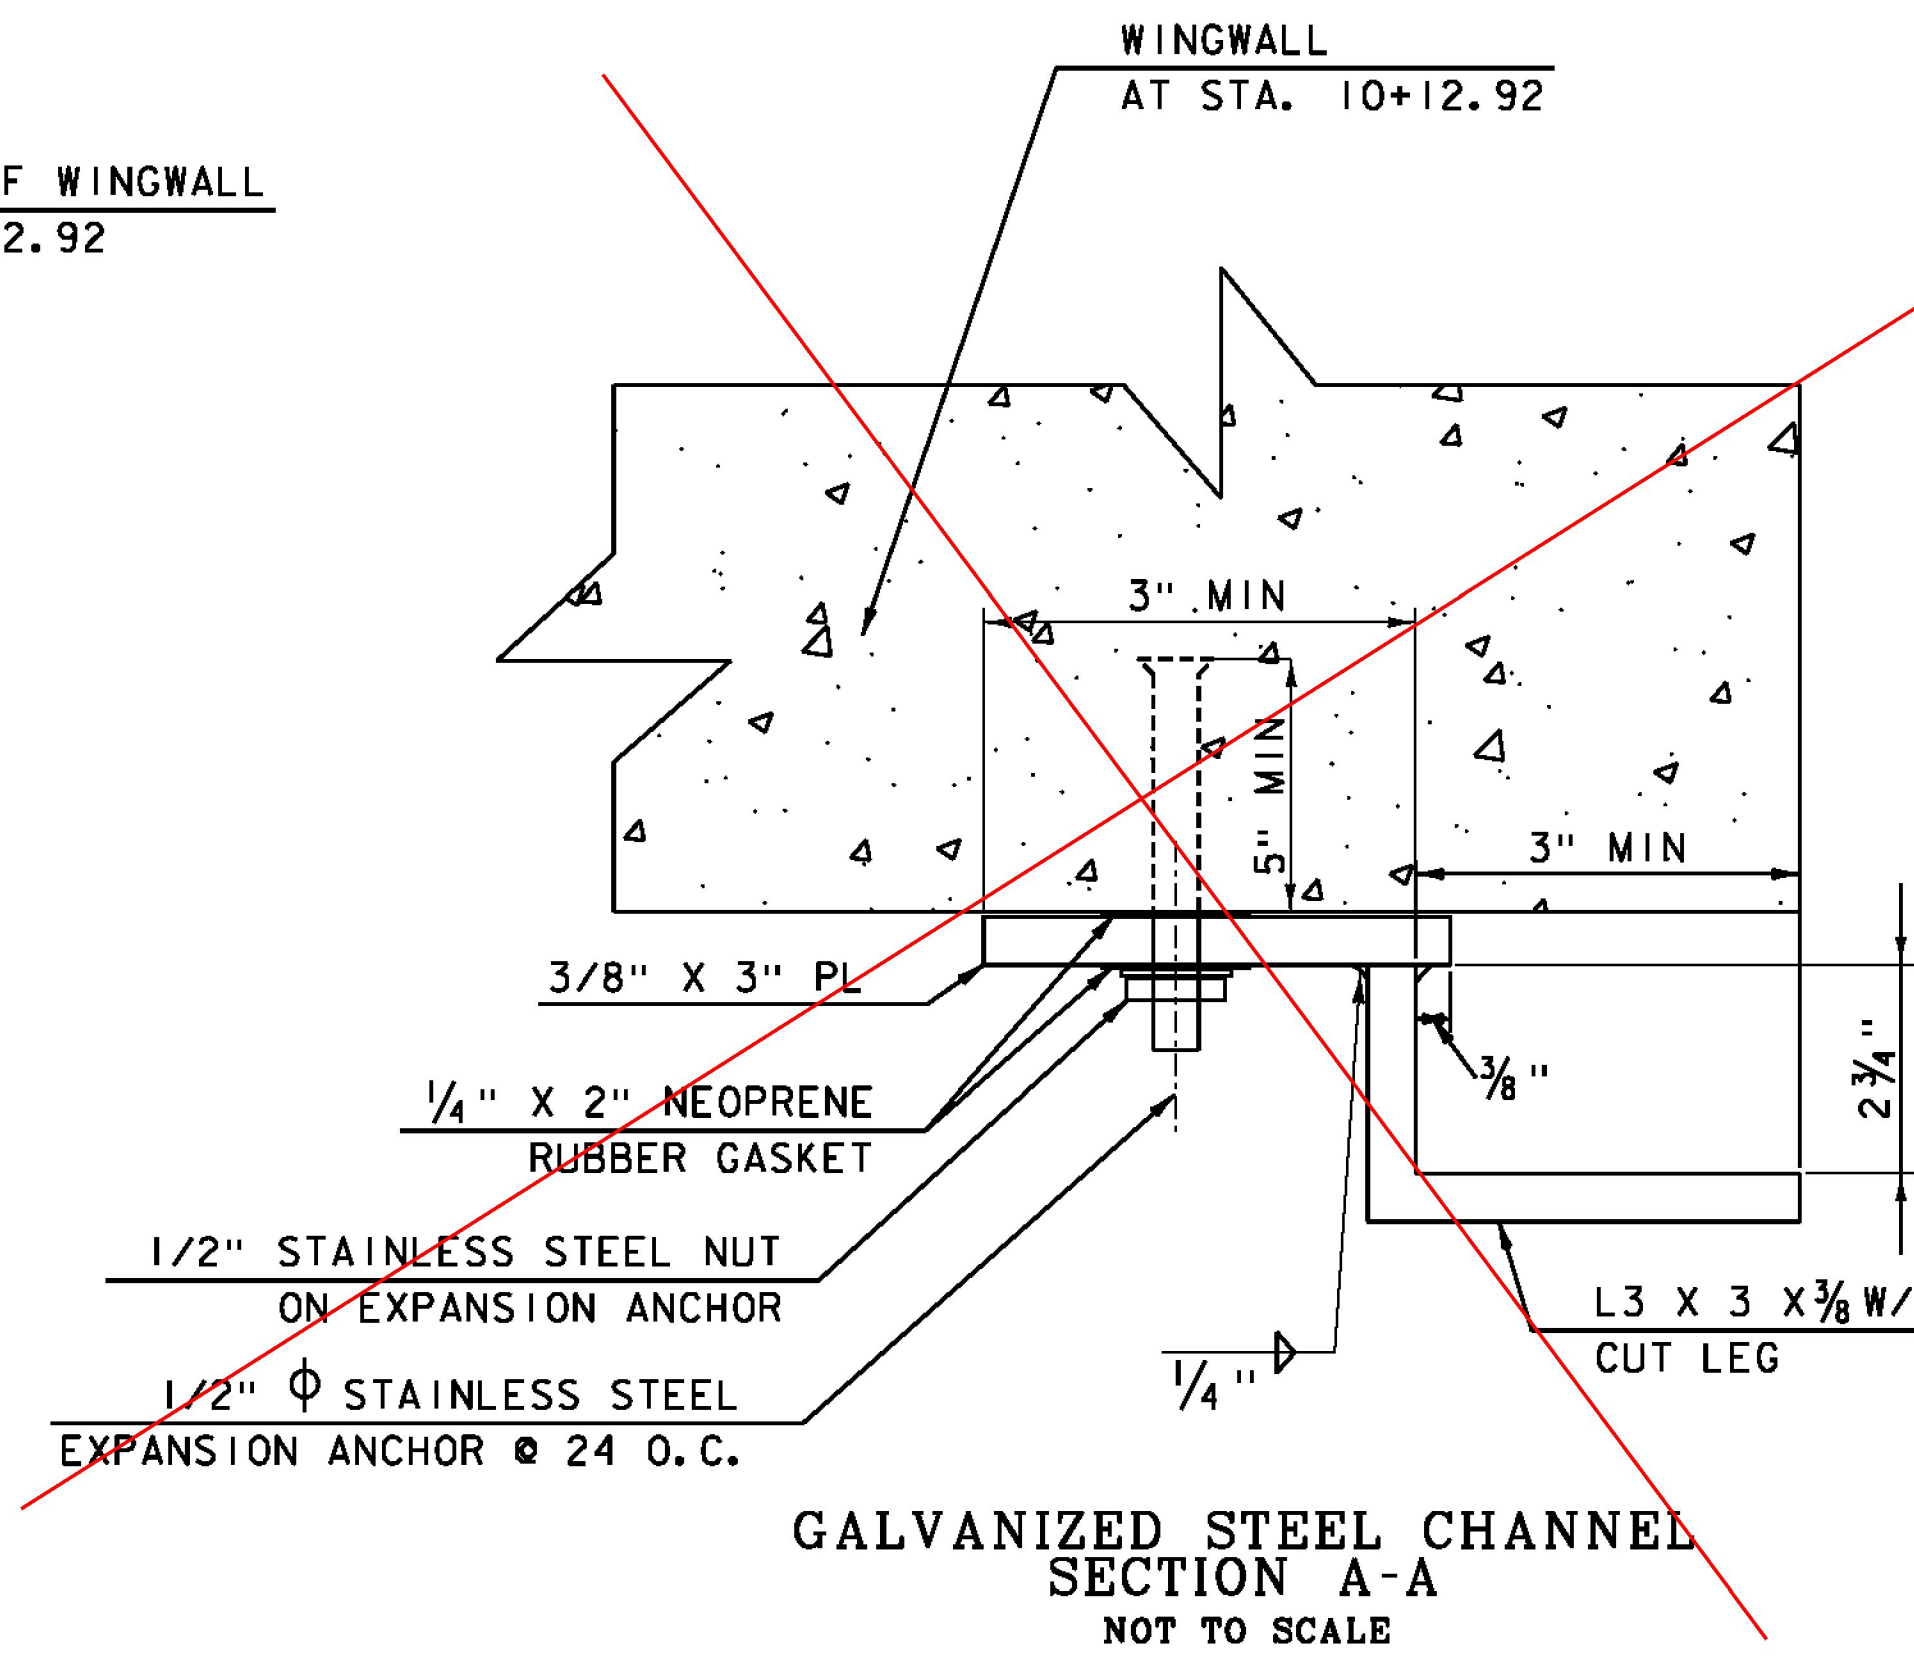

GALVANIZED STEEL CHANNEL  
 NOT TO SCALE

THIS SHEET REPLACES PRECEDING SHEET


PROJECT NAME: PERU  
 PROJECT NUMBER: STP SCR(4)


FILE NAME: z07bi06det.dgn  
 PROJECT LEADER: E. ATKINS  
 DESIGNED BY: B. KHALIFA  
 DETAIL SHEET 6

PLOT DATE: 12/31/2014  
 DRAWN BY: M. BRADLEY  
 CHECKED BY: B. KHALIFA  
 SHEET 12R OF 45

HEADWALL SECTION

**Vermont Agency of Transportation  
 Accepted**  
 By Ken Upmal at 7:50 am, May 30, 2018

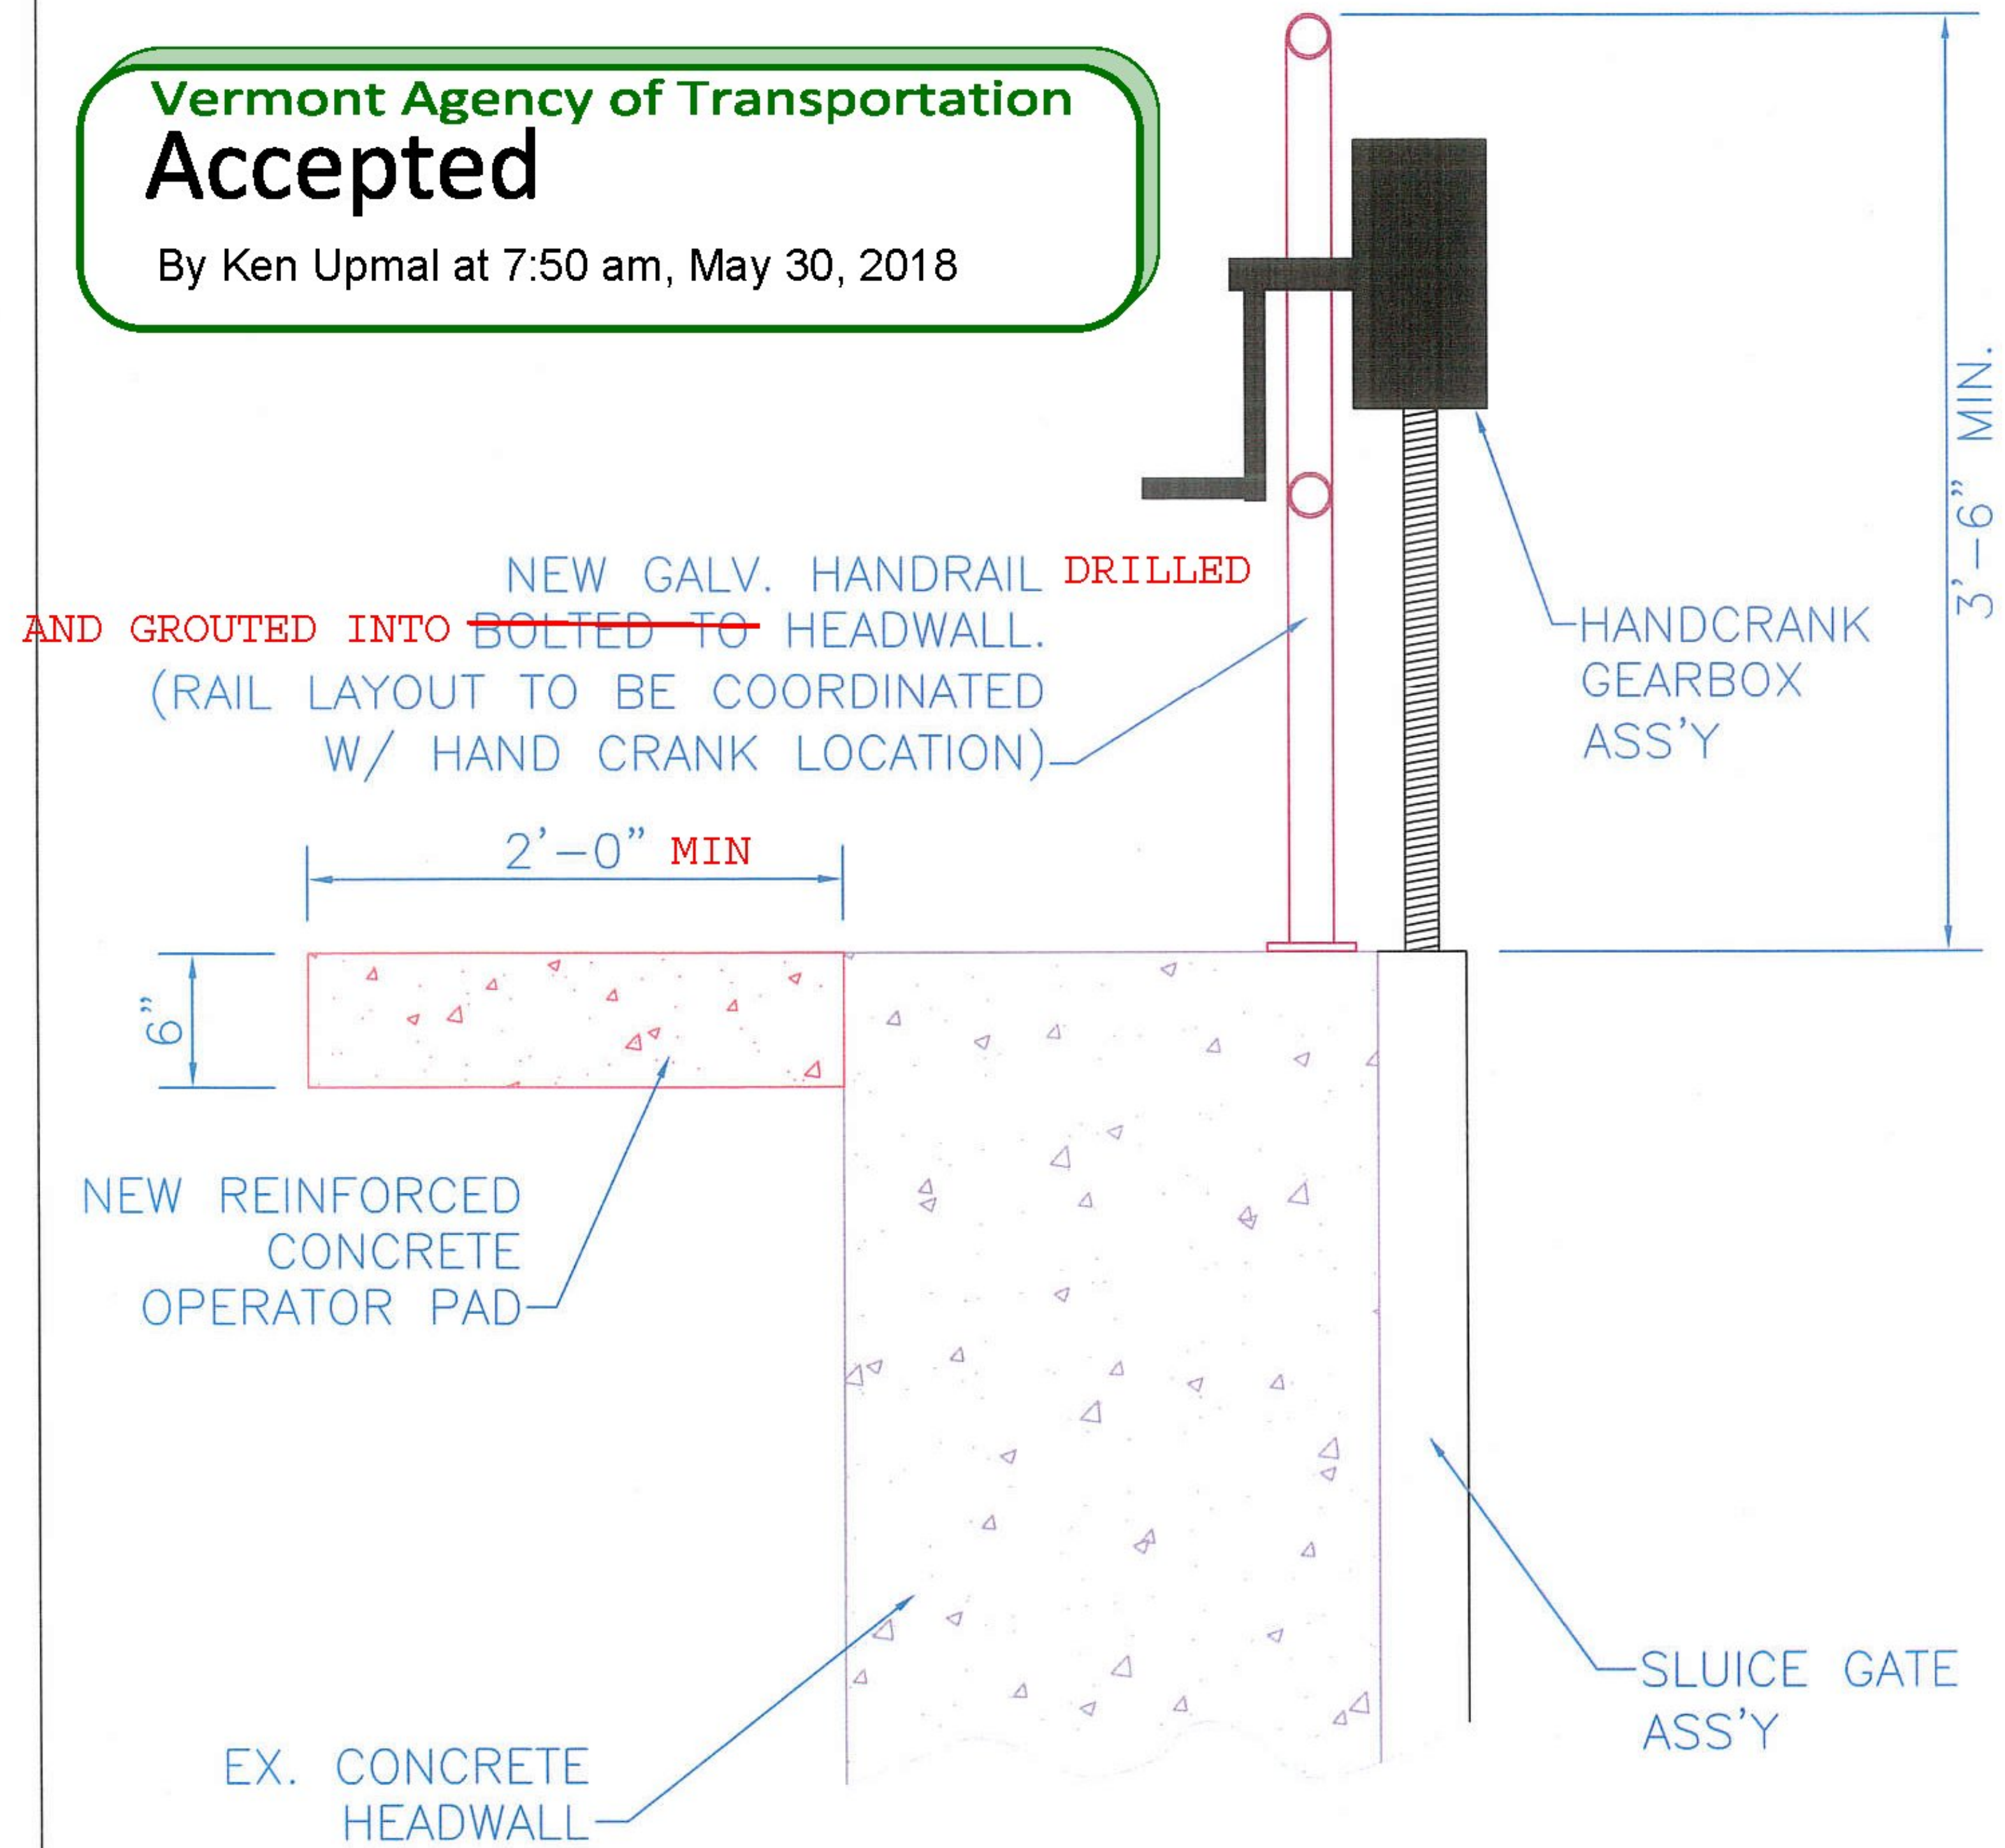


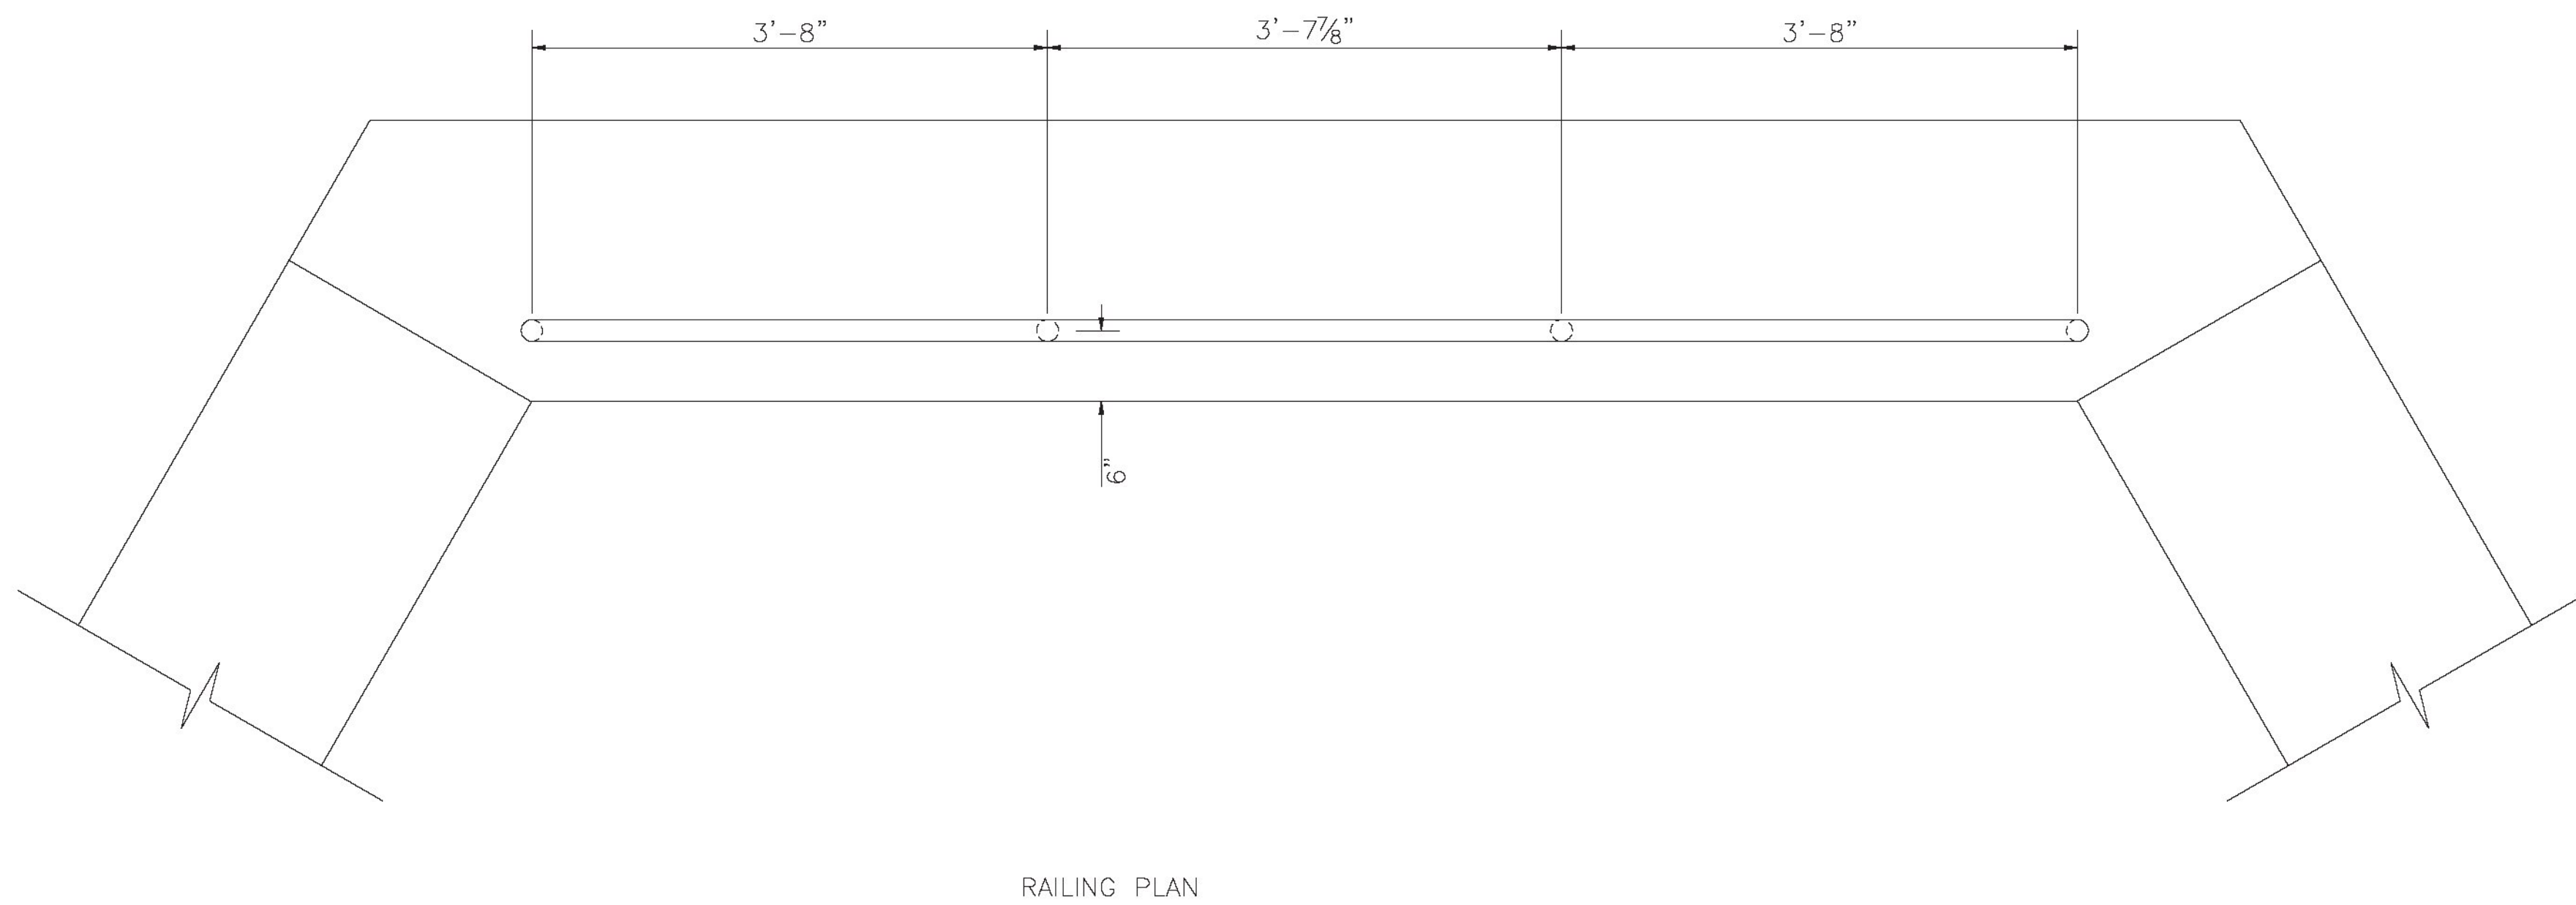

RAILING PLAN

**Vermont Agency of Transportation Accepted**  
By Ken Upmal at 10:15 am, Apr 06, 2018

<b>B. RENAUD BROS. INC.</b> STEEL SALES & FABRICATION VERNON VT. USA	WELDING PROCEDURE		NO.		
	DATE: 2/26/2017	PROJECT NAME: PERU	RB-FW-001		
BY: A. DUNKLEE	PROJECT NO. STP SCR(4)				
AWS CODE: D1.5	PQR REF. NO: N/A				
MATERIAL SPECIFICATION: ASTM 500 GR. B					
WELDING PROCESS: SMAW					
MANUAL, SEMI-AUTOMATIC OR AUTOMATIC: MANUAL					
WELDING POSITION: ALL					
FILLER METAL SPECIFICATION: ANSI/AWS A5.1-A5.5					
FILLER METAL CLASSIFICATION: E7018					
FLUX: N/A					
SHIELDING GAS: N/A	FLOW RATE: N/A				
SINGLE OR MULTIPLE PASS: SINGLE					
SINGLE OR MULTIPLE ARC: SINGLE					
WELDING CURRENT: DC	APPROVAL STAMP				
WELDING POLARITY: ELECTRODE POSITIVE					
WELDING PROGRESSION: N/A					
ROOT TREATMENT: REMOVE ALL IMPURITIES & GALV.					
PREHEAT & INTERPASS TEMPERATURE: $\geq 1\frac{1}{2}''=70^{\circ}\text{F}$ $1\frac{1}{2}''-2\frac{1}{2}''=150^{\circ}\text{F}$ OVER $2\frac{1}{2}''=225^{\circ}\text{F}$					
POSTHEAT TREATMENT: N/A					
HEAT INPUT: MIN: N/A MAX: N/A					
ELECTRODE STICKOUT: N/A					
PASS NO.	ELECTRODE SIZE:	WELDING CURRENT AMPS	VOLTS	TRAVEL SPEED	JOINT DETAIL:
AS REQ.	3/32"	70-110		ADJUST AS REQ.	
	1/8"	70-170			
NOTES:					

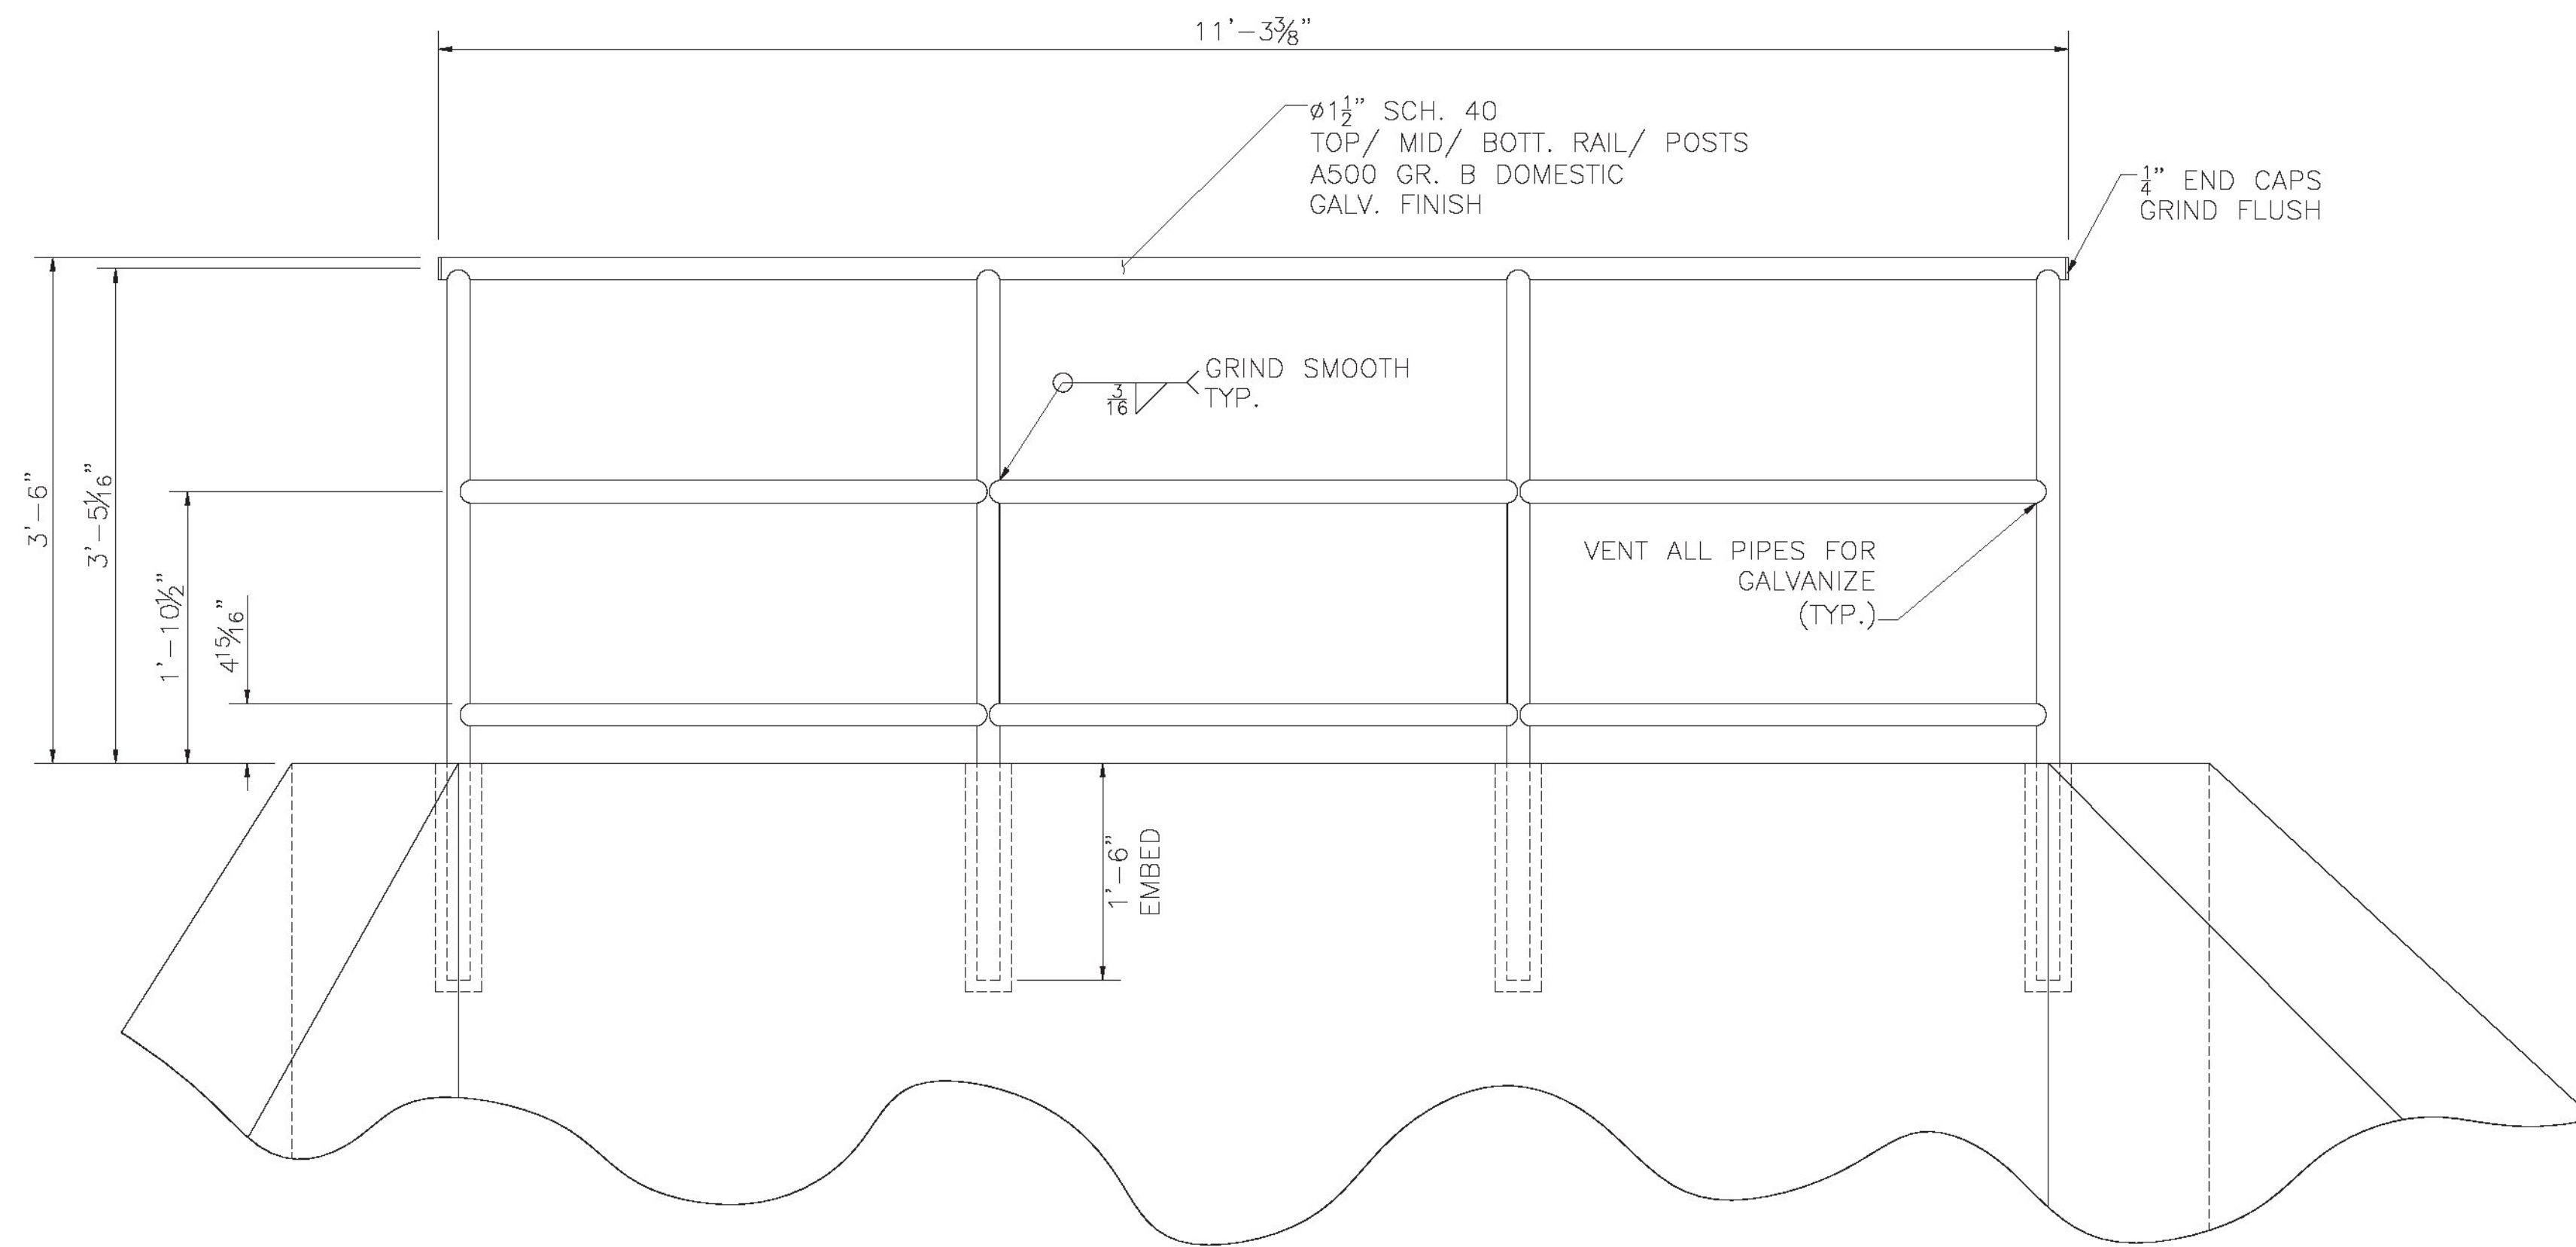

The calculation is not properly done and is difficult to understand. However, we performed our own independent analysis on the railings and posts and found that the 1 1/2" pipes are within the allowable stress limit and are acceptable.


**SUBMITTAL REVIEW**

<input checked="" type="checkbox"/>	NO EXCEPTIONS TAKEN
<input type="checkbox"/>	MAKE CORRECTIONS NOTED
<input type="checkbox"/>	REVISE AND RESUBMIT
<input type="checkbox"/>	REJECTED

CHECKING IS ONLY FOR GENERAL CONFORMANCE WITH THE DESIGN CONCEPT OF THE PROJECT AND GENERAL COMPLIANCE WITH THE INFORMATION GIVEN IN THE CONTRACT DOCUMENTS. ANY ACTION SHOWN IS SUBJECT TO THE REQUIREMENTS OF THE PLANS AND SPECIFICATIONS. CONTRACTOR IS RESPONSIBLE FOR DIMENSIONS WHICH SHALL BE CONFIRMED AND CORRELATED AT THE JOB SITE; FABRICATION PROCESSES AND TECHNIQUES OF CONSTRUCTION; COORDINATION OF HIS WORK WITH THAT OF ALL OTHER TRADES; AND THE SATISFACTORY PERFORMANCE OF THE WORK.

**GREEN INTERNATIONAL AFFILIATES, INC.**  
CIVIL AND STRUCTURAL ENGINEERS

CHECKED BY MS DATE 4/05/2018  
SIGNED BY BK DATE 4/05/2018

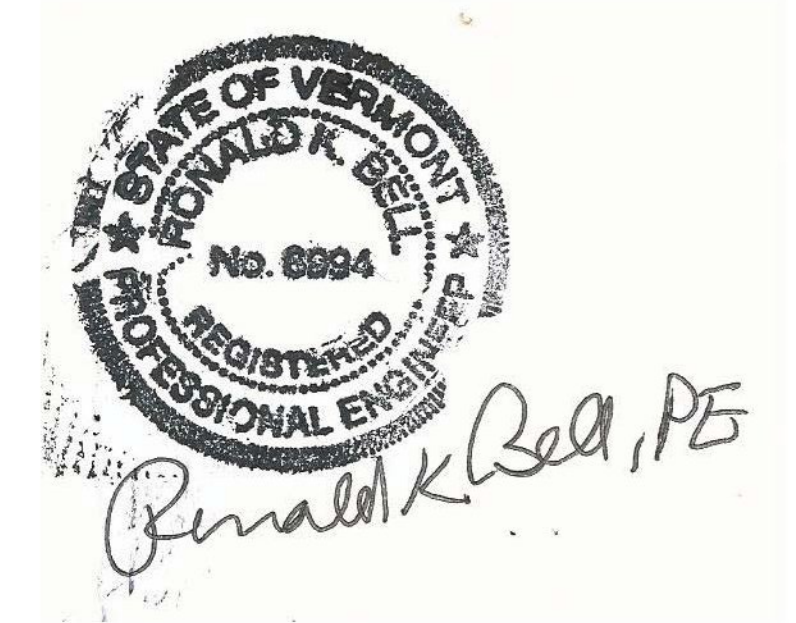

NOTES:  
ALL EXPOSED EDGES GRIND TO A 1/16" RADIUS  
ALL MATERIALS TO BE DOMESTIC  
ALL WELDING TO BE PERFORMED BY VTrans QUALIFIED WELDER

MATERIALS	A500 GR. B
HOLE SIZE	N/A
BOLT SPECS.	N/A
FINISH	GALV.

SHEET NAME: RAIL LAYOUT

PROJECT NAME: PERU	SHEET NO. 1 OF 1
PROJECT NO: STP SCR(4)	
PROJECT OWNER: VTrans	
DRAWN BY: A.D.	CHK'D BY: C.E.
DATE: 2/26/18	

REV. NO.	DATE:

**B. RENAUD BROS. INC.**  
STEEL SALES & FABRICATION  
VERNON VT. USA

283 FT. BRIDGMAN RD. VERNON VT., 05554  
PH. (802) 251-7383 FAX: (802) 251-7308


EMBEDDED DEPTH FOR ALL THREADED STUDS			
DIAMETER	EMBEDDED DEPTH	HOLE DEPTH	HOLE DIA.
3/4	14	11-1/4	7/8

Contractor to confirm in the field that adequate clearance will be provided.

**Approved AsNoted**  
 BY: Ken Upmal  
 DATE: 11/29/2017  
 RESUBMIT: NO  
 RECEIVED: November 13, 2017  
 CKD BY: DV/BK (Green Intl.)  
 STATE OF VERMONT  
 AGENCY OF TRANSPORTATION

MATERIAL KEY	FINISH KEY	PAINT KEY
1. CAST IRON:ASTM A-126 CL. B 4. MANG. BRZ.:ASTM B-584 AL. C86500 5. NAVAL BRZ.:ASTM B-21 AL. C48200	1. AS CAST 2. MILL 3. MACHINED 4. GALVANIZE-ASTM A-123 5. GALVANIZE-ASTM A-153 6. SEE PAINT KEY 7. ZINC PLATED	6E BLAST CLEAN PER SSPC-SP10 PRIME (1) CT (3 MILS) & PAINT (2) CTS (4 MILS/CT) TDFT-11 MILS POLYAMIDE EPOXY COLOR: GRAY 6H-L VENDOR PRIME COAT (2) CTS POLYAMIDE EPOXY PAINT & (1) CT POLYURETHANE ENAMEL (TDFT-7 MILS) COLOR: GRAY 6H BLAST CLEAN PER SSPC-SP6 (2) CTS POLYAMIDE EPOXY PAINT & (1) CT POLYURETHANE ENAMEL (TDFT-7 MILS) COLOR: GRAY

Contractor to field verify all elevations and dimensions with as built conditions.

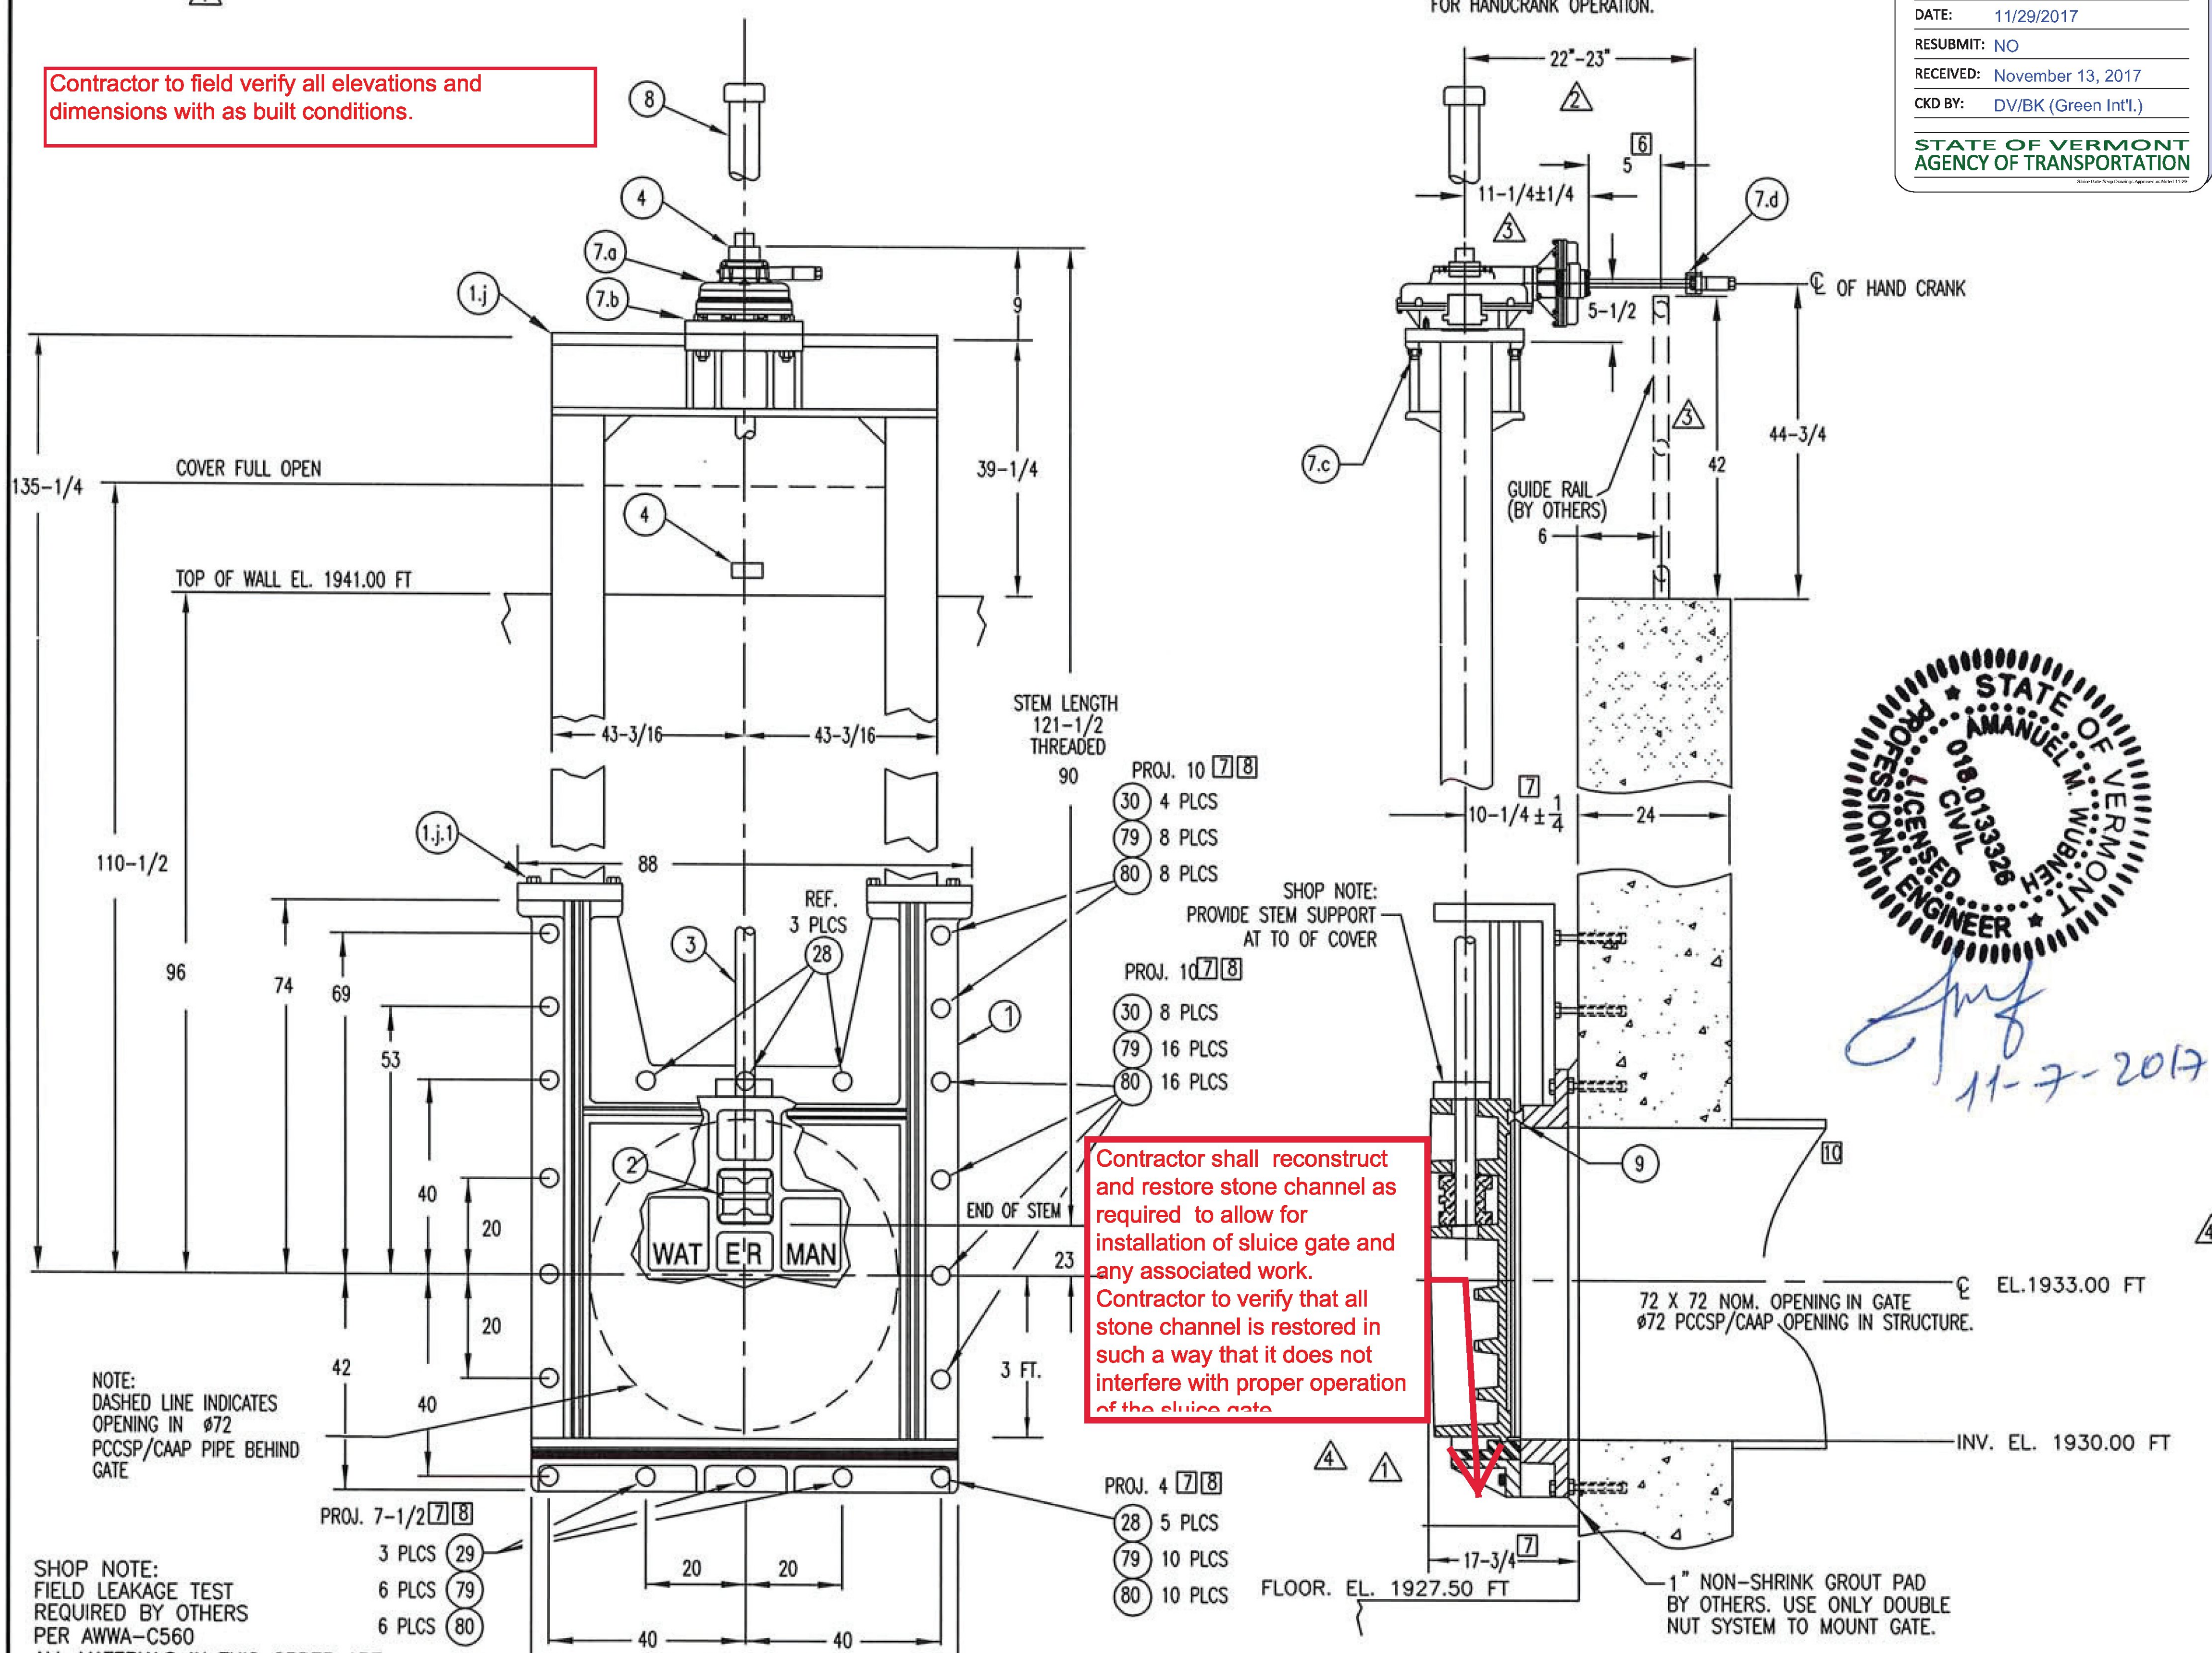

ITEM DESCRIPTION	MATERIAL KEY	FINISH KEY	PART NO. OR SIZE (FOR WATERMAN USE ONLY)	QTY/ GATE	TOTAL QTY
1. SLUICE GATE ASSEMBLY - 72x72 QS-5000-F	-	-	REF. 100103	1	1
a) FRAME	1	6E	W-5477-01-01	1	1
b) COVER	1	6E	W-5480-02-01	1	1
c) SEAT	5	2	1-1/8 IN WIDE EXT. (REF. 100077)	A/R	A/R
d) GUIDE RAIL	1	6E	W-5096 L&R	1 EA	1 EA
e) SIDE WEDGE ASSEMBLY	-	-	SYSTEM B (REF. 100067)	4 EA	4 EA
1) FRAME WEDGE	4	1,3	W-5004 L&R (REF. 100065)	4 EA	4 EA
2) COVER WEDGE	4	1,3	W-5139 L&R (REF. 100066)	4 EA	4 EA
3) ASSEMBLY / ADJUSTING HARDWARE	15B	2	-	A/R	A/R
f) TOP WEDGE ASSEMBLY	-	-	REF. 100074	4	4
1) TOP WEDGE	4	1,3	W-5006 (REF. 100069)	4	4
2) WEDGE BLOCK BRACKET	4	1,3	W-5007 (REF. 100070)	4	4
3) ASSEMBLY / ADJUSTING HARDWARE	15B	2	-	A/R	A/R
h) FLUSHBOTTOM ASSEMBLY	-	-	REF. 102982	1	1
1) BRACKET	1	6E	W-5156-00-01	1 EA	1 EA
2) SEAL	13	2	76 INCHES (REF. 102981)	1	1
3) SEAL RETAINER	9B	2	-	1	1
4) ASSEMBLY / ADJUSTING HARDWARE	15B	2	-	A/R	A/R
j) YOKE	1	6E	REF. 105207	1	1
1) ASSEMBLY / ADJUSTING HARDWARE	15B	2	-	A/R	A/R
2. THRUST NUT (W-5014)	4	2,3	2-1/2 DIA, 4 TPI, LH (REF. 101224-91) [5]	1	1
3. STEM (RISING)	9B	2	2-1/2 DIA, 4 TPI, LH (REF. 108130-1) [5]	1	1
4. LIMIT NUT	1	5	2-1/2 DIA, 4 TPI, LH (REF. 108222-11) [5]	2	2
7. LIFT ASSEMBLY	-	-	-	1	1
a) LIFT	1,4	6H-L	TYPE 1B7/AS3 12:1 MOD.EXTEND SHAFT INPUT BY 6 INCHES CUSTOM FA16 BASEPLATE (SEE BUILD PLANS) 3/4 NC X 4-1/2 LG. REF. 109919	1	1
b) BASEPLATE	6	6H	-	1	1
c) HEX HEAD BOLT & WASHER	15B	2	-	8/8	8/8
d) HANDCRANK (15 INCH RADIUS)	20,35A	2,3	-	1	1
8. STEM COVER (W/ MYLAR STRIP)	14,35A	2	REF. 102787 (4 in) 78 LG.	1	1
9. STEM COVER ADAPTOR	6,11	4	REF. 104041	1	1
28. ALL THREADED STUD [8]	9B	2,3	3/4 NC X 18 LG.	5	5
29. ALL THREADED STUD [8]	9B	2,3	3/4 NC X 21-1/2 LG.	3	3
30. ALL THREADED STUD [8]	9B	2,3	3/4 NC X 24 LG.	12	12
79. HEX NUT	15B	2	3/4 NC	40	40
80. WASHER	316 SS	2	3/4 DIA.	40	40

NOTES: UNLESS OTHERWISE SPECIFIED.  
 1. (GATE CAPACITY) MAXIMUM SEATING HEAD = 51 FT.; MAXIMUM UNSEATING HEAD = 20 FT.  
 2. OPERATING HEAD FROM GATE CENTER LINE: SEATING HEAD = 15 FT.; UNSEATING HEAD = 15 FT. [8]  
 3. LIFT CAPACITY = 15340 LBS @ 25 LBS PULL.  
 4. TURN HANDWHEEL CCW TO OPEN (RAISE) GATE.  
 5. 29' MODIFIED STUB ACME THREADS.  
 6. CONTRACTOR TO VERIFY OR SUPPLY.  
 7. DIMENSION INCLUDES GROUT PAD THICKNESS.  
 8. CONTRACTOR TO PROVIDE HILTI HIT-RE 500-V3 (WET OR DRY CONDITIONS), HILTI HY-200 (DRY CONDITIONS ONLY); OR EQUAL.  
 9. IMPACT INTO DOVETAIL GROOVE/ MACHINE FLAT TO .002 T.I.R. WITH A 63 FINISH OR BETTER.

SHOP NOTE:  
 FIELD LEAKAGE TEST  
 REQUIRED BY OTHERS  
 PER AWWA-C560  
 ALL MATERIALS IN THIS ORDER ARE  
 BUY AMERICA AND HEAT NUMBER TRACKING IS REQUIRED.  
 GATE ASSEMBLED AND TESTED FOR PROPER  
 ASSEMBLY AND OPERATION.( TEST AND INSPECTION DOCUMENT REQUIRED)

Contractor shall reconstruct and restore stone channel as required to allow for installation of sluice gate and any associated work. Contractor to verify that all stone channel is restored in such a way that it does not interfere with proper operation of the sluice gate.

CONTRACTOR TO INSURE THERE WILL NOT BE ANY DEBRIS/ SILT DEPOSIT ON THE SEATING SIDE OF THE GATE

	<b>72 X 72 WATERMAN MODEL QS-5000-F-Y SLUICE GATE</b>	FOR:RENAUD BROS.,INC 283 FORT BRIDGMAN RD#2 VERNON,VT 05354 Po:SIGNED QUOTE 8/9/17 REF:AGENCY OF TRANSPORTATION	REV.NO. [4] DATE NOV. 07, '17 AMW BY FS JOB NO. M028960C PROJECT MANAGER FRANK SOTO
		REF:AGENCY OF TRANSPORTATION	REV.NO. [3] DATE SEPT.. 05, '17 AMW BY FS JOB NO. WQ17-H-28960C DRAWN BY AMW CHECK'D BY REM ENGINEER AMW SHEET 1 OF 1
			REV.NO. [2] DATE AUG. 31, '17 AMW BY FS SCALE NTS DATE AUG. 18, '17
			REV.NO. [1] DATE AUG. 29, '17 AMW BY FS DRAWING NO. RB-17-0487

P.O. BOX 458 * 25500 Road 204 * Exeter, California 93221 * Phone (559)562-4000 * FAX (559)562-2277 * www.watermanusa.com

REUSE OF DOCUMENTS: THIS DOCUMENT AND THE IDEAS AND DESIGNS INCORPORATED HEREIN, AS AN INSTRUMENT OF PROFESSIONAL SERVICE, IS THE INTELLECTUAL PROPERTY OF WATERMAN INDUSTRIES AND IS TO BE CONSIDERED CONFIDENTIAL AND PROPRIETARY. IT, OR THE IDEAS AND CONCEPTS DESCRIBED THEREIN, ARE NOT TO BE USED, IN WHOLE OR IN PART, FOR ANY OTHER USE WITHOUT THE WRITTEN AUTHORIZATION OF WATERMAN INDUSTRIES.


V:\Draw\RB-17-0487.dwg Nov 07, 2017 - 6:13pm

# REINFORCING STEEL SCHEDULE

ITEM	EACH	SIZE	LENGTH	MARK	TYPE	A	B	C	D	E	F	G	H	J	K	R	O	ITEM	EACH	SIZE	LENGTH	MARK	TYPE	A	B	C	D	E	F	G	H	J	K	R	O				
OUTLET HEADWALL, WINGWALLS AND FOOTING																																							
	52	7	13'- 6"	1W701	STR																																		
	52	7	13'- 6"	1W702	STR																																		
*	29	7	13'- 0"	1W703	STR																																		
	28	7	18'- 0"	1W704	STR																																		
▲	28	7	28'- 6"	1W705	STR																																		
	37	7	6'- 6"	1W706	17			4'- 6"	2'- 0"																														
▲	37	7	13'- 0"	1W707	STR																																		
▲	26	7	13'- 0"	1W708	STR																																		
▲	28	7	10'- 6"	1W709	STR																																		
▲	26	7	13'- 0"	1W710	STR																																		
*	9	8	7'- 3"	1W801	STR																																		
* ▲	41	10	18'- 0"	1W1001	17			15'- 6"	2'- 6"																														
	12	11	15'- 6"	1W1101	STR																																		
*	13	11	13'- 0"	1W1102	STR																																		

~ NOTES ~

- UNLESS OTHERWISE DESIGNATED, ALL BAR REINFORCEMENT FOR CONCRETE IN SIZES UP TO AND INCLUDING NO. 18 SHALL CONFORM TO THE REQUIREMENTS OF THE "SPECIFICATIONS FOR DEFORMED BILLET-STEEL BARS FOR CONCRETE REINFORCEMENT", AASHTO M 31 (ASTM A 615-S). ALL BARS SHALL BE GRADE 60, UNLESS OTHERWISE DESIGNATED.
- FOR TYPICAL BENDING DETAILS, RECOMMENDED PIN DIAMETER "D" OF BENDS AND HOOKS, AND OTHER STANDARD PRACTICE, SEE CURRENT CONCRETE REINFORCING STEEL INSTITUTE "MANUAL OF STANDARD PRACTICE".
- BARS WHICH REQUIRE MORE ACCURATE BENDING THAN STANDARD PRACTICES SHOULD HAVE LIMITS INDICATED.
- ALL DIMENSIONS ARE OUT TO OUT OF BAR EXCEPT "A" AND "G" ON STANDARD 180 DEGREE AND 135 DEGREE HOOKS.
- "J" DIMENSION ON 180 DEGREE HOOKS TO BE SHOWN ONLY WHERE NECESSARY TO RESTRICT HOOK SIZE. OTHERWISE, STANDARD HOOKS ARE TO BE USED.
- "H" DIMENSION ON STIRRUPS TO BE SHOWN ONLY WHEN NECESSARY TO MAINTAIN CLEARANCES.
- WHERE SLOPE DIFFERS FROM 45 DEGREES, DIMENSIONS "H" AND "K" MUST BE SHOWN.
- ▲ DENOTES BARS TO BE CUT IN FIELD.
- * DENOTES ONE EXTRA BAR ADDED FOR TESTING PURPOSES.
- △ DENOTES TWO EXTRA BARS ADDED FOR TESTING PURPOSES.
- E IN BAR MARK PREFIX DENOTES EPOXY COATED REINFORCING STEEL.

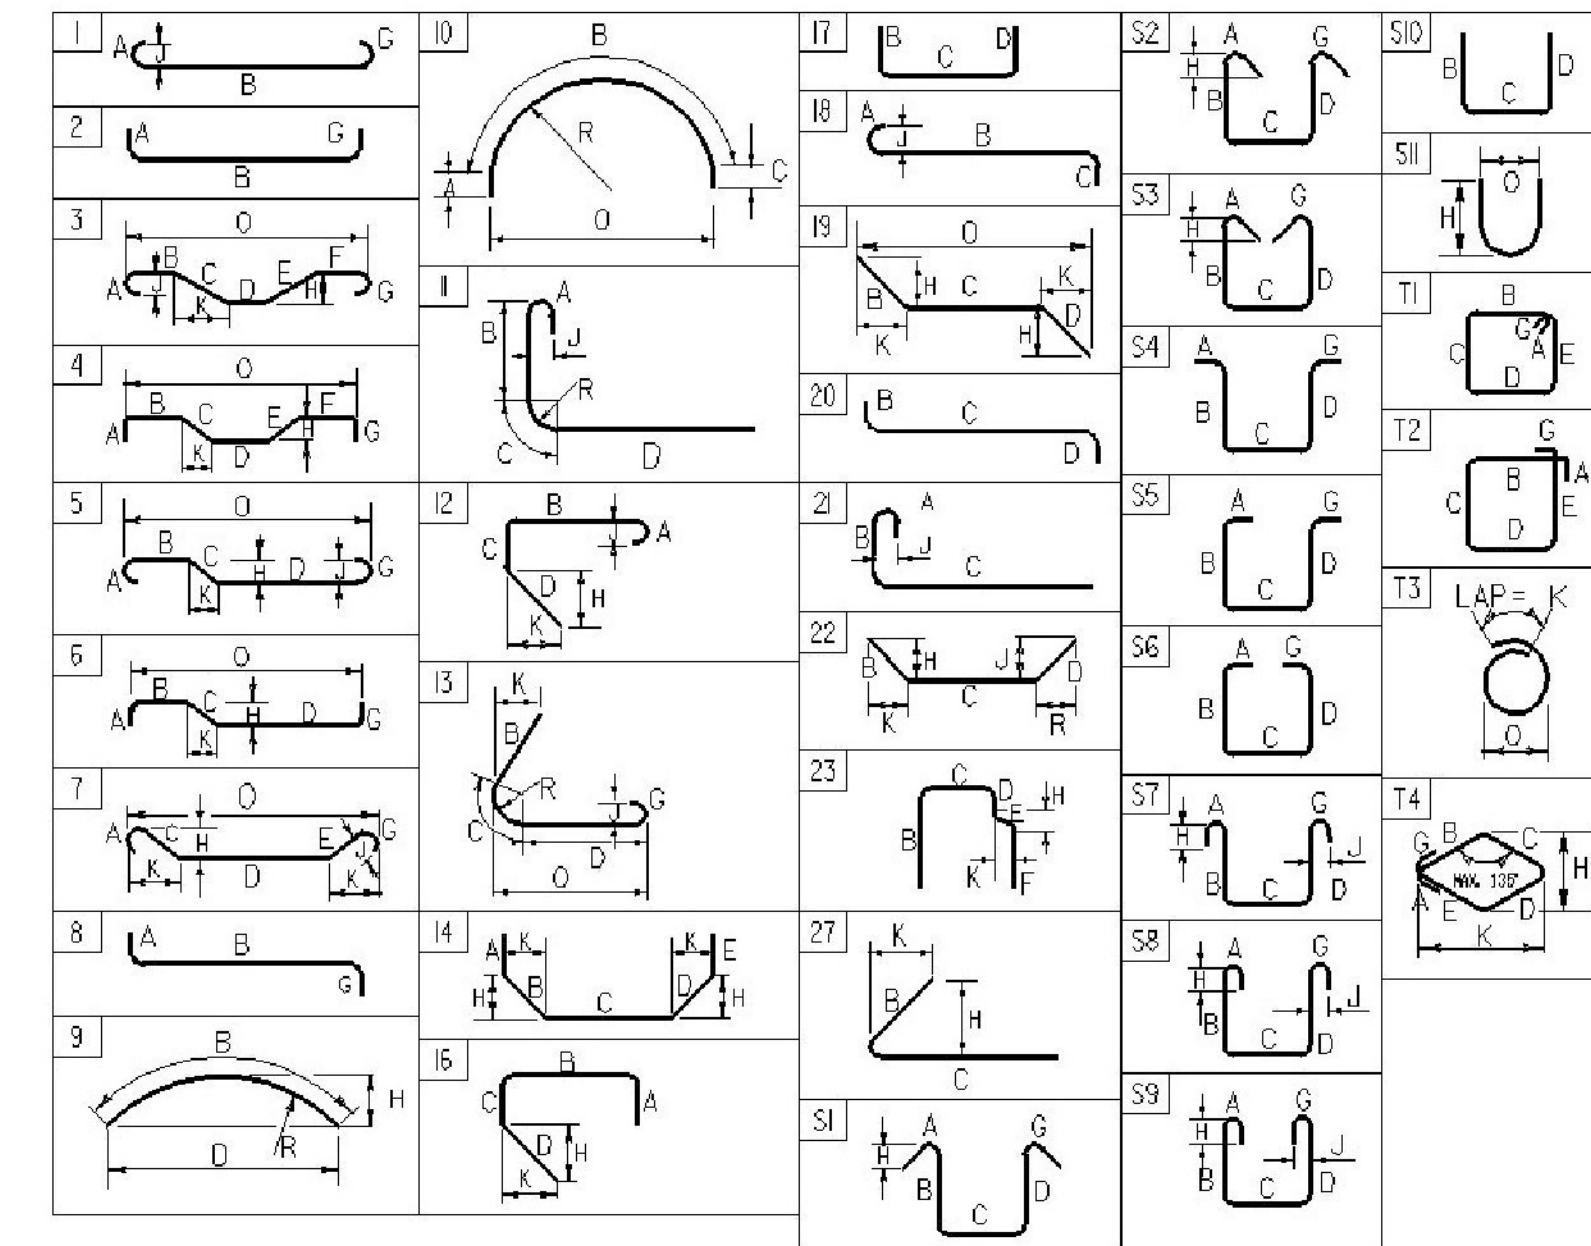

**ASTM STANDARD REINFORCING BARS**

BAR SIZE DESIGNATION	WEIGHT POUNDS PER FOOT	NOMINAL DIMENSIONS ROUND SECTION		
		DIAMETER INCHES	AREA INCHES ²	PERIMETER INCHES
#3	0.376	0.375	0.11	1.178
#4	0.668	0.500	0.20	1.571
#5	1.043	0.625	0.31	1.963
#6	1.502	0.750	0.44	2.356
#7	2.044	0.875	0.60	2.749
#8	2.670	1.000	0.79	3.142
#9	3.400	1.128	1.00	3.544
#10	4.303	1.270	1.27	3.990
#11	5.313	1.410	1.56	4.430
#14	7.65	1.693	2.25	5.32
#18	13.60	2.257	4.00	7.09

PROJECT NAME: PERU  
PROJECT NUMBER: STP SCRP(4)






FILE NAME: z07b106r.s.dgn  
PROJECT LEADER: E. ATKINS  
DESIGNED BY: B. KHALIFA  
REINFORCING STEEL SCHEDULE

PLOT DATE: 12/31/2014  
DRAWN BY: M. BRADLEY  
CHECKED BY: M. CRUZ  
SHEET 13 OF 45

GPS CONTROL POINTS






This Project has Assumed Horizontal and Vertical Datums

TRAVERSE TIES

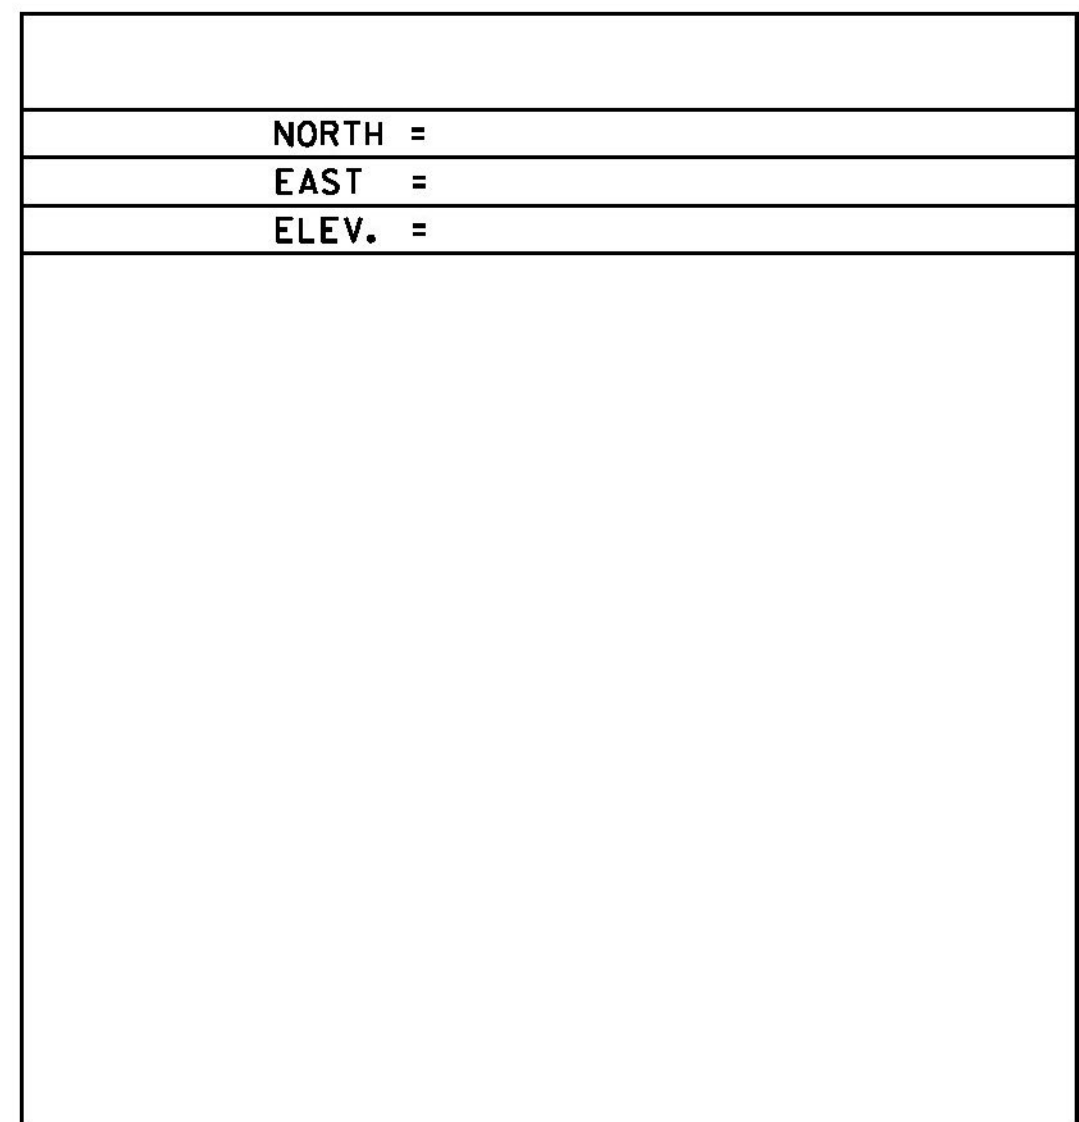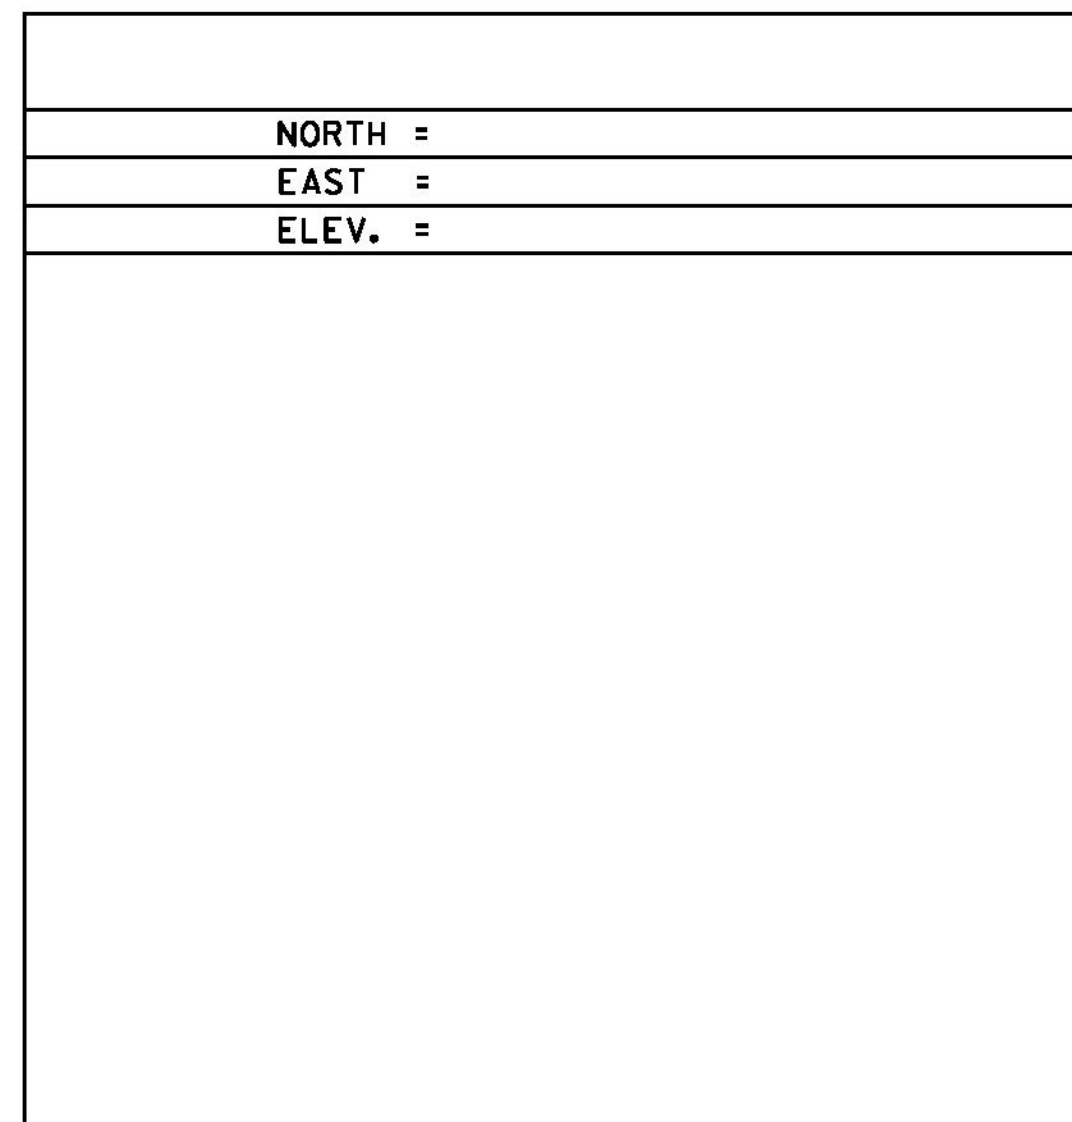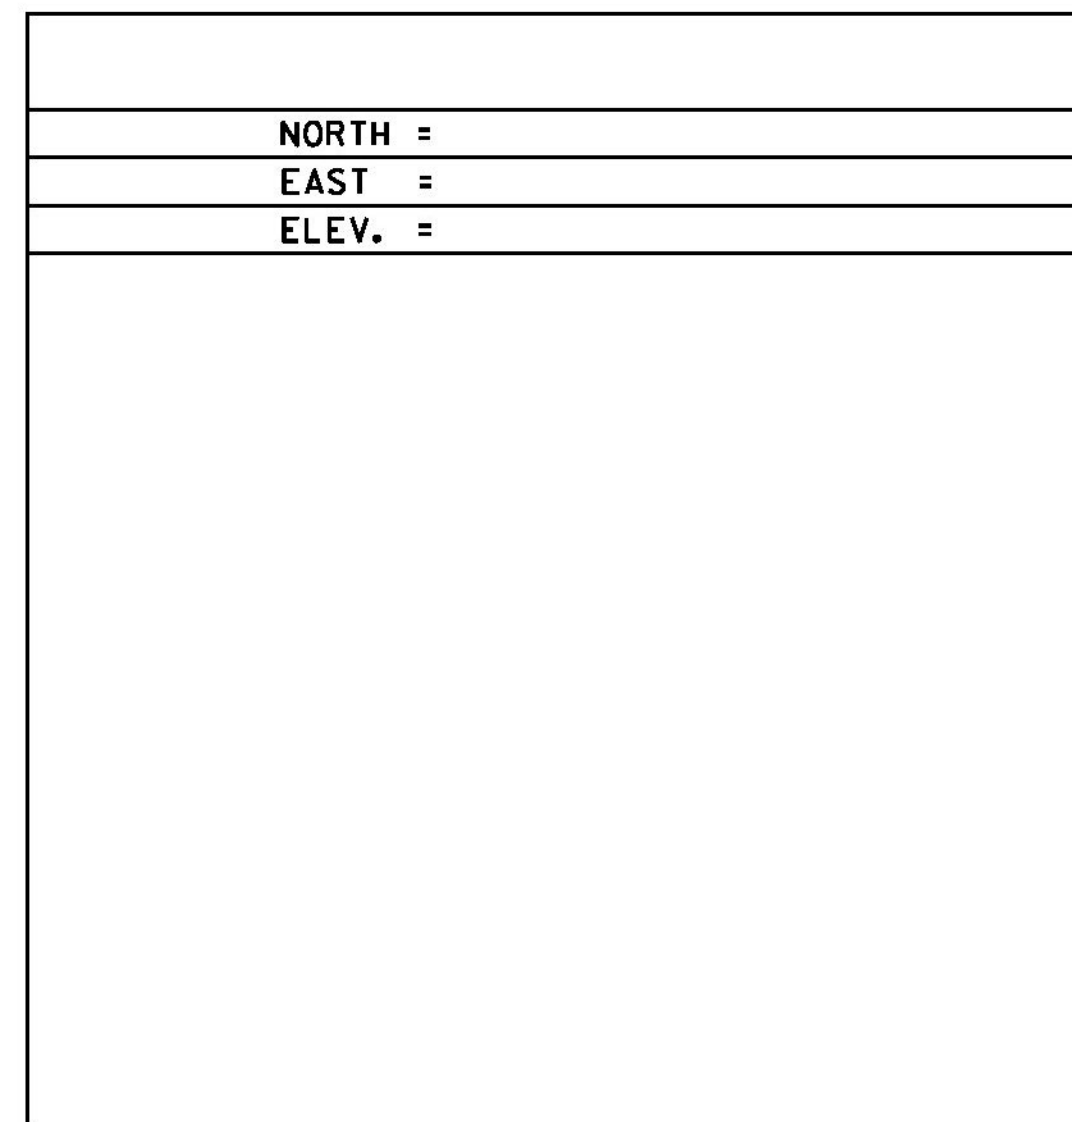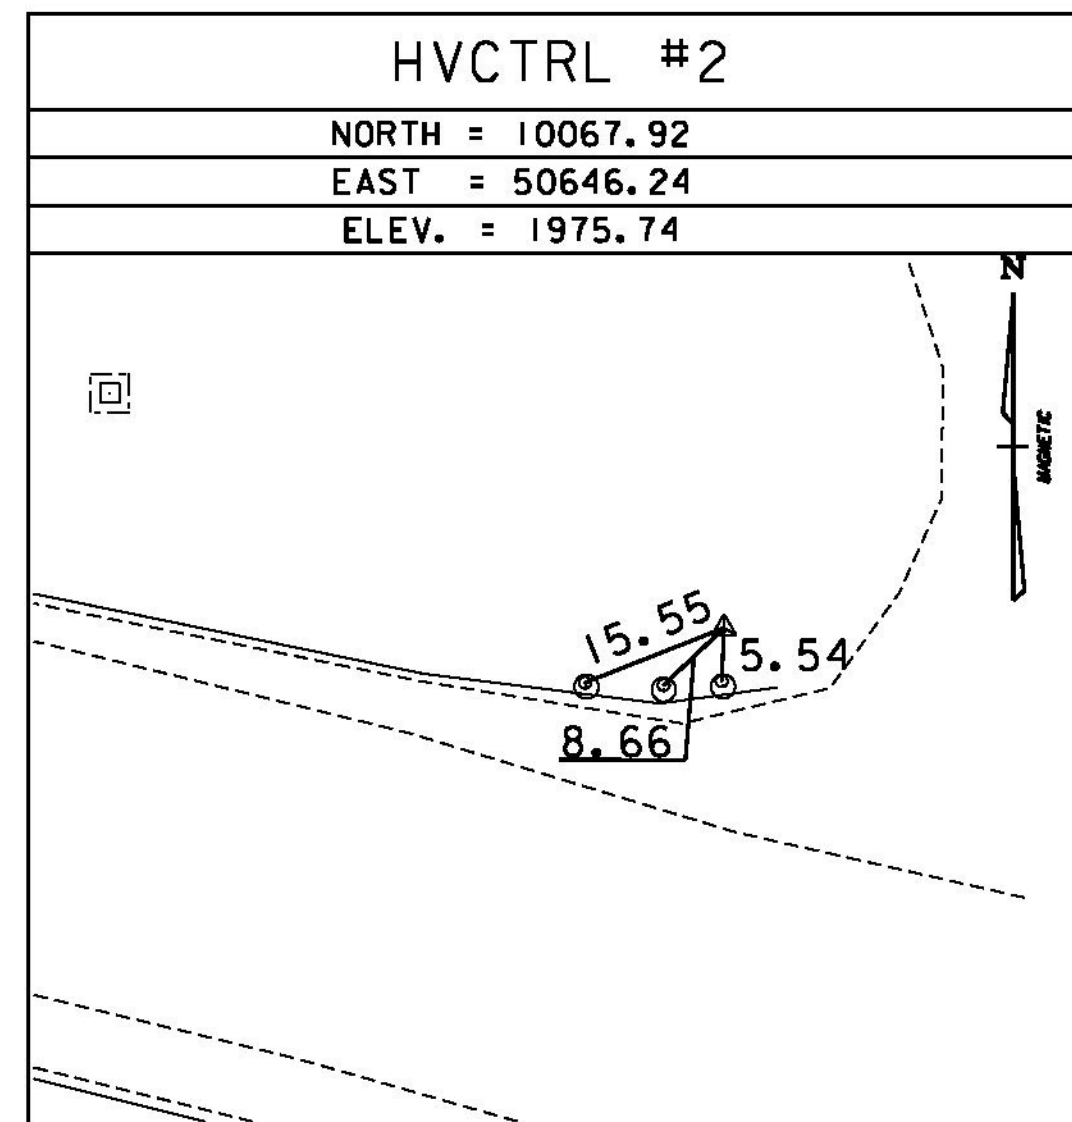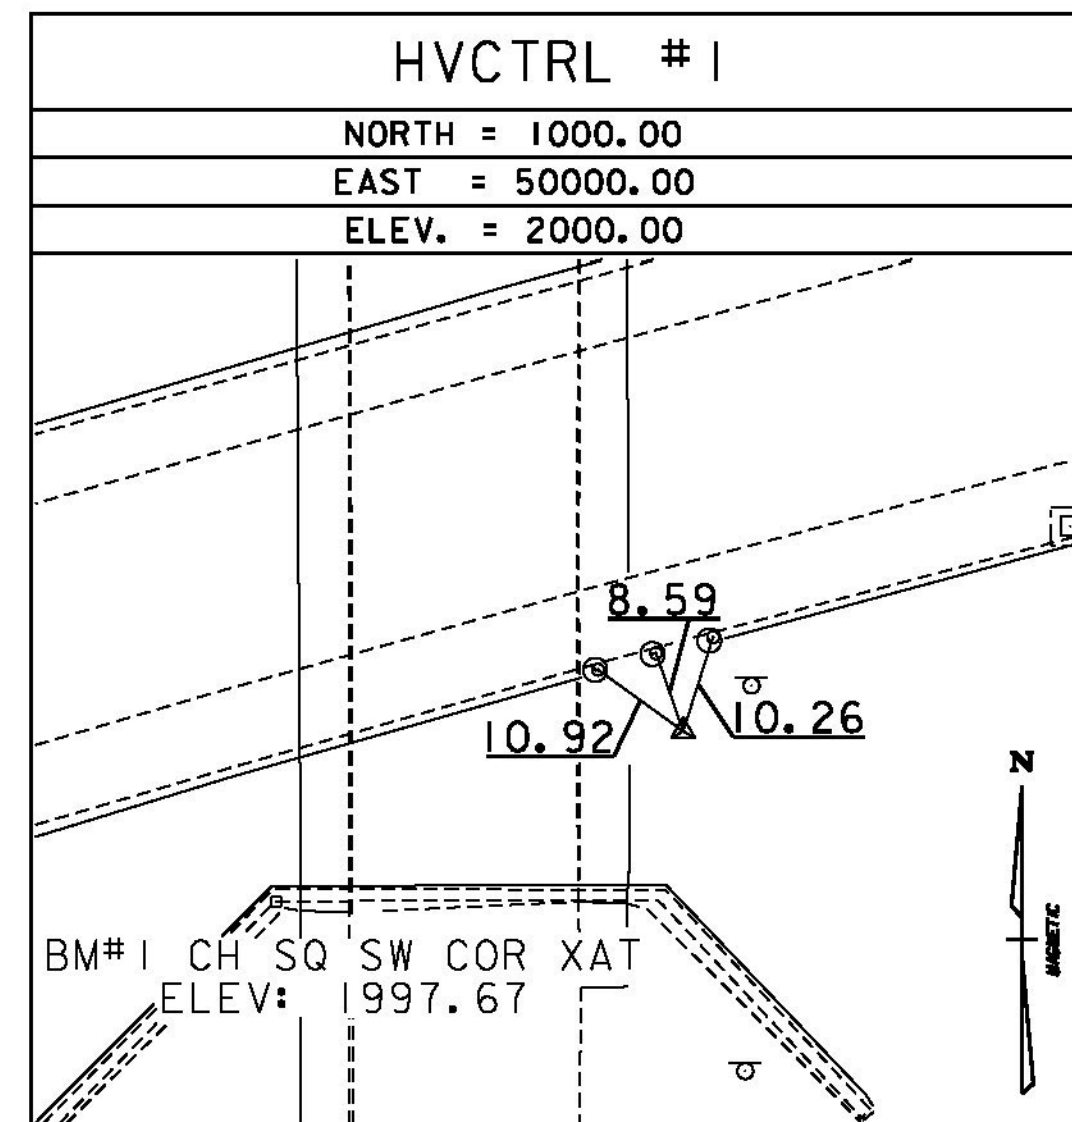


* Main Traverse Completed 5/29/08 L. ORVIS PC/R. BULLOCK/C. CYR/R. BOCKUS

ALIGNMENT TIES

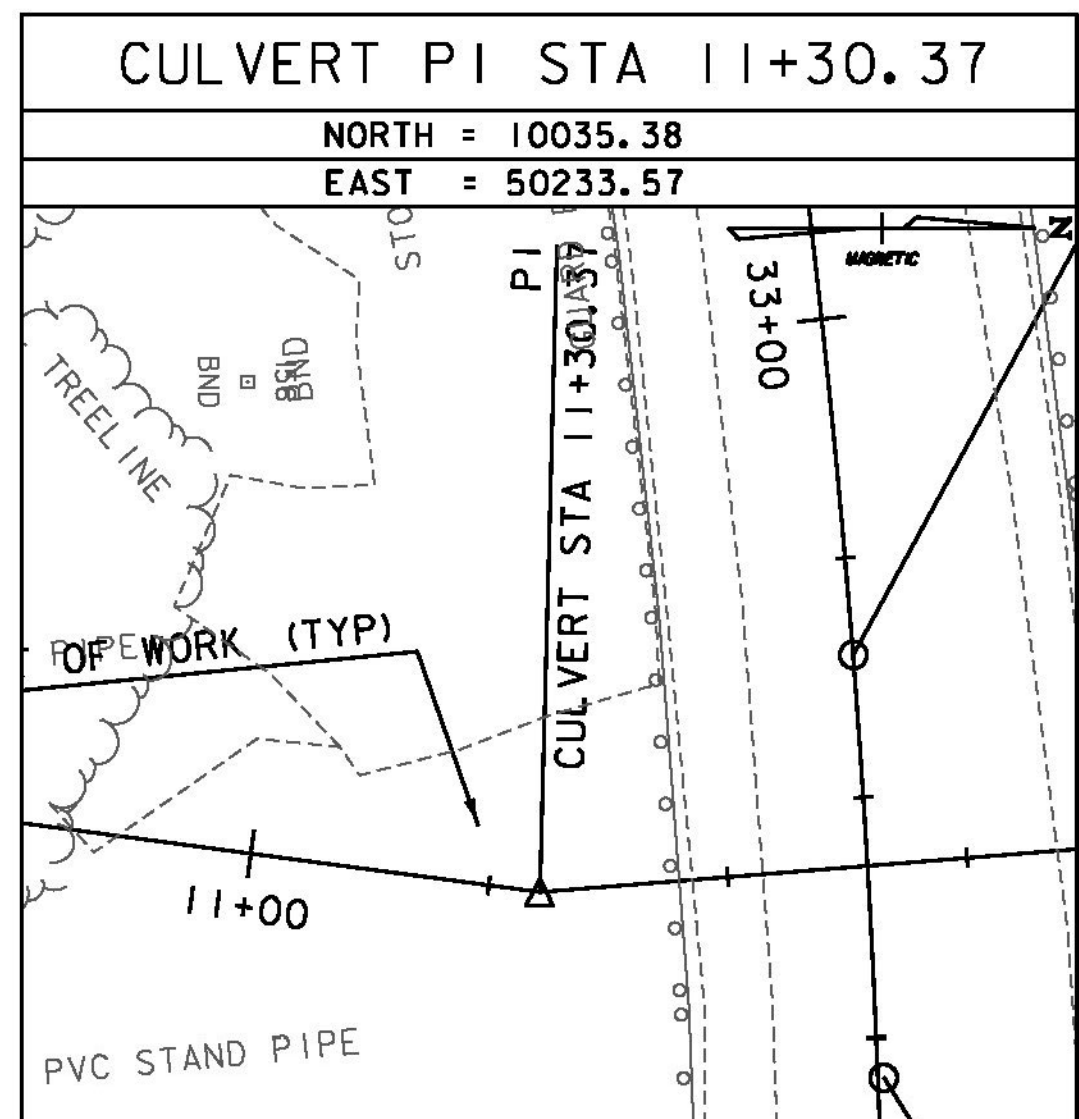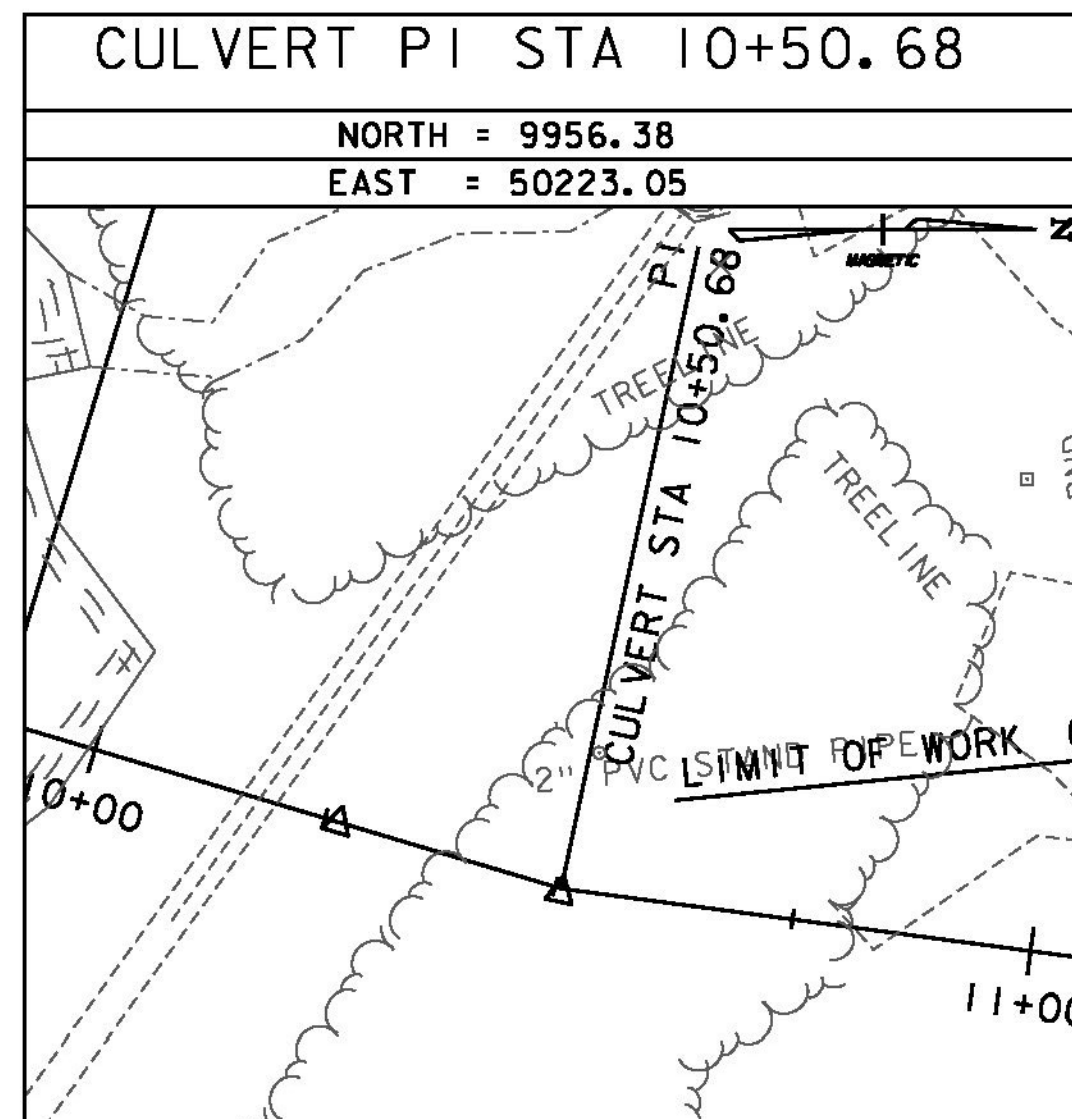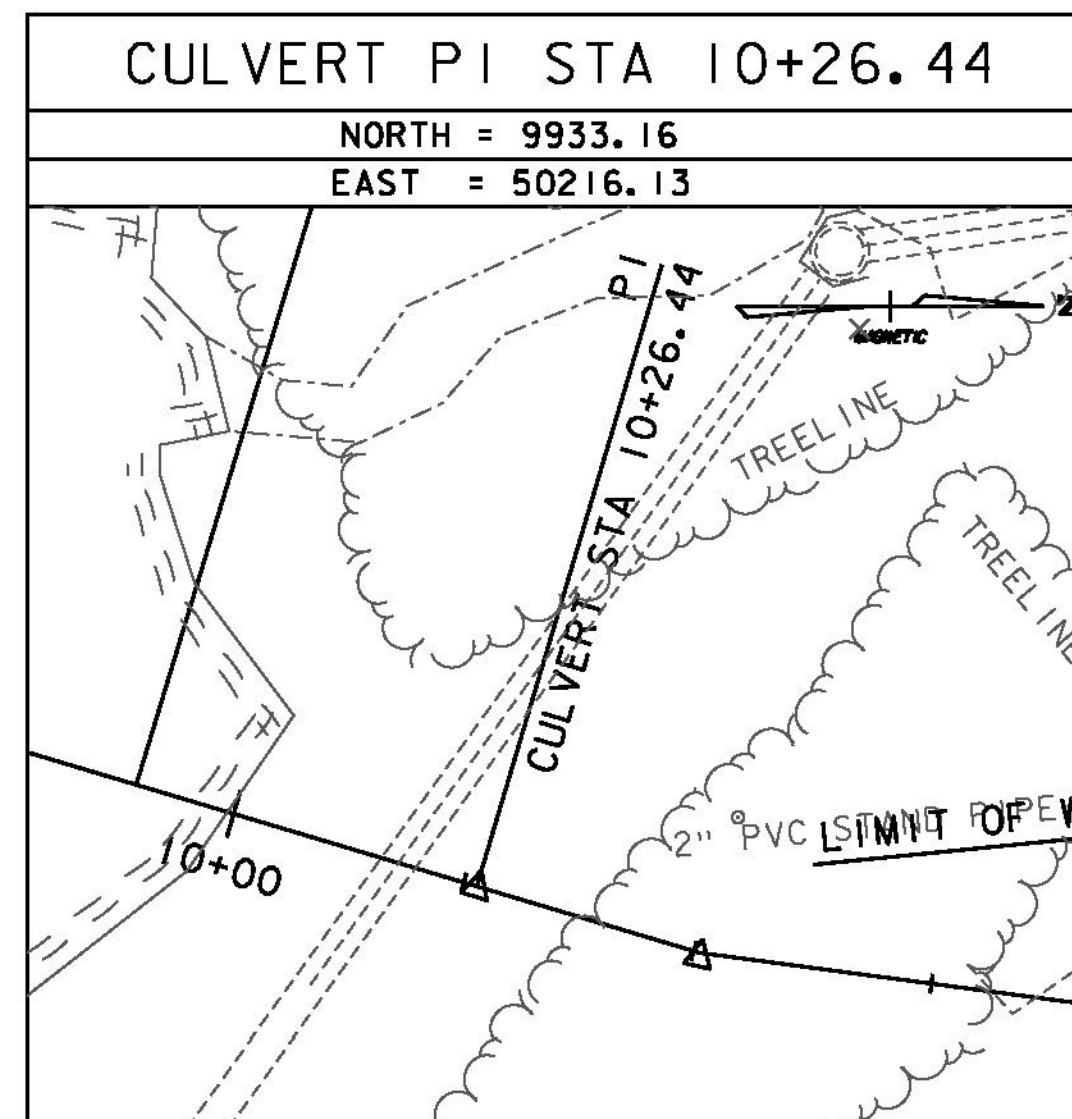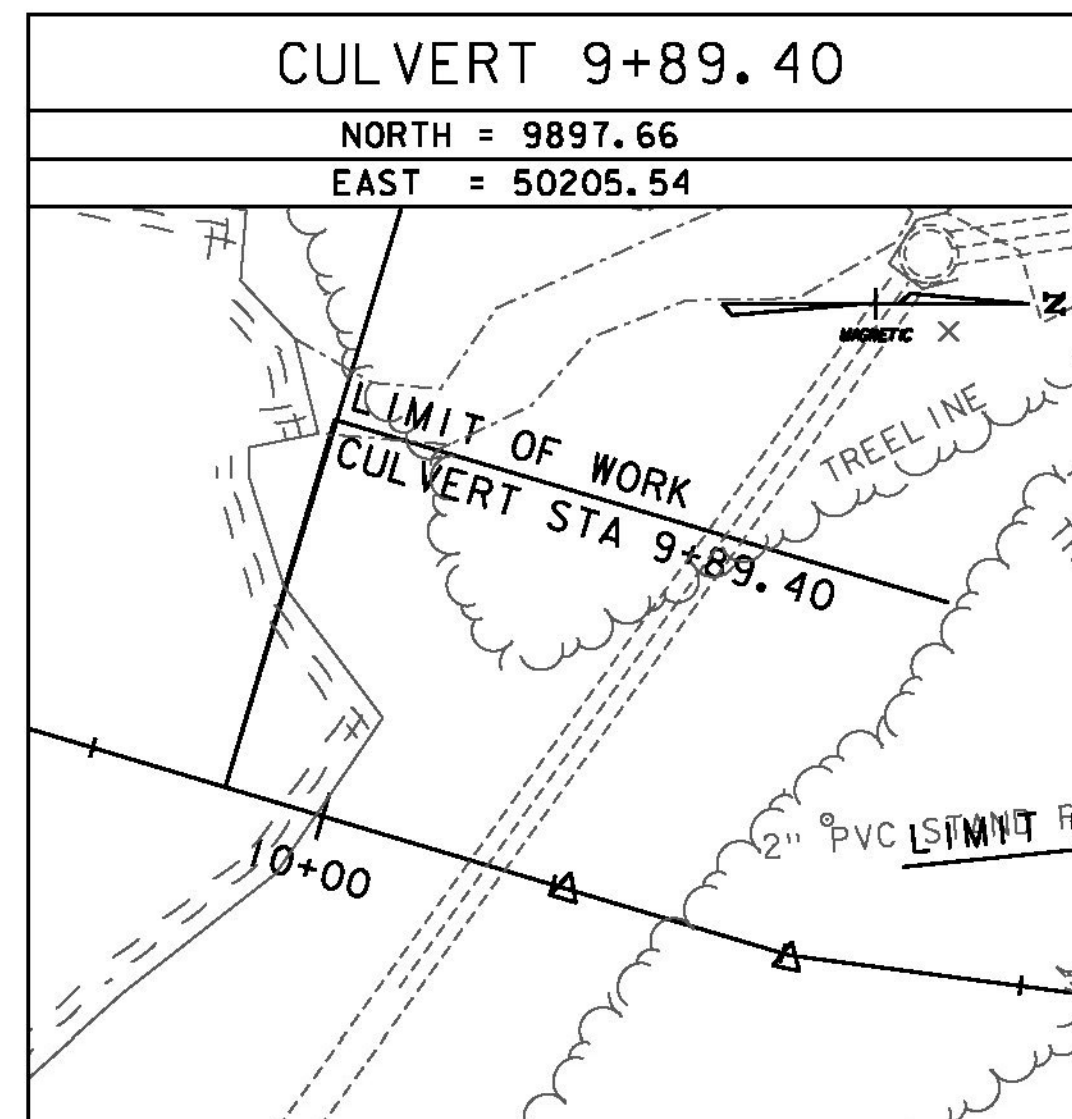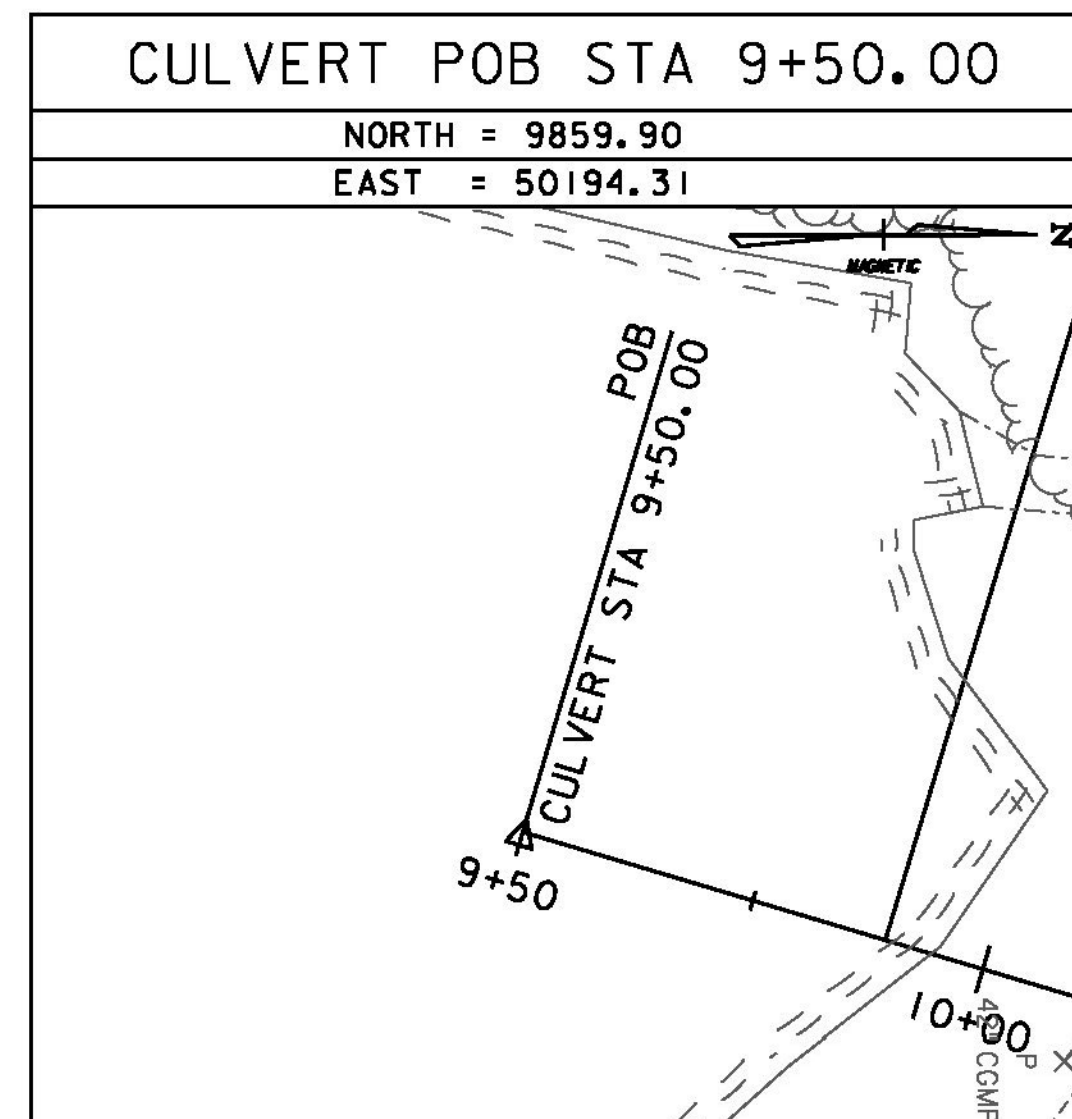






DATUM	
VERTICAL	ASSUMED
HORIZONTAL	ASSUMED
ADJUSTMENT	NONE

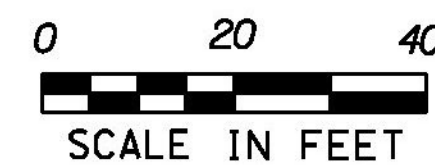






GREEN INTERNATIONAL AFFILIATES, INC.  
CIVIL AND STRUCTURAL ENGINEERS

PROJECT NAME:	PERU	PLOT DATE:	12/31/2014
PROJECT NUMBER:	STP SCR(4)	DRAWN BY:	C. MORIN
FILE NAME:	z07bi06f1.dgn	CHECKED BY:	E. ATKINS
PROJECT LEADER:	E. ATKINS	TIE SHEET 1	SHEET 14 OF 45
DESIGNED BY:	M. BRADLEY		






ALIGNMENT TIES

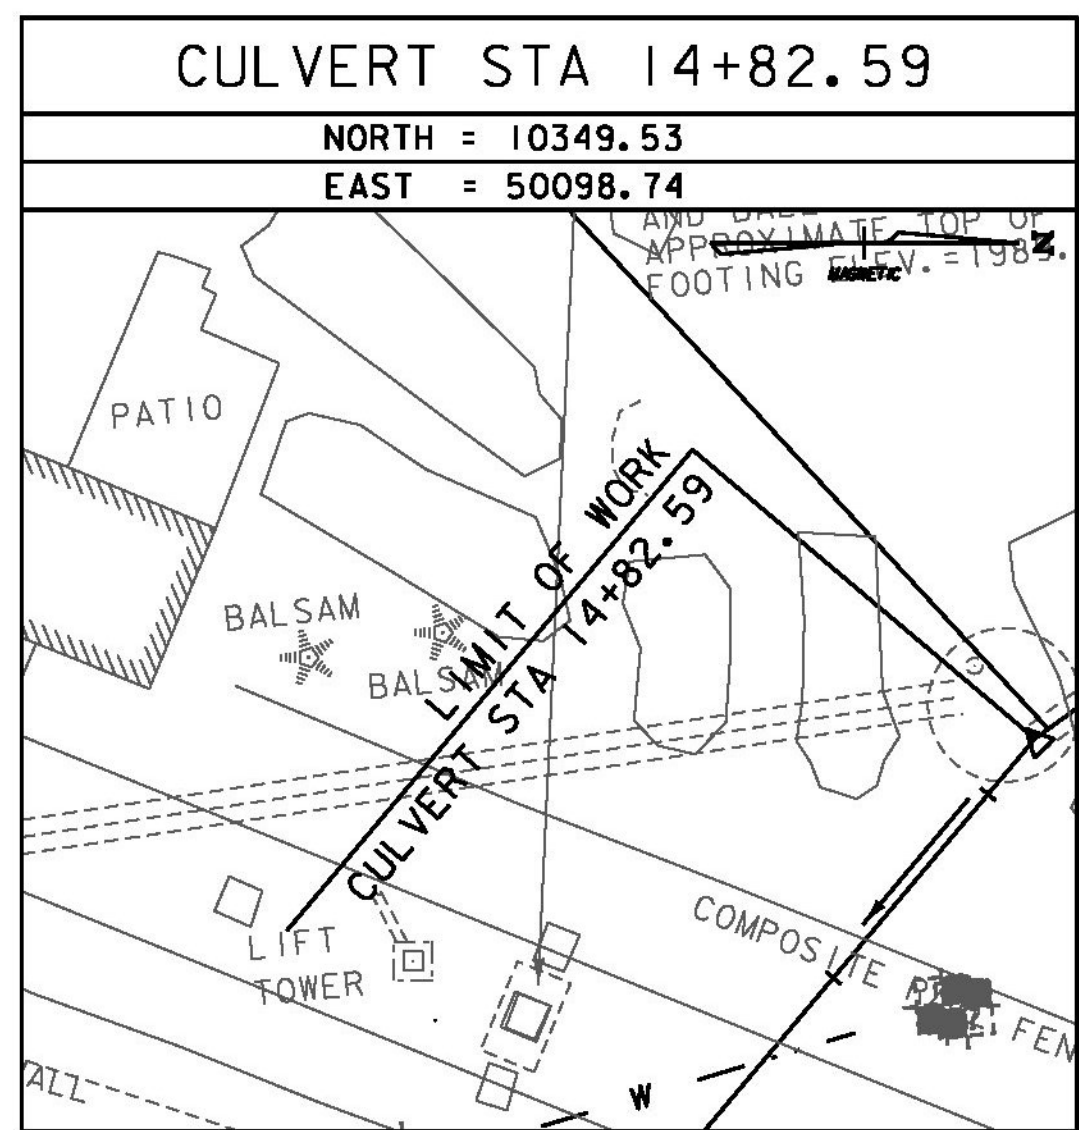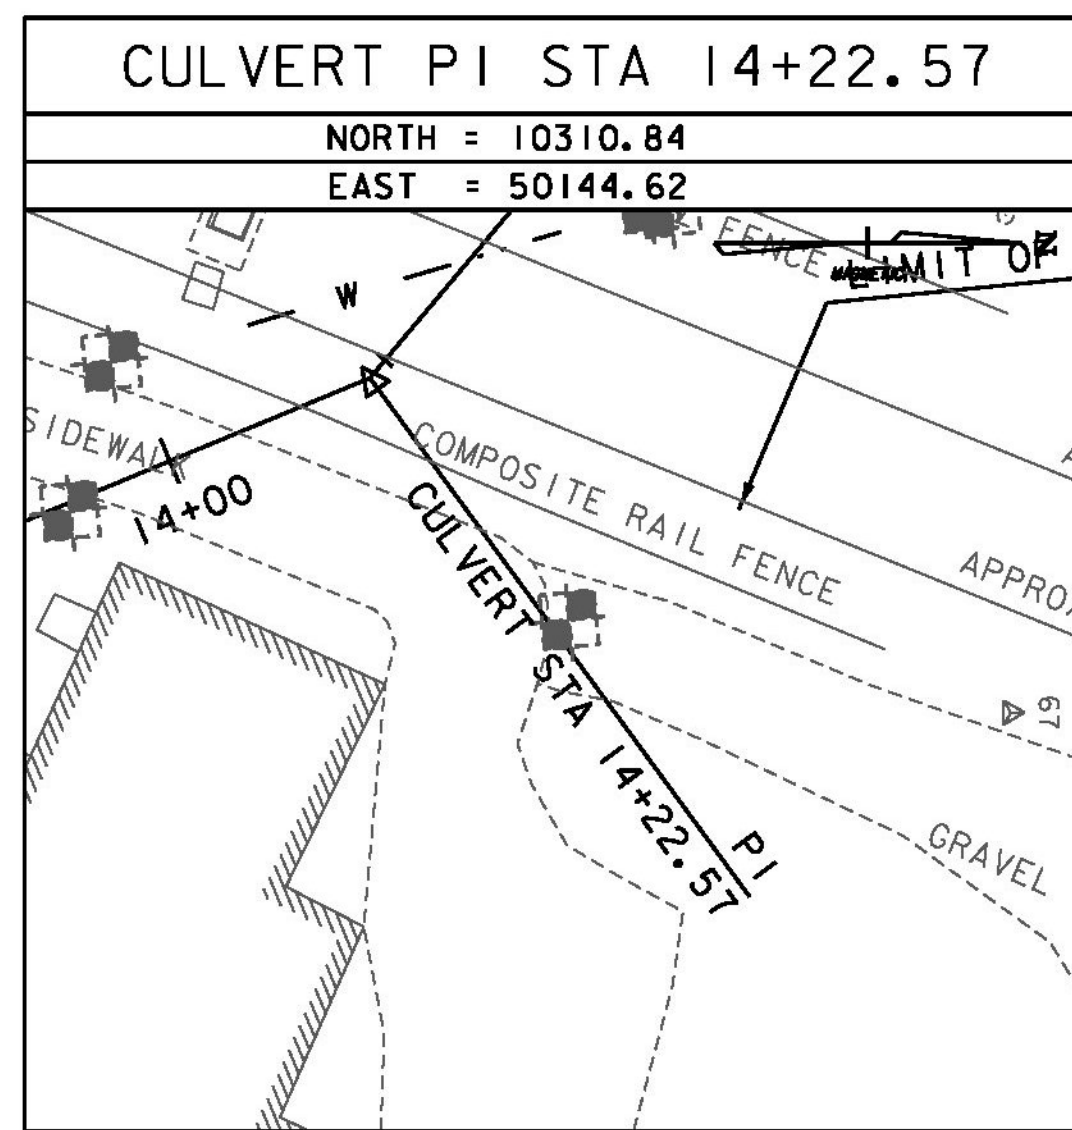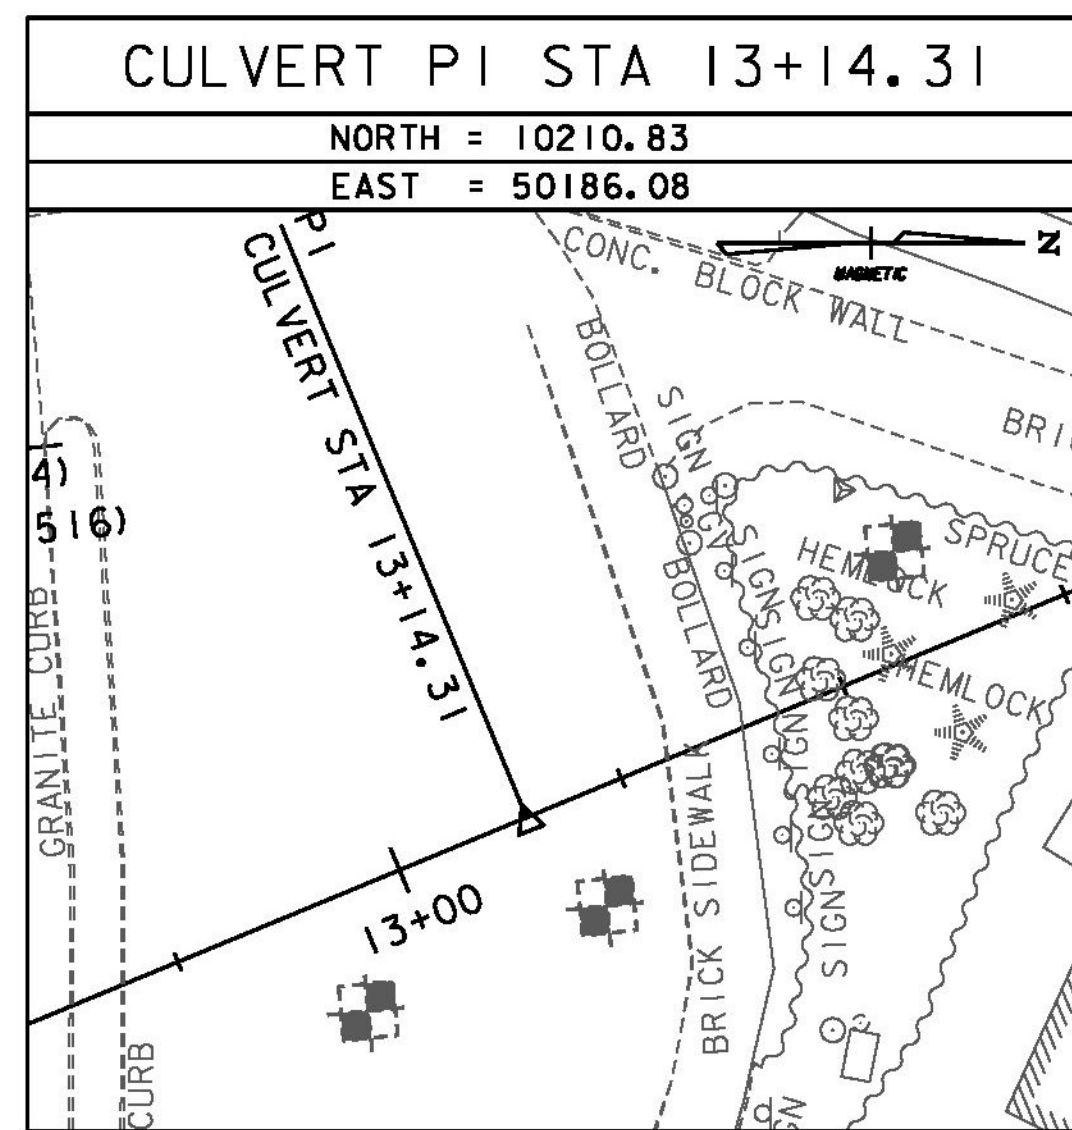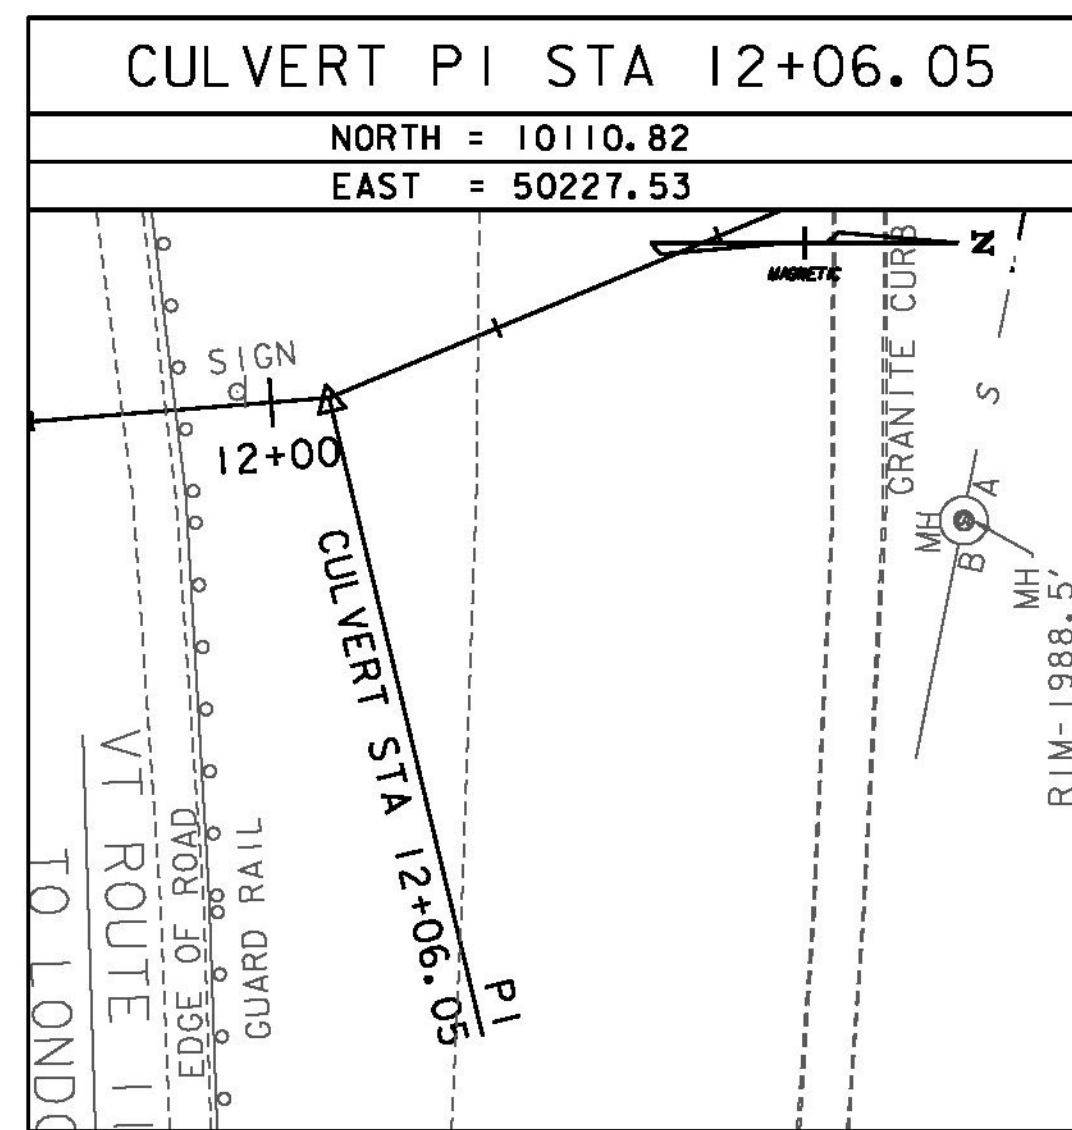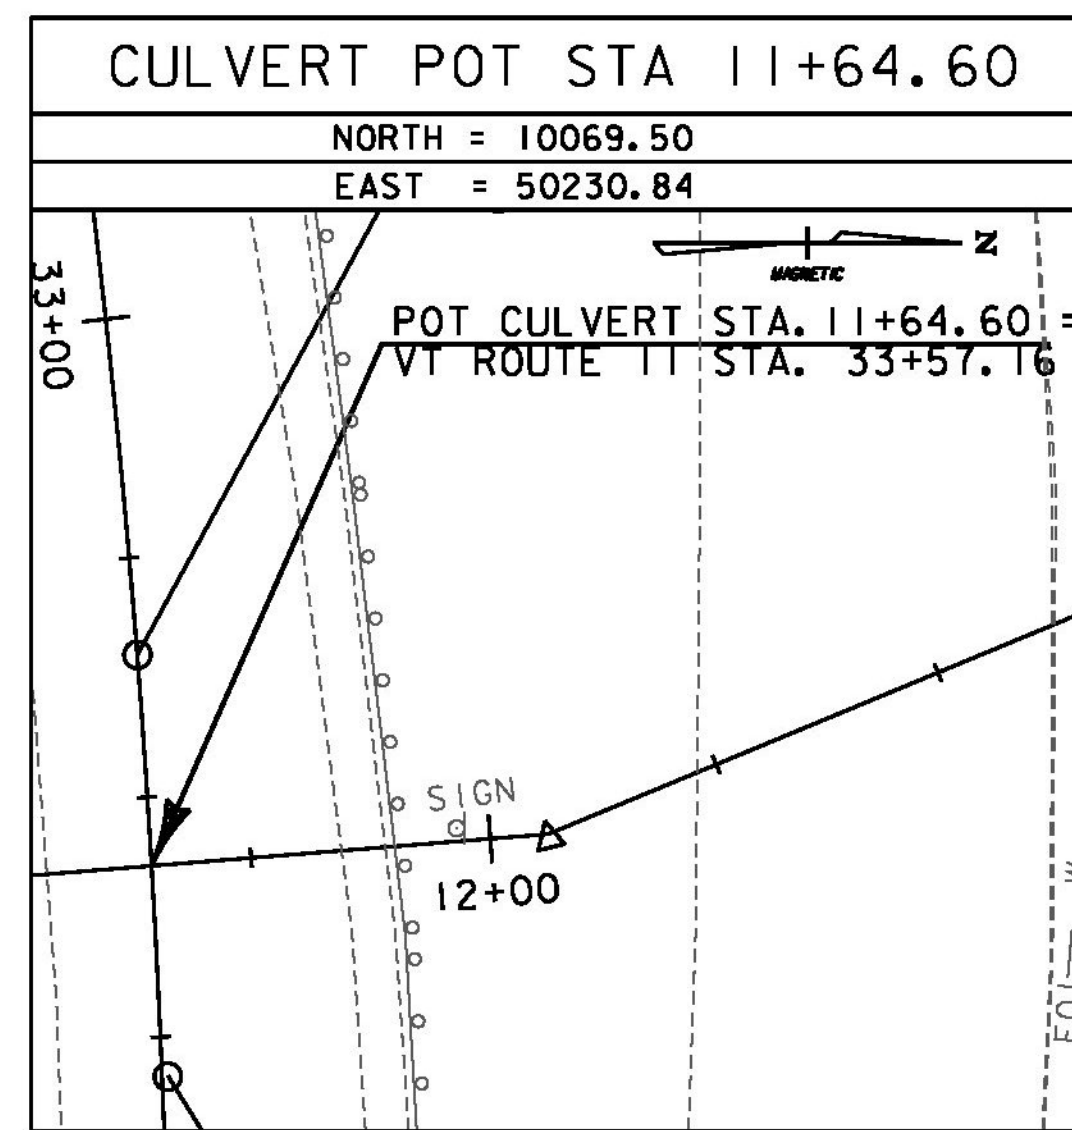


ALIGNMENT TIES

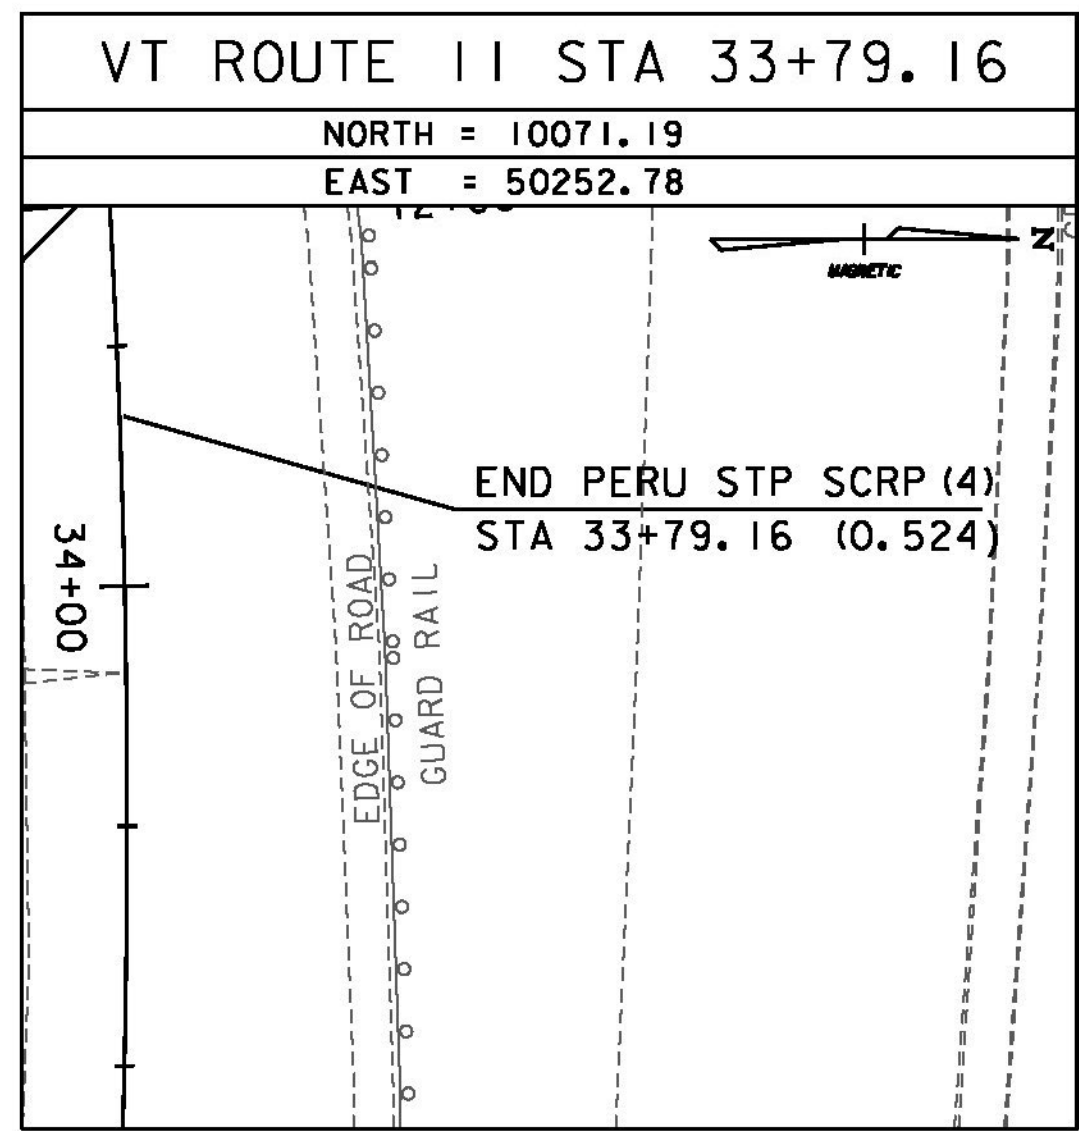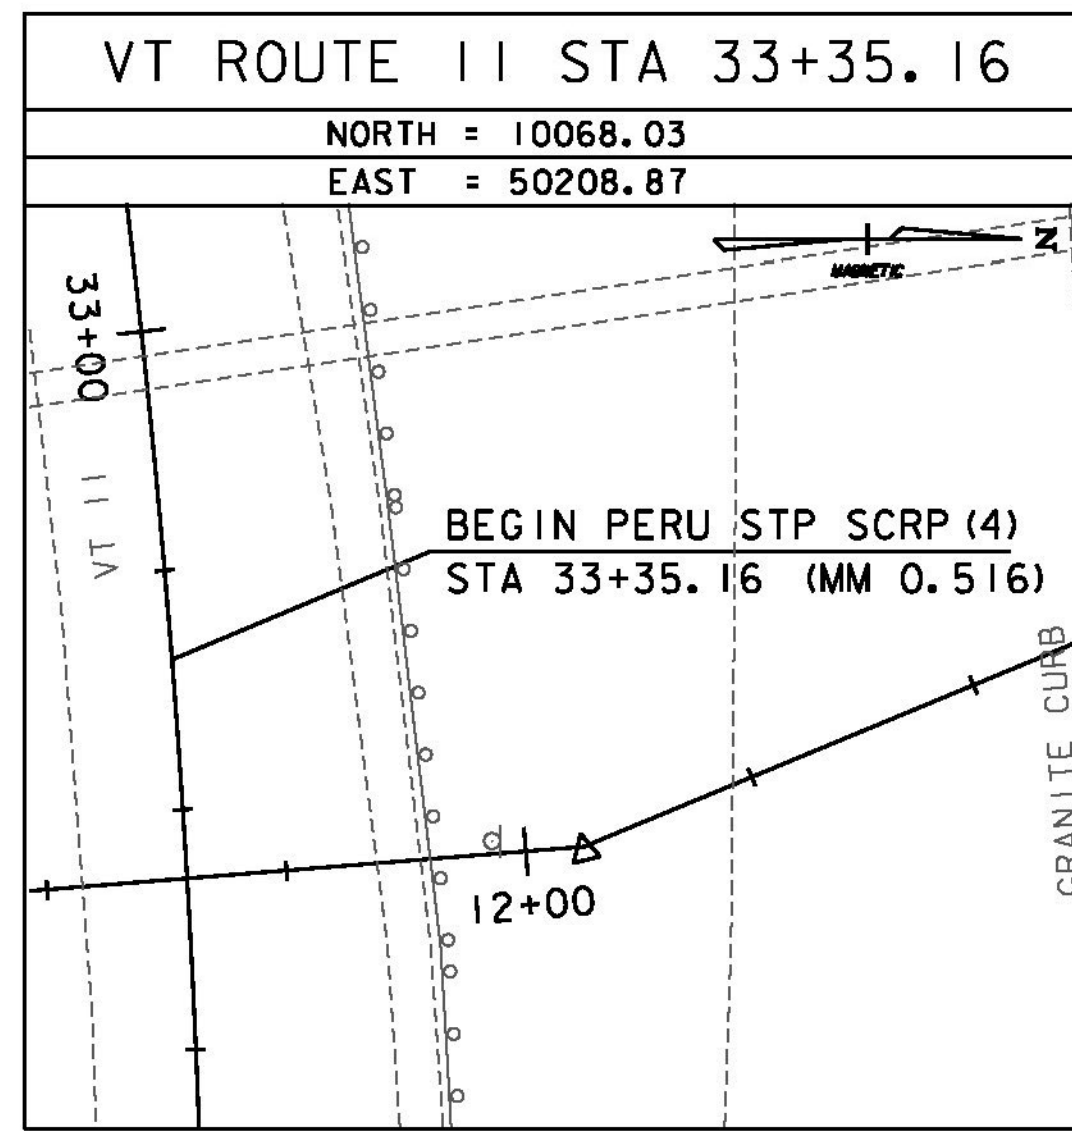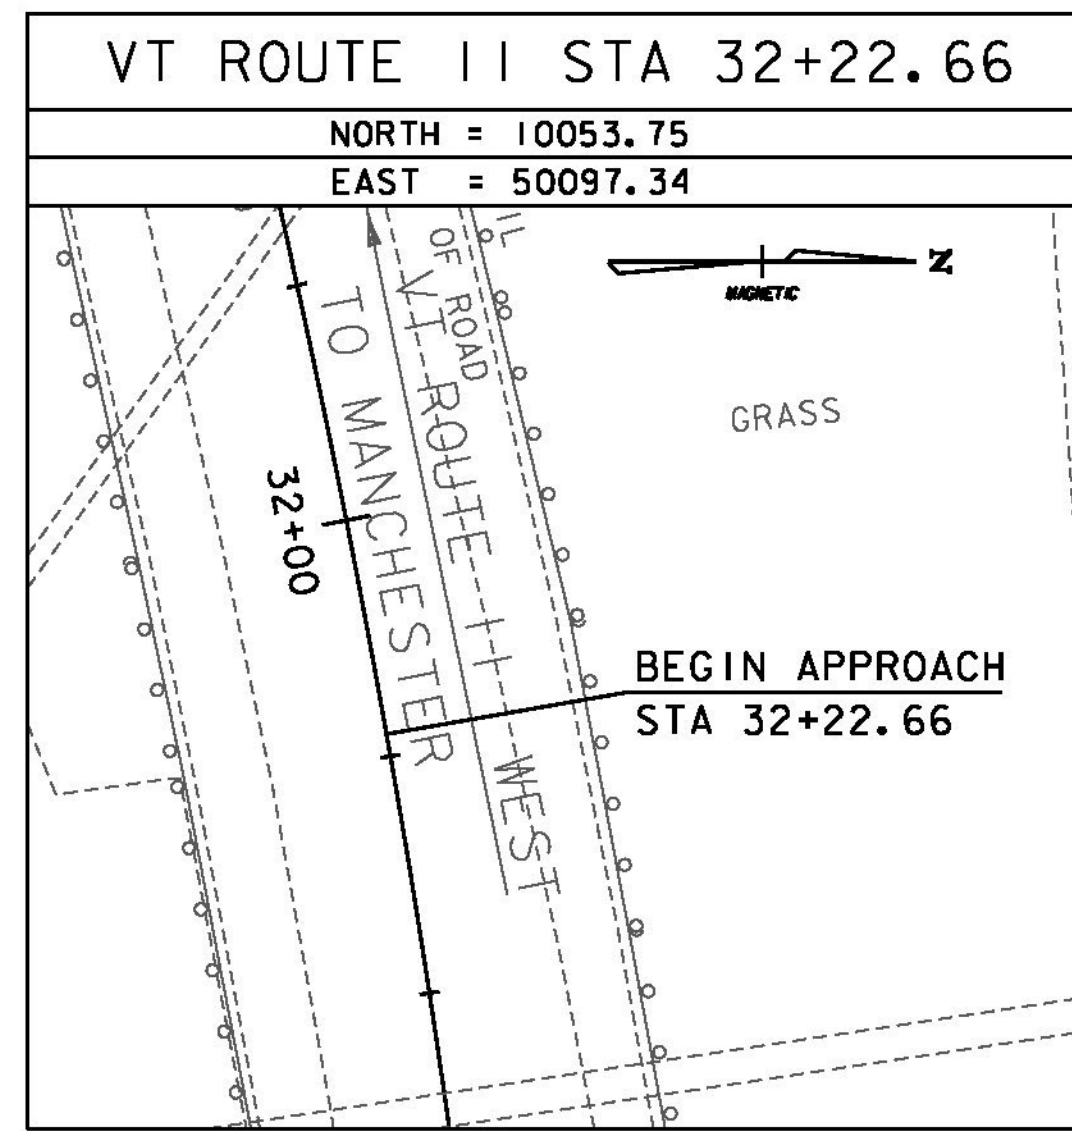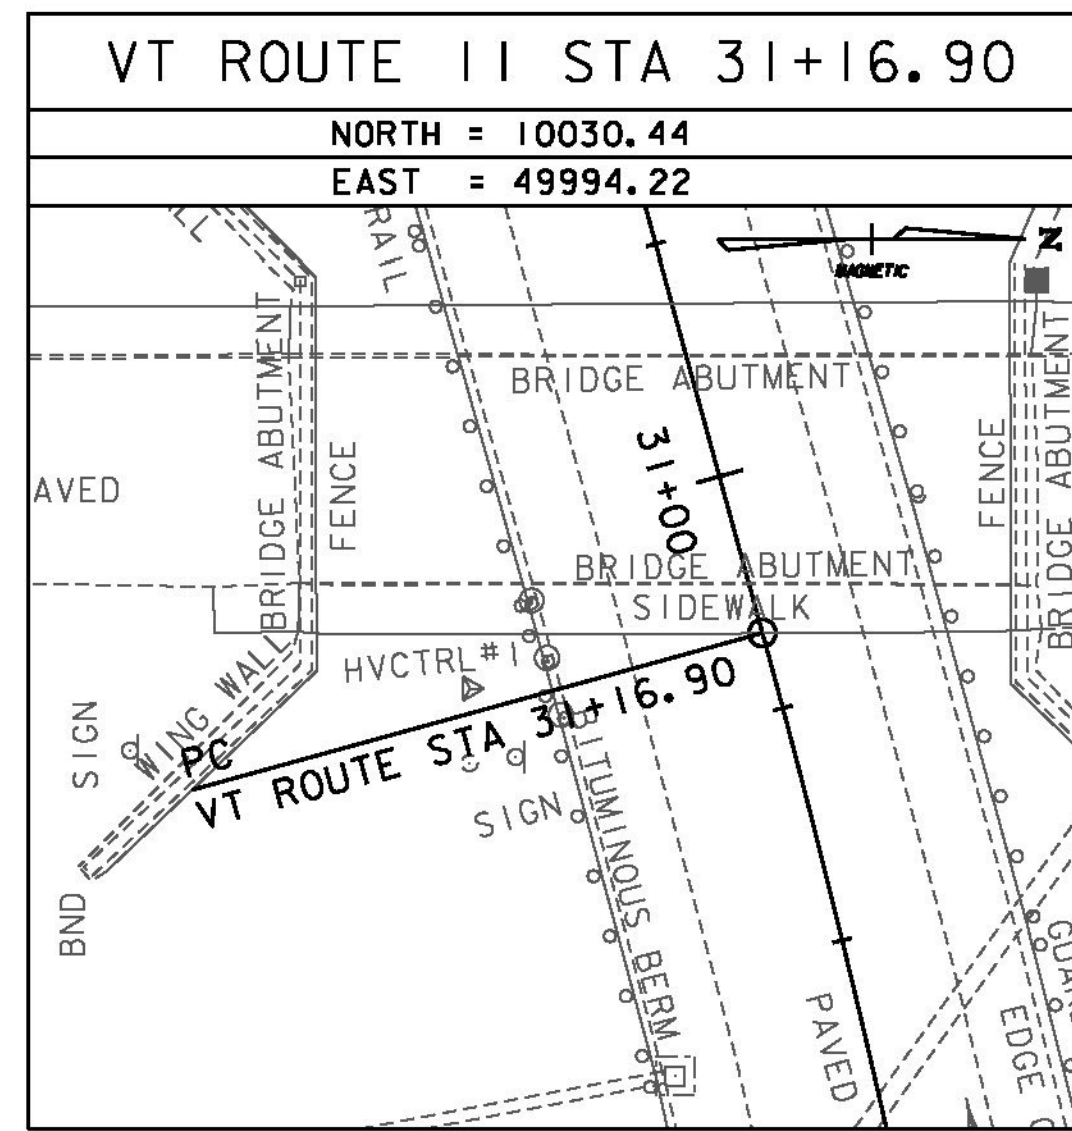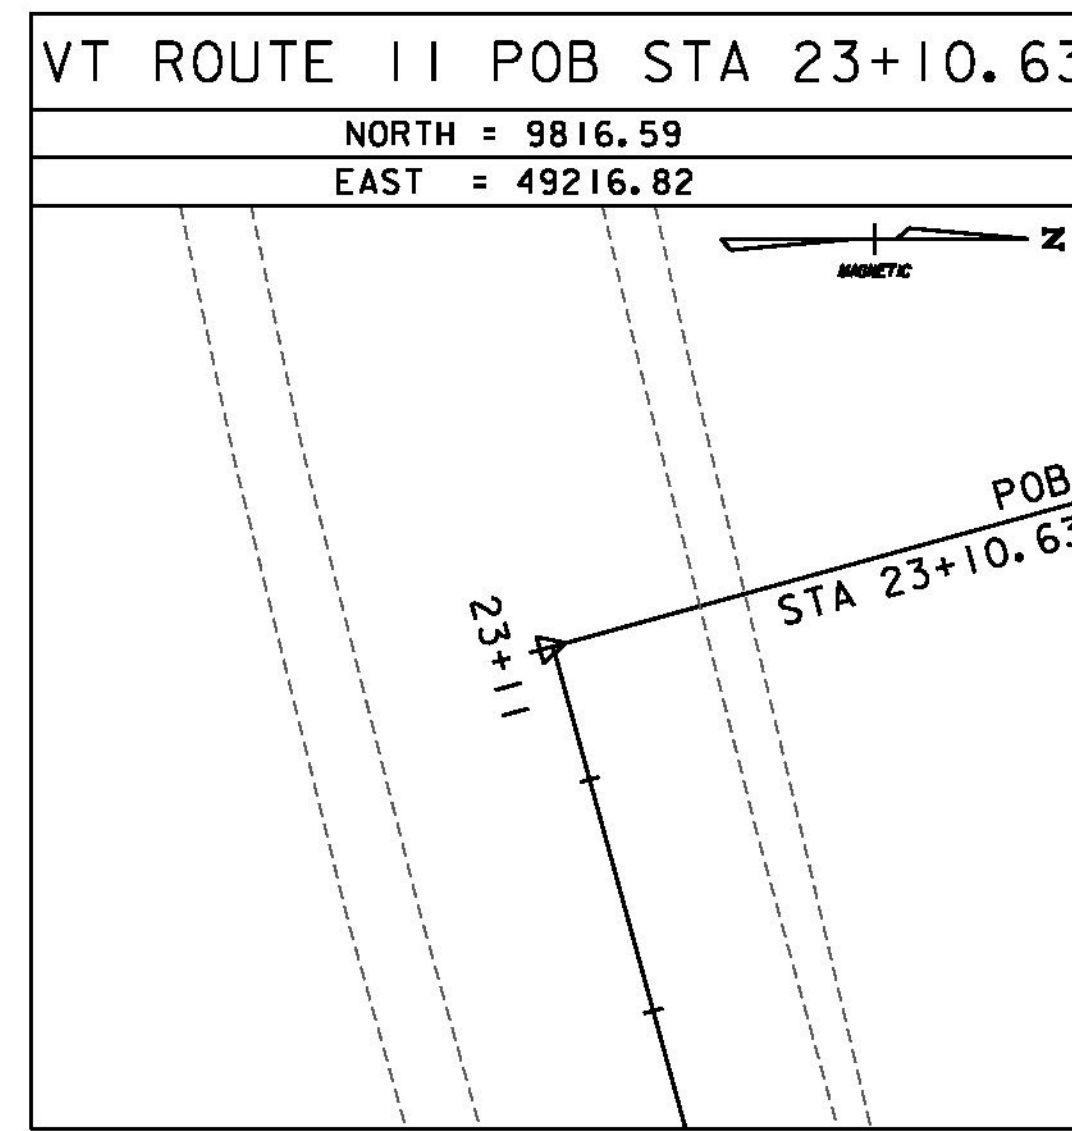

ALIGNMENT TIES

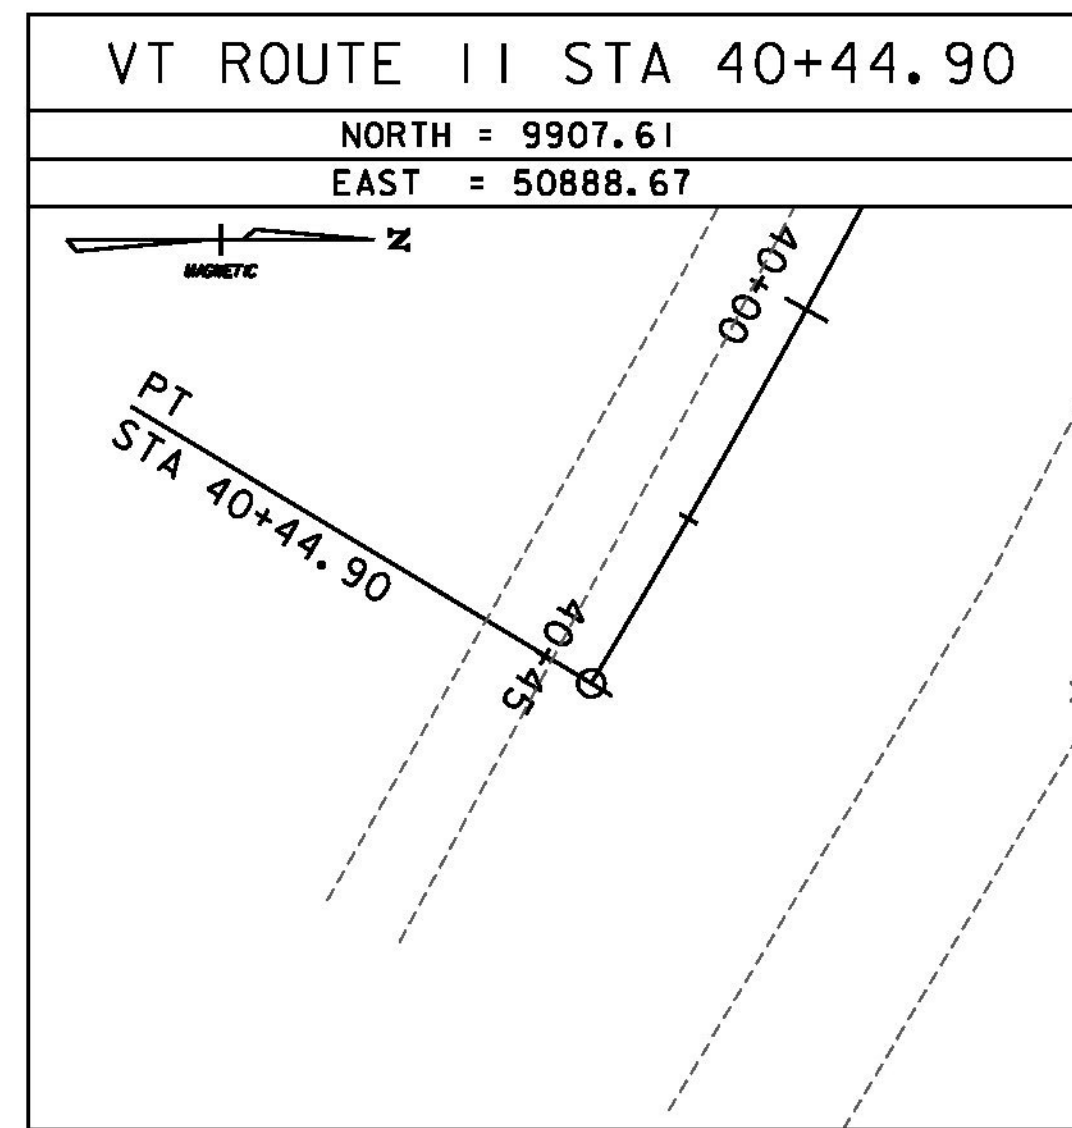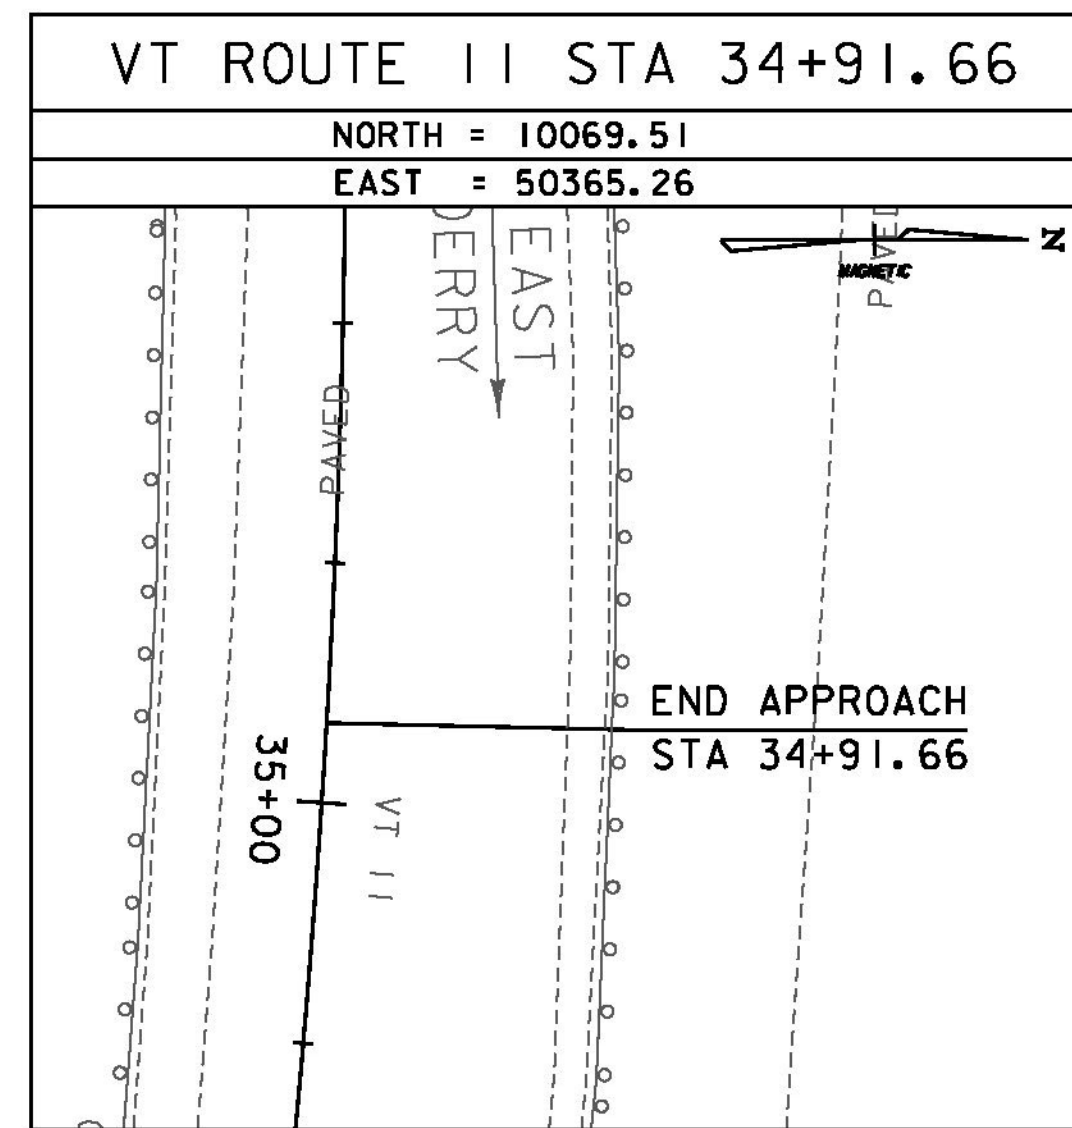   

DATUM	
VERTICAL	ASSUMED
HORIZONTAL	ASSUMED
ADJUSTMENT	NONE

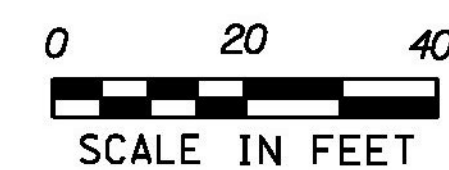

GREEN INTERNATIONAL AFFILIATES, INC.  
CIVIL AND STRUCTURAL ENGINEERS

PROJECT NAME: PERU  
PROJECT NUMBER: STP SCR(4)




FILE NAME: z07bi06t1.dgn  
PROJECT LEADER: E. ATKINS  
DESIGNED BY: M. BRADLEY  
TIE SHEET 2

PLOT DATE: 12/31/2014  
DRAWN BY: C. MORIN  
CHECKED BY: E. ATKINS  
SHEET 15 OF 45

ALIGNMENT TABLE


CULVERT						
ELEMENT	POINT	STATION	NORTHING	EASTING	LENGTH	BEARING/RADIUS
	POB	9+50.00	9859.8965	50194.3068		
LINEAR					76.44	N 16°35'26.44" E
	PI	10+26.44	9933.1573	50216.1347		
LINEAR					24.23	N 16°35'21.38" E
	PI	10+50.68	9956.3818	50223.0535		
LINEAR					79.69	N 7°34'54.37" E
	PI	11+30.37	10035.3795	50233.5684		
LINEAR					75.68	N 4°34'35.63" W
	PI	12+06.05	10110.8183	50227.5298		
LINEAR					216.52	N 22°30'48.66" W
	PI	14+22.57	10310.8359	50144.6245		
LINEAR					60.02	N 49°51'49.76" W
	PI	14+82.59	10349.5270	50098.7337		

VT ROUTE 11						
ELEMENT	POINT	STATION	NORTHING	EASTING	LENGTH	BEARING/RADIUS
	POB	23+1-.63	9816.5915	49216.8240		
LINEAR					806.27	N 74°37'09.35" E
	PC	31+16.90	10030.4401	49994.2172		
CURVE					928.00	1145.92'
	PT	40+44.90	9907.6102	50888.6713		

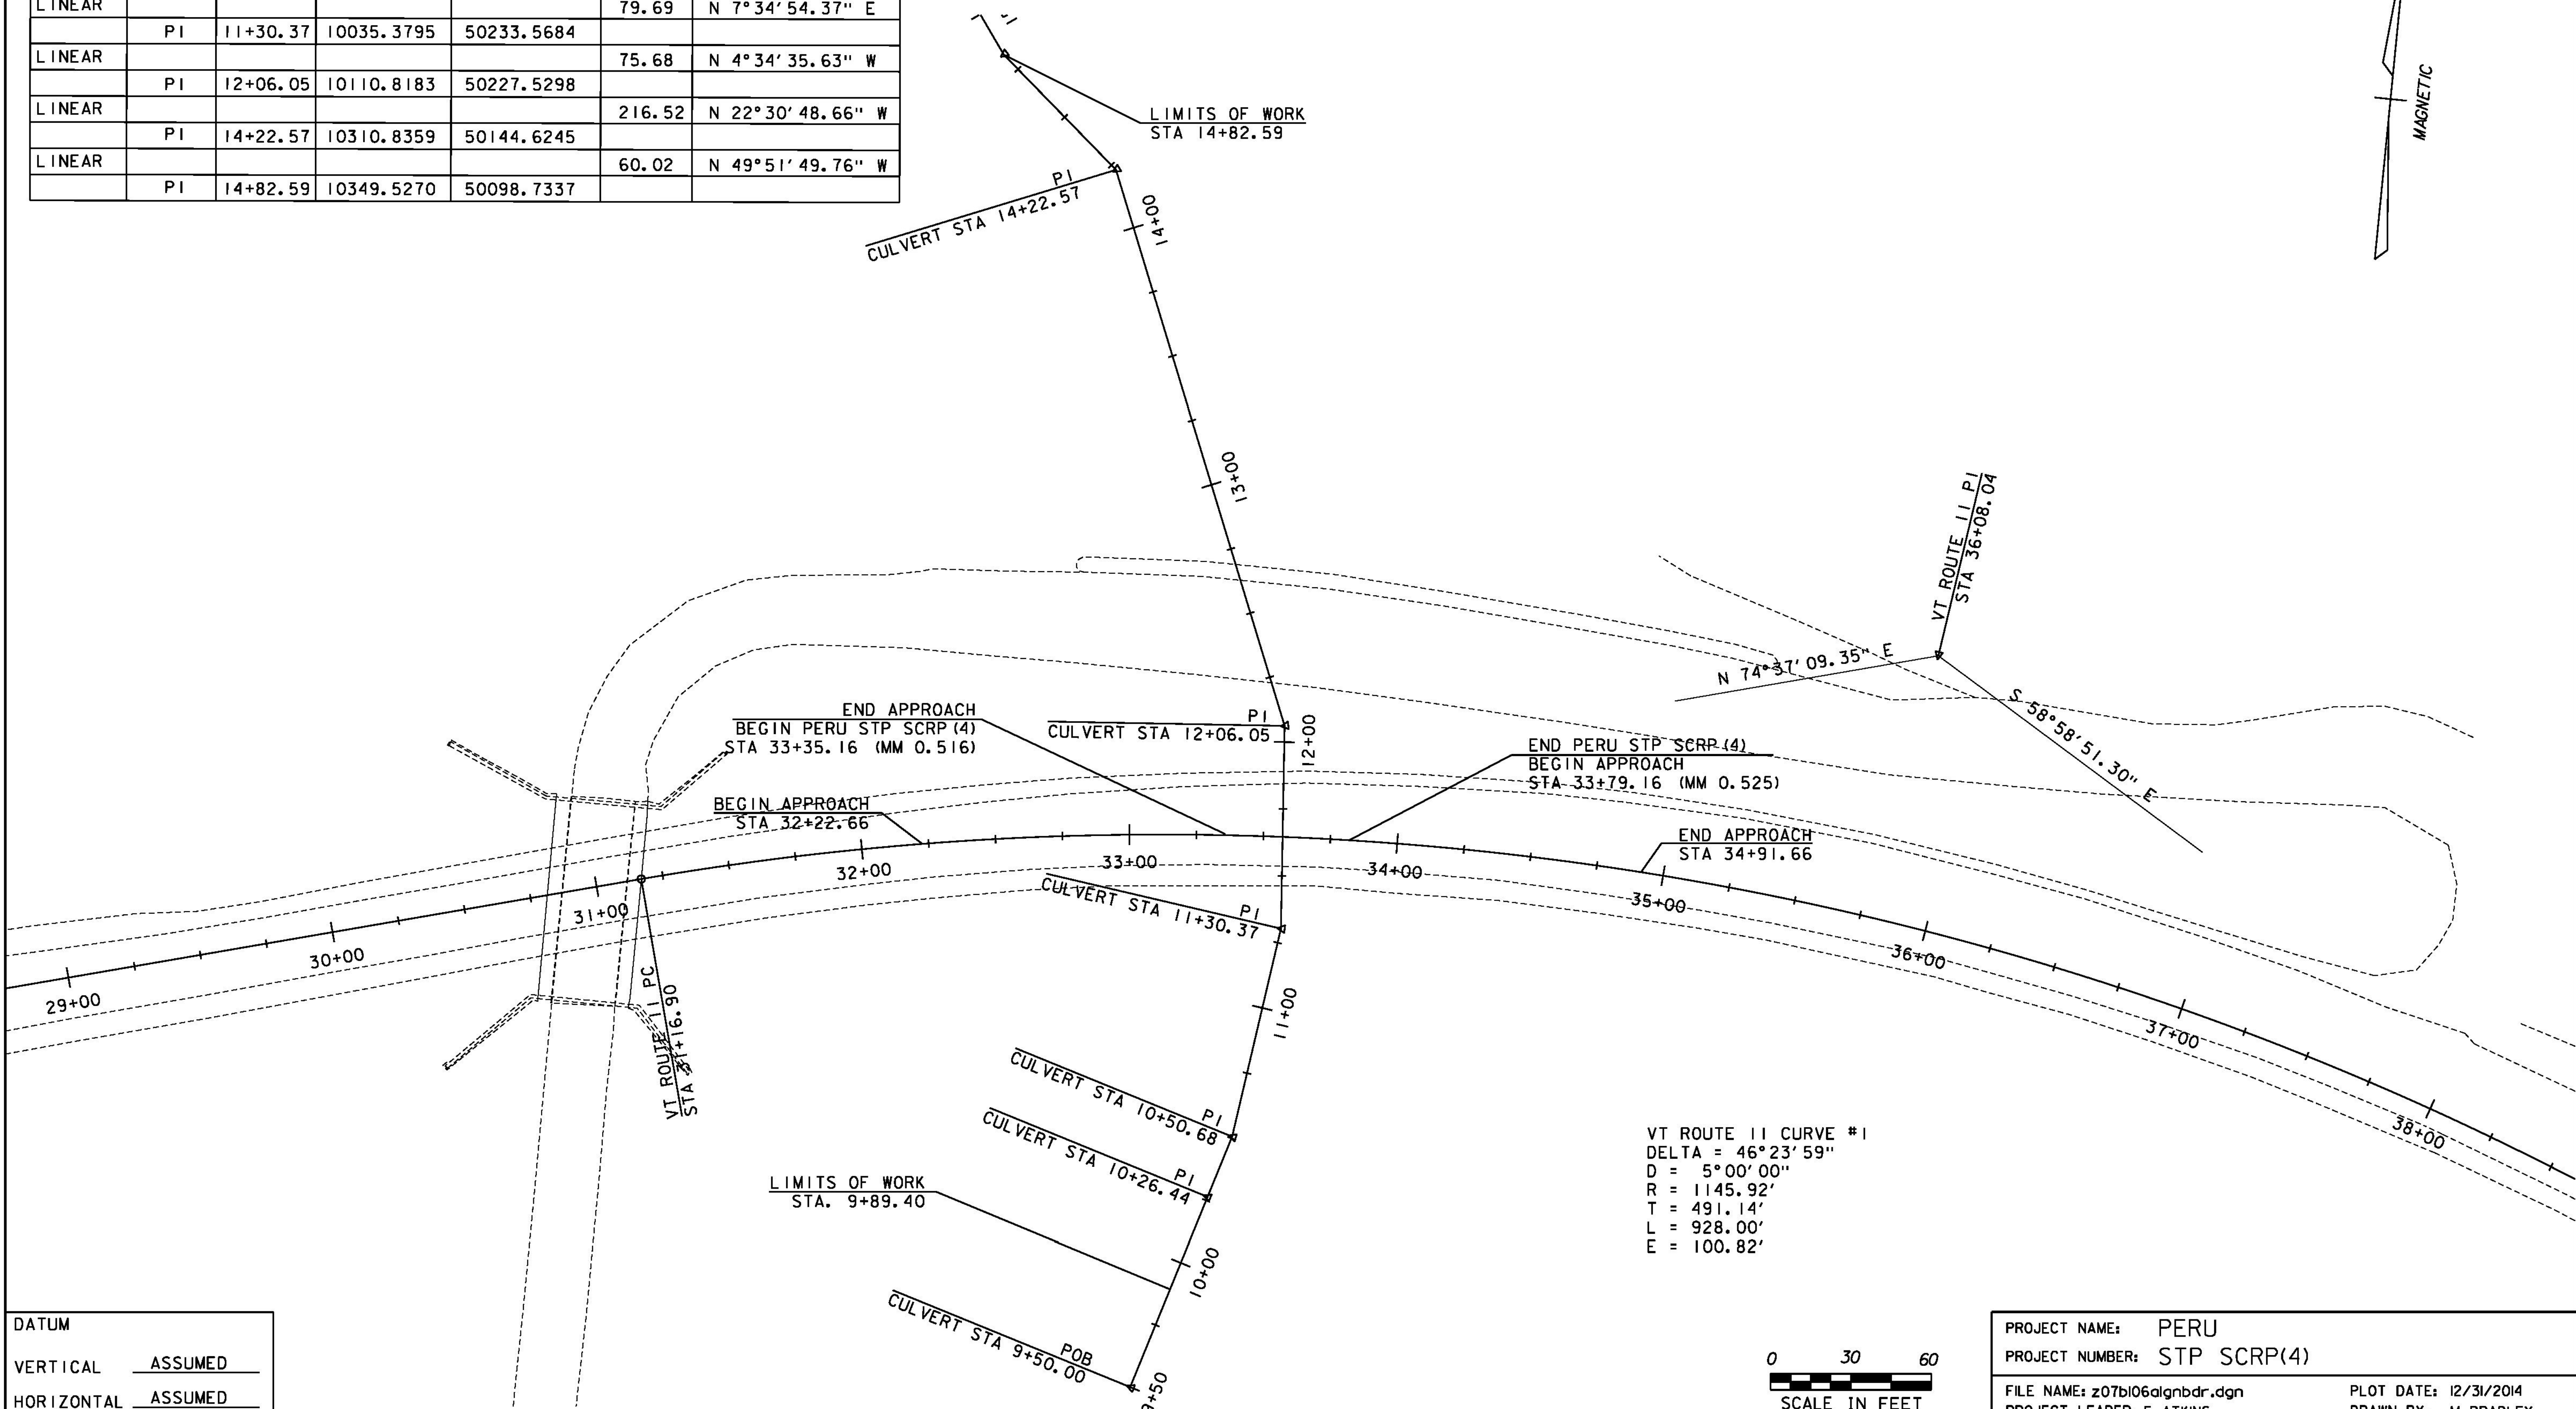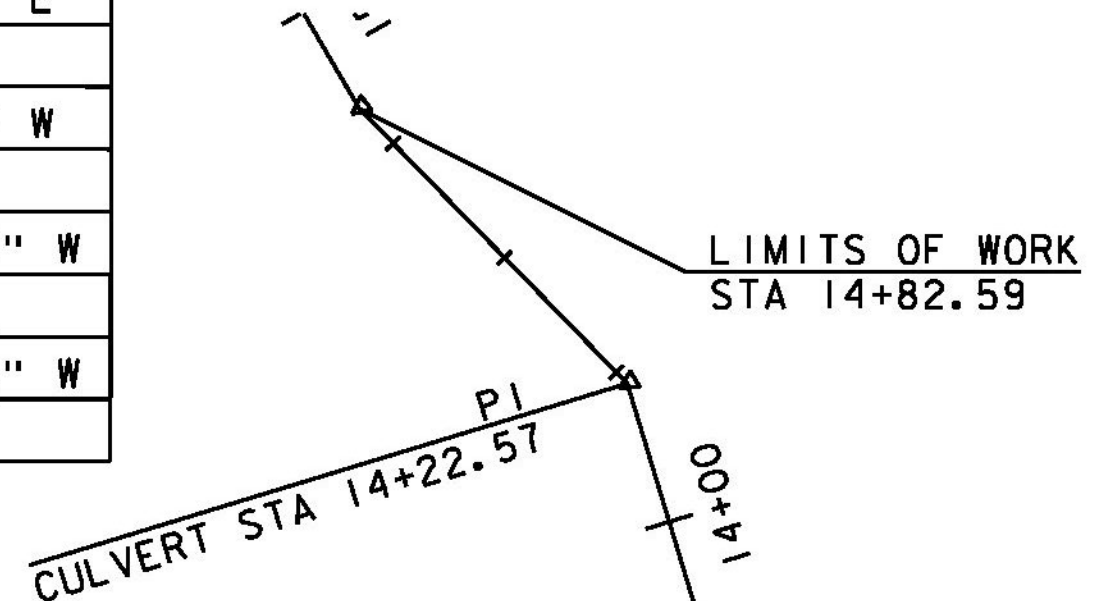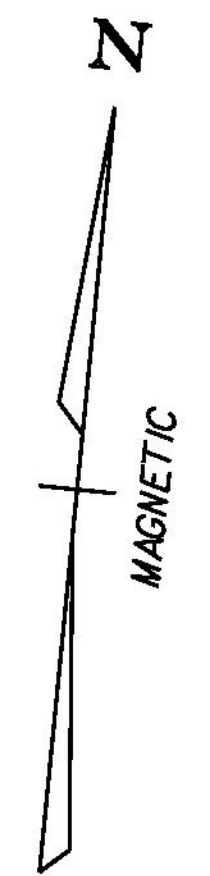

VT ROUTE 11 CURVE #1  
 DELTA = 46°23'59"  
 D = 5°00'00"  
 R = 1145.92'  
 T = 491.14'  
 L = 928.00'  
 E = 100.82'

DATUM	
VERTICAL	ASSUMED
HORIZONTAL	ASSUMED
ADJUSTMENT	NONE

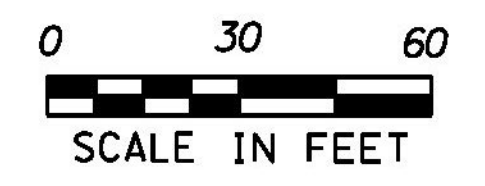

GREEN INTERNATIONAL AFFILIATES, INC.  
 CIVIL AND STRUCTURAL ENGINEERS

PROJECT NAME:	PERU	PLOT DATE:	12/31/2014
PROJECT NUMBER:	STP SCR(4)	DRAWN BY:	M. BRADLEY
FILE NAME:	z07b106algnbdr.dgn	CHECKED BY:	E. ATKINS
DESIGNED BY:	M. BRADLEY	ALIGNMENT SHEET	SHEET 16 OF 45



BORING LOG		Boring No.: B-101					
Peru STP SCR(4)		Page No.: 1 of 1					
Peru STP SCR(4)		Pin No.: 07b106					
Checked By: ASP							
Boring Crew: Roger Burn, TT		Casing Sampler					
Date Started: 6/05/14 Date Finished: 6/05/14		Type: Flushwall SPT					
VTSPG NAD83: N 9936.08 ft E 50213.63 ft		I.D.: 4 in 2 in					
Station: 10+28.60 Offset: 3.0L		Hammer Wt: 300 lb. 140 lb.					
Ground Elevation: 1945.62 ft		Hammer Fall: 30 in. 30 in.					
		Hammer/Rod Type: Safety					
		Rig: D-50 C _u = 1.3					
Groundwater Observations		Date Depth Notes					
		06/15/14 Dry, after drilling					
Depth (ft)	Strata (1)	Classification of Materials (Description)	Blow(s) (N Value)	Moisture Content %	Gravel %	Sand %	Fines %
0-1.17	A-4, SiSa, Rec. = 1.17 ft, 2-inches topsoil over Fill		6-10-8-16 (18)	23.2	18.6	44.6	36.8
1.17-1.67	A-2-4, GrSiSa, Rec. = 0.5 ft, Fill		21-10-8-9 (18)	16.6	23.5	45.7	30.8
1.67-2.17	A-2-4, GrSiSa, Rec. = 1.5 ft, Fill		13-17-20-36 (37)	18.8	20.1	50.3	29.6
2.17-2.84	A-2-4, SiSa, Rec. = 0.67 ft, Fill		20-33-50-50 (83)	13.6	4.4	68.2	27.4
2.84-3.51	A-1-a, SaGr, Rec. = 0.67 ft, Fill		13-16-43-50 (59)	10.7	57.9	34.5	7.6
3.51-4.18	A-2-4, GrSiSa, Rec. = 0.83 ft, Till		14-15-25-25 (40)	12.6	27.4	37.5	35.1
4.18-5.18	A-4, GrSiSa, Rec. = 1.0 ft, Till		26-40-39-42 (79)	12.2	23.3	38.7	38.0
Hole stopped @ 22.0 ft							

2010/COPY J1146126/GPJ VERMONT ADT GDT 7/2/14

Notes:  
 1. Classification lines represent approximate boundaries between material types. Transition may be gradual.  
 2. N values have not been corrected for hammer energy. C_u is the hammer energy correction factor. C_u is an estimated value.  
 3. Water level readings have been made at times and under conditions stated.  
 4. Ground surface elevations indicated on this boring log were estimated based on the grading plan provided by VDOT.



BORING LOG		Boring No.: B-102					
Peru STP SCR(4)		Page No.: 1 of 1					
Peru STP SCR(4)		Pin No.: 07b106					
Checked By: ASP							
Boring Crew: Roger Burn, TT		Casing Sampler					
Date Started: 6/05/14 Date Finished: 6/05/14		Type: Flushwall SPT					
VTSPG NAD83: N 10003.10 ft E 50224.48 ft		I.D.: 4 in 2 in					
Station: 10+75.40 Offset: 4.0L		Hammer Wt: 300 lb. 140 lb.					
Ground Elevation: 1973.85 ft		Hammer Fall: 30 in. 30 in.					
		Hammer/Rod Type: Safety					
		Rig: D-50 C _u = 1.3					
Groundwater Observations		Date Depth Notes					
		06/15/14 Dry, after drilling					
Depth (ft)	Strata (1)	Classification of Materials (Description)	Blow(s) (N Value)	Moisture Content %	Gravel %	Sand %	Fines %
0-0.83	A-1-B, SiGrSa, Rec. = 0.83 ft, 4-inches topsoil over Fill		1-4-13-20 (17)	13.6	27.1	47.9	25.0
0.83-1.33	A-2-4, SiGrSa, Rec. = 0.5 ft, Fill		20-16-26-16 (42)	11.2	28.7	43.5	27.8
1.33-1.83	Rec. = 0.0 ft, 4.0 ft - 6.0 ft, boulders from 5 to 14 feet, Fill		12-10-3-3 (13)	15.8	13.5	53.5	33.0
1.83-2.33	A-2-4, SiSa, Rec. = 0.33 ft, broken rock, wood pieces, Fill		28-29-18-10 (47)	8.1	50.8	32.1	17.1
2.33-3.00	A-1-B, SaGr, Rec. = 0.67 ft, Fill		22-15-20-21 (35)				
3.00-3.83	A-2-4, GrSiSa, Rec. = 1.0 ft, Fill		4-5-8-15 (13)	29.8	23.4	41.5	35.1
3.83-5.03	Organic silt with broken rock, Fill, Rec. = 1.2 ft		9-5-6-11 (11)	93.7			
5.03-5.33	Silt with organic matter and broken rock, Fill, Rec. = 0.33 ft		39-60 (60+)	29.4			
5.33-6.33	A-4, GrSaSi, Rec. = 0.83 ft, Fill		30-40-40-57 (80)	14.1	29.6	34.2	36.2
6.33-7.00	A-2-4, SaSiGr, Rec. = 0.07 ft, Till		46-80-50 (130+)	12.7	38.2	28.4	33.4
7.00-7.50	A-2-4, SaSiGr, Rec. = 0.5 ft, Till		51-100 (100+)	13.8	36.8	30.2	33.0
7.50-8.17	A-1-B, SiSaGr, Rec. = 0.2 ft, Till		100 (100+)	18.1	39.5	38.4	22.1
Hole stopped @ 45.3 ft							

2010/COPY J1146126/GPJ VERMONT ADT GDT 7/2/14

Notes:  
 1. Classification lines represent approximate boundaries between material types. Transition may be gradual.  
 2. N values have not been corrected for hammer energy. C_u is the hammer energy correction factor. C_u is an estimated value.  
 3. Water level readings have been made at times and under conditions stated.  
 4. Ground surface elevations indicated on this boring log were estimated based on the grading plan provided by VDOT.



BORING LOG		Boring No.: B-103					
Peru STP SCR(4)		Page No.: 1 of 1					
Peru STP SCR(4)		Pin No.: 07b106					
Checked By: ASP							
Boring Crew: Peter Labossion, TT		Casing Sampler					
Date Started: 6/04/14 Date Finished: 6/04/14		Type: Flushwall SPT					
VTSPG NAD83: N 10089.25 ft E 50229.26 ft		I.D.: 4 in 2 in					
Station: 11+84.40 Offset: 0.0R		Hammer Wt: 300 lb. 140 lb.					
Ground Elevation: 1988.78 ft		Hammer Fall: 30 in. 30 in.					
		Hammer/Rod Type: Cathead					
		Rig: B-47 C _u = 1.0					
Groundwater Observations		Date Depth Notes					
		06/14/14 Dry, after drilling					
Depth (ft)	Strata (1)	Classification of Materials (Description)	Blow(s) (N Value)	Moisture Content %	Gravel %	Sand %	Fines %
0-0.67	8-inches bituminous asphalt pavement		16-26-29-31 (65)	4.7	53.4	28.0	18.6
0.67-1.34	A-1-B, SaGr, Rec. = 0.67 ft, Fill		29-24-16-18 (40)	7.7	39.1	30.6	30.3
1.34-2.01	A-2-4, SiSaGr, Rec. = 0.67 ft, Fill	(IMPORTED FILL)	11-16-30 (36)	11.8	26.0	34.9	39.1
2.01-2.68	A-4, GrSaSi, Rec. = 1.0 ft, Fill		20-34-60-75 (94)	9.9	28.1	35.4	36.5
2.68-3.35	A-4, GrSaSi, Rec. = 0.83 ft, drill rig rocking and grinding noises, Fill		35-39-40-44 (79)	11.4	18.8	39.2	42.0
3.35-4.02	A-4, SaSi, Rec. = 1.17 ft, drill rig rocking and grinding noises, Fill		38-42-50-60 (62)	11.5	28.2	40.0	31.8
4.02-4.69	A-2-4, GrSiSa, Rec. = 1.0 ft, Fill		14-12-14-11 (26)	9.1	48.7	32.0	19.3
4.69-5.36	A-1-B, SaGr, Rec. = 0.33 ft, Fill		5-5-8-8 (11)	16.5	31.8	34.5	33.7
5.36-6.03	A-2-4, GrSiSa, Rec. = 0.5 ft, Fill	(FILL)	16-35-41-39 (77)	12.6	41.8	38.0	20.2
6.03-6.70	A-1-B, SiSaGr, Rec. = 1.0 ft, Till		16-16-18-17 (52)	11.2	46.3	29.2	24.5
6.70-7.37	A-1-B, SiSaGr, Rec. = 0.83 ft, Till						
Hole stopped @ 36.0 ft							

2010/COPY J1146126/GPJ VERMONT ADT GDT 7/2/14

Notes:  
 1. Classification lines represent approximate boundaries between material types. Transition may be gradual.  
 2. N values have not been corrected for hammer energy. C_u is the hammer energy correction factor. C_u is an estimated value.  
 3. Water level readings have been made at times and under conditions stated.  
 4. Ground surface elevations indicated on this boring log were estimated based on the grading plan provided by VDOT.





NOTE: HORIZONTAL AND VERTICAL DATUMS ARE ASSUMED. REFER TO TIE SHEETS FOR HORIZONTAL AND VERTICAL CONTROL

PROJECT NAME: PERU  
 PROJECT NUMBER: STP SCR(4)

FILE NAME: z07b106bor.dgn  
 PROJECT LEADER: E. ATKINS  
 DESIGNED BY: M. BRADLEY  
 BORING SHEET 2

PLOT DATE: 12/31/2014  
 DRAWN BY: M. BRADLEY  
 CHECKED BY: E. ATKINS  
 SHEET 18 OF 45










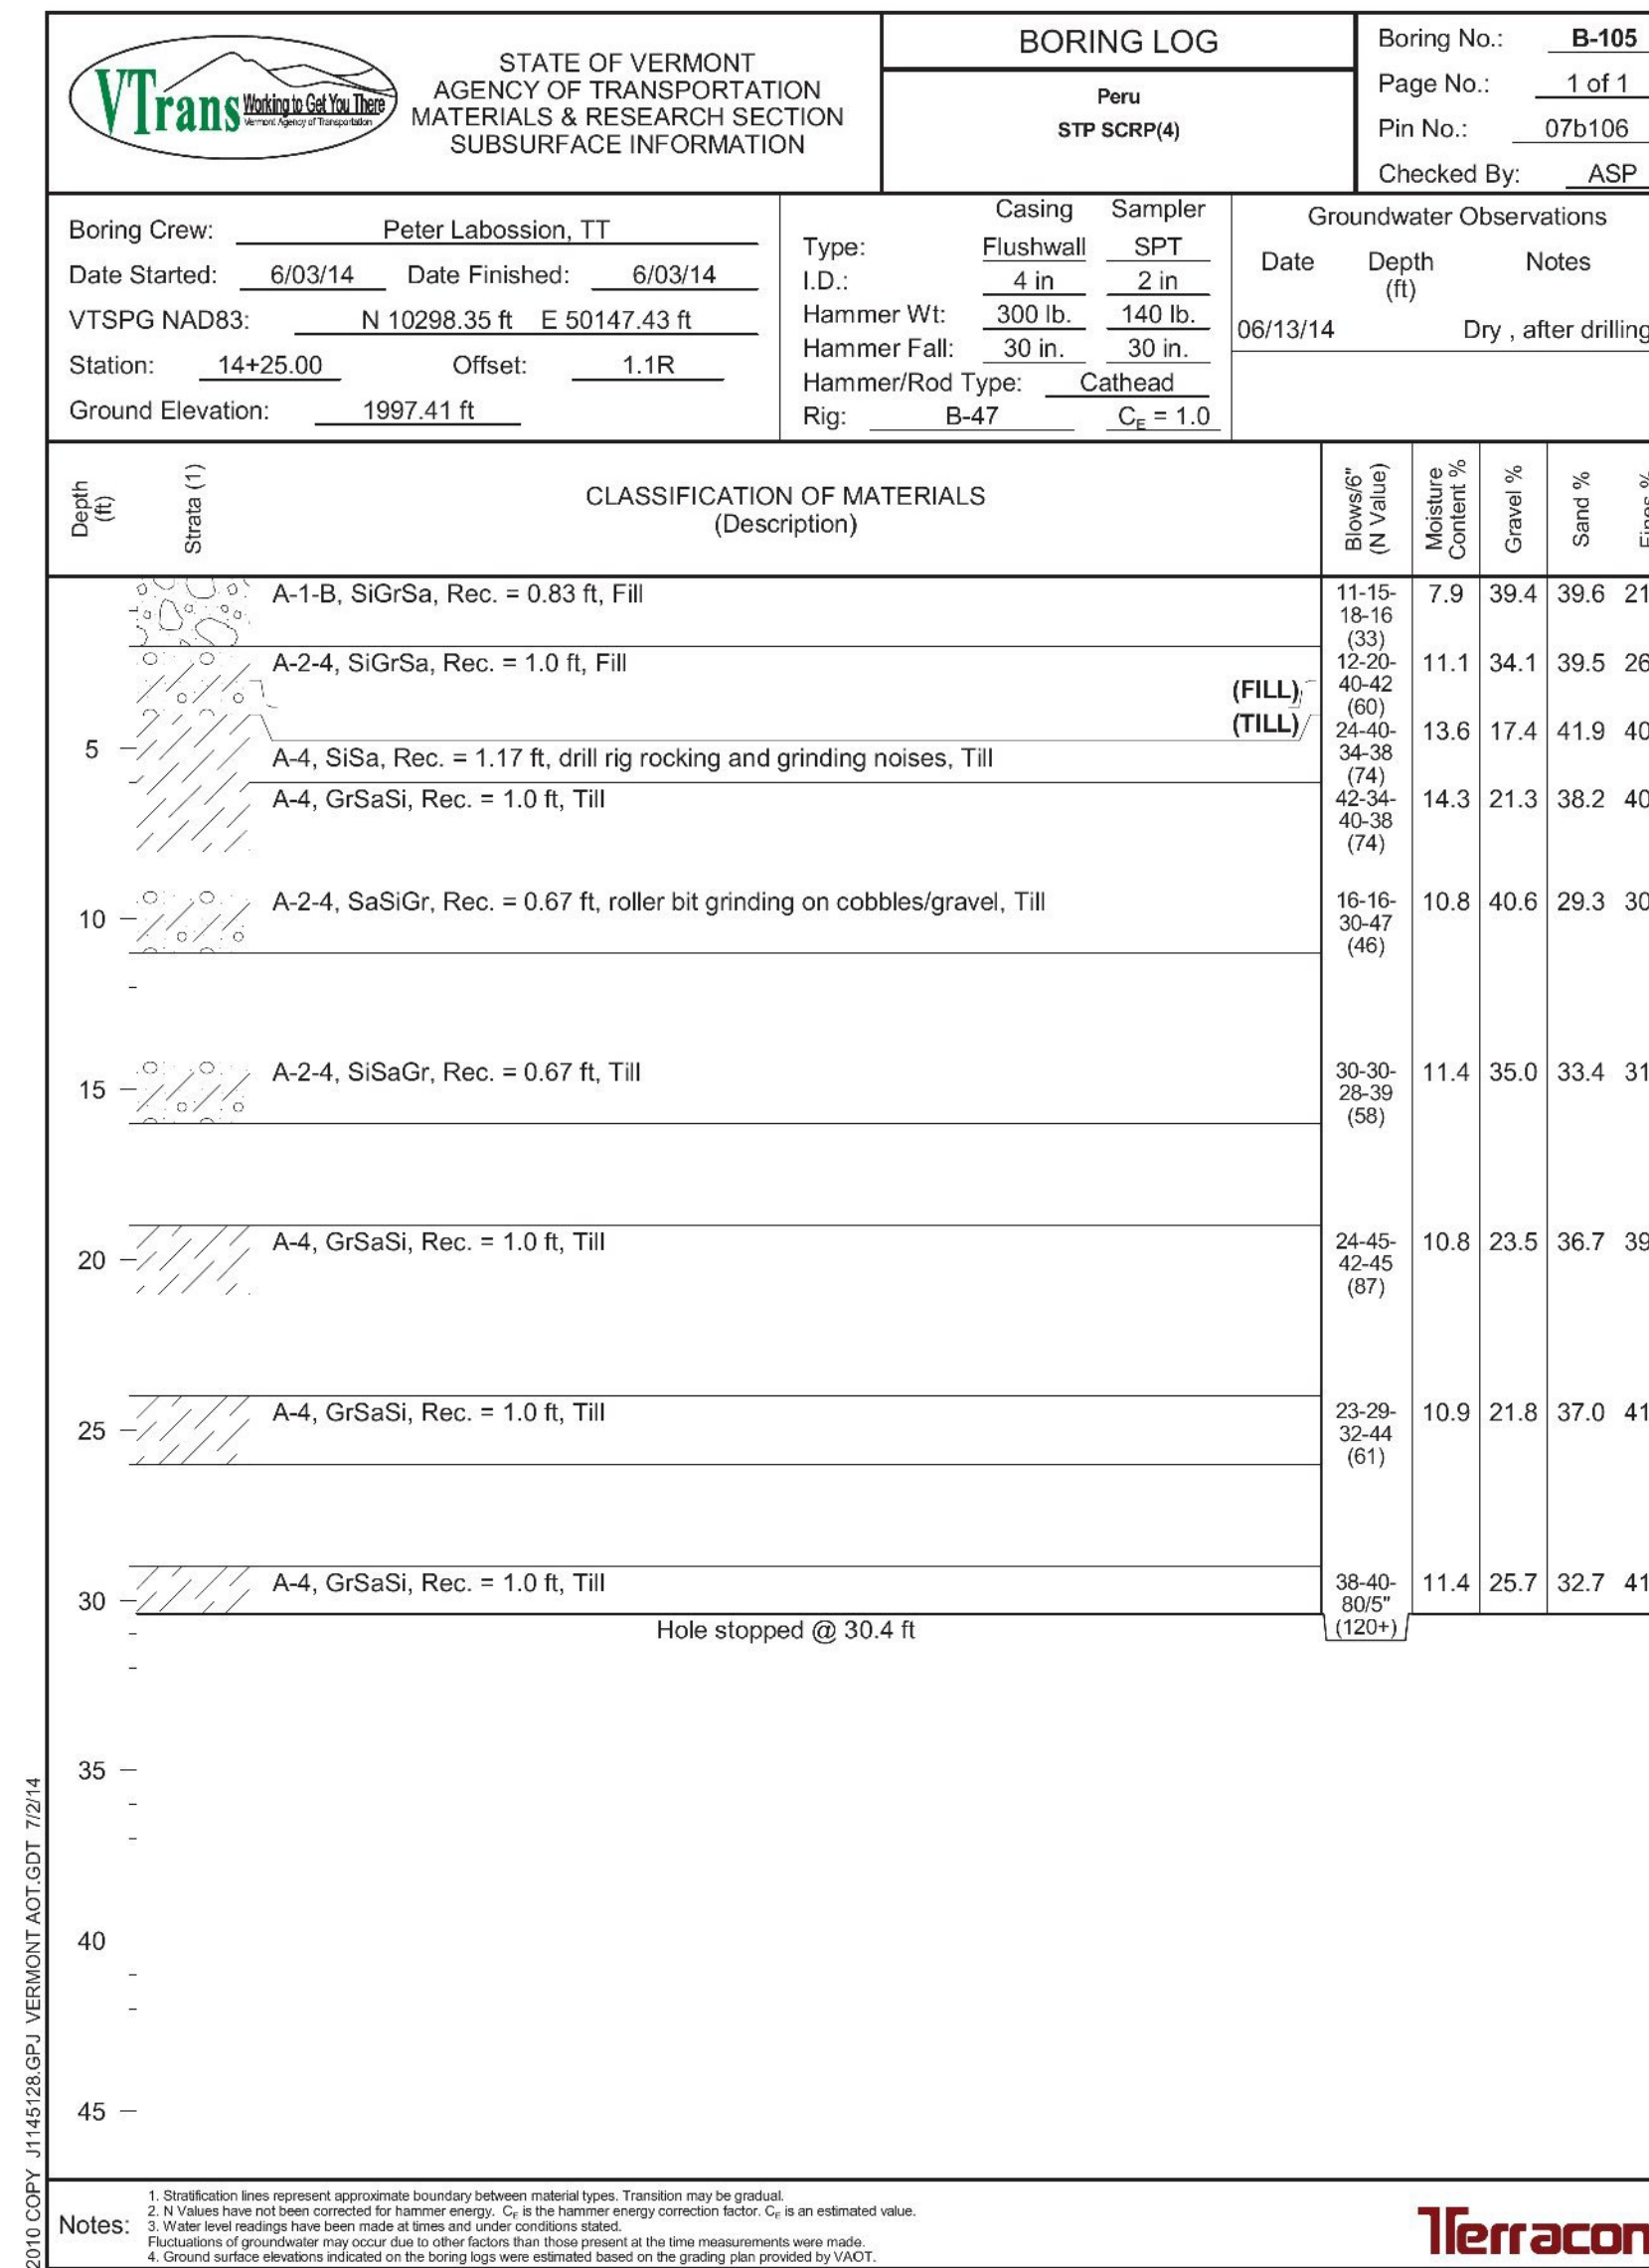
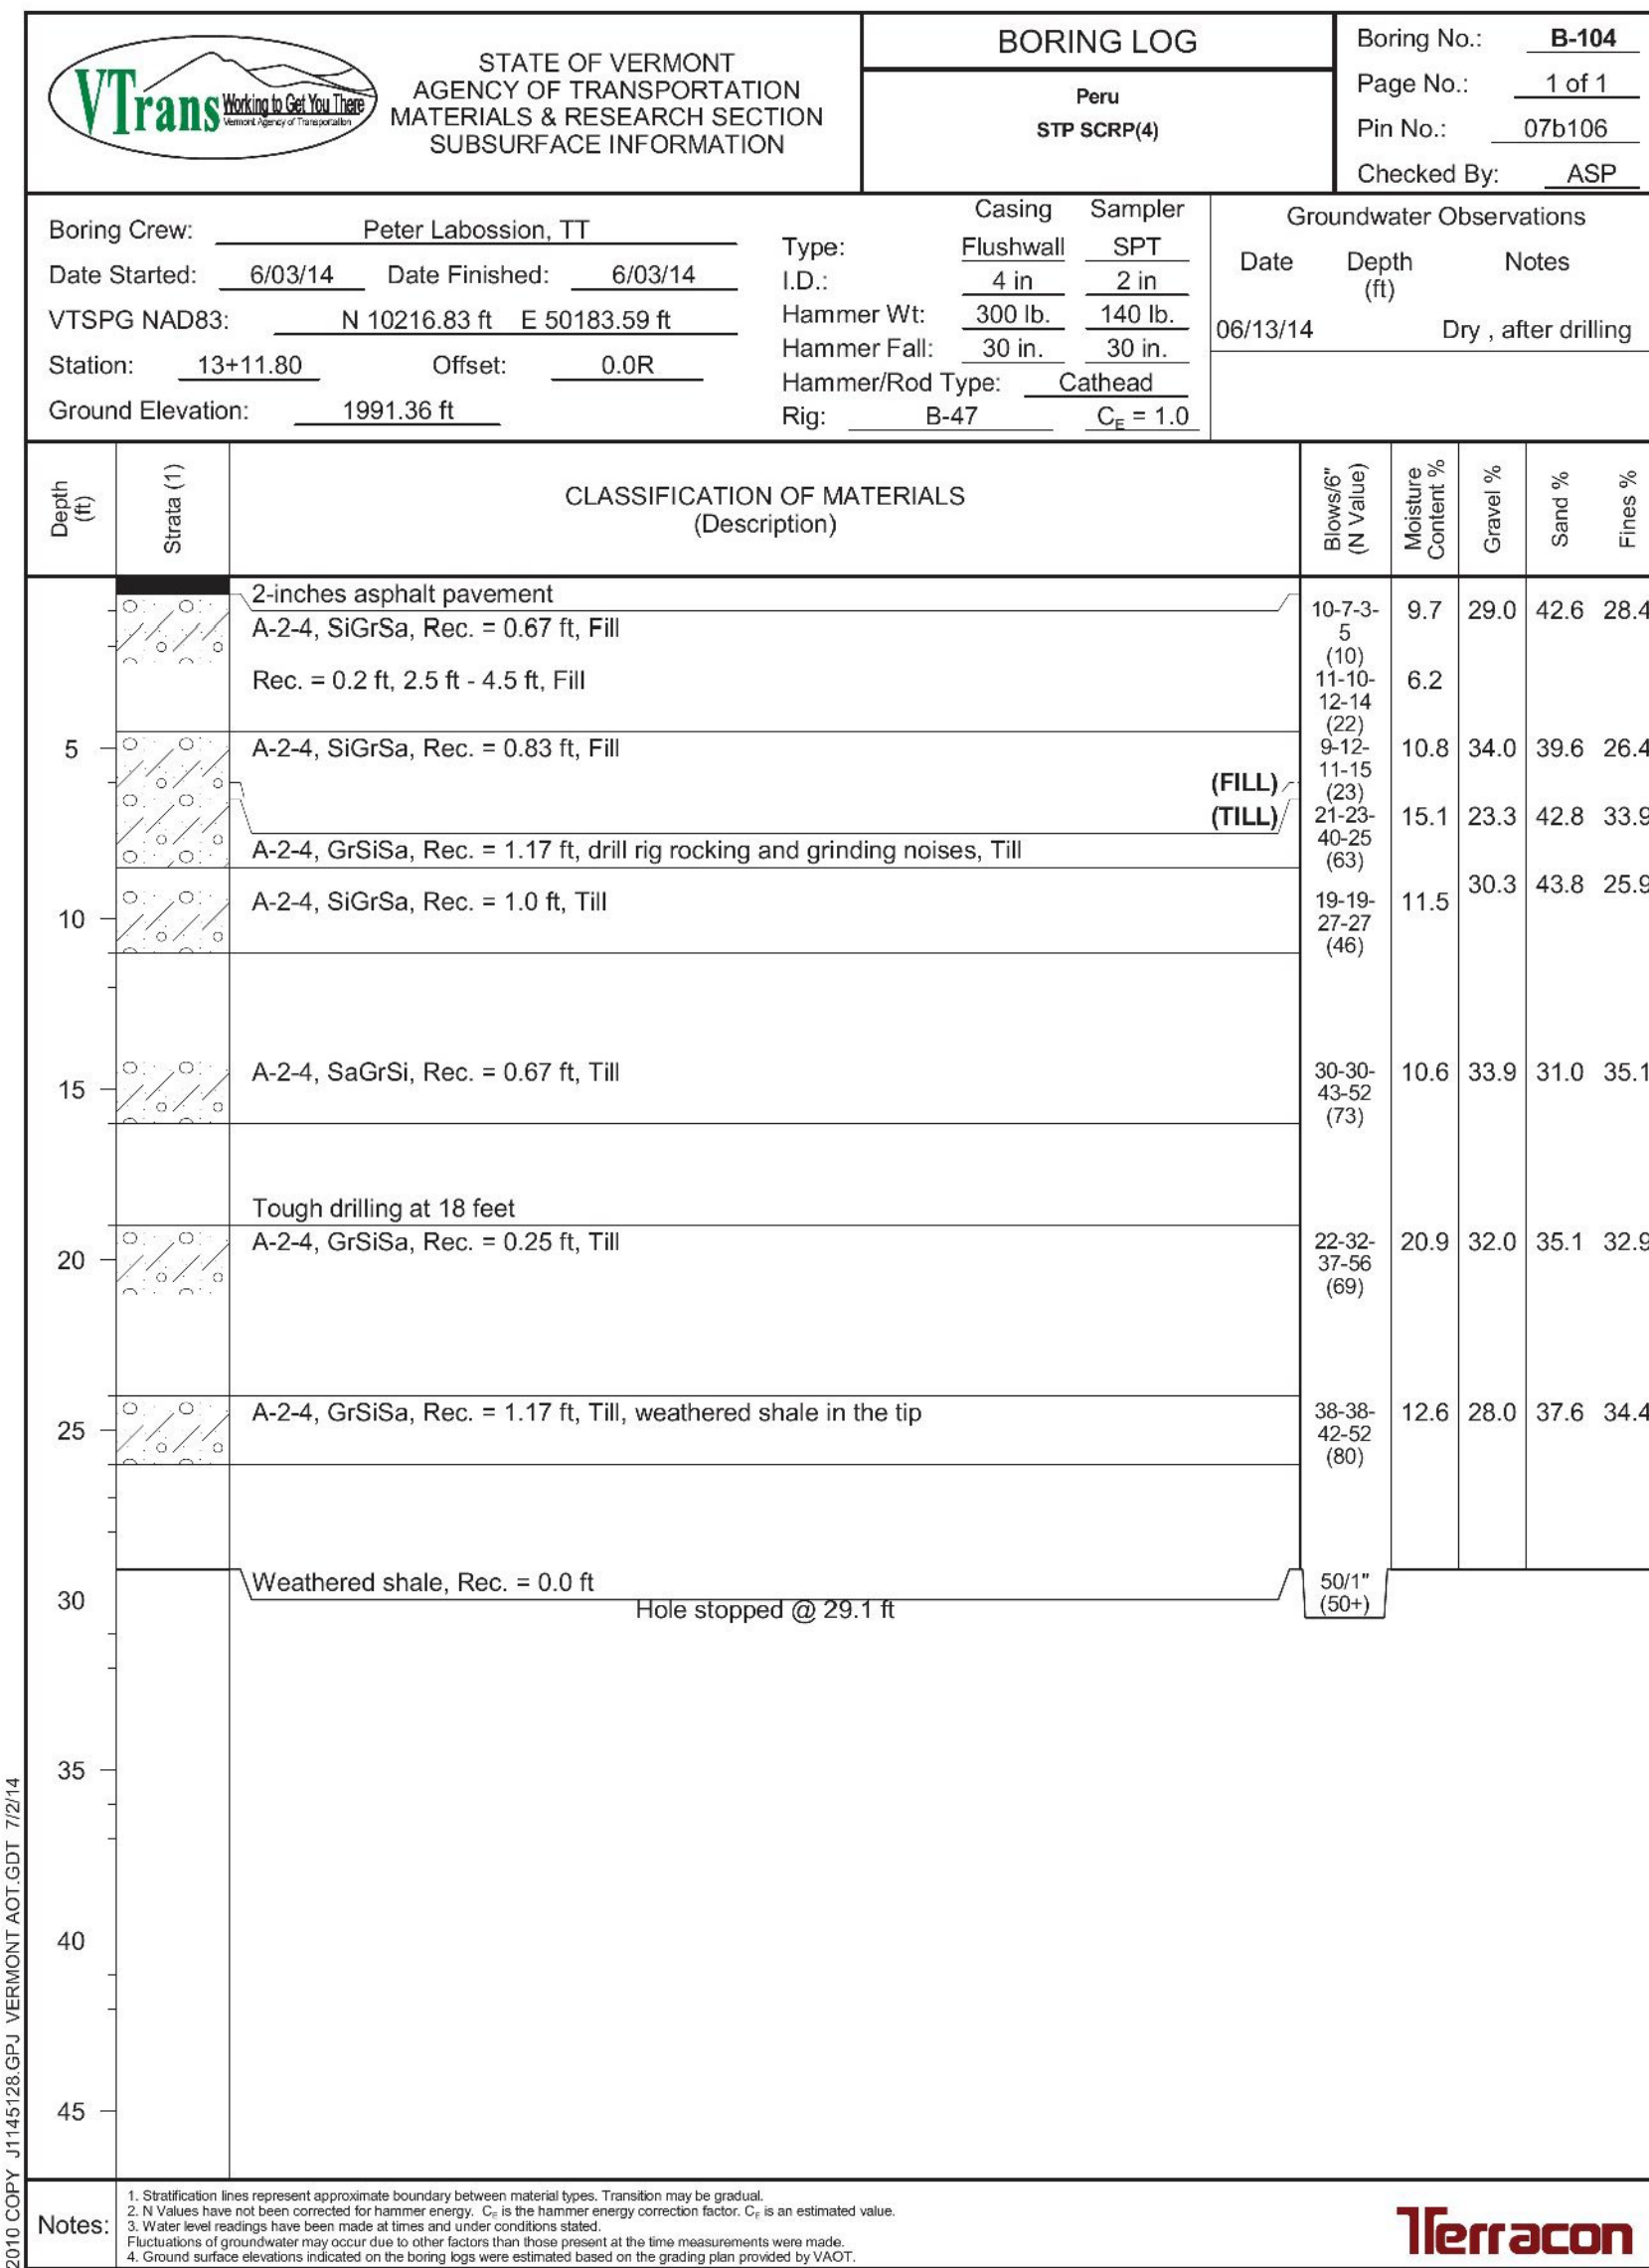


NOTE: HORIZONTAL AND VERTICAL DATUMS ARE ASSUMED. REFER TO TIE SHEETS FOR HORIZONTAL AND VERTICAL CONTROL

PROJECT NAME: PERU  
 PROJECT NUMBER: STP SCR(4)

FILE NAME: z07b106bor.dgn  
 PROJECT LEADER: E. ATKINS  
 DESIGNED BY: M. BRADLEY  
 BORING SHEET 3

PLOT DATE: 12/31/2014  
 DRAWN BY: M. BRADLEY  
 CHECKED BY: E. ATKINS  
 SHEET 19 OF 45

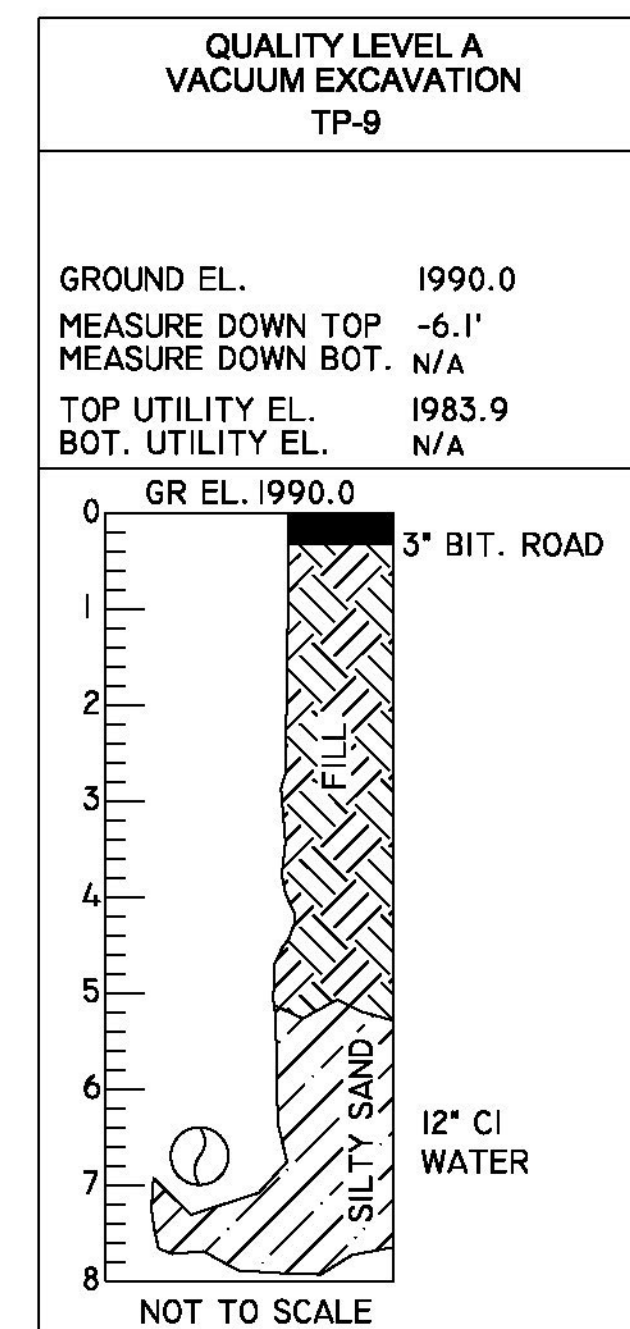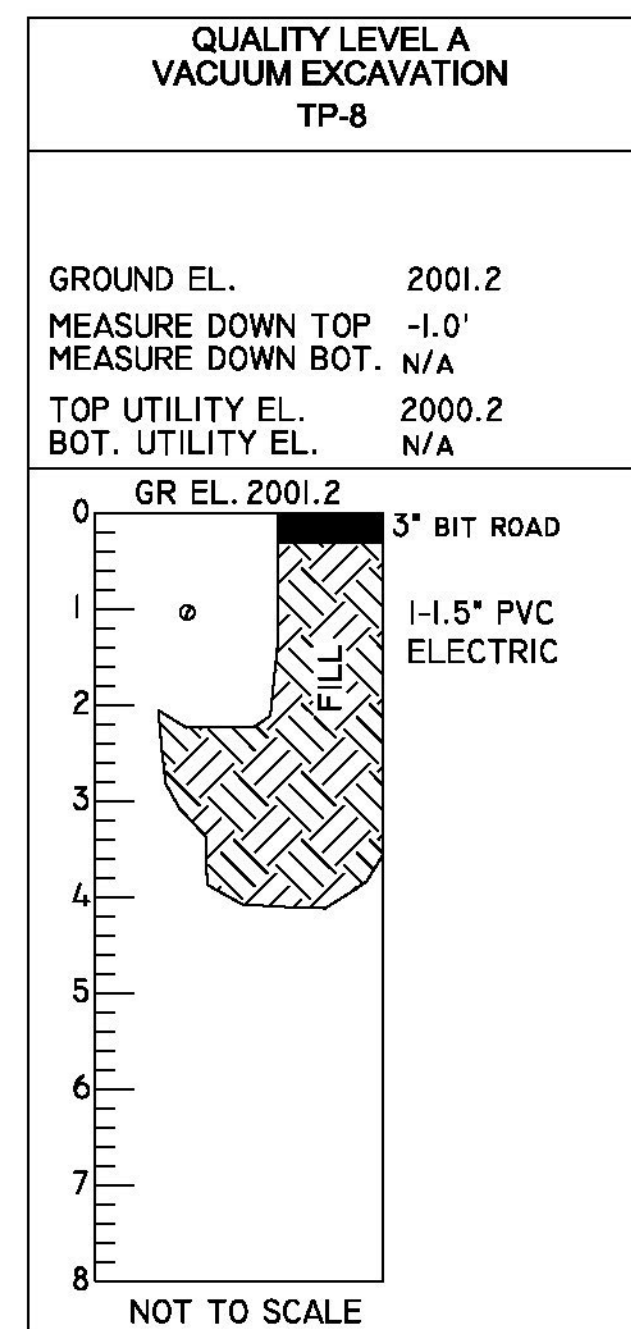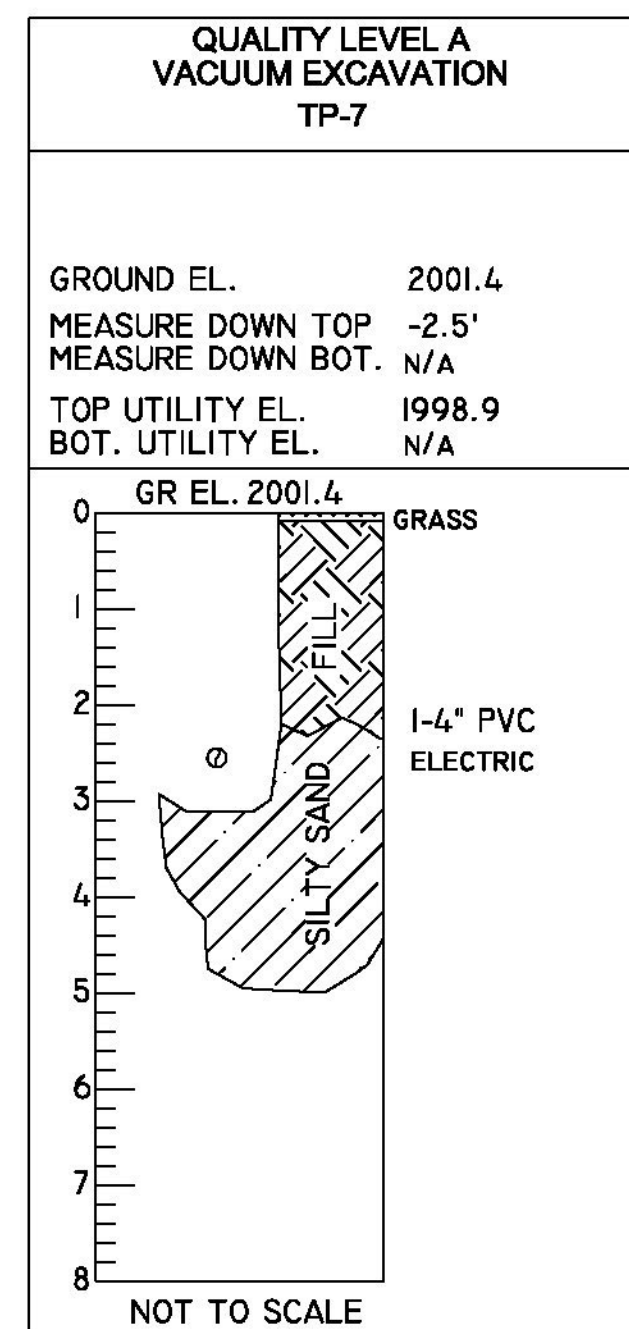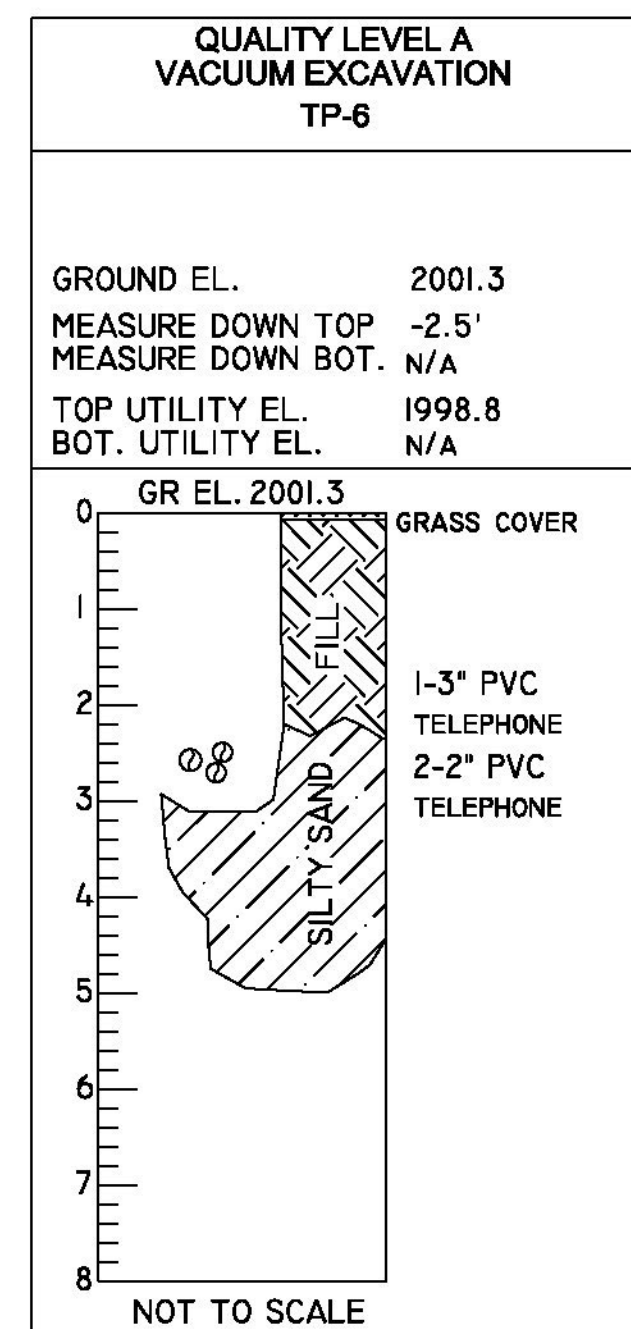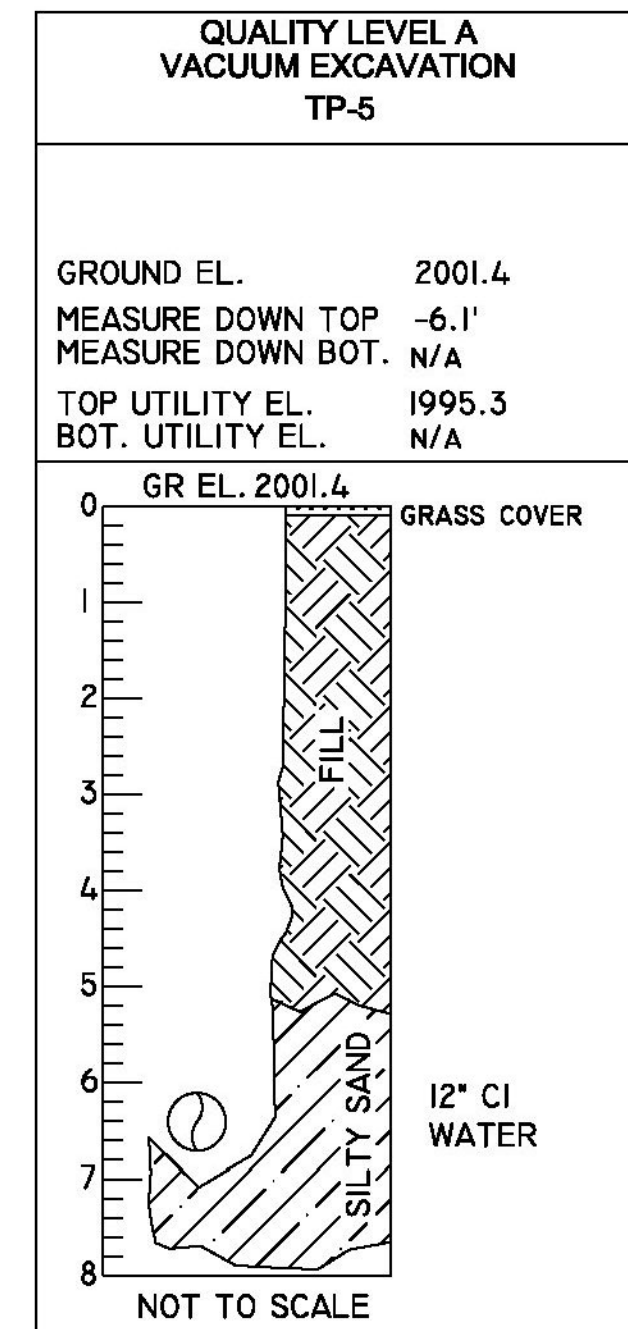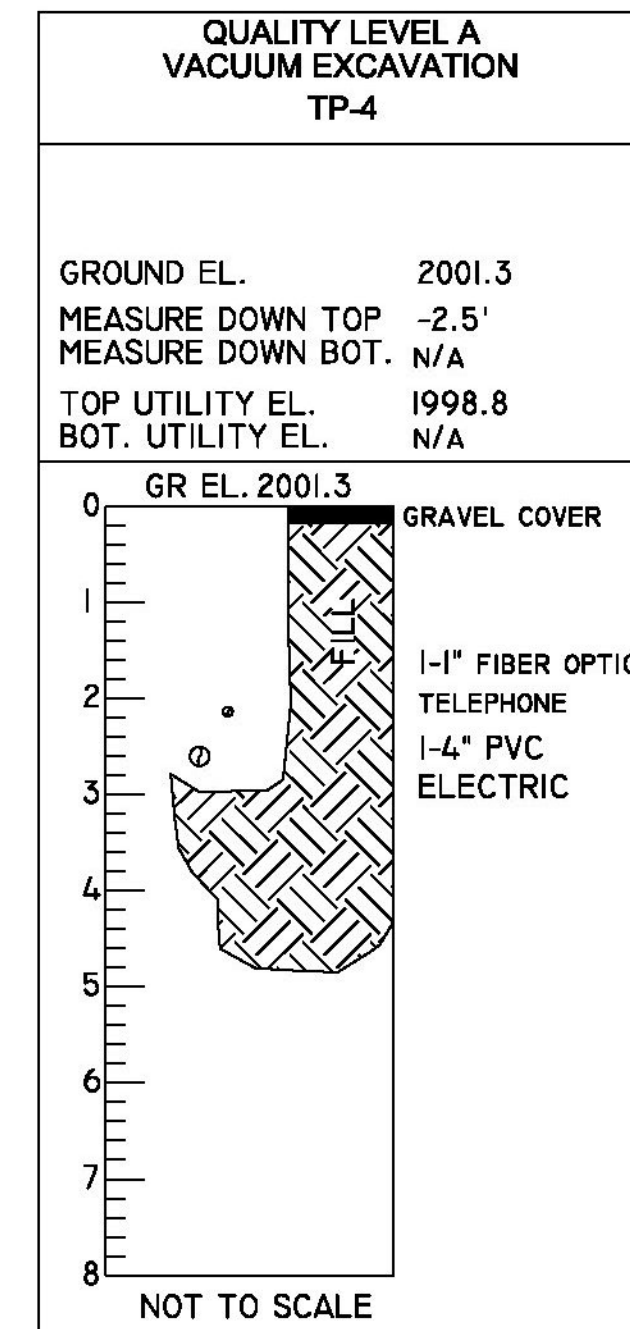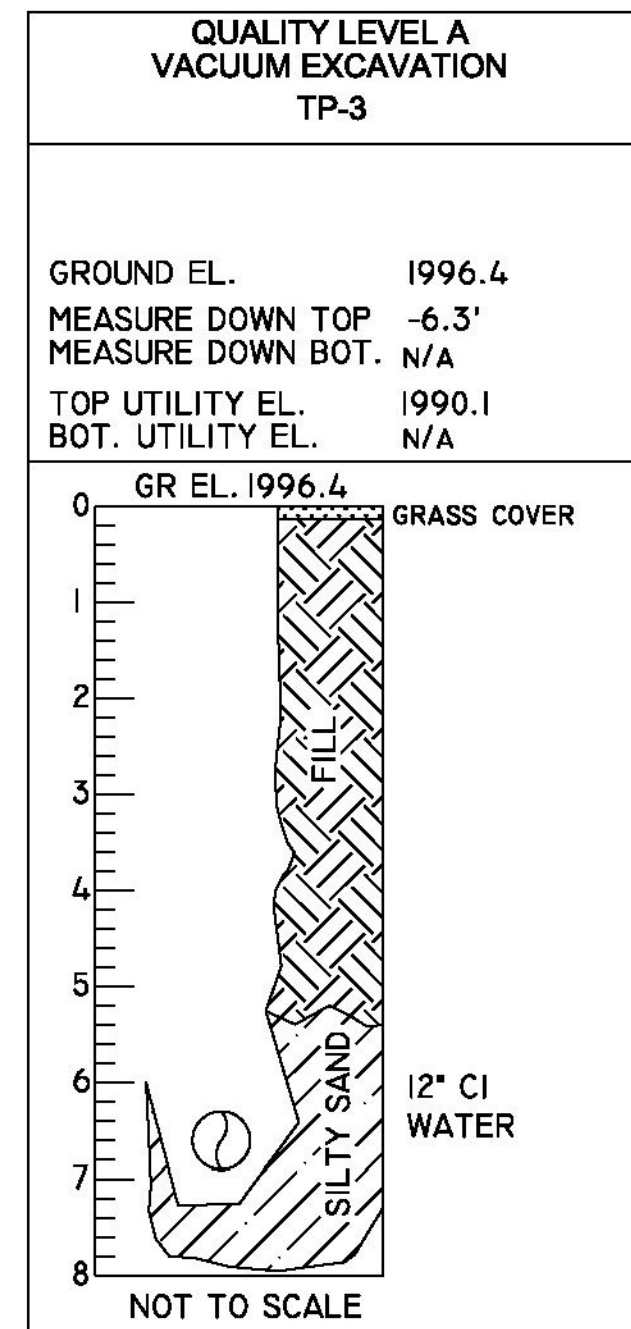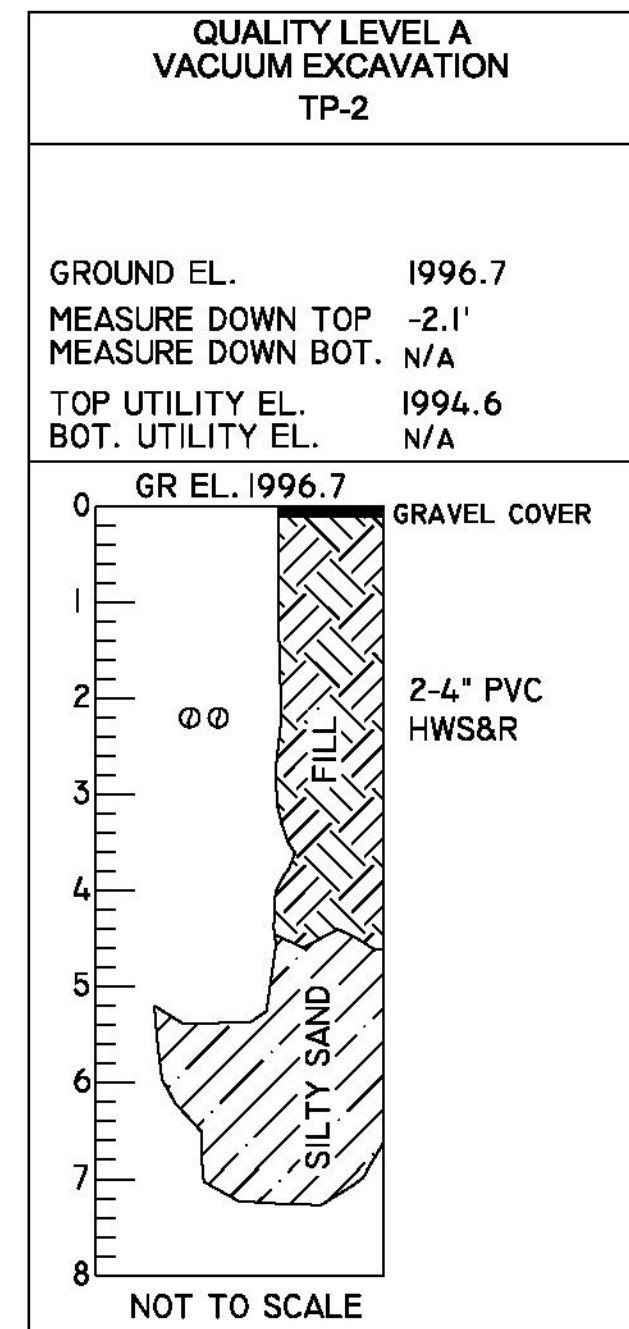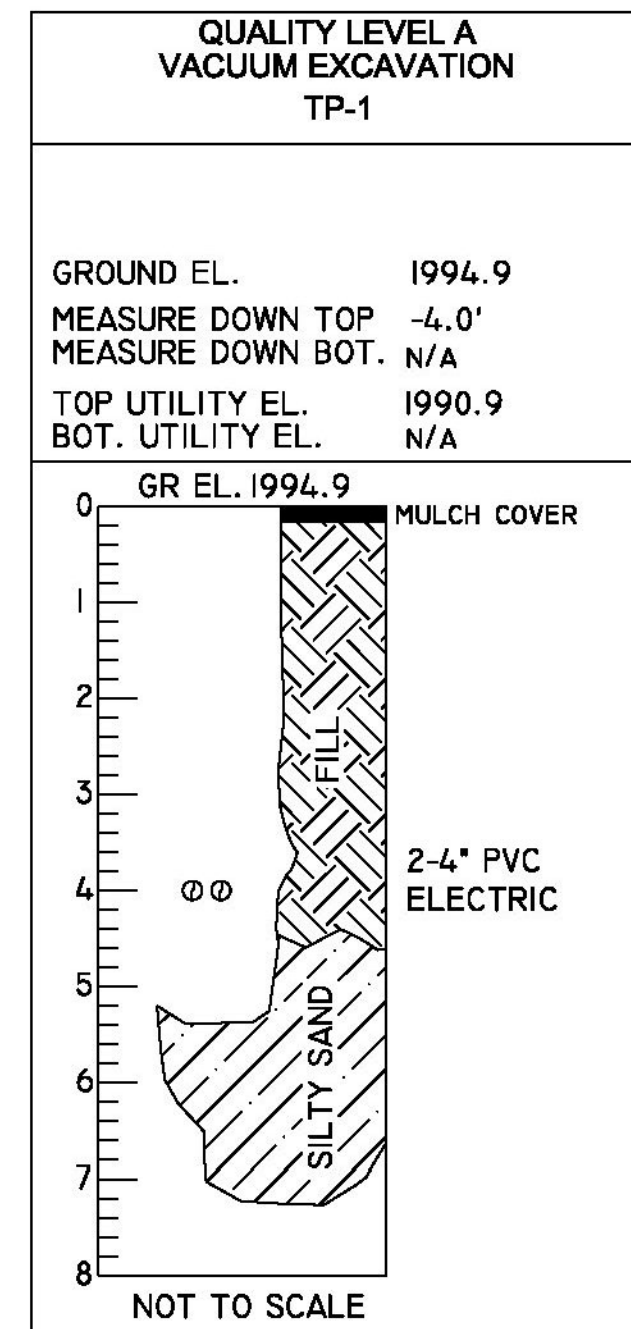

NOTE: HORIZONTAL AND VERTICAL DATUMS ARE ASSUMED. REFER TO TIE SHEETS FOR HORIZONTAL AND VERTICAL CONTROL

PROJECT NAME: PERU  
PROJECT NUMBER: STP SCRP(4)

FILE NAME: z07bi06bor.dgn  
PROJECT LEADER: E. ATKINS  
DESIGNED BY: M. BRADLEY  
BORING SHEET 4

PLOT DATE: 12/31/2014  
DRAWN BY: M. BRADLEY  
CHECKED BY: E. ATKINS  
SHEET 20 OF 45

# QUANTITY SHEET 1

SUMMARY OF ESTIMATED QUANTITIES							TOTALS		DESCRIPTIONS				DETAILED SUMMARY OF QUANTITIES		
	ROADWAY	ROADWAY (NO FEDERAL/STATE)	LANDSCAPING (NO FEDERAL/STATE)	EROSION CONTROL	EROSION CONTROL (NO FEDERAL/STATE)	FULL C.E. ITEMS	GRAND TOTAL	FINAL	UNIT	ITEMS	ITEM NUMBER	ROUND	QUANTITIES	UNIT	ITEMS
	1						1		LS	CLEARING AND GRUBBING, INCLUDING INDIVIDUAL TREES AND STUMPS	201.10	-	COMMON EXCAVATION		
	500						500		CY	COMMON EXCAVATION	203.15	5	495 CY		VT ROUTE 11
	15						15		CY	SOLID ROCK EXCAVATION	203.16	EST	5 CY		ROUNDING
	25	75					100		CY	TRENCH EXCAVATION OF EARTH	204.20	4	500 CY		TOTAL
	1						1		CY	TRENCH EXCAVATION OF EARTH, EXPLORATORY (N.A.B.I.)	204.22	-	TRENCH EXCAVATION OF EARTH		
	4400	400					4800		CY	STRUCTURE EXCAVATION	204.25	4	96 CY		MEASURED
	730	70					800		CY	GRANULAR BACKFILL FOR STRUCTURES	204.30	77	4 CY		ROUNDING
	725						725		SY	COLD PLANING, BITUMINOUS PAVEMENT	210.10	4	100 CY		TOTAL
	400						400		CY	SUBBASE OF DENSE GRADED CRUSHED STONE	301.35	66	STRUCTURE EXCAVATION		
	10						10		CY	AGGREGATE SHOULDERS, IN PLACE	402.10	3	4796 CY		MEASURED
	10						10		CWT	EMULSIFIED ASPHALT	404.85	0.1	4 CY		ROUNDING
	1						1		LU	PRICE ADJUSTMENT, ASPHALT CEMENT (N.A.B.I.)	406.50	-	4800 CY		TOTAL
	66						66		CY	CONCRETE, HIGH PERFORMANCE CLASS B	501.34	0.4	GRANULAR BACKFILL FOR STRUCTURES		
	15000						15000		LB	REINFORCING STEEL, LEVEL I	507.11	5	723 CY		MEASURED
	5						5		GAL	WATER REPELLENT, SILANE	514.10	0.9	77 CY		ROUNDING
	220						220		CY	CONTROLLED DENSITY (FLOWABLE) FILL	541.45	16	800 CY		TOTAL
										BEGIN OPTION AA			SUBBASE OF DENSE GRADED CRUSHED STONE		
	30						30		LF	12" CAAP .060 (2-2/3 X 1/2)	601.0205	1	334 CY		VT ROUTE 11
	30						30		LF	12" PCCSP .064 (2-2/3 X 1/2)	601.0405	1	66 CY		ROUNDING
	30						30		LF	12" RCP CLASS III	601.0805	1	400 CY		TOTAL
	30						30		LF	12" CPEP(SL)	601.2605	1	PERMANENT EROSION CONTROL		
										END OPTION AA			40 CY		STONE FILL, TYPE I
										BEGIN OPTION BB			70 CY		STONE FILL, TYPE II
	350						350		LF	72 CAAP .105 (3 X 1)	601.0342	8	1550 SY		GEOTEXTILE UNDER STONE FILL
	350						350		LF	72" PCCSP .109 (3 X 1)	601.0542	8	50 LB		SEED
										END OPTION BB			PERMANENT EROSION CONTROL		
										BEGIN OPTION CC					
		90					90		LF	24" CAAP .060 (2-2/3 X 1/2)	601.0225	4			
		90					90		LF	24" PCCSP .064 (2-2/3 X 1/2)	601.0425	4			
		90					90		LF	24" RCP CLASS III	601.0825	4			
		90					90		LF	24" CPEP(SL)	601.2620	4			
										END OPTION CC					
										BEGIN OPTION DD					
		55					55		LF	72 CAAP .105 (3 X 1)	601.0342	-			
		55					55		LF	72" PCCSP .109 (3 X 1)	601.0542	-			
										END OPTION DD					
	10						10		LF	42" PCCSP .109 (2-2/3 X 1/2)	601.0452	-			
	2						2		EACH	42" PCCSP ELBOW .109 (2-2/3 X 1/2)	601.5456	-			
	5						5		EACH	PRECAST REINFORCED CONCRETE MANHOLE WITH CAST IRON COVER (10' DIA. ) (<= 25 FOOT DEPTH)	604.21	-			

PROJECT NAME: PERU  
PROJECT NUMBER: STP SCR(4)

FILE NAME: z07b106qty.dgn  
PROJECT LEADER: E. ATKINS  
DESIGNED BY: M. BRADLEY  
QUANTITY SHEET 1

PLOT DATE: 12/31/2014  
DRAWN BY: M. BRADLEY  
CHECKED BY: E. ATKINS  
SHEET 21 OF 45



# QUANTITY SHEET 2

SUMMARY OF ESTIMATED QUANTITIES							TOTALS		DESCRIPTIONS				DETAILED SUMMARY OF QUANTITIES		
	ROADWAY	ROADWAY (NO FEDERAL/STATE)	LANDSCAPING (NO FEDERAL/STATE)	EROSION CONTROL	EROSION CONTROL (NO FEDERAL/STATE)	FULL C.E. ITEMS	GRAND TOTAL	FINAL	UNIT	ITEMS	ITEM NUMBER	ROUND	QUANTITIES	UNIT	ITEMS
	2						2		EACH	PRECAST REINFORCED CONCRETE MANHOLE WITH CAST IRON COVER (10' DIA. ) (> 25 FOOT DEPTH)	604.21	-			
	1						1		EACH	REHAB. DROP INLETS, CATCH BASINS, OR MANHOLES, CLASS II	604.415	-			
	20						20		MGAL	DUST CONTROL WITH WATER	609.10	4			
				40			40		CY	STONE FILL, TYPE I	613.10	2			
				70			70		CY	STONE FILL, TYPE II	613.11	3			
	150						150		LF	TREATED TIMBER CURB	616.35	28			
	30						30		LF	REMOVING AND RESETTING CURB	616.40	4			
	9						9		EACH	YIELDING MARKER POSTS	619.17	-			
	45						45		LF	CHAIN-LINK FENCE, 4 FEET	620.11	4			
	70						70		LF	REMOVING AND RESETTING FENCE	620.50	5			
	275						275		LF	REMOVE AND RESET GUARDRAIL	621.75	25			
	300						300		LF	TEMPORARY TRAFFIC BARRIER	621.90	38			
	300						300		LF	REMOVE AND RESET TEMPORARY TRAFFIC BARRIER	621.95	46			
	40						40		LF	PVC SEWER PIPE (8")	628.35	1.5			
	1						1		LS	TRANSFER TO NEW SYSTEM, SANITARY SEWER	628.42	-			
	70						70		LF	DUCTILE IRON PIPE, CEMENT-LINED (12")	629.24	4			
	1						1		LS	TRANSFER TO NEW SYSTEM, WATER SYSTEM	629.42	-			
	850	100					950		TON	CRUSHED STONE BEDDING	629.54	35			
	128						128		HR	UNIFORMED TRAFFIC OFFICERS	630.10	EST			
	400						400		HR	FLAGGERS	630.15	EST			
						1	1		LS	FIELD OFFICE, ENGINEERS	631.10	-			
						3000	3000		DL	FIELD OFFICE TELEPHONE (N.A.B.I.)	631.26	-			
	1						1		LS	MOBILIZATION/DEMobilIZATION (PARTICIPATING)	635.11	-			
	1						1		LS	TRAFFIC CONTROL	641.10	-			
	120						120		DAY	PORTABLE CHANGEABLE MESSAGE SIGN RENTAL	641.17	EST			
	700						700		LF	DURABLE 4 INCH WHITE LINE, THERMOPLASTIC	646.402	33			
	1100						1100		LF	DURABLE 4 INCH YELLOW LINE, THERMOPLASTIC	646.412	16			
	300						300		LF	DURABLE 6 INCH YELLOW LINE, THERMOPLASTIC	646.432	12			
	3000						3000		LF	TEMPORARY 4 INCH WHITE LINE, PAINT	646.602	18			
	3250						3250		LF	TEMPORARY 4 INCH YELLOW LINE, PAINT	646.612	10			
	1050						1050		LF	TEMPORARY 6 INCH YELLOW LINE, PAINT	646.632	42			
	40						40		LF	TEMPORARY 24 INCH STOP BAR, PAINT	646.682	4			
	560						560		SF	REMOVAL OF EXISTING PAVEMENT MARKINGS	646.85	7			
	680						680		SF	PAVEMENT MARKING MASK	646.86	1			
				1550			1550		SY	GEOTEXTILE UNDER STONE FILL	649.31	49			
				50			50		SY	GEOTEXTILE FOR FILTER CURTAIN	649.61	14			
				25	25		50		LB	SEED	651.15	37			
				25	25		50		LB	SEED, WINTER RYE	651.17	37			
				50	50		100		LB	FERTILIZER	651.18	46			
				0.2	0.1		0.3		TON	AGRICULTURAL LIMESTONE	651.20	0.09			

PROJECT NAME: PERU  
PROJECT NUMBER: STP SCRP(4)

FILE NAME: z07b106qty.dgn  
PROJECT LEADER: E. ATKINS  
DESIGNED BY: M. BRADLEY  
QUANTITY SHEET 2

PLOT DATE: 12/31/2014  
DRAWN BY: M. BRADLEY  
CHECKED BY: E. ATKINS  
SHEET 22 OF 45

# QUANTITY SHEET 3

SUMMARY OF ESTIMATED QUANTITIES							TOTALS		DESCRIPTIONS				DETAILED SUMMARY OF QUANTITIES		
	ROADWAY	ROADWAY (NO FEDERAL/STATE)	LANDSCAPING (NO FEDERAL/STATE)	EROSION CONTROL	EROSION CONTROL (NO FEDERAL/STATE)	FULL C.E. ITEMS	GRAND TOTAL	FINAL	UNIT	ITEMS	ITEM NUMBER	ROUND	QUANTITIES	UNIT	ITEMS
				0.2	0.1		0.3		TON	HAY MULCH	651.25	0.09			
				20	10		30		CY	TOPSOIL	651.35	1			
				1			1		LS	EPSC PLAN	652.10	-			
				200			200		HR	MONITORING EPSC PLAN	652.20	EST			
				1			1		LU	MAINTENANCE OF EPSC PLAN (N.A.B.I.)	652.30	-			
				200			200		SY	TEMPORARY EROSION MATTING	653.20	10			
				80			80		CY	VEHICLE TRACKING PAD	653.35	EST			
				600			600		LF	BARRIER FENCE	653.50	50			
				1025	400		1425		LF	PROJECT DEMARCATION FENCE	653.55	35			
			3				3		EACH	EVERGREEN TREES (ABIES BALSAMEA)(BALSAM FIR)(B&B)(7-8 FEET)	656.20	-			
			9				9		EACH	DECIDUOUS SHRUBS (CLETHRA ALNIFOLIA 'HUMMINGBIRD')(HUMMING BIRD SUMMERSWEET)(CONT)(2-2.5 FEET)	656.35	-			
			7				7		EACH	DECIDUOUS SHRUBS (CORNUS ALBA 'ARGENTEO-MARGINALA')(VARIGATED RED TWIG DOGWOOD)(B&B)(3-4 FEET)	656.35	-			
			4				4		EACH	DECIDUOUS SHRUBS (JUNIPERUS CHINENSIS 'SEA GREEN')(SEAGREEN JUNIPER)(CONT)(2-2.5 FEET)	656.35	-			
			5				5		MGAL	LANDSCAPE WATERING	656.65	0.5			
			12				12		CY	LANDSCAPE BACKFILL, TRUCK MEASUREMENT	656.80	0.2			
	36						36		LF	SQUARE TUBE SIGN POST AND ANCHOR	675.341	EST			
	7						7		EACH	REMOVING SIGNS	675.50	-			
	7						7		EACH	ERECTING SALVAGED SIGNS	675.60	-			
		500					500		LF	ELECTRICAL CONDUIT (4") (PVC)	678.21	17			
		6					6		EACH	PULL BOX, STANDARD	678.25	-			
		150					150		LF	ELECTRICAL CONDUIT SLEEVE (8") (PVC)	678.30	1			
	1						1		EACH	TEMPORARY TRAFFIC SIGNAL SYSTEM	678.40	-			
	1						1		LU	PRICE ADJUSTMENT, FUEL (N.A.B.I.)	690.50	-			
	1	1					2		LS	SPECIAL PROVISION (DECOMMISSION PIPE)	900.645	-			
			1				1		LS	SPECIAL PROVISION (LANDSCAPE AREA RESTORATION)	900.645	-			
	1						1		LS	SPECIAL PROVISION (STAFF GAUGE)	900.645	-			
	1						1		LS	SPECIAL PROVISION (STOP LOG SYSTEM)	900.645	-			
	1						1		LU	SPECIAL PROVISION (MAT DENSITY PAY ADJUSTMENT, SMALL QUANTITY) (N.A.B.I.)	900.650	-			
	1						1		LU	SPECIAL PROVISION (MIXTURE PAY ADJUSTMENT)(N.A.B.I.)	900.650	-			
			1050				1050		SF	SPECIAL PROVISION (REMOVE AND RESET CONCRETE PAVERS)	900.670	49			
	10						10		SY	SPECIAL PROVISION (PORTLAND CEMENT CONCRETE ISLAND TREATMENT, 4 INCH)	900.675	2			
	460						460		TON	SPECIAL PROVISION (BITUMINOUS CONCRETE PAVEMENT, SMALL QUANTITY)	900.680	11			

PROJECT NAME: PERU  
PROJECT NUMBER: STP SCR(4)

FILE NAME: z07bi06qty.dgn  
PROJECT LEADER: E. ATKINS  
DESIGNED BY: M. BRADLEY  
QUANTITY SHEET 3

PLOT DATE: 12/31/2014  
DRAWN BY: M. BRADLEY  
CHECKED BY: E. ATKINS  
SHEET 23 OF 45





**COLD PLANING, BITUMINOUS CONCRETE**  
 32+22.7 - 32+97.7  
 34+16.7 - 34+91.66

**TREATED TIMBER CURB**  
 32+97.7 LT - 34+16.7 LT

**REMOVING AND RESETTING FENCE**  
 14+05.0 LT - 14+22.6 RT  
 14+51.3 LT - 14+58.8 RT

**REMOVE AND RESET GUARDRAIL** **EXISTING RAIL WAS IN POOR CONDITION**  
 32+94.6 RT - 34+19.6 RT  
 32+94.6 LT - 34+19.6 LT

**SPECIAL PROVISION (REMOVE AND RESET CONCRETE PAVERS)**  
 13+28.6 RT - 14+17.9 RT

**AGGREGATE SHOULDERS, IN PLACE**  
 32+47.7 - 32+97.7  
 34+16.7 - 34+66.7

**REMOVING AND RESETTING CURB**  
 16+65.7 LT - 12+59.9 RT  
 12+71.9 LT - 12+66.0 RT

**STONE FILL, TYPE II**  
 9+64.4 LT - RT - 10+26.9 LT - RT

**SPECIAL PROVISION (PORTLAND CEMENT CONCRETE ISLAND TREATMENT, 4 INCH)**  
 12+59.9 RT - 12+71.9 LT

**SPECIAL PROVISION (LANDSCAPE AREA RESTORATION)**  
 13+35.5 RT - 13+97.3 RT

**REHAB. DROP INLETS, CATCH BASINS, OR MANHOLES, CLASS II**  
 14+07.1 LT


**CHAIN LINK FENCE, 4 FEET**  
 10+02.3 LT - 10+06.6

**NOTES:**

- SEE TRAFFIC SIGNS AND MARKINGS SHEET FOR PAVEMENT MARKING INFORMATION
- REFER TO LANDSCAPE PLAN SHEET FOR MORE INFORMATION
- THE WORK ADJACENT TO THE POND IS ANTICIPATED TO BE COMPLETED IN THE DRY WHEN THE POND IS DRAINED OR LOW. THE CONTRACTOR SHALL COORDINATE WITH BROMLEY SKI RESORT.
- CONTRACTOR SHALL LEAVE EXCAVATION SUPPORT IN PLACE AND BACKFILL USING CONTROLLED DENSITY (FLOWABLE) FILL, SEE DETAILS AND PIPE INSTALLATION NOTES

RETAIN EXISTING PIPE  
 WEIR WALL ADDED TO STRUCTURE 1


- 9+92.7 LT - 14+82.6 LT  
EXISTING 42" PCCSP - SPECIAL PROVISION (DECOMMISSION PIPE)
- 14+82.6 LT - 16+00.0 LT  
EXISTING 42" PCCSP - RETAIN
- 11+26.2 RT - 11+45.5 RT  
EXISTING 15" PCCSP - RETAIN PIPE  
EXISTING DI @ 11+45.5 RT - PROTECT AND ADJUST STRUCTURE
- 14+22.6 LT - 14+50.6 RT  
EXISTING 12" CPEP - REMOVE  
EXISTING DI @ 14+50.6 RT - REMODEL
- 14+50.6 RT - 14+43.2 RT  
EXISTING 24" CPEP - RETAIN  
EXISTING DI @ 14+43.2 RT - RETAIN
- 10+45.5 RT - 9+50.0 RT  
EXISTING 42" CGMP - REMOVE 20' OF EXISTING PIPE
- 14+07.1 LT - UNK  
ABANDON EXISTING 12" CPEP - RETAIN EXISTING DI

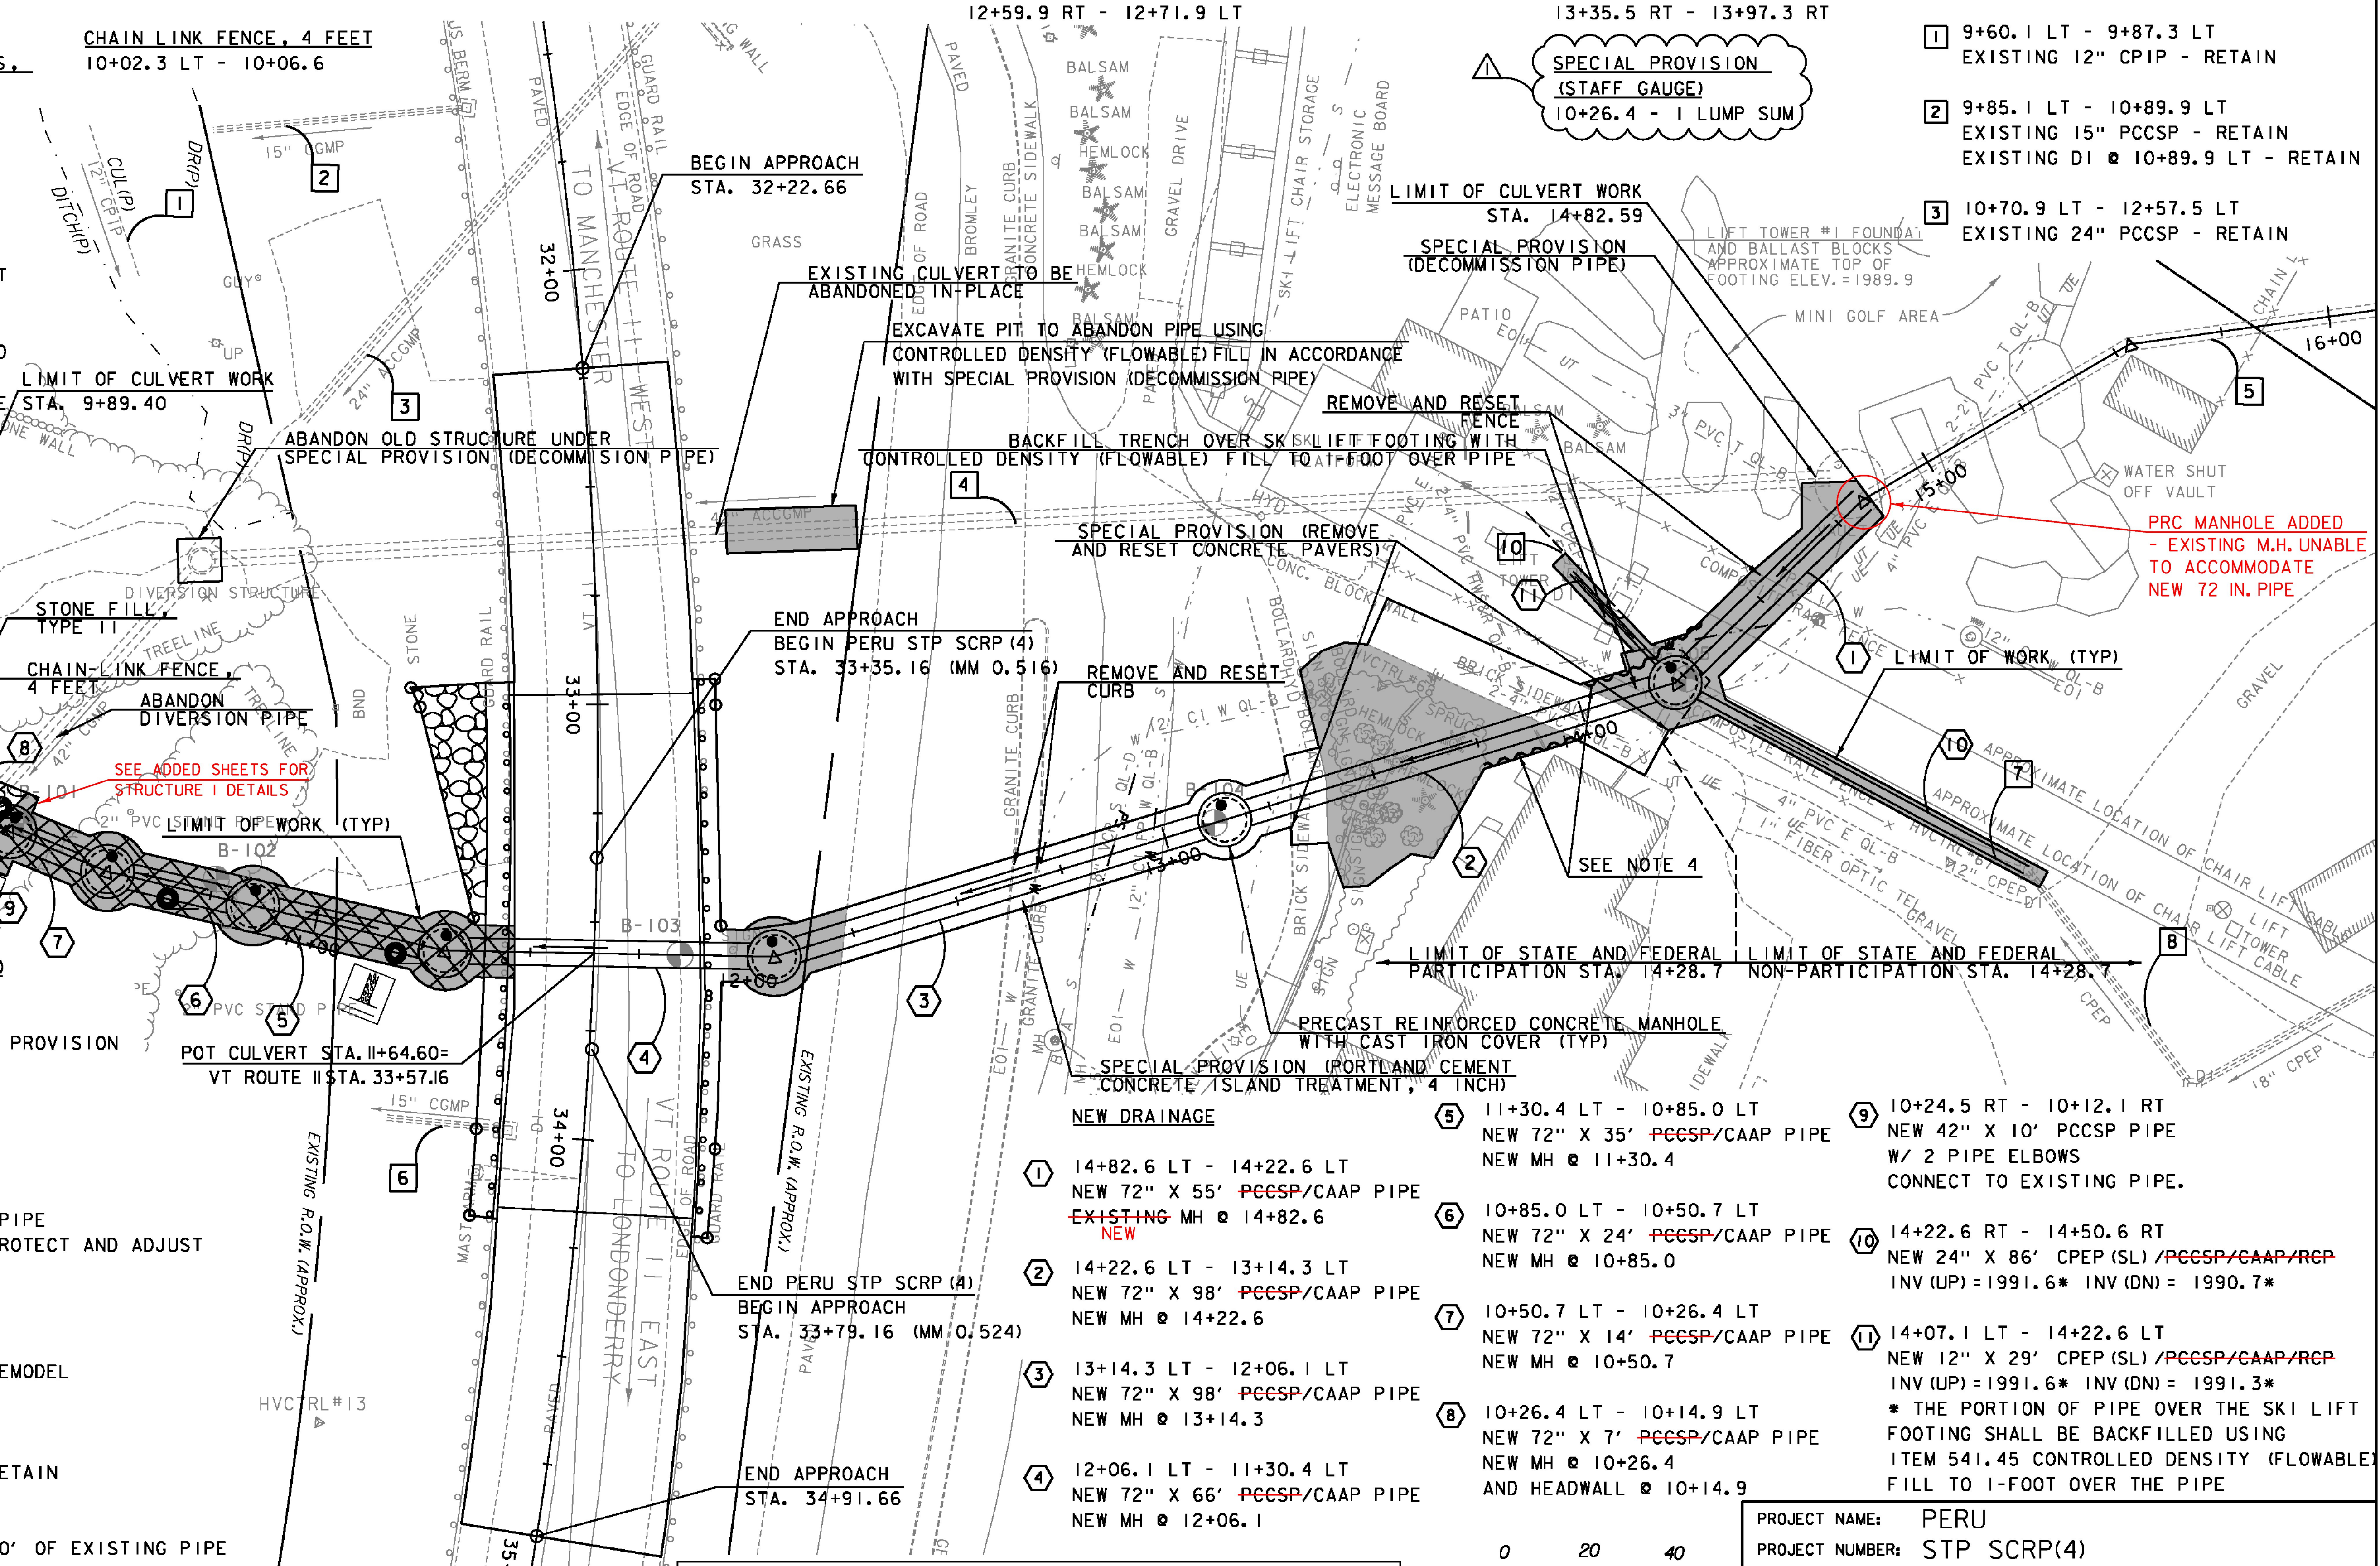

- EXISTING DRAINAGE**
- 9+60.1 LT - 9+87.3 LT  
EXISTING 12" CP-IP - RETAIN
  - 9+85.1 LT - 10+89.9 LT  
EXISTING 15" PCCSP - RETAIN  
EXISTING DI @ 10+89.9 LT - RETAIN
  - 10+70.9 LT - 12+57.5 LT  
EXISTING 24" PCCSP - RETAIN

PRC MANHOLE ADDED - EXISTING M.H. UNABLE TO ACCOMMODATE NEW 72 IN. PIPE

REVISION	BY	DATE
▲ ADDED CONSTRUCTION NOTE FOR SPECIAL PROVISION (STAFF GAUGE)	MAB	2/10/2015

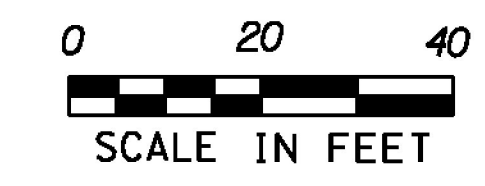


GREEN INTERNATIONAL AFFILIATES, INC.  
 CIVIL AND STRUCTURAL ENGINEERS

PROJECT NAME: PERU  
 PROJECT NUMBER: STP SCR(4)  
 FILE NAME: z07b106bdr.dgn  
 PROJECT LEADER: E. ATKINS  
 DESIGNED BY: M. BRADLEY  
 PLAN SHEET

PLOT DATE: 12/31/2014  
 DRAWN BY: M. BRADLEY  
 CHECKED BY: E. ATKINS  
 SHEET 26 OF 45

**GENERAL LANDSCAPE NOTES:**

1. SEE EPSC SHEETS FOR SEEDING FORMULAS, FERTILIZER APPLICATION RATES, MULCH REQUIREMENTS ETC.
2. LANDSCAPE BACKFILL, TRUCK MEASUREMENT BACKFILL WITH PLANTING MIX OF 1/2 SCREENED TOPSOIL, 1/4 COMPOST AND 1/4 NATIVE MATERIAL AS APPROVED BY THE ENGINEER. UNSUITABLE NATIVE MATERIAL SHALL BE REPLACED WITH IMPORTED APPROVED TOPSOIL AS DIRECTED BY ENGINEER.
3. WATERING SHRUBS TO RECEIVE A MINIMUM OF 5 GALLONS AT EACH WATERING, TWICE WEEKLY DURING ESTABLISHMENT PERIOD. TREES TO RECEIVE A MINIMUM OF 10 GALLONS AT EACH WATERING, TWICE WEEKLY DURING ESTABLISHMENT PERIOD. CONTRACTORS SHALL MAINTAIN AND PROVIDE A LOG TO THE RESIDENT ENGINEER SHOWING AMOUNTS AND DATES OF WATERING AND NOTING NATURAL RAINFALL EVENTS. WATERING SCHEDULE MAY BE ADJUSTED AS APPROVED BY THE RESIDENT ENGINEER.
4. BARK MULCH SHALL BE CEDAR AND PROVIDED IN ACCORDANCE WITH SUBSECTION 755.10 (C).
5. PAYMENT FOR CEDAR BARK MULCH, LANDSCAPE STONE, AND LANDSCAPE BOULDERS SHALL BE CONSIDERED INCIDENTAL TO SPECIAL PROVISION (LANDSCAPE AREA RESTORATION).

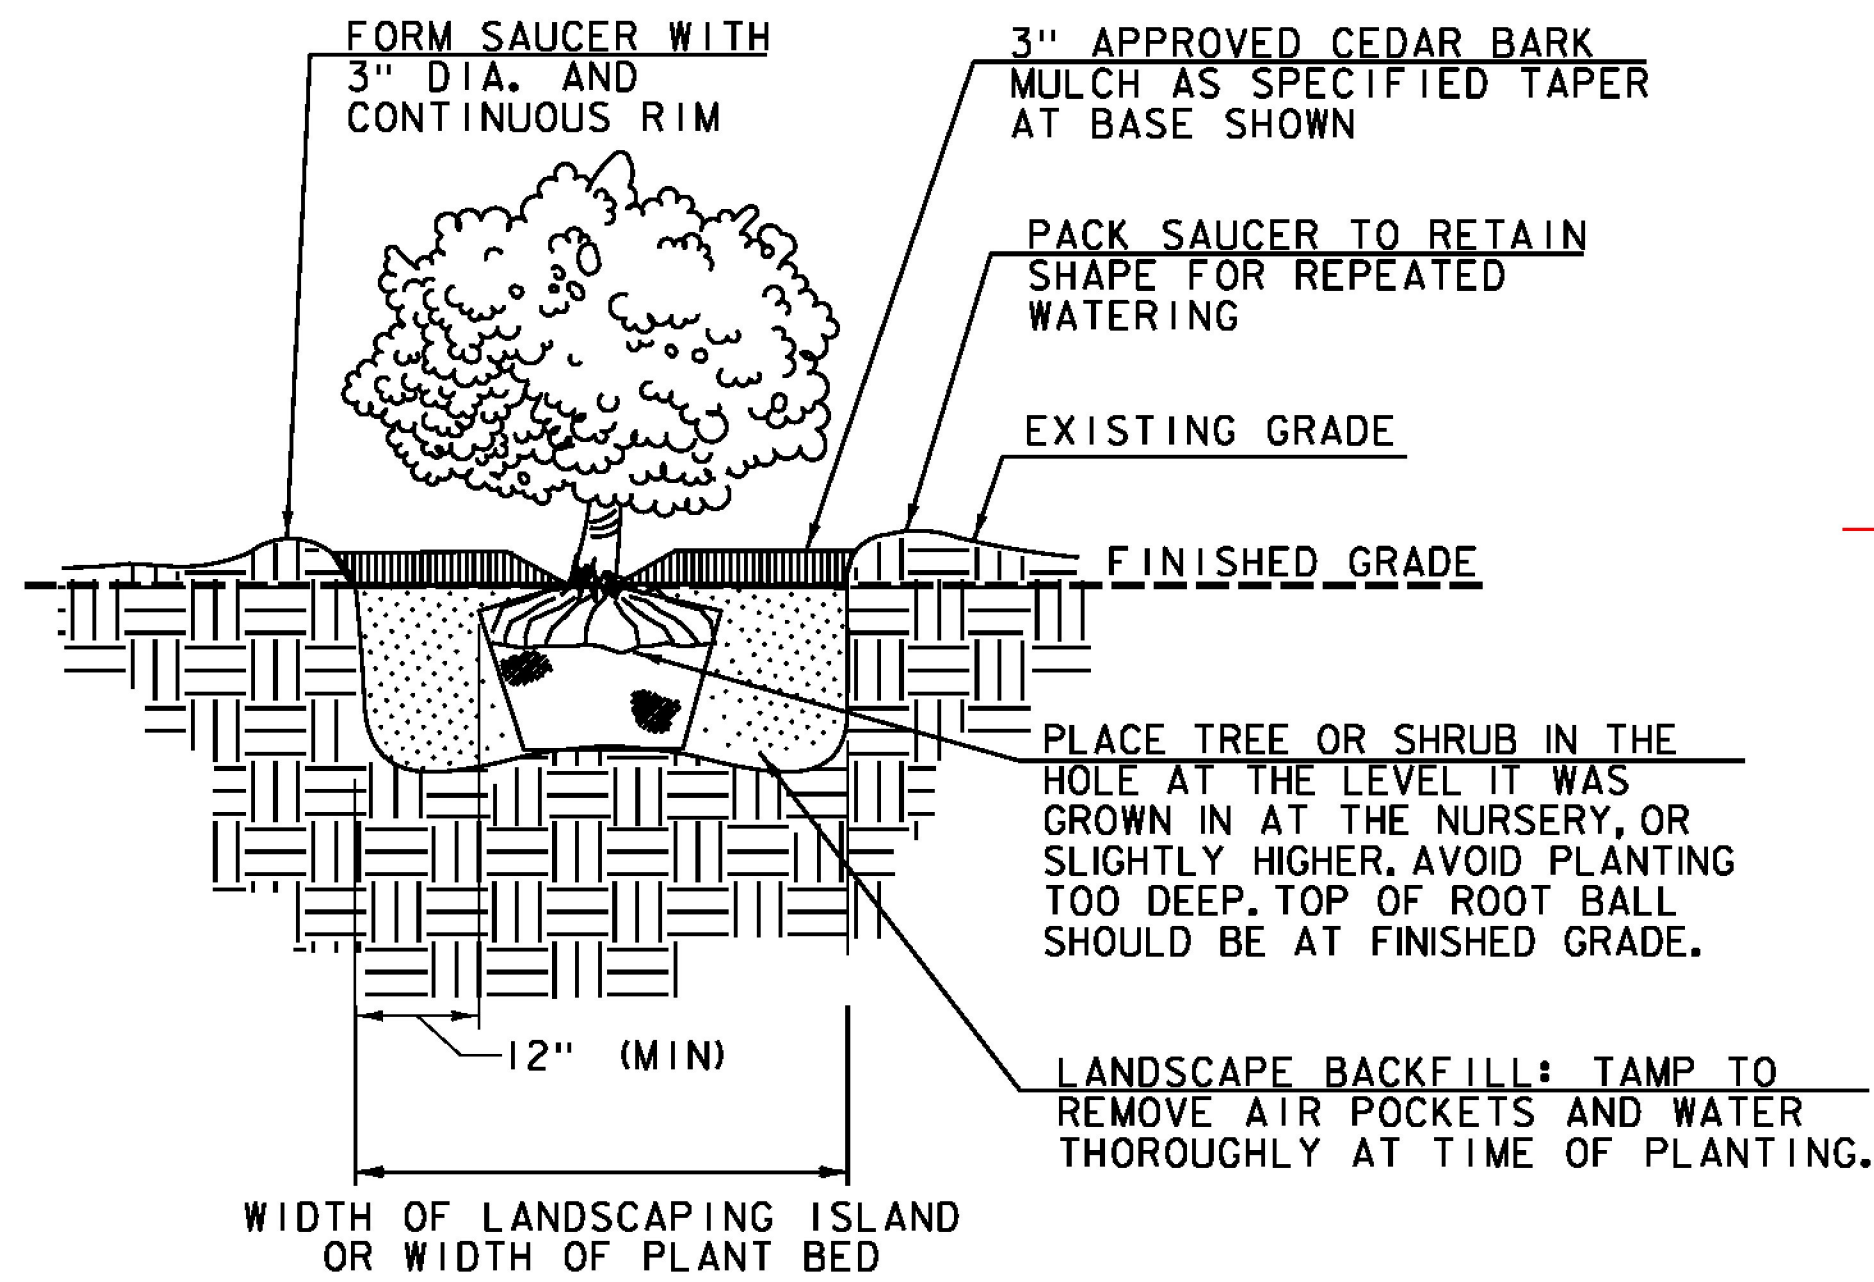


**SHRUB PLANTING DETAIL**  
SCALE: NOT TO SCALE

**PLANT LIST**

QTY.	SIZE	COMMON NAME / AREA	BOTANICAL NAME	SPACING/COMMENTS	
EVERGREEN TREES					
1	3	7-8 FEET HEIGHT	BALSAM FIR	ABIES BALSAMEA	BALL AND BURLAP (B&B)
9	2-2.5 FEET SPREAD	HUMMING BIRD SUMMERSWEET	CLETHRA ALNIFOLIA 'HUMINGBIRD'	CONTAINER (CONT)	
7	3-4 FEET HEIGHT	VARIGATED REDTWIG DOGWOOD	CORNUS ALBA 'ARGENTEO-MARGINALA'	BALL AND BURLAP (B&B)	
4	2-2.5 FEET SPREAD	SEAGREEN JUNIPER	JUNIPERUS CHINENSIS 'SEA GREEN'	CONTAINER (CONT)	



B&B = BALL AND BURLAP

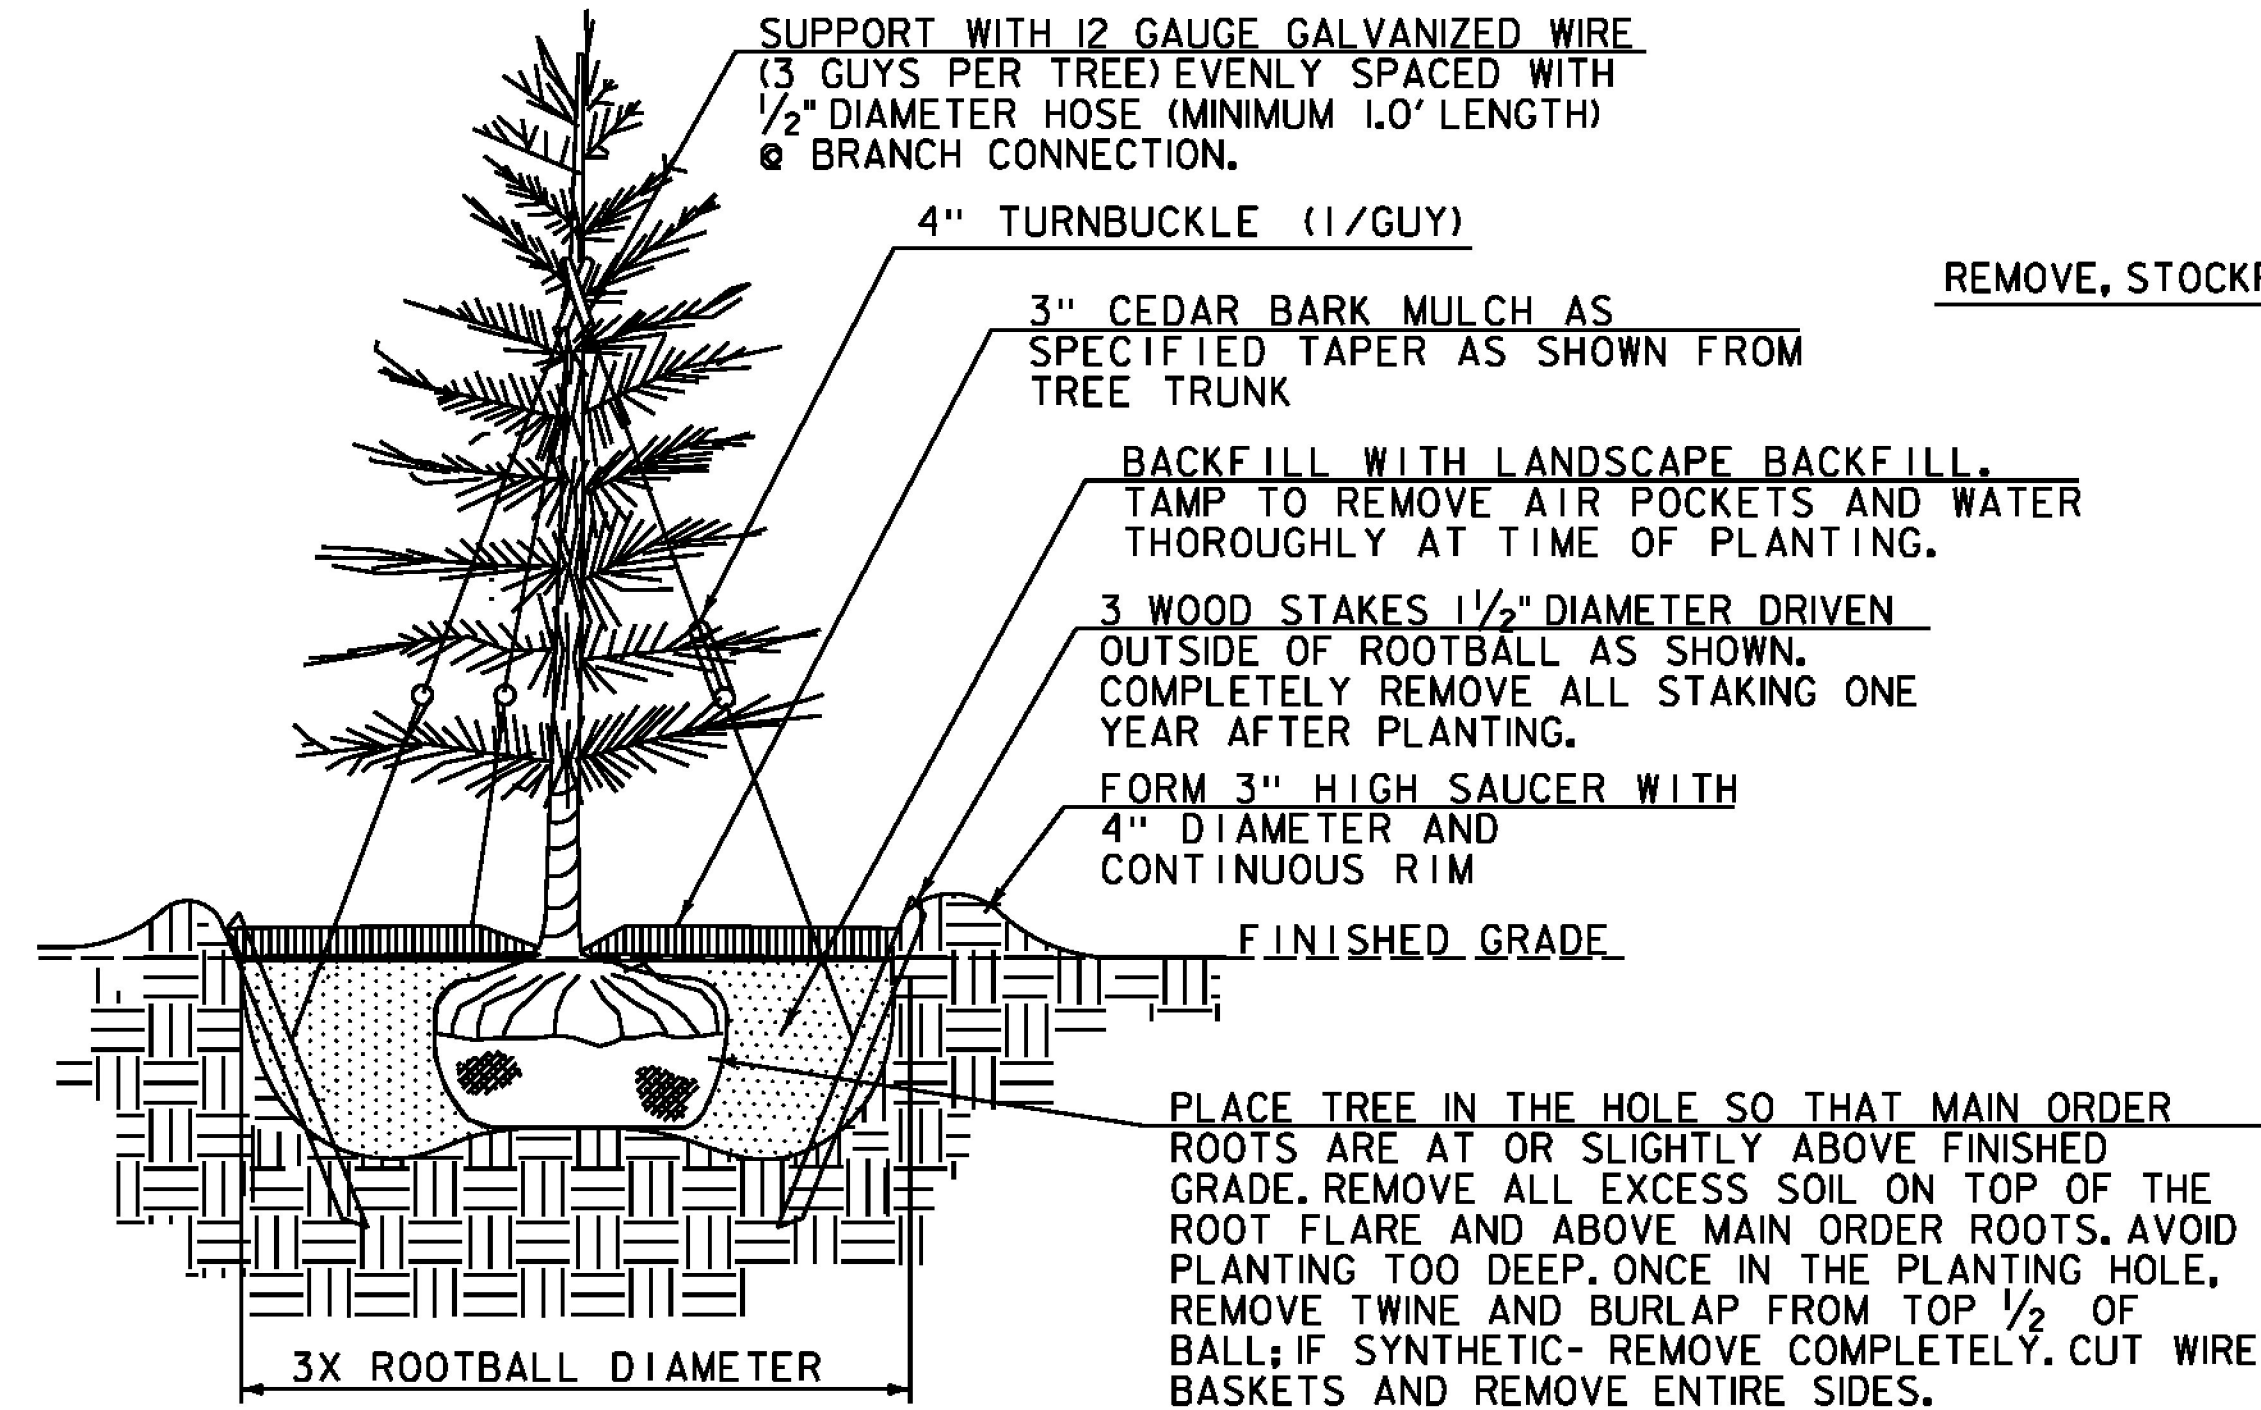

**EVERGREEN TREE PLANTING DETAIL**  
SCALE: NOT TO SCALE

**NOTES:**

1. ANTI-DESICCANT SPRAY IS TO BE APPLIED TO ALL EVERGREENS PER MANUFACTURER SPECIFICATIONS.
2. COMPLETELY REMOVE ALL GUY-WIRES AND TURNBUCKLE ONE YEAR AFTER PLANTING.

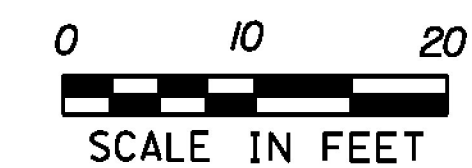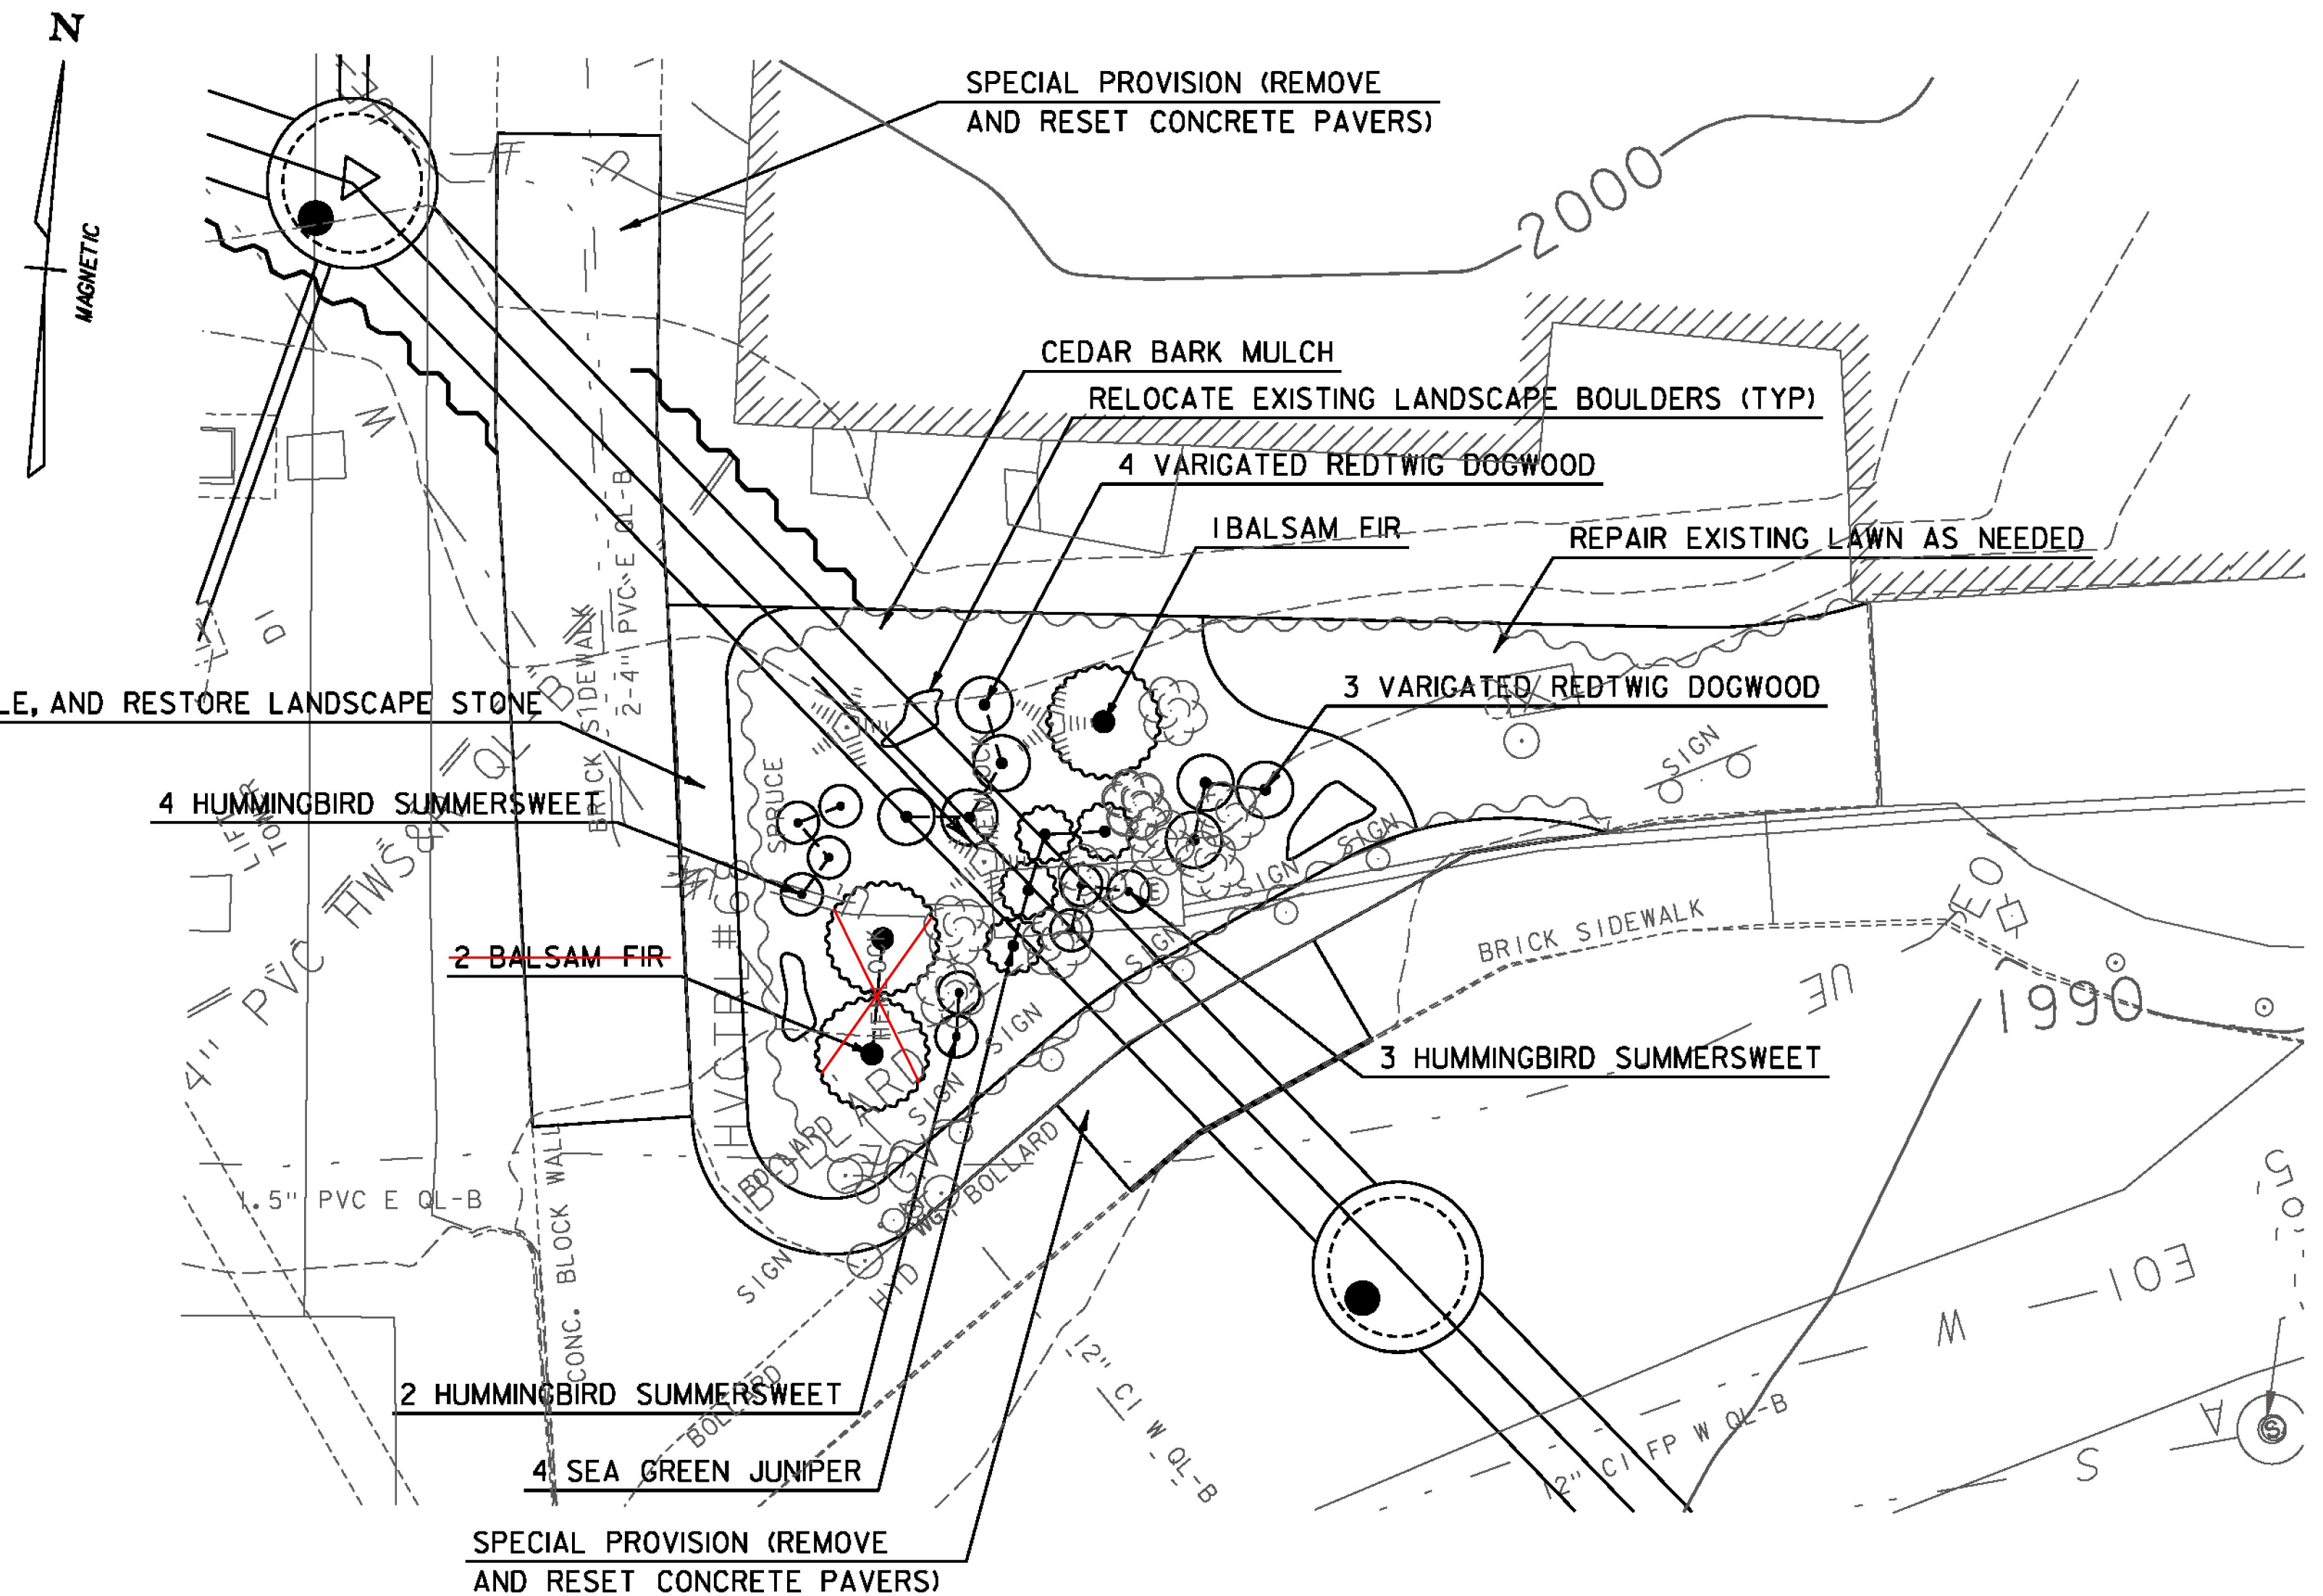

GREEN INTERNATIONAL AFFILIATES, INC.  
CIVIL AND STRUCTURAL ENGINEERS

PROJECT NAME: PERU  
PROJECT NUMBER: STP SCRP(4)

FILE NAME: z07b106landbdr.dgn  
PROJECT LEADER: E. ATKINS  
DESIGNED BY: J. RIEMENSCHNEIDER  
LANDSCAPE PLAN SHEET

PLOT DATE: 12/31/2014  
DRAWN BY: D. VERTIYEV  
CHECKED BY: E. ATKINS  
SHEET 27 OF 45

**NOTES:**

- 1.) UTILITIES CROSSING THE TRENCH SHALL BE SUPPORTED IN PLACE DURING CONSTRUCTION. PAYMENT FOR UTILITY SUPPORT SHALL BE INCIDENTAL TO THE CONTRACT.
- 2.) UTILITIES TO BE REPLACED SHALL BE BYPASSED DURING CONSTRUCTION. BYPASS SHALL BE PAID FOR UNDER ITEMS 628.42, TRANSFER TO NEW SYSTEM, SANITARY SEWER AND 629.42, TRANSFER TO NEW SYSTEM, WATER SYSTEM.
- 3.) AFTER CULVERT INSTALLATION AND BEFORE PLACEMENT OF GRANULAR BACKFILL FOR STRUCTURES, THE CONTRACTOR SHALL INSTALL NEW PIPE IN PLACE OF THE BYPASSED SYSTEM.
- 4.) SEE THE UTILITIES SPECIAL PROVISIONS FOR ADDITIONAL INFORMATION AND REQUIREMENTS.




~~PVC SEWER PIPE (8") (PARTICIPATING)~~  
~~12+76.2 RT - 12+97.7 LT NOT DONE~~

DUCTILE IRON PIPE, CEMENT-LINED  
(12") (PARTICIPATING)  
 12+66.4 RT - 12+73.4 LT  
 12+95.1 RT - 13+00.0 LT  
 14+12.9 LT - 14+47.9 RT

ELECTRICAL CONDUIT (4") (PVC) (NON-PARTICIPATING)  
 11+38.6 RT - 12+11.4 RT 73'  
 11+39.4 RT - 12+10.3 RT 71'  
 12+13.3 RT - 13+81.4 RT 168'  
 12+11.8 RT - 13+78.1 RT 166'

PULL BOX, STANDARD (NON-PARTICIPATING)  
 11+37.6 RT  
 11+38.4 RT  
 12+12.4 RT  
 12+11.3 RT  
 13+82.4 RT  
 13+79.1 RT


ELECTRICAL CONDUIT SLEEVE (8") (PVC) (NON-PARTICIPATING)  
 11+38.6 RT - 12+11.4 RT 75'  
 11+39.4 RT - 12+10.3 RT 74'

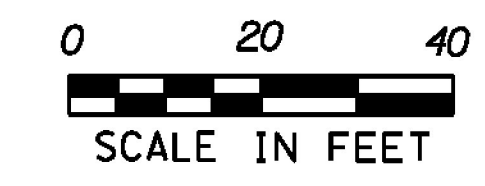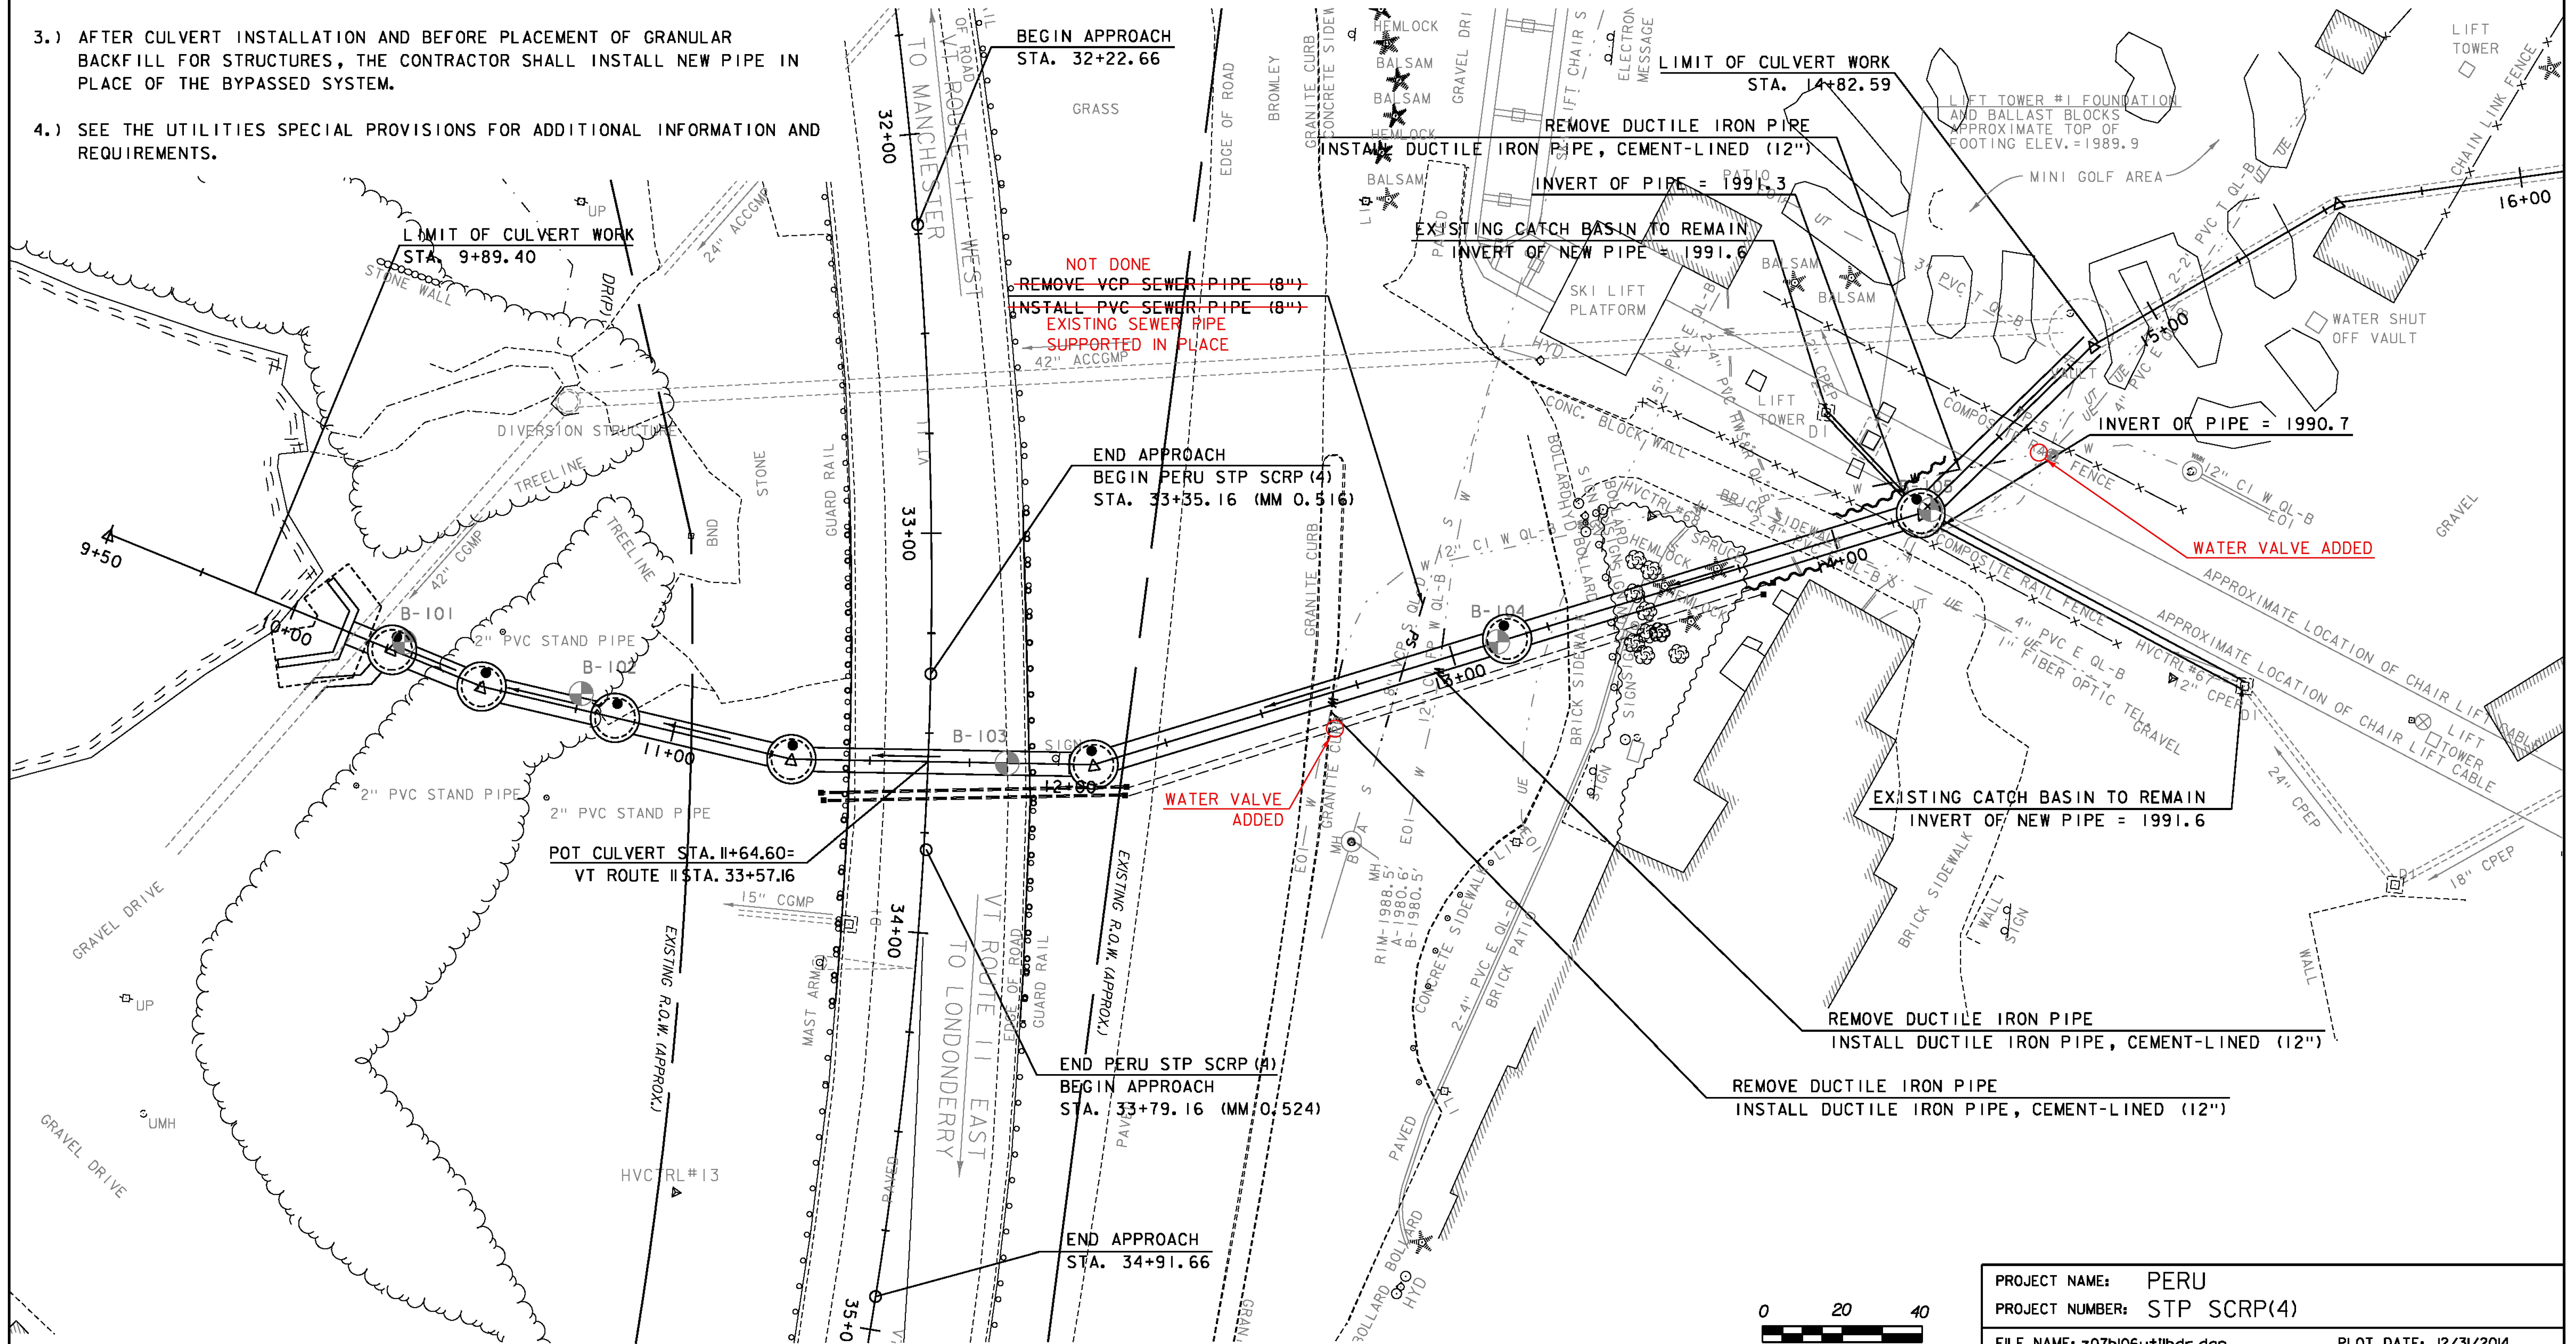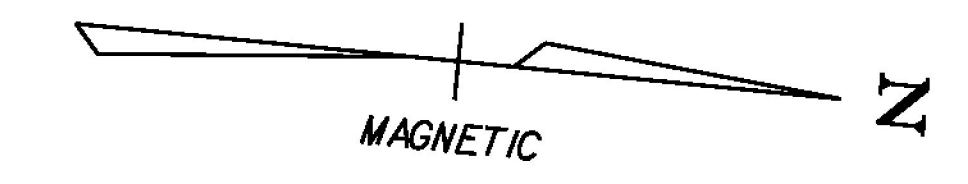

SCALE IN FEET  
 GREEN INTERNATIONAL AFFILIATES, INC.  
 CIVIL AND STRUCTURAL ENGINEERS

PROJECT NAME:	PERU
PROJECT NUMBER:	STP SCRP(4)
FILE NAME:	z07b106ut11bdr.dgn
PROJECT LEADER:	E. ATKINS
DESIGNED BY:	M. BRADLEY
UTILITY PLAN SHEET	
PLOT DATE:	12/31/2014
DRAWN BY:	M. BRADLEY
CHECKED BY:	E. ATKINS
SHEET	28 OF 45

# PROPOSED CULVERT

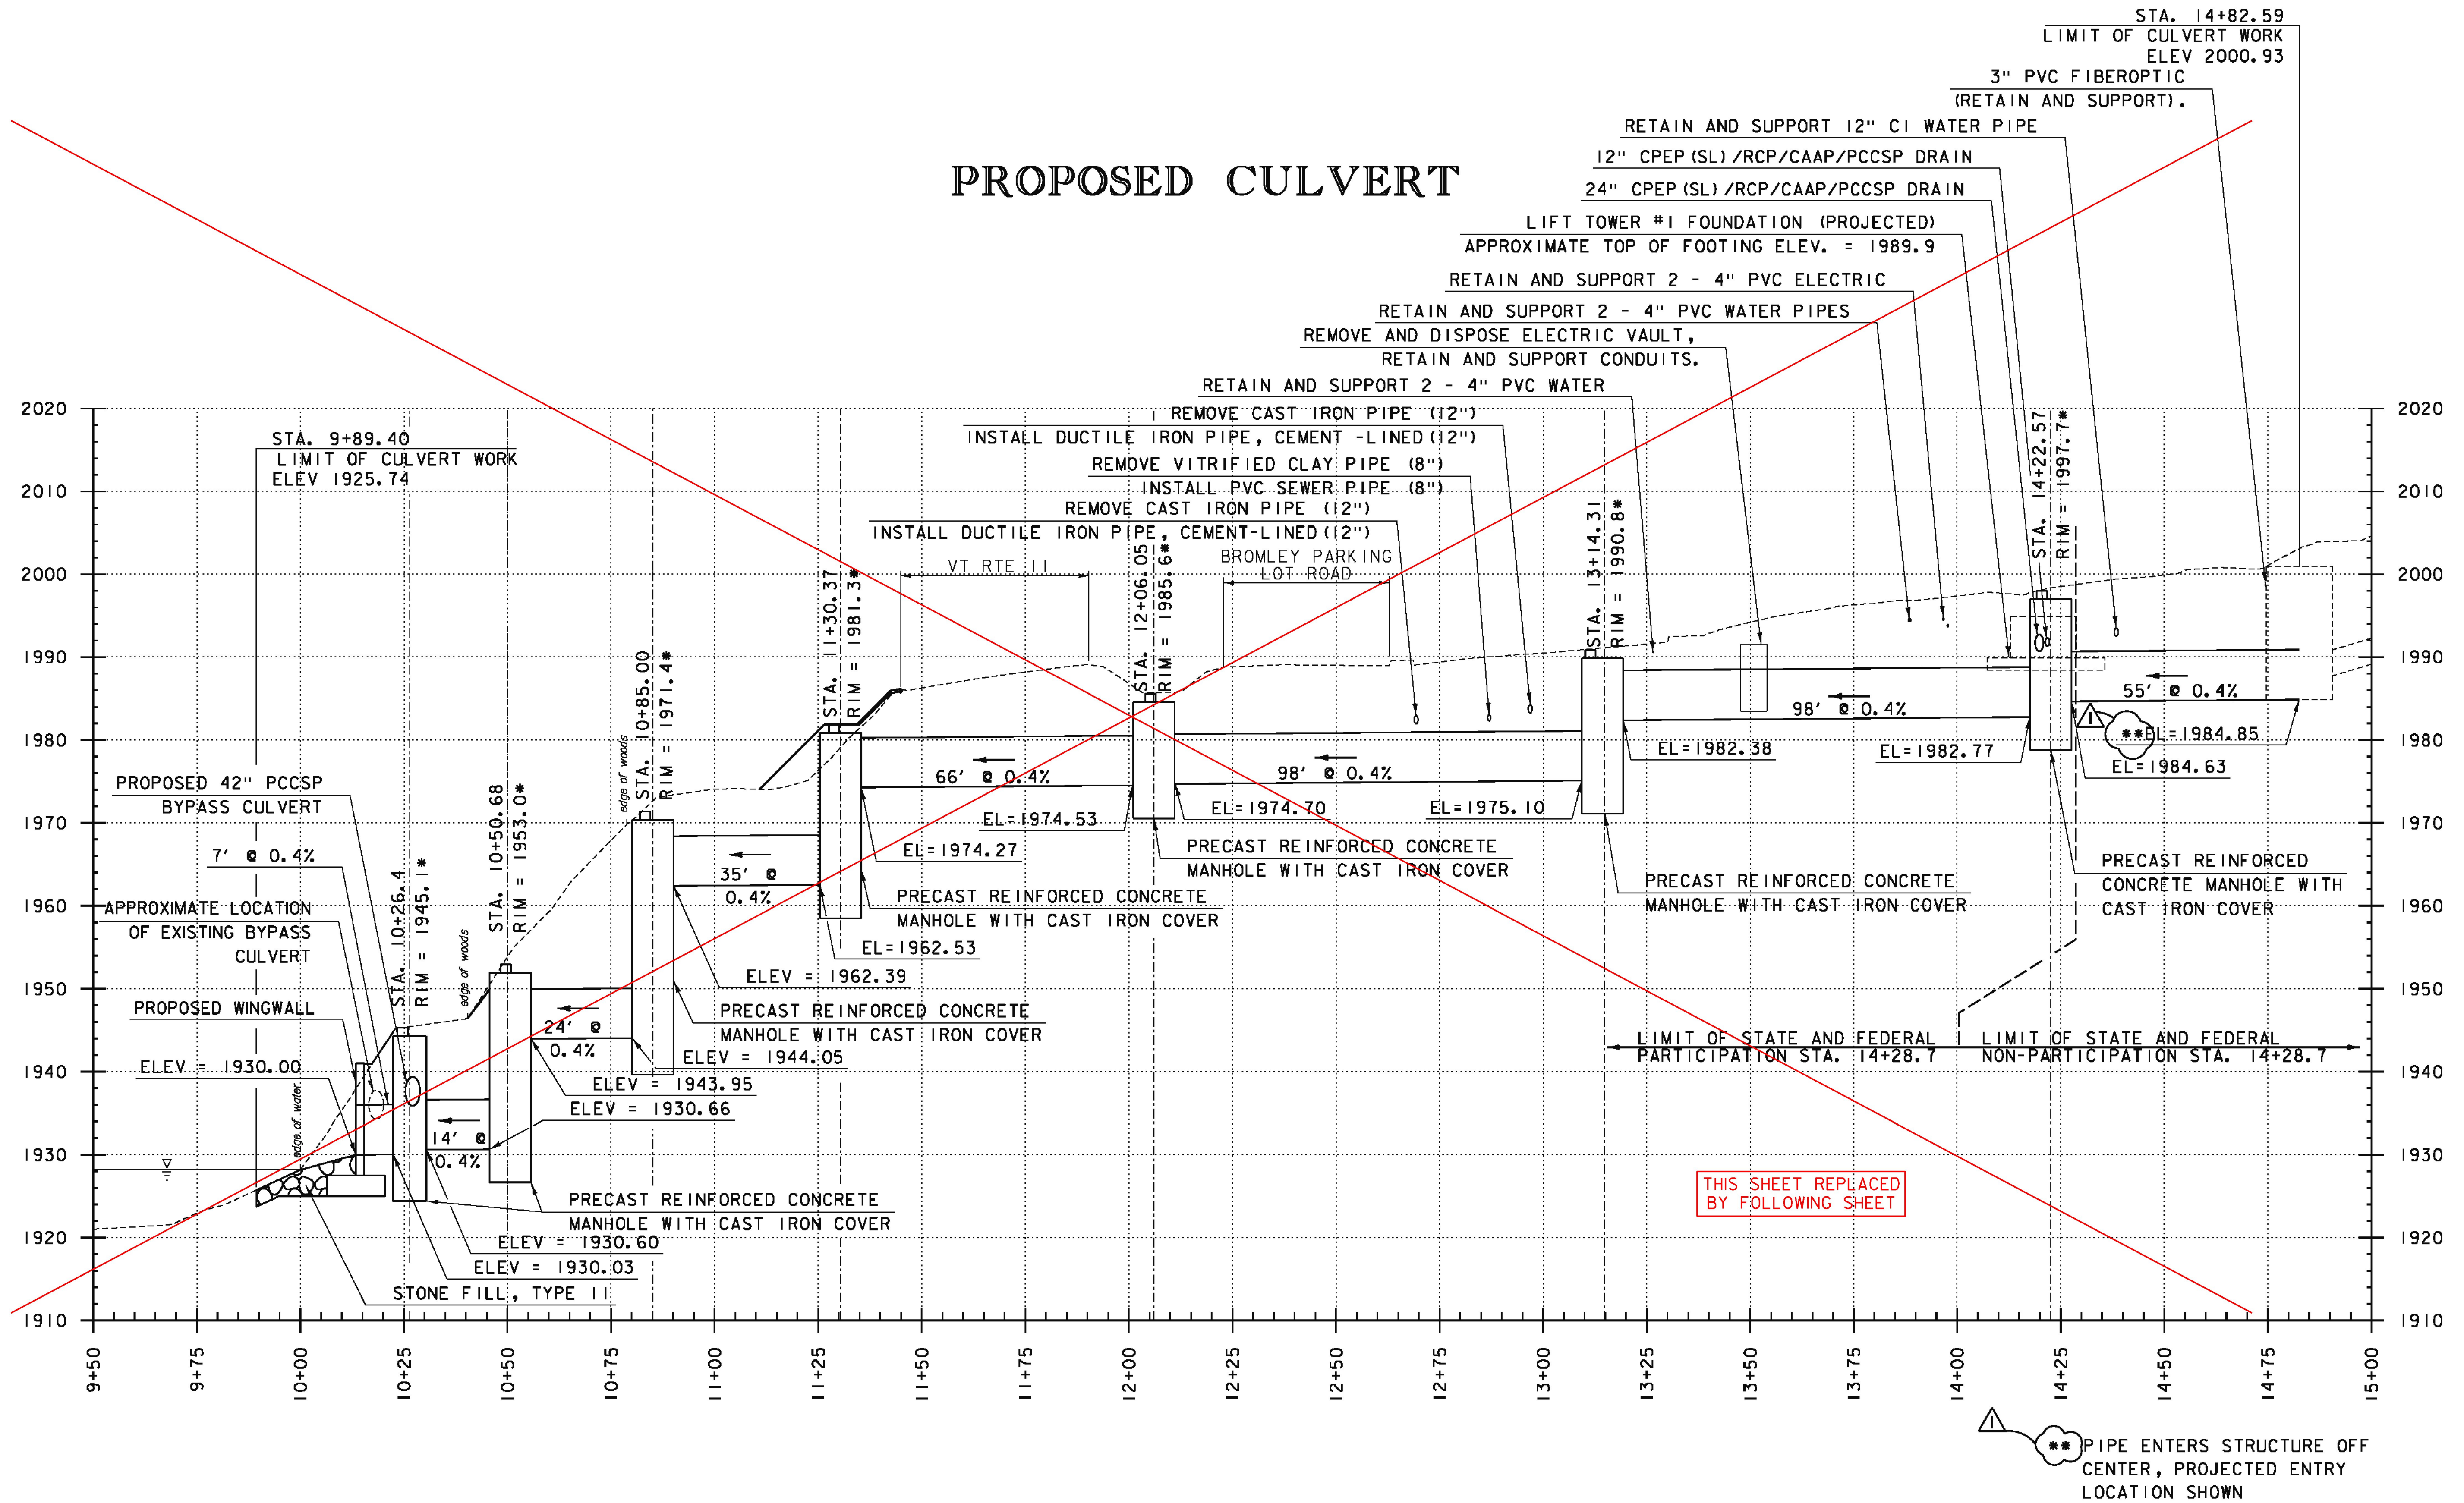

THIS SHEET REPLACED BY FOLLOWING SHEET

REVISION	BY	DATE
△ SECOND ASTERISK WAS ADDED TO NOTE AND ELEVATION CALLOUT	MAB	2/10/2015


PROJECT NAME:	PERU
PROJECT NUMBER:	STP SCR(4)
FILE NAME:	z07b106xsl.dgn
PROJECT LEADER:	E. ATKINS
DESIGNED BY:	M. BRADLEY
PLOT DATE:	12/31/2014
DRAWN BY:	M. BRADLEY
CHECKED BY:	E. ATKINS
PROFILE SHEET 1	SHEET 29 OF 45

*RIM ELEVATIONS ARE APPROXIMATE AND SHALL BE ADJUSTED TO MEET THE GRADE AS NECESSARY. SEE SHEET 8 FOR ADDITIONAL REQUIREMENTS.

MANHOLE STRUCTURES ARE SHOWN PICTORIALLY FOR INFORMATION ONLY. ACTUAL SHAPE AND SIZE TO BE DETERMINED BY THE CONTRACTOR.



# PROPOSED CULVERT

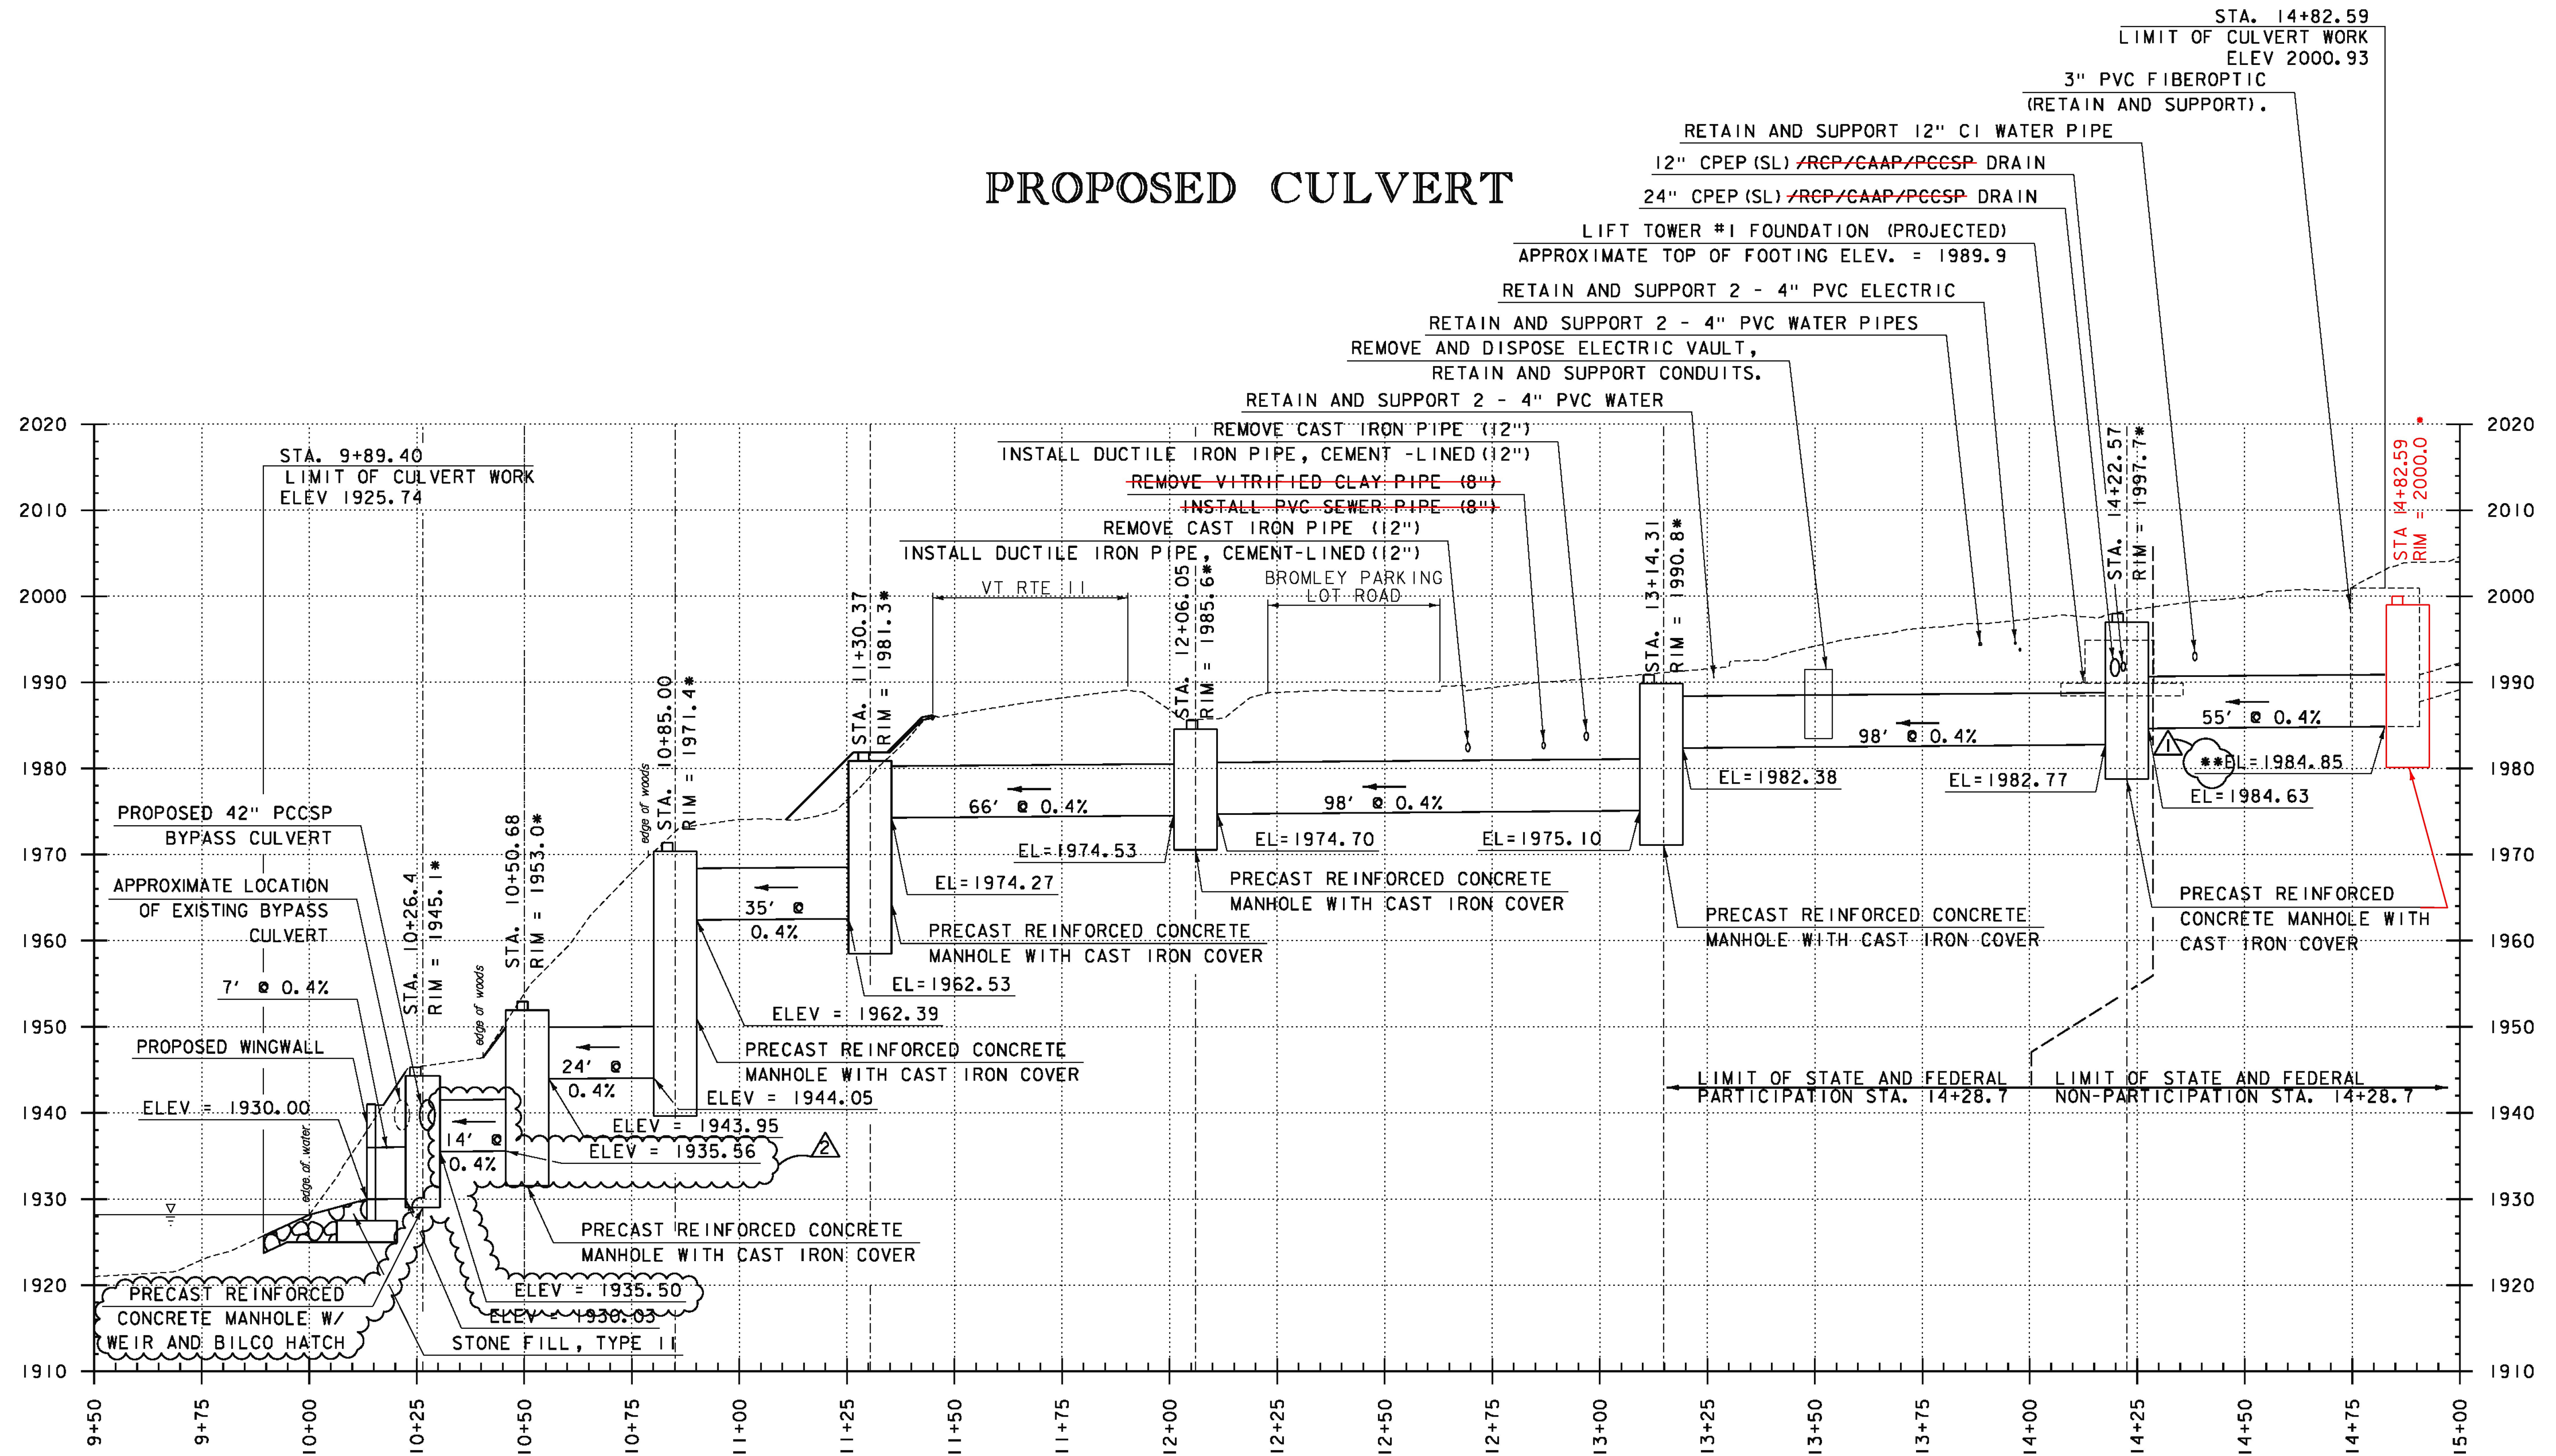

REVISION	BY	DATE
△ SECOND ASTERISK WAS ADDED TO NOTE AND ELEVATION CALLOUT	MAB	2/10/2015
△ PROFILE UPDATED TO REFLECT ADDITION OF BAFFLE W/ WEIR.	MAB	6/8/2015

△ ** PIPE ENTERS STRUCTURE OFF CENTER, PROJECTED ENTRY LOCATION SHOWN


THIS SHEET REPLACES PRECEDING SHEET

*RIM ELEVATIONS ARE APPROXIMATE AND SHALL BE ADJUSTED TO MEET THE GRADE AS NECESSARY. SEE SHEET 8 FOR ADDITIONAL REQUIREMENTS.

MANHOLE STRUCTURES ARE SHOWN PICTORIALLY FOR INFORMATION ONLY. ACTUAL SHAPE AND SIZE TO BE DETERMINED BY THE CONTRACTOR.


GREEN INTERNATIONAL AFFILIATES, INC.  
CIVIL AND STRUCTURAL ENGINEERS

PROJECT NAME: PERU  
 PROJECT NUMBER: STP SCR(4)  
 FILE NAME: z07bl06xsl.dgn  
 PROJECT LEADER: E. ATKINS  
 DESIGNED BY: M. BRADLEY  
 PROFILE SHEET 1  
 PLOT DATE: 12/31/2014  
 DRAWN BY: M. BRADLEY  
 CHECKED BY: E. ATKINS  
 SHEET 29 OF 45

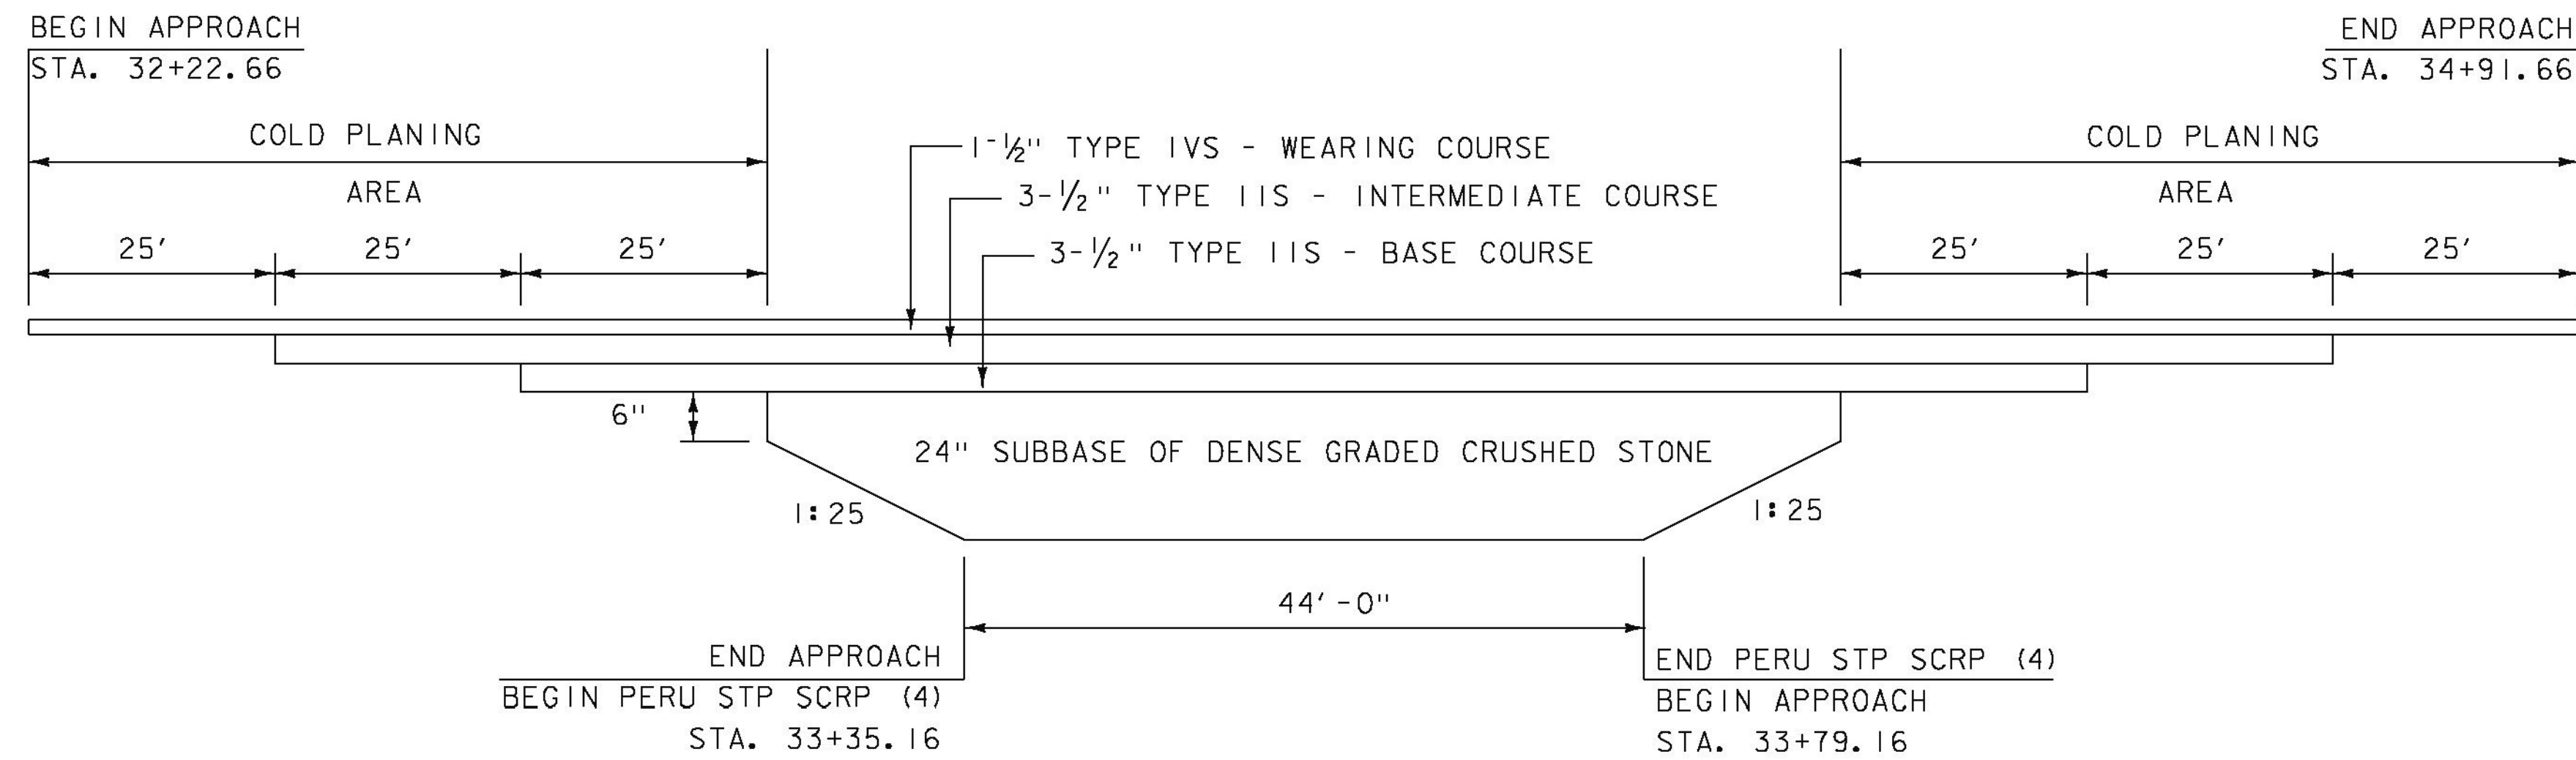

**VT ROUTE 11 MATERIAL TRANSITION DETAIL**  
NOT TO SCALE

## VT ROUTE 11

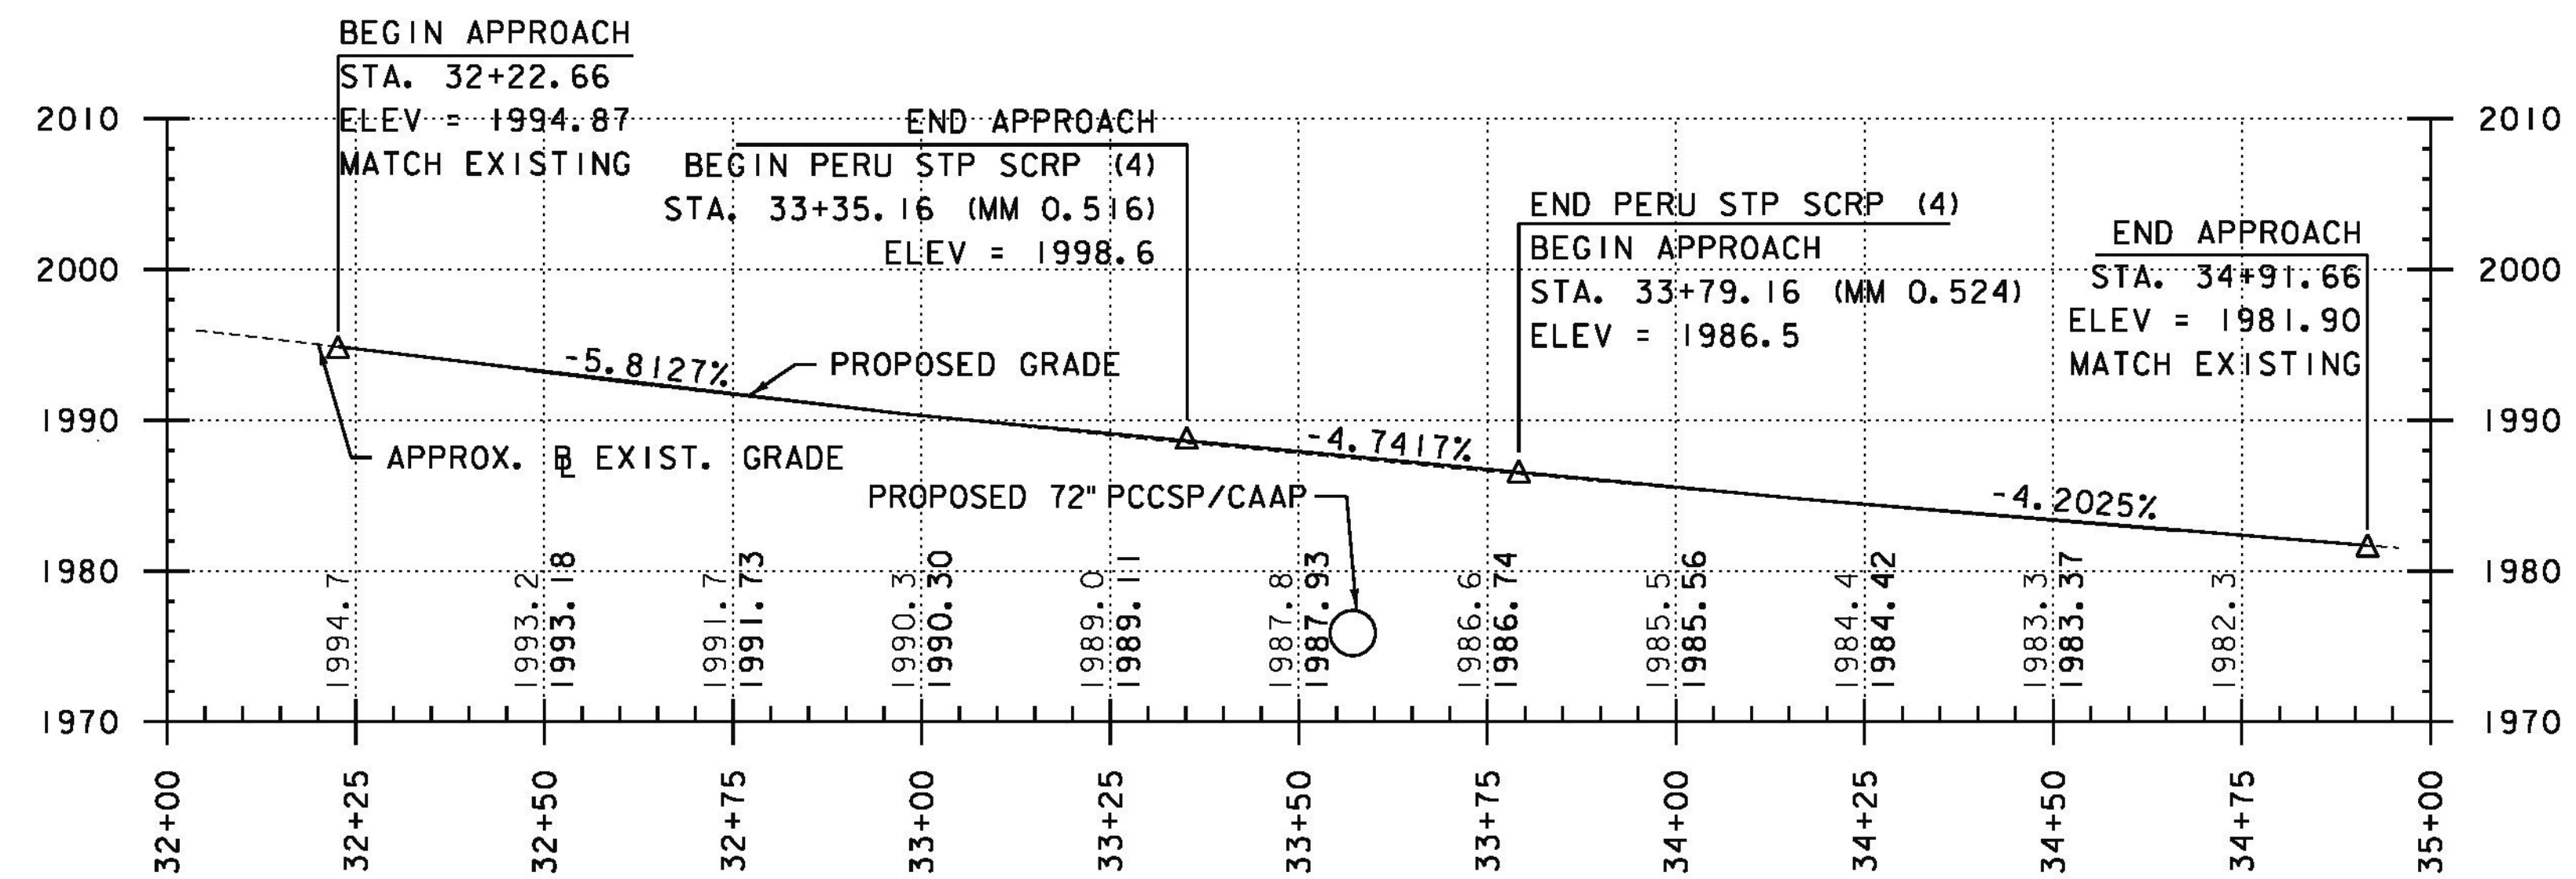

THE GRADES SHOWN TO THE NEAREST TENTH ARE THE ORIGINAL GROUND APPROXIMATE ELEVATIONS ALONG THE PROPOSED ALIGNMENT. THE GRADES SHOWN TO THE NEAREST HUNDREDTH ARE THE PROPOSED PROFILE GRADES FOR THE NEW ALIGNMENT.

NOTE:  
1. ALL STATIONS AND ELEVATIONS ARE SHOWN IN FEET.



PROJECT NAME: PERU  
PROJECT NUMBER: STP SCR(4)

FILE NAME: z07bi06xsl.dgn  
PROJECT LEADER: E. ATKINS  
DESIGNED BY: M. BRADLEY  
PROFILE SHEET 2

PLOT DATE: 12/31/2014  
DRAWN BY: M. BRADLEY  
CHECKED BY: E. ATKINS  
SHEET 30 OF 45

## EPSC PLAN NARRATIVE

### 1.1 PROJECT DESCRIPTION

THIS PROJECT INVOLVES THE ABANDONMENT OF 382 FT OF CULVERT. 410 FEET OF NEW CULVERT WILL BE INSTALLED ALONG A NEW ALIGNMENT TO TAKE ITS PLACE. THE PROJECT IS LOCATED IN THE TOWN OF PERU, ON VT ROUTE 11, APPROXIMATELY 1800 FT WEST OF THE INTERSECTION OF VT ROUTE 11 AND OLD MANCHESTER RD.

NOTE: AREA OF DISTURBANCE INCLUDES LIMITS OF EARTH DISTURBANCE WITHIN THE PROJECT AREA, AS WELL AS WASTE, BORROW AND STAGING AREAS, AND OTHER EARTH DISTURBING ACTIVITIES WITHIN OR DIRECTLY ADJACENT TO THE PROJECT LIMITS AS SHOWN ON THE ATTACHED EPSC PLAN.

TOTAL AREA OF DISTURBANCE AS SHOWN ON THE ATTACHED EPSC PLAN IS APPROXIMATELY 0.48 ACRES.

IT IS ANTICIPATED THAT THIS PROJECT WILL LAST ONE CONSTRUCTION SEASON.

### 1.2 SITE INVENTORY

#### 1.2.1 TOPOGRAPHY

THE TOPOGRAPHY OF THE AREA IS A MOUNTAIN THAT IS A MIX OF WELL ESTABLISHED FOREST AND OPEN AREAS. VT ROUTE 11, A PAVED PARKING LOT, AND A PAVED ACCESS ROAD ARE WITHIN THE PROJECT LIMITS. THERE IS A SKI LODGE, SKI LIFT SHACK AND HOTEL IN THE VICINITY, BUT NOT UPSLOPE OF THE HEADWALL. A SMALL HOUSING DEVELOPMENT IS LOCATED UP SLOPE TO THE WEST WITH GRASS AND TREE BUFFERS.

#### 1.2.2 DRAINAGE, WATERWAYS, BODIES OF WATER, AND PROXIMITY TO NATURAL OR MAN-MADE WATER FEATURES

A MOUNTAIN STREAM IS THE ONLY WATER SOURCE WITHIN THE PROJECT LIMITS. THE STREAM BED CONSISTS OF GRAVEL, COBBLES AND BOULDERS. THE TRIBUTARY AREA AT THE HEADWALL IS 120 ACRES. THERE ARE A NUMBER OF DROP INLETS ON SITE DRAINING TO A COMMON MANMADE POND. DUE TO THE NATURE OF THE SURROUNDING TERRAIN THE PROJECT SITE WILL RECEIVE RUNOFF WATER FROM A FEW NEARBY SLOPES.

#### 1.2.3 VEGETATION

THE VEGETATION IN THE PROJECT AREA CONSISTS OF HARDWOOD TREES AND UNDERGROWTH. THE IMPACT TO VEGETATION WILL BE LIMITED TO THAT WHICH IS DIRECTLY AFFECTED BY THE CONSTRUCTION OF THE NEW CULVERT. UPON PROJECT COMPLETION, THE HEADWALL WILL BE PROTECTED WITH STONE FILL, TYPE II AS SHOWN ON THE PLANS. DISTURBED VEGETATION WILL BE REESTABLISHED PER THE LANDSCAPING PLAN AS WELL AS WITH STANDARD SEED AND MULCH PRACTICES.

#### 1.2.4 SOILS

ALL SOIL DATA CAME FROM THE U.S. DEPARTMENT OF AGRICULTURE SOIL CONSERVATION SERVICE FOR THE COUNTY OF BENNINGTON, VERMONT. SOILS ON THE PROJECT SITE ARE RAWSONVILLE / MUNDAL - HILLY, ROCKY, "K FACTOR" = 0.64 AND RAWSONVILLE / HOGBACK - VERY HILLY, VERY ROCKY, "K FACTOR" = 0.64. THE SOIL IS CONSIDERED HIGHLY ERODIBLE DUE TO SIGNIFICANT SLOPES.

NOTE: K-VALUES GENERALLY INDICATE THE FOLLOWING:

0.0-0.23 = LOW EROSION POTENTIAL  
0.24-0.36 = MODERATE EROSION POTENTIAL  
0.37 AND HIGHER = HIGH EROSION POTENTIAL

#### 1.2.5 SENSITIVE RESOURCE AREAS

CRITICAL HABITATS: NO  
HISTORICAL OR ARCHEOLOGICAL AREAS: NO  
PRIME AGRICULTURAL LAND: NO  
THREATENED AND ENDANGERED SPECIES: NO  
WATER RESOURCE: UNNAMED BROOK  
WETLANDS: NO

### 1.3 RISK EVALUATION

THIS PROJECT DOES NOT FALL UNDER THE JURISDICTION OF GENERAL PERMIT 3-9020 FOR STORMWATER RUNOFF FROM CONSTRUCTION SITES. SHOULD CHANGES PRIOR TO OR DURING CONSTRUCTION RESULT IN ONE OR MORE ACRES OF EARTH DISTURBANCE OR SHOULD THE PROJECT BECOME PART OF A LARGER PLAN OF DEVELOPMENT, THE CONTRACTOR WILL BE RESPONSIBLE FOR ANY ADDITIONAL PERMITTING.

### 1.4 EROSION PREVENTION AND SEDIMENT CONTROL

THE EROSION CONTROL PLANS ARE MEANT AS A GUIDELINE FOR PREVENTING EROSION AND CONTROLLING SEDIMENT TRANSPORT. THE PRINCIPLES OUTLINED IN THIS NARRATIVE CONSIST OF APPLYING MEASURES THROUGHOUT CONSTRUCTION OF THE PROJECT IN ORDER TO MINIMIZE SEDIMENT TRANSPORT TO THE RECEIVING WATERS. THE MEASURES INCLUDE STABILIZATION AND STRUCTURAL PRACTICES, STORM WATER CONTROLS AND OTHER POLLUTION PREVENTION PRACTICES. THEY HAVE BEEN PROPOSED BY THE DESIGNER AS A BASIS FOR PROTECTING RESOURCES AND WILL NEED TO BE BUILT UPON BASED ON THE SPECIFIC MEANS AND METHODS OF THE CONTRACTOR. REFER TO THE LOW RISK SITE HANDBOOK AND APPROPRIATE DETAIL SHEETS FOR SPECIFIC GUIDANCE AND CONSTRUCTION DETAILING.

ALL MEASURES SHALL BE REGULARLY MAINTAINED AND SHALL BE CHECKED FOR SEDIMENT BUILD-UP. SEDIMENT SHALL BE DISPOSED OF AT AN APPROVED SITE WHERE IT WILL NOT BE SUBJECT TO EROSION.

#### 1.4.1 MARK SITE BOUNDARIES

SITE BOUNDARIES AND AREAS CONSTRUCTION EQUIPMENT CAN ACCESS SHALL BE DELINEATED.

PROJECT DEMARCATION FENCING (PDF) SHALL BE USED TO PHYSICALLY MARK SITE BOUNDARIES. BARRIER FENCE SHALL BE USED INSTEAD OF PROJECT DEMARCATION FENCE WITHIN 100 FEET OF A WATER RESOURCE (STREAM, BROOK, LAKE, POND, WETLAND, ETC).

#### 1.4.2 LIMIT DISTURBANCE AREA

PREVENTING INITIAL SOIL EROSION BY MINIMIZING THE EXPOSED AREA IS MUCH MORE EFFECTIVE THAN TREATING ERODED SEDIMENT. EARTH DISTURBANCE CAN BE MINIMIZED THROUGH CONSTRUCTION PHASING BY ONLY OPENING UP EARTH AS NECESSARY. THIS CAN LIMIT THE AREA THAT WILL BE DISTURBED AND EXPOSED TO EROSION. EMPLOY TEMPORARY CONSTRUCTION STABILIZATION PRACTICES IN INCREMENTAL STAGES AS PHASES CHANGE. FOR PROJECTS WHICH FALL UNDER THE CONSTRUCTION GENERAL PERMIT, ONLY THE ACREAGE LISTED ON THE PERMIT AUTHORIZATION MAY BE EXPOSED AT ANY GIVEN TIME.

MAINTAINING VEGETATED BUFFERS ALONG STREAM BANKS, WETLANDS OR OTHER SENSITIVE AREAS IS A CRUCIAL EROSION AND SEDIMENT CONTROL MEASURE THAT SHOULD BE ESTABLISHED WHEREVER POSSIBLE.

#### 1.4.3 SITE ENTRANCE/EXIT STABILIZATION

TRACKING OF SEDIMENT ONTO PUBLIC HIGHWAYS SHALL BE MINIMIZED TO REDUCE THE POTENTIAL FOR RUNOFF ENTERING RECEIVING WATERS. INSTALLATION SHALL COINCIDE WITH THE CONTRACTOR'S PROGRESS SCHEDULE.

STABILIZED CONSTRUCTION ENTRANCES SHALL BE INSTALLED AS PROPOSED ON THE EPSC PLAN AND ANYWHERE EQUIPMENT WILL BE GOING FROM AREAS OF EXPOSED SOILS TO PAVED SURFACES.

#### 1.4.4 INSTALL SEDIMENT BARRIERS

SEDIMENT BARRIERS SHALL BE UTILIZED TO INTERCEPT RUNOFF AND ALLOW SUSPENDED SEDIMENT TO SETTLE OUT. THEY SHALL BE INSTALLED PRIOR TO ANY UP SLOPE WORK.

TURBIDITY CURTAIN SHALL BE INSTALLED AT THE DOWNSTREAM END OF CONSTRUCTION AS SHOWN ON THE PLANS.

#### 1.4.5 SLOW DOWN CHANNELIZED RUNOFF

CHECK STRUCTURES SHALL BE UTILIZED TO REDUCE THE VELOCITY, AND THUS THE EROSION POTENTIAL, OF CONCENTRATED FLOW IN CHANNELS.

THIS MEASURE IS NOT ANTICIPATED ON THIS PROJECT.

#### 1.4.6 CONSTRUCT PERMANENT CONTROLS

PERMANENT STORMWATER TREATMENT DEVICES SHALL BE INSTALLED AS SHOWN ON THE PLANS AND IN ACCORDANCE WITH PERMIT CONDITIONS.

THIS MEASURE IS NOT ANTICIPATED ON THIS PROJECT.

#### 1.4.7 STABILIZE EXPOSED SOILS DURING CONSTRUCTION

ALL AREAS OF DISTURBANCE MUST HAVE TEMPORARY STABILIZATION IN PLACE WITHIN 48 HOURS OF DISTURBANCE OR IN ACCORDANCE WITH THE CONSTRUCTION GENERAL PERMIT 3-9020 AUTHORIZATION.

BIODEGRADABLE EROSION CONTROL MATTING OR AN EQUIVALENT SHALL BE USED TO STABILIZE ALL SLOPES STEEPER THAN 1:3.

THE FORECAST OF RAINFALL EVENTS SHALL TRIGGER IMMEDIATE PROTECTION OF EXPOSED SOILS.

#### 1.4.8 WINTER STABILIZATION

VARIOUS MEASURES SPECIFIC TO WINTER MAY BE NECESSARY SHOULD THE PROJECT EXTEND INTO WINTER (OCTOBER 15 THROUGH APRIL 15). REFER TO THE LOW RISK SITE HANDBOOK FOR GUIDANCE.

THIS MEASURE IS NOT ANTICIPATED ON THIS PROJECT. WORK WITHIN THE EXISTING CULVERTS AND STREAM SHALL BE COMPLETED DURING THE LOW FLOW SEASON (JULY 15TH TO OCTOBER 1ST).

#### 1.4.9 STABILIZE SOIL AT FINAL GRADE

EXPOSED SOIL MUST BE STABILIZED WITHIN 48 HOURS OF REACHING FINAL GRADE.

SEED, MULCH, FERTILIZER AND LIME SHALL BE USED TO ESTABLISH PERMANENT VEGETATION. FOR SLOPES STEEPER THAN 1:3, BIODEGRADABLE EROSION CONTROL MATTING OR AN EQUIVALENT SHALL BE USED INSTEAD OF MULCH.

#### 1.4.10 DE-WATERING ACTIVITIES

DISCHARGE FROM DEWATERING ACTIVITIES THAT FLOWS OFF OF THE CONSTRUCTION SITE MUST NOT CAUSE OR CONTRIBUTE TO A VIOLATION OF THE VERMONT WATER QUALITY STANDARDS.

TREATMENT OF DEWATERING COFFERDAM IS NOT ANTICIPATED, THE EXISTING CULVERT SHALL REMAIN IN USE UNTIL THE NEW CULVERT IS COMPLETED.

#### 1.4.11 INSPECT YOUR SITE

INSPECT THE PROJECT SITE BASED ON SPECIAL PROVISION REQUIREMENTS OR CONSTRUCTION GENERAL PERMIT AUTHORIZATION STIPULATIONS.

### 1.5 SEQUENCE AND STAGING

THIS SECTION WILL BE DEVELOPED BY THE CONTRACTOR USING THE GUIDANCE OUTLINED IN THE VTRANS EPSC PLAN CONTRACTOR CHECKLIST.


#### 1.5.1 OFF-SITE ACTIVITIES

IN ADDITION TO THE CONTRACTOR CHECKLIST ANY ACTIVITIES OUTSIDE THE CONSTRUCTION LIMITS SHALL FOLLOW SUBSECTIONS 105.25- 105.29 OF THE STANDARD SPECIFICATIONS FOR CONSTRUCTION.

PROJECT NAME: PERU  
PROJECT NUMBER: STP_SCRP(4)

FILE NAME: z07bi06er0nar.dgn  
PROJECT LEADER: E. ATKINS  
DESIGNED BY: M. BRADLEY  
EPSC NARRATIVE

PLOT DATE: 12/31/2014  
DRAWN BY: M. BRADLEY  
CHECKED BY: E. ATKINS  
SHEET 31 OF 45

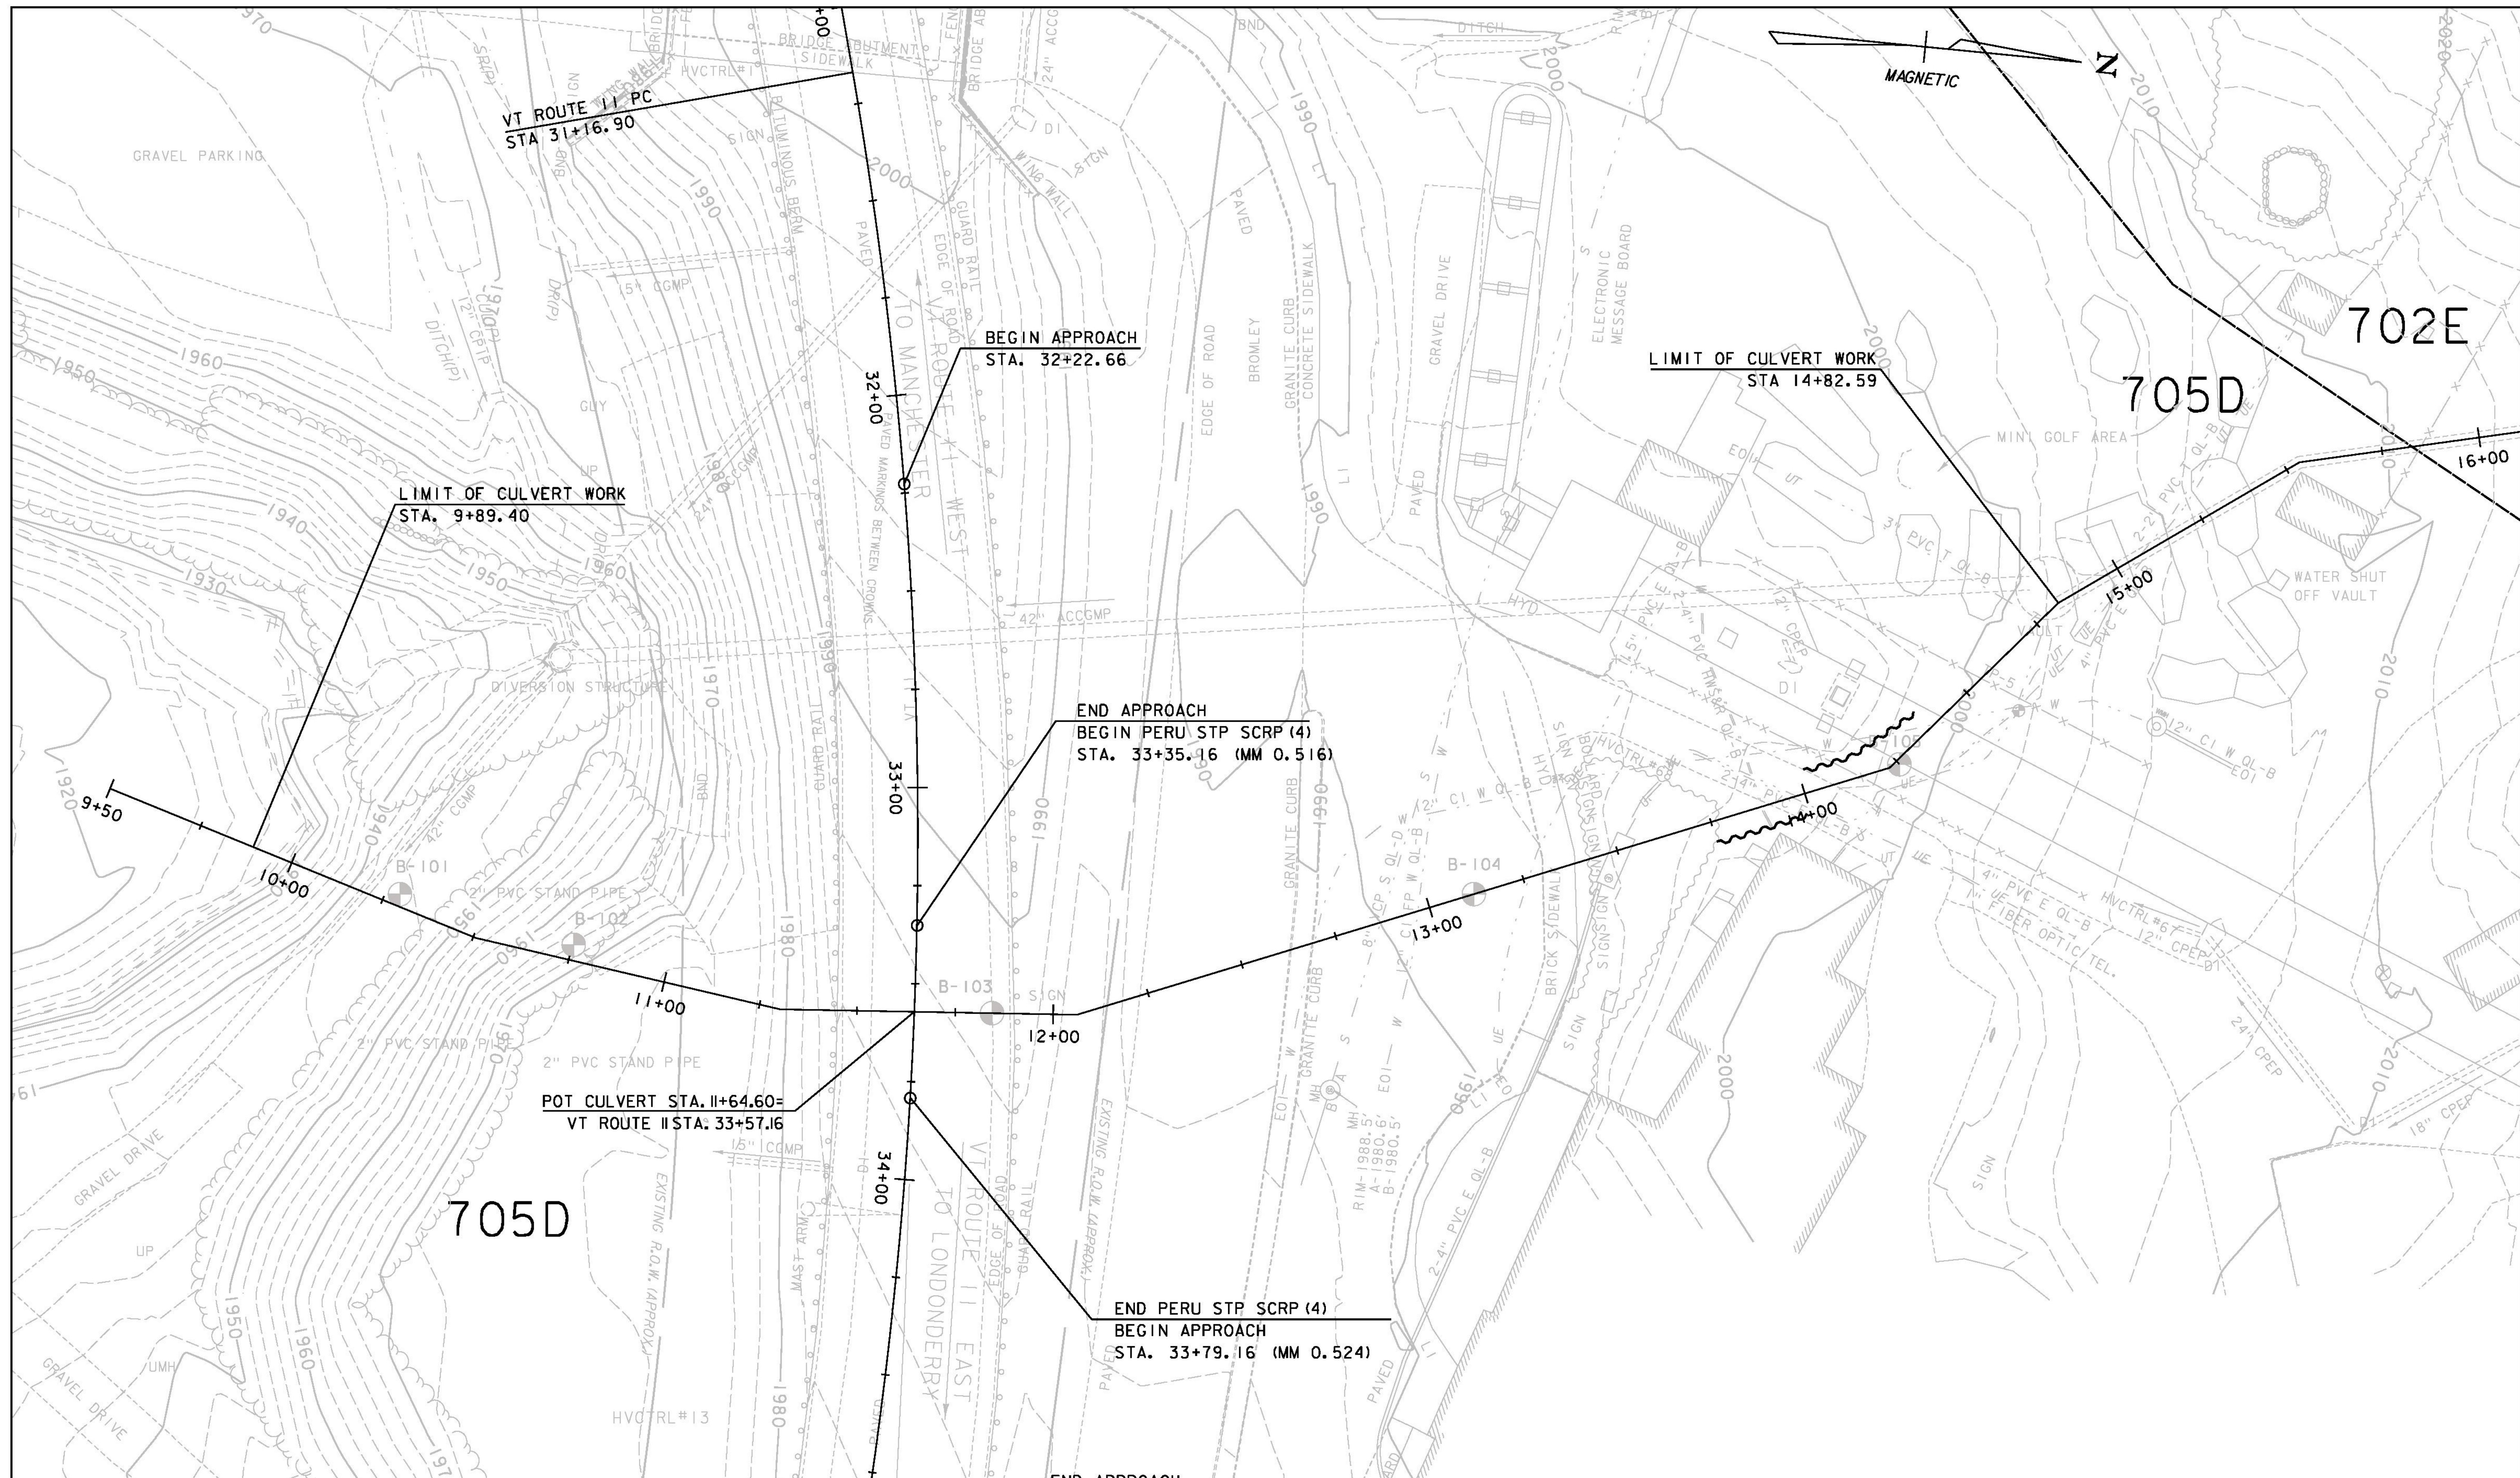

**SOIL LEGEND**

SOIL DESIGNATION	HYDROLOGIC SOIL GROUP CLASSIFICATION	SOIL ERODIBILITY COEFFICIENTS (K)
705D =RAWSONVILLE / MUNDAL - HILLY, ROCKY	C	0.64
702E =RAWSONVILLE / HOGBACK - VERY HILLY, VERY ROCKY	C	0.64



GREEN INTERNATIONAL AFFILIATES, INC.  
CIVIL AND STRUCTURAL ENGINEERS

PROJECT NAME: PERU	PLOT DATE: 12/31/2014
PROJECT NUMBER: STP SCR(4)	DRAWN BY: M. BRADLEY
FILE NAME: z07b106r0bdr.dgn	CHECKED BY: E. ATKINS
DESIGNED BY: M. BRADLEY	SHEET 32 OF 45
EPSC EXISTING CONDITIONS PLAN SHEET	

NOTES:  
 1. SEE EPSC DETAIL SHEETS FOR CONSTRUCTION DETAILS.

2. ALL AREAS OF DISTURBANCE MUST HAVE TEMPORARY OR FINAL STABILIZATION WITHIN 7 DAYS OF THE INITIAL DISTURBANCE. AFTER THIS TIME, ANY DISTURBANCE IN THE AREA MUST BE STABILIZED AT THE END OF EACH WORK DAY. THE FOLLOWING EXCEPTIONS APPLY:  
 I) STABILIZATION IS NOT REQUIRED IF WORK IS TO CONTINUE IN THE AREA WITHIN THE NEXT 24 HOURS AND THERE IS NO PRECIPITATION FORECAST FOR THE NEXT 24 HOURS.  
 II) STABILIZATION IS NOT REQUIRED IF THE WORK IS OCCURRING IN A SELF CONTAINED EXCAVATION WITH A DEPTH OF 2 FEET OR GREATER.

3. THE CONTRACTOR SHALL MINIMIZE ANY SOIL DISTURBANCES BETWEEN OCTOBER 15 THROUGH APRIL 15. TO ASSURE A VIGOROUS CATCH OF VEGETATIVE COVER, SEEDING AND MULCHING SHALL BE COMPLETED BY SEPTEMBER 15 TO THE EXTENT POSSIBLE, OR AS DIRECTED BY THE ENGINEER.

STONE FILL, TYPE I  
 32+94.7 RT - 33+51.6 RT

GEOTEXTILE FOR FILTER CURTAIN  
 9+96.5 LT - 9+96.5 RT

SEED  
 RURAL AREA MIX:  
 9+96.5 LT-RT - 11+46.3 LT-RT  
 11+95.4 LT-RT - 12+25.4 LT-RT  
 12+24.6 LT - 12+53.6 LT

URBAN AREA MIX:  
 14+01.4 LT-RT - 14+82.6 LT-RT  
 BEGIN APPROACH  
 STA. 32+22.66

SEED, WINTER RYE  
 9+96.5 LT-RT - 11+46.3 LT-RT  
 11+95.4 LT-RT - 12+25.4 LT-RT  
 14+01.4 LT-RT - 14+82.6 LT-RT

FERTILIZER  
 9+96.5 LT-RT - 11+46.3 LT-RT  
 11+95.4 LT-RT - 12+25.4 LT-RT  
 12+24.6 LT - 12+53.6 LT  
 14+01.4 LT-RT - 14+82.6 LT-RT

AGRICULTURAL LIMESTONE  
 9+96.5 LT-RT - 11+46.3 LT-RT  
 11+95.4 LT-RT - 12+25.4 LT-RT  
 12+24.6 LT - 12+53.6 LT  
 14+01.4 LT-RT - 14+82.6 LT-RT

HAY MULCH  
 9+96.5 LT-RT - 11+46.3 LT-RT  
 11+95.4 LT-RT - 12+25.4 LT-RT  
 12+24.6 LT - 12+53.6 LT  
 14+01.4 LT-RT - 14+82.6 LT-RT


TOP SOIL  
 9+96.5 LT-RT - 11+46.3 LT-RT  
 11+95.4 LT-RT - 12+25.4 LT-RT  
 12+24.1 LT - 12+53.6 LT  
 14+01.4 LT-RT - 14+82.6 LT-RT

TEMPORARY EROSION MATTING  
 10+08.8 LT-RT - 11+46.5 LT-RT

BARRIER FENCE  
 9+89.0 LT - 11+00.0 LT  
 9+85.2 RT - 11+20.4 RT

PROJECT DEMARCATION FENCE  
 11+00.0 LT - 11+07.7 LT  
 11+77.9 LT - 14+84.9 LT  
 11+20.4 RT - 11+35.3 RT  
 11+81.2 RT - 14+84.9 RT


IMPACT BELOW EXISTING ORDINARY HIGH WATER LINE  
 APPROXIMATE AREA OF IMPACT = 1,898 SF +/- (0.044 AC)

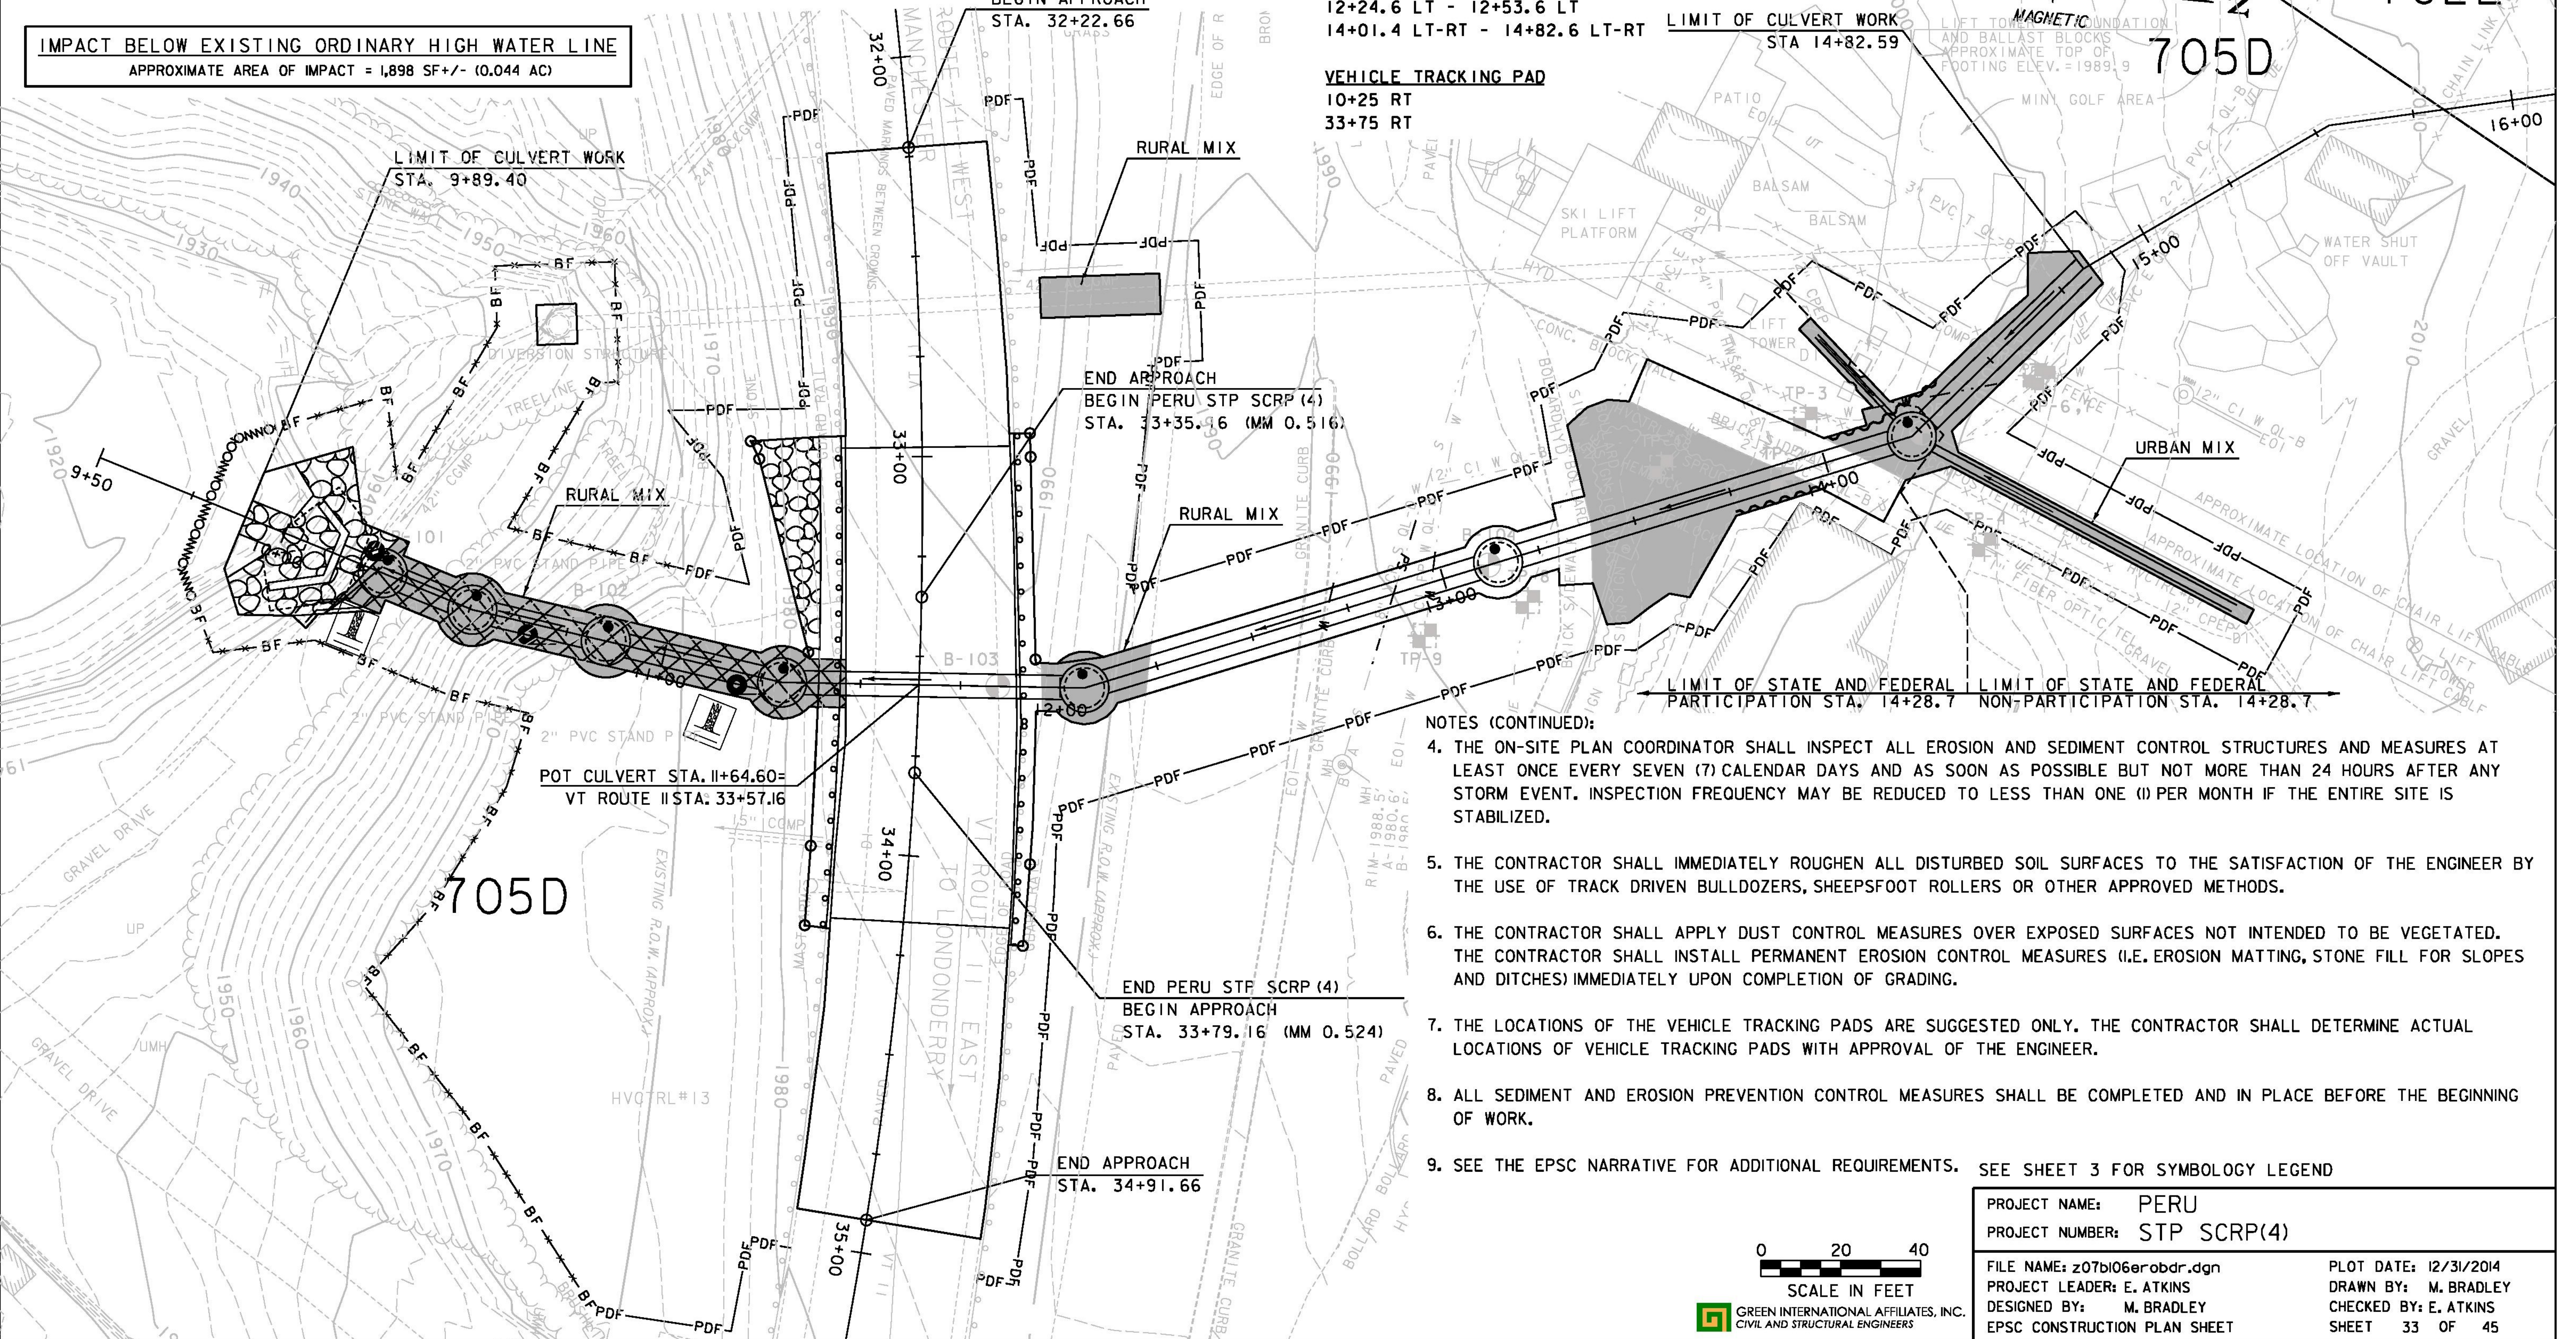


- NOTES (CONTINUED):
4. THE ON-SITE PLAN COORDINATOR SHALL INSPECT ALL EROSION AND SEDIMENT CONTROL STRUCTURES AND MEASURES AT LEAST ONCE EVERY SEVEN (7) CALENDAR DAYS AND AS SOON AS POSSIBLE BUT NOT MORE THAN 24 HOURS AFTER ANY STORM EVENT. INSPECTION FREQUENCY MAY BE REDUCED TO LESS THAN ONE (1) PER MONTH IF THE ENTIRE SITE IS STABILIZED.
  5. THE CONTRACTOR SHALL IMMEDIATELY ROUGHEN ALL DISTURBED SOIL SURFACES TO THE SATISFACTION OF THE ENGINEER BY THE USE OF TRACK DRIVEN BULLDOZERS, SHEEPSFOOT ROLLERS OR OTHER APPROVED METHODS.
  6. THE CONTRACTOR SHALL APPLY DUST CONTROL MEASURES OVER EXPOSED SURFACES NOT INTENDED TO BE VEGETATED. THE CONTRACTOR SHALL INSTALL PERMANENT EROSION CONTROL MEASURES (I.E. EROSION MATTING, STONE FILL FOR SLOPES AND DITCHES) IMMEDIATELY UPON COMPLETION OF GRADING.
  7. THE LOCATIONS OF THE VEHICLE TRACKING PADS ARE SUGGESTED ONLY. THE CONTRACTOR SHALL DETERMINE ACTUAL LOCATIONS OF VEHICLE TRACKING PADS WITH APPROVAL OF THE ENGINEER.
  8. ALL SEDIMENT AND EROSION PREVENTION CONTROL MEASURES SHALL BE COMPLETED AND IN PLACE BEFORE THE BEGINNING OF WORK.
  9. SEE THE EPSC NARRATIVE FOR ADDITIONAL REQUIREMENTS. SEE SHEET 3 FOR SYMBOLOGY LEGEND

PROJECT NAME: PERU  
 PROJECT NUMBER: STP SCR(4)  
 FILE NAME: z07b106erobdr.dgn  
 PROJECT LEADER: E. ATKINS  
 DESIGNED BY: M. BRADLEY  
 EPSC CONSTRUCTION PLAN SHEET

PLOT DATE: 12/31/2014  
 DRAWN BY: M. BRADLEY  
 CHECKED BY: E. ATKINS  
 SHEET 33 OF 45

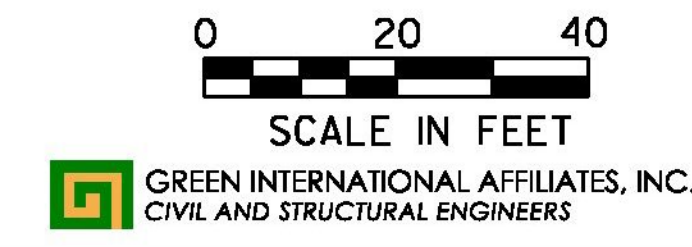

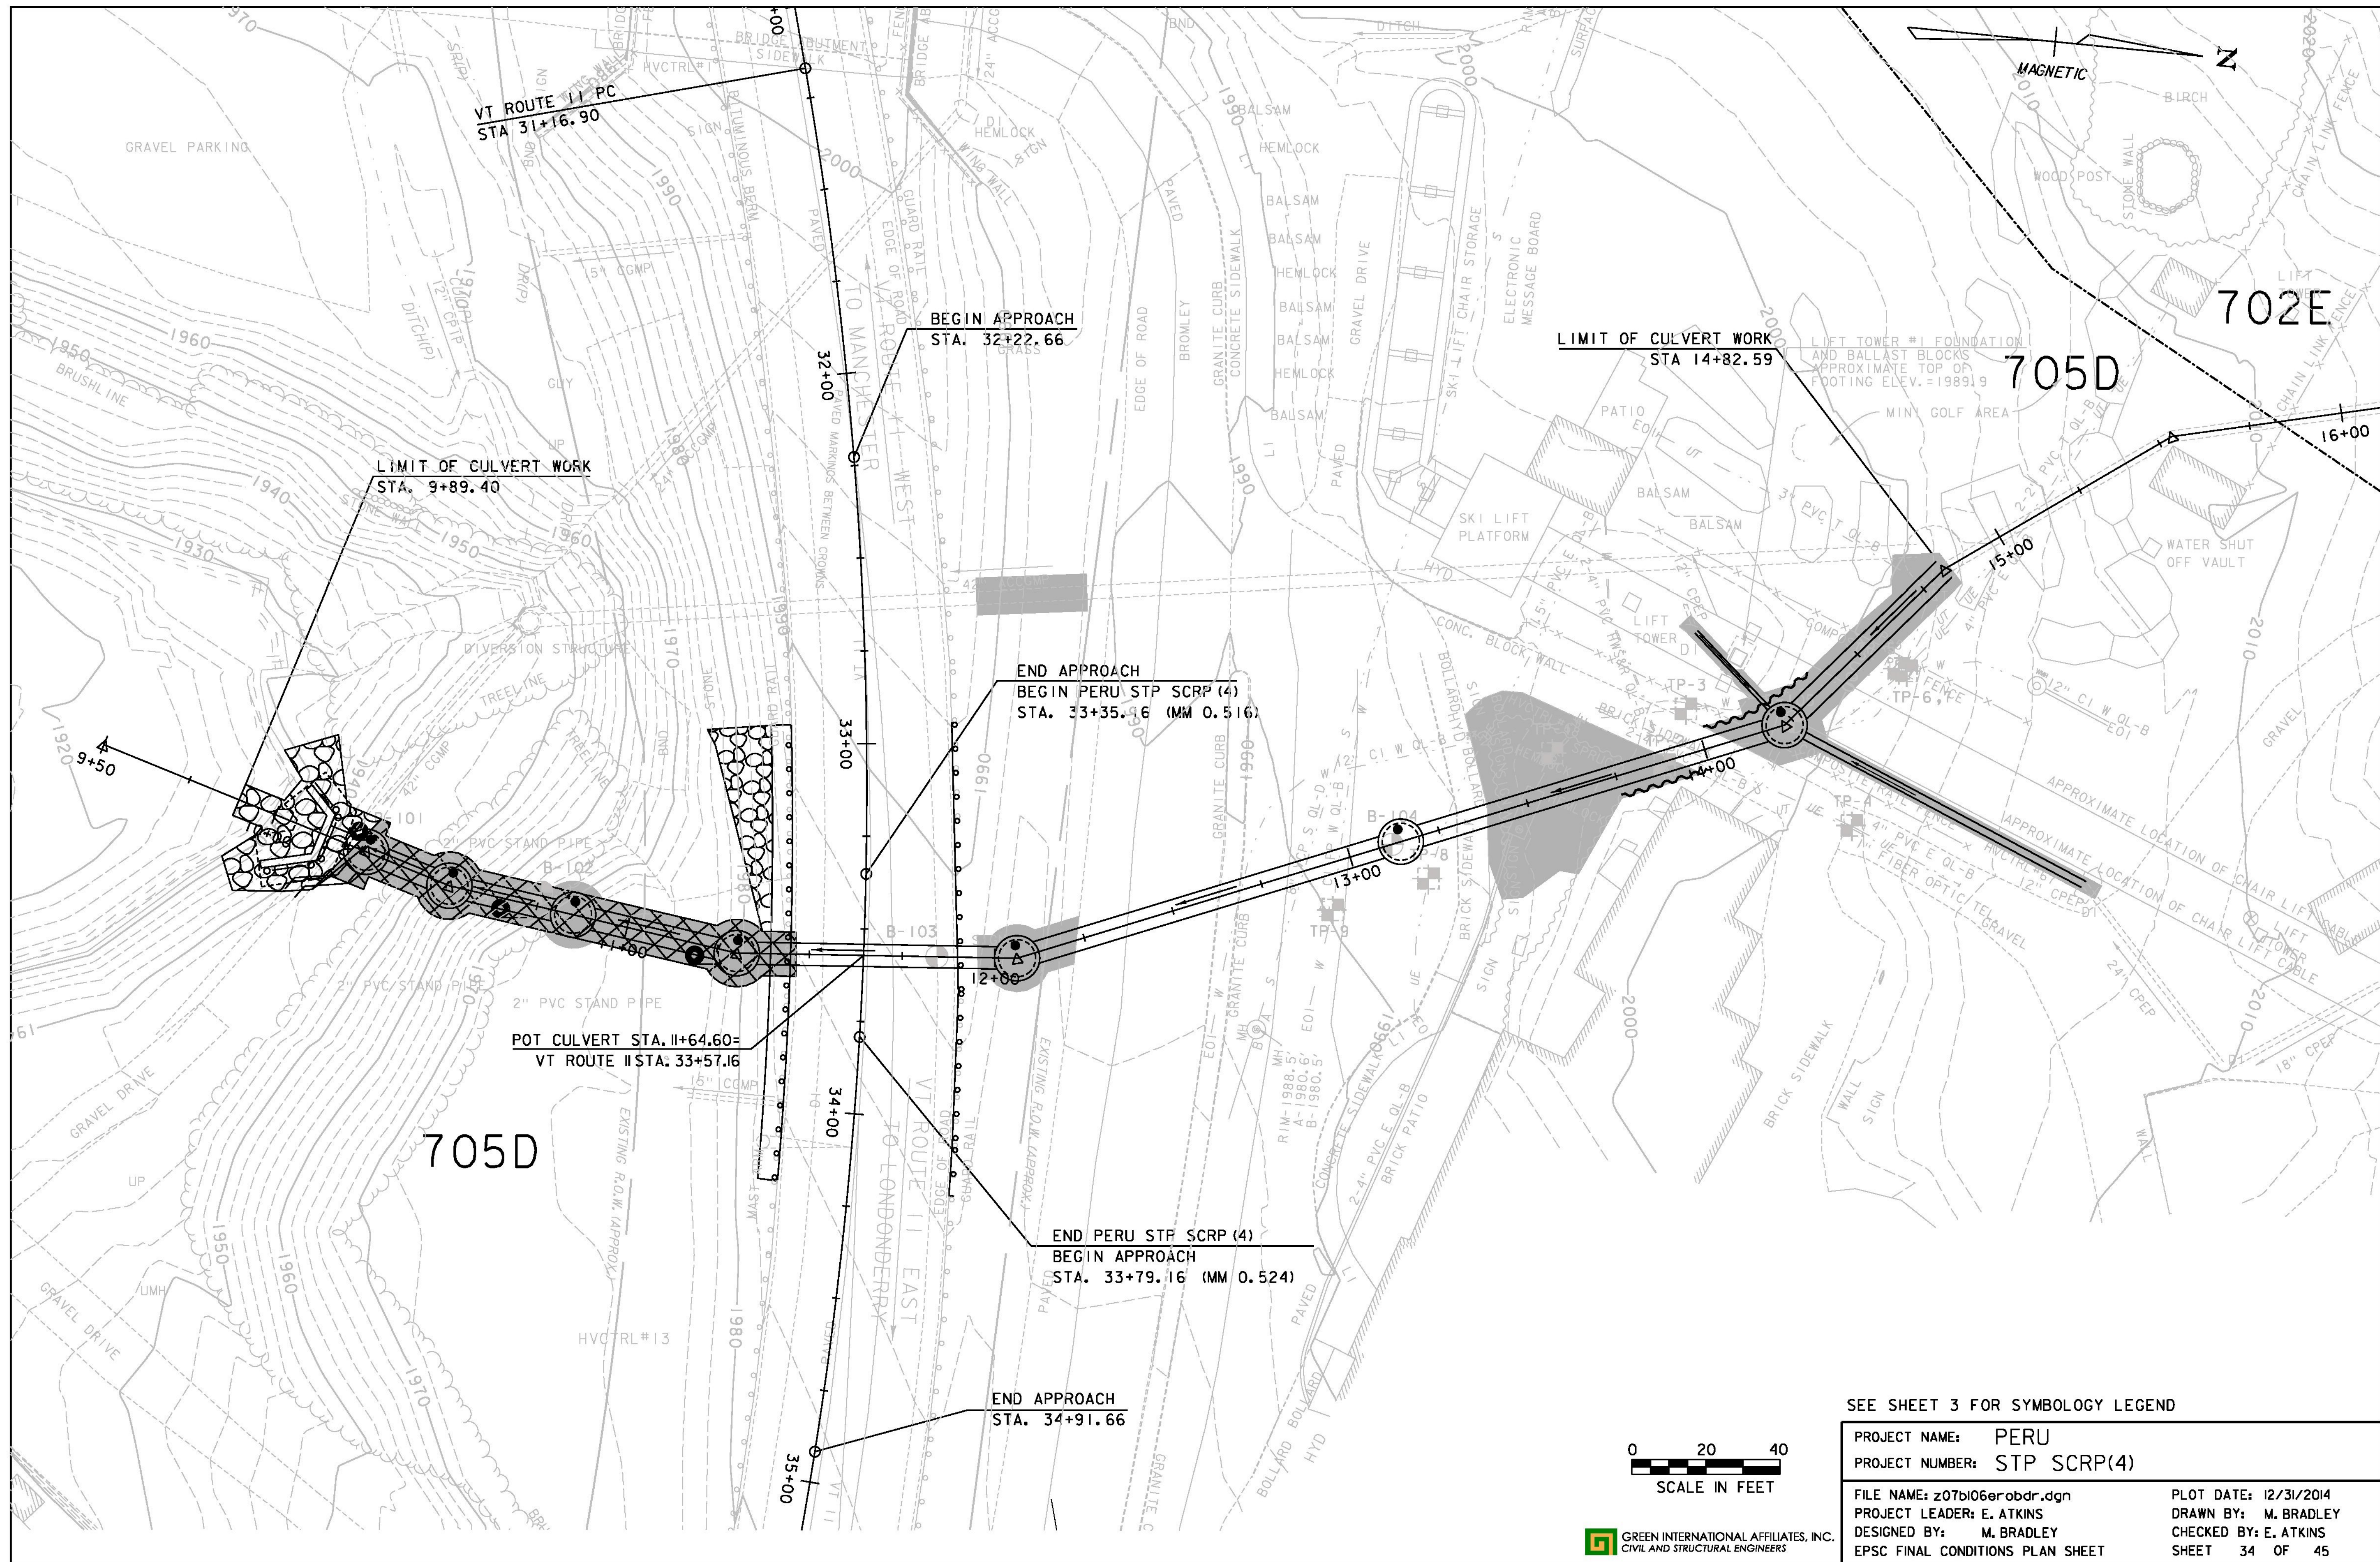


SEE SHEET 3 FOR SYMBOLOGY LEGEND



PROJECT NAME: PERU  
 PROJECT NUMBER: STP SCR(4)

FILE NAME: z07bi06erobdr.dgn  
 PROJECT LEADER: E. ATKINS  
 DESIGNED BY: M. BRADLEY  
 EPSC FINAL CONDITIONS PLAN SHEET

PLOT DATE: 12/31/2014  
 DRAWN BY: M. BRADLEY  
 CHECKED BY: E. ATKINS  
 SHEET 34 OF 45

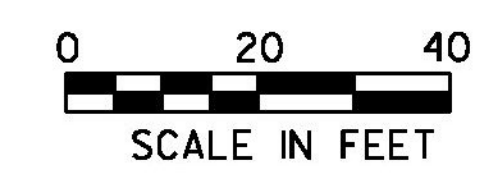

GREEN INTERNATIONAL AFFILIATES, INC.  
 CIVIL AND STRUCTURAL ENGINEERS

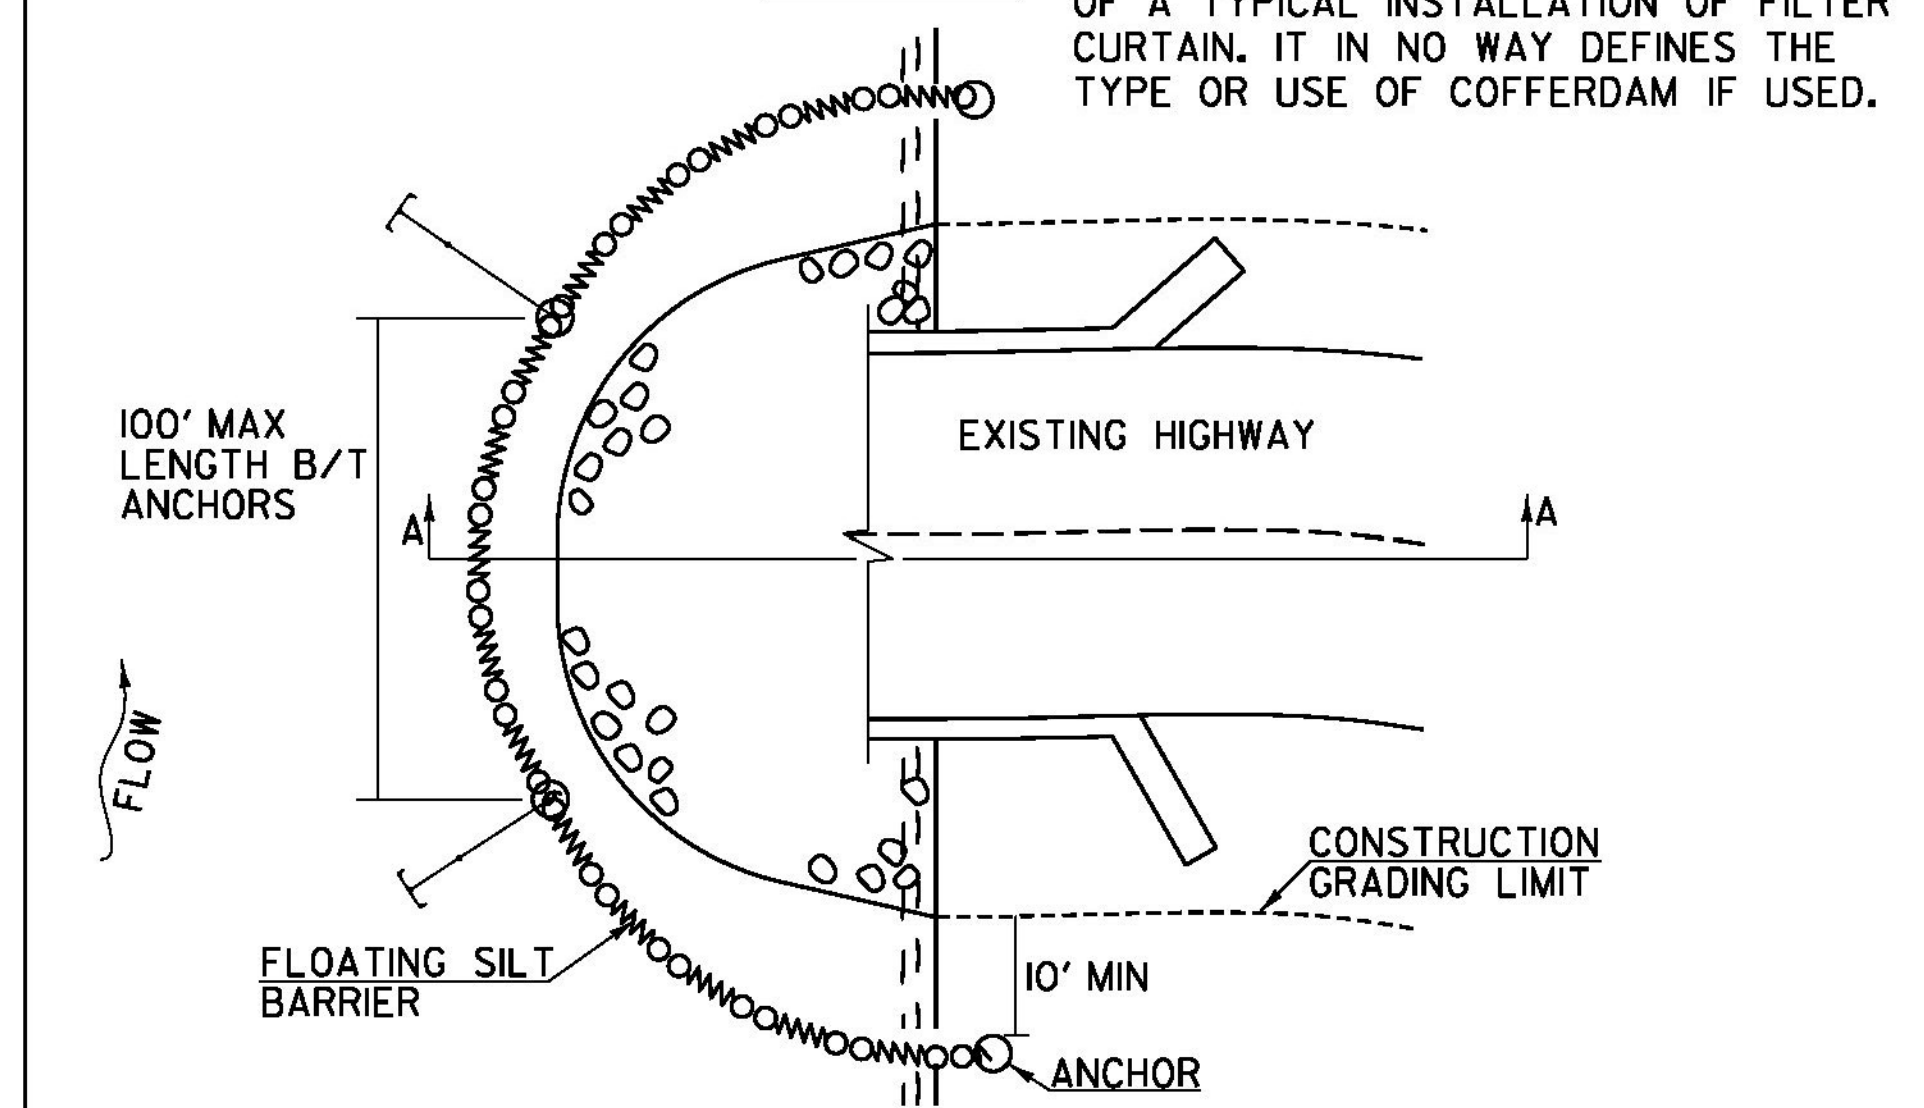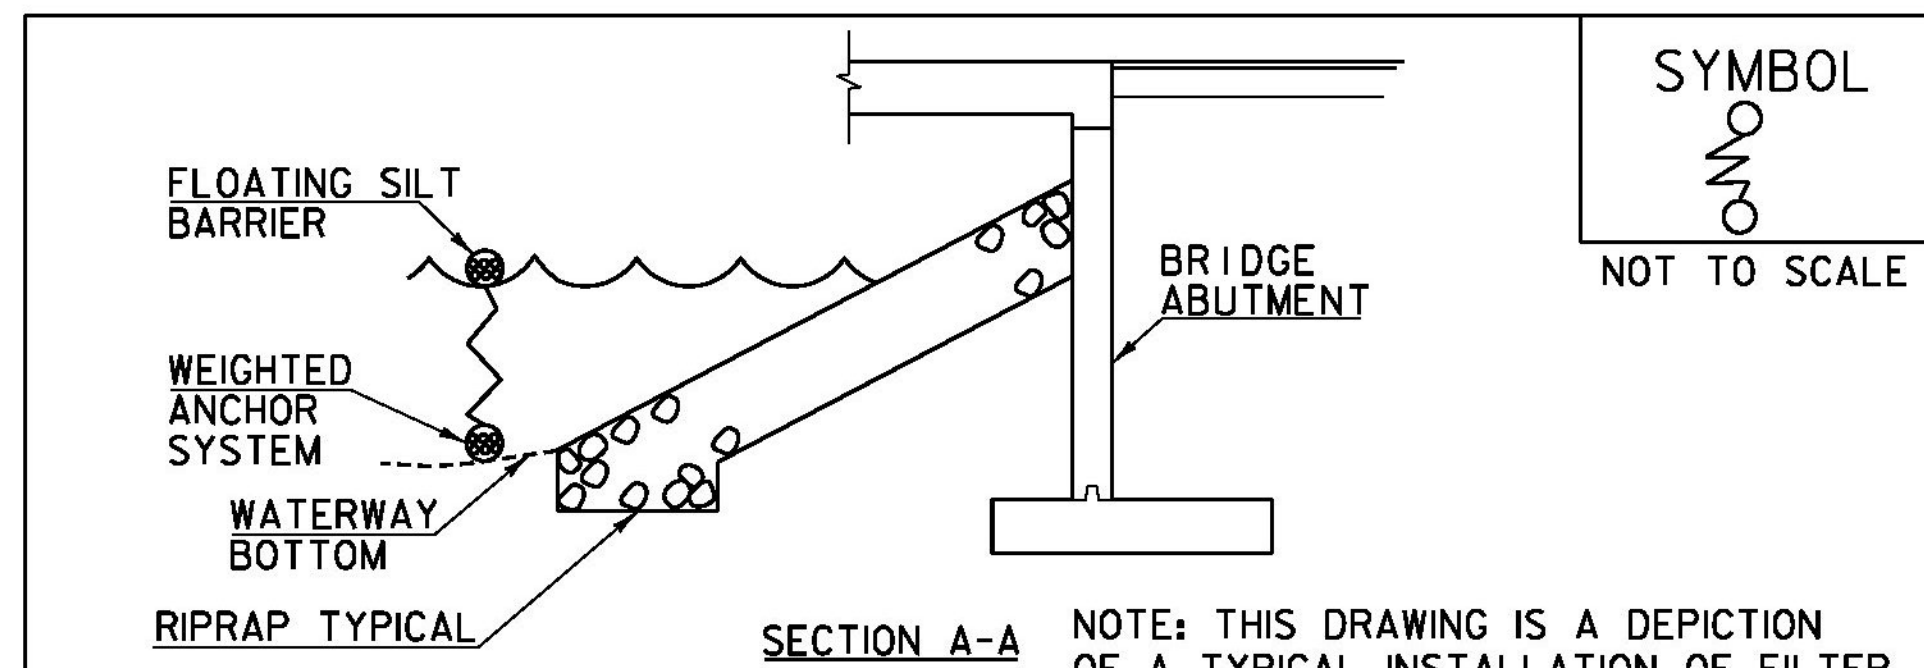

**CONSTRUCTION SPECIFICATIONS**

1. FILTER CURTAIN SHALL NOT BE PLACED ACROSS A FLOWING WATERWAY, OR IN A WATERWAY WITH STREAM VELOCITIES GREATER THAN 1.5 FEET/SECOND.
2. MAXIMUM 100' LENGTH BETWEEN ANCHORS.
3. LAST SECTION SHALL TERMINATE A MINIMUM OF 10' BEYOND LIMIT OF DISTURBANCE.
4. THE WEIGHTED ANCHOR SYSTEM SHALL BE A TYPE WHICH ALLOWS THE CURTAIN TO CONFORM TO THE BOTTOM OF THE WATERWAY.
5. THE CURTAIN SHALL BE REMOVED BY SLOWLY PULLING TOWARD THE SHORE MINIMIZING THE ESCAPE OF SEDIMENTS INTO WATERWAY.

**FILTER CURTAIN**

REVISIONS	
APRIL 1, 2008	WHF
JANUARY 13, 2009	WHF
SEPTEMBER 4, 2009	WHF

THIS WORK SHALL BE PERFORMED IN ACCORDANCE WITH SECTION 649 FOR GEOTEXTILE FOR FILTER CURTAIN (PAY ITEM 649.6).

VAOT RURAL AREA MIX					
% WEIGHT	LBS/AC		NAME	GERM %	PURITY %
	BROADCAST	HYDROSEED			
37.5%	22.5	45	CREeping RED FESCUE	85%	98%
37.5%	22.5	45	TALL FESCUE	90%	95%
5.0%	3	6	RED TOP	90%	95%
15.0%	9	18	BIRDSFOOT TREFOIL	85%	98%
5.0%	3	6	ANNUAL RYE GRASS	85%	95%
100%	60	120			

VAOT URBAN AREA MIX					
% WEIGHT	LBS/AC		NAME	GERM %	PURITY %
	BROADCAST	HYDROSEED			
42.5%	34	68	CREeping RED FESCUE	85%	98%
10.0%	8	16	PERENNIAL RYE GRASS	90%	95%
42.5%	34	68	KENTUCKY BLUE GRASS	85%	85%
5.0%	4	8	ANNUAL RYE GRASS	85%	95%
100%	80	160			

SOIL AMENDMENT GUIDANCE			
FERTILIZER		LIME	
BROADCAST	HYDROSEED	BROADCAST	HYDROSEED
10-20-10	FOLLOW	PELLETIZED	FOLLOW
500 LBS/AC	MANUFACTURER	2 TONS/AC	MANUFACTURER

**CONSTRUCTION GUIDANCE**

1. RURAL SEED MIX: USE AS INDICATED IN THE PLANS AND/OR FOR ALL ESTABLISHED UPLAND (NON WETLAND) AREAS DISTURBED BY THE CONTRACTOR.
2. URBAN SEED MIX: USE AS INDICATED IN THE PLANS AND/OR FOR ALL ESTABLISHED LAWN AREAS DISTURBED BY THE CONTRACTOR.
3. ALL SEED MIXTURES: SHALL NOT HAVE A WEED CONTENT EXCEEDING 0.40% BY WEIGHT AND SHALL BE FREE OF ALL NOXIOUS SEED.
4. FERTILIZER AND LIMESTONE: SHALL FOLLOW RATES SHOWN ON PLAN OR AS DIRECTED BY THE ENGINEER
5. HAY MULCH: TO BE PLACED ON EARTH SLOPES AT THE RATE OF 2 TONS/ACRE, ACHIEVE 90% GROUND COVER OR AS DIRECTED BY THE ENGINEER.
6. TOPSOIL: TO BE USED WITH SEED AS INDICATED ON THE PLANS, OR AS DIRECTED BY THE ENGINEER.
7. HYDROSEEDING: ALTHOUGH GUIDANCE IS GIVEN ABOVE THE SITE CONDITIONS AND THE TYPE OF HYDROSEED WILL ULTIMATELY DICTATE THE AMOUNTS AND TYPES OF SOIL AMENDMENTS TO BE APPLIED
8. TURF ESTABLISHMENT: PLACING SEED, FERTILIZER, LIME AND MULCH PRIOR TO SEPTEMBER 15 AND AFTER APRIL 15 CAN BETTER ENSURE A VIGOROUS GROWTH OF GRASS.


ADAPTED FROM VTRANS TECHNICAL LANDSCAPE MANUAL FOR ROADWAYS AND TRANSPORTATION FACILITIES

**TURF ESTABLISHMENT**

REVISIONS	
JUNE 23, 2009	WHF
JANUARY 15, 2010	WHF
FEBRUARY 16, 2011	WHF

PROJECT NAME: PERU  
 PROJECT NUMBER: STP SCR(4)  
 FILE NAME: z07b106er0det.dgn  
 PROJECT LEADER: E. ATKINS  
 DESIGNED BY: M. BRADLEY  
 EPSC DETAIL SHEET I

PLOT DATE: 12/31/2014  
 DRAWN BY: T. BIGELOW  
 CHECKED BY: E. ATKINS  
 SHEET 35 OF 45

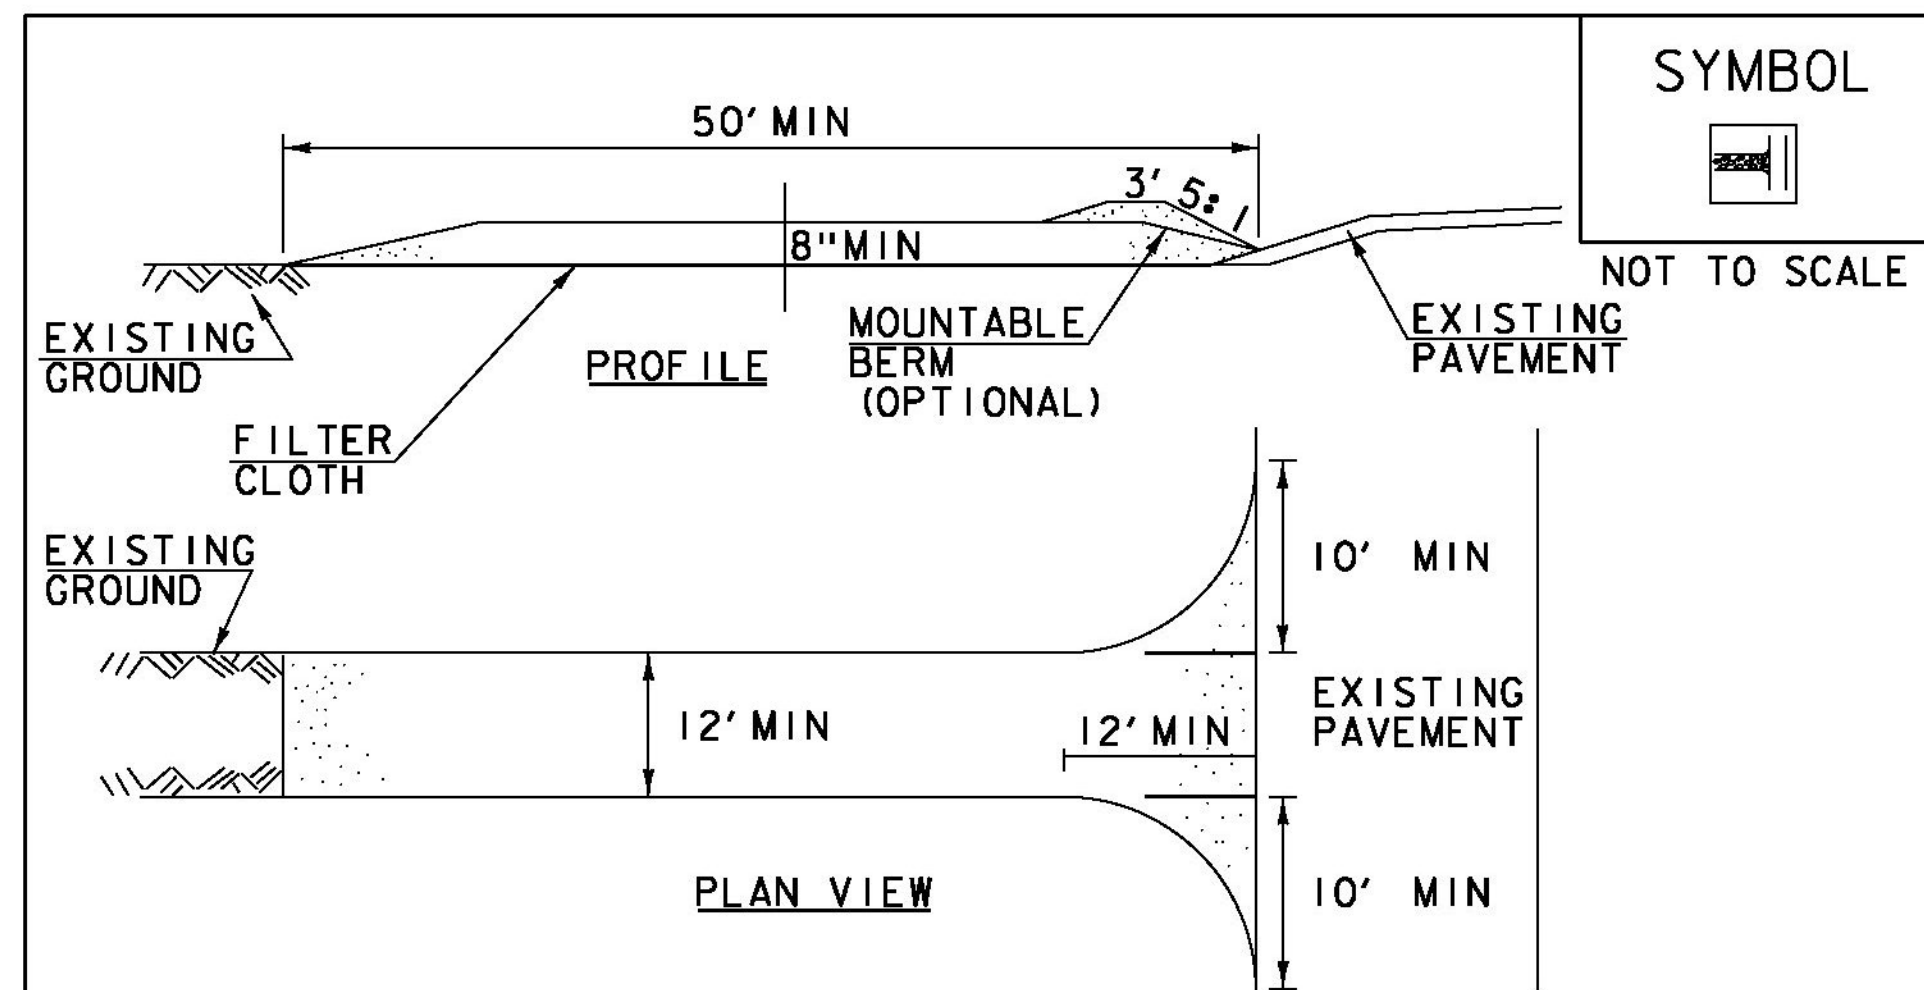

**CONSTRUCTION SPECIFICATIONS**

1. STONE SIZE- USE 1-4" STONE, RECLAIMED OR RECYCLED CONCRETE EQUIVALENT.
2. LENGTH- NOT LESS THAN 50' (EXCEPT ON A SINGLE RESIDENCE LOT WHERE A 30' MINIMUM LENGTH APPLIES).
3. THICKNESS- NOT LESS THAN 8".
4. WIDTH- 12' MINIMUM, BUT NOT LESS THAN THE FULL WIDTH AT POINTS WHERE INGRESS OR EGRESS OCCURS. 24' IF SINGLE ENTRANCE TO SITE.
5. GEOTEXTILE MUST BE PLACED OVER THE ENTIRE AREA PRIOR TO PLACING STONE.
6. SURFACE WATER- ALL SURFACE WATER FLOWING OR DIVERTED TOWARD CONSTRUCTION ENTRANCES SHALL BE PIPED BENEATH THE ENTRANCE. IF PIPING IS IMPRACTICAL, A MOUNTABLE BERM WITH 5:1 SLOPES WILL BE PERMITTED.
7. MAINTENANCE- THE ENTRANCE SHALL BE MAINTAINED IN A CONDITION WHICH WILL PREVENT TRACKING OR FLOWING OF SEDIMENT ONTO PUBLIC RIGHTS-OF-WAY, ALL SEDIMENT SPILLED, DROPPED, WASHED OR TRACKED ONTO PUBLIC RIGHTS-OF-WAY MUST BE REMOVED IMMEDIATELY.
8. WHEN WASHING IS REQUIRED, IT SHALL BE DONE ON AN AREA STABILIZED WITH STONE AND WHICH DRAINS INTO AN APPROVED SEDIMENT TRAPPING DEVICE.
9. PERIODIC INSPECTION AND NEEDED MAINTENANCE SHALL BE PROVIDED ACCORDING TO PERMIT REQUIREMENTS.


ADAPTED FROM DETAILS PROVIDED BY: NEW YORK STATE DEC  
ORIGINALLY DEVELOPED BY USDA-NRCS  
VERMONT DEPARTMENT OF ENVIRONMENTAL CONSERVATION

**STABILIZED  
CONSTRUCTION  
ENTRANCE**

NOTES:  
REFER TO "THE VERMONT STANDARDS & SPECIFICATIONS FOR  
EROSION PREVENTION & SEDIMENT CONTROL -2006- "FROM  
THE VT AGENCY OF NATURAL RESOURCES FOR ADDITIONAL  
GUIDANCE.

THIS WORK SHALL BE PERFORMED IN ACCORDANCE WITH  
SECTION 653 FOR VEHICLE TRACKING PAD (PAY ITEM 653.35)  
OR AS SPECIFIED IN THE CONTRACT.

REVISIONS	
MARCH 24, 2008	WHF
JANUARY 13, 2009	WHF

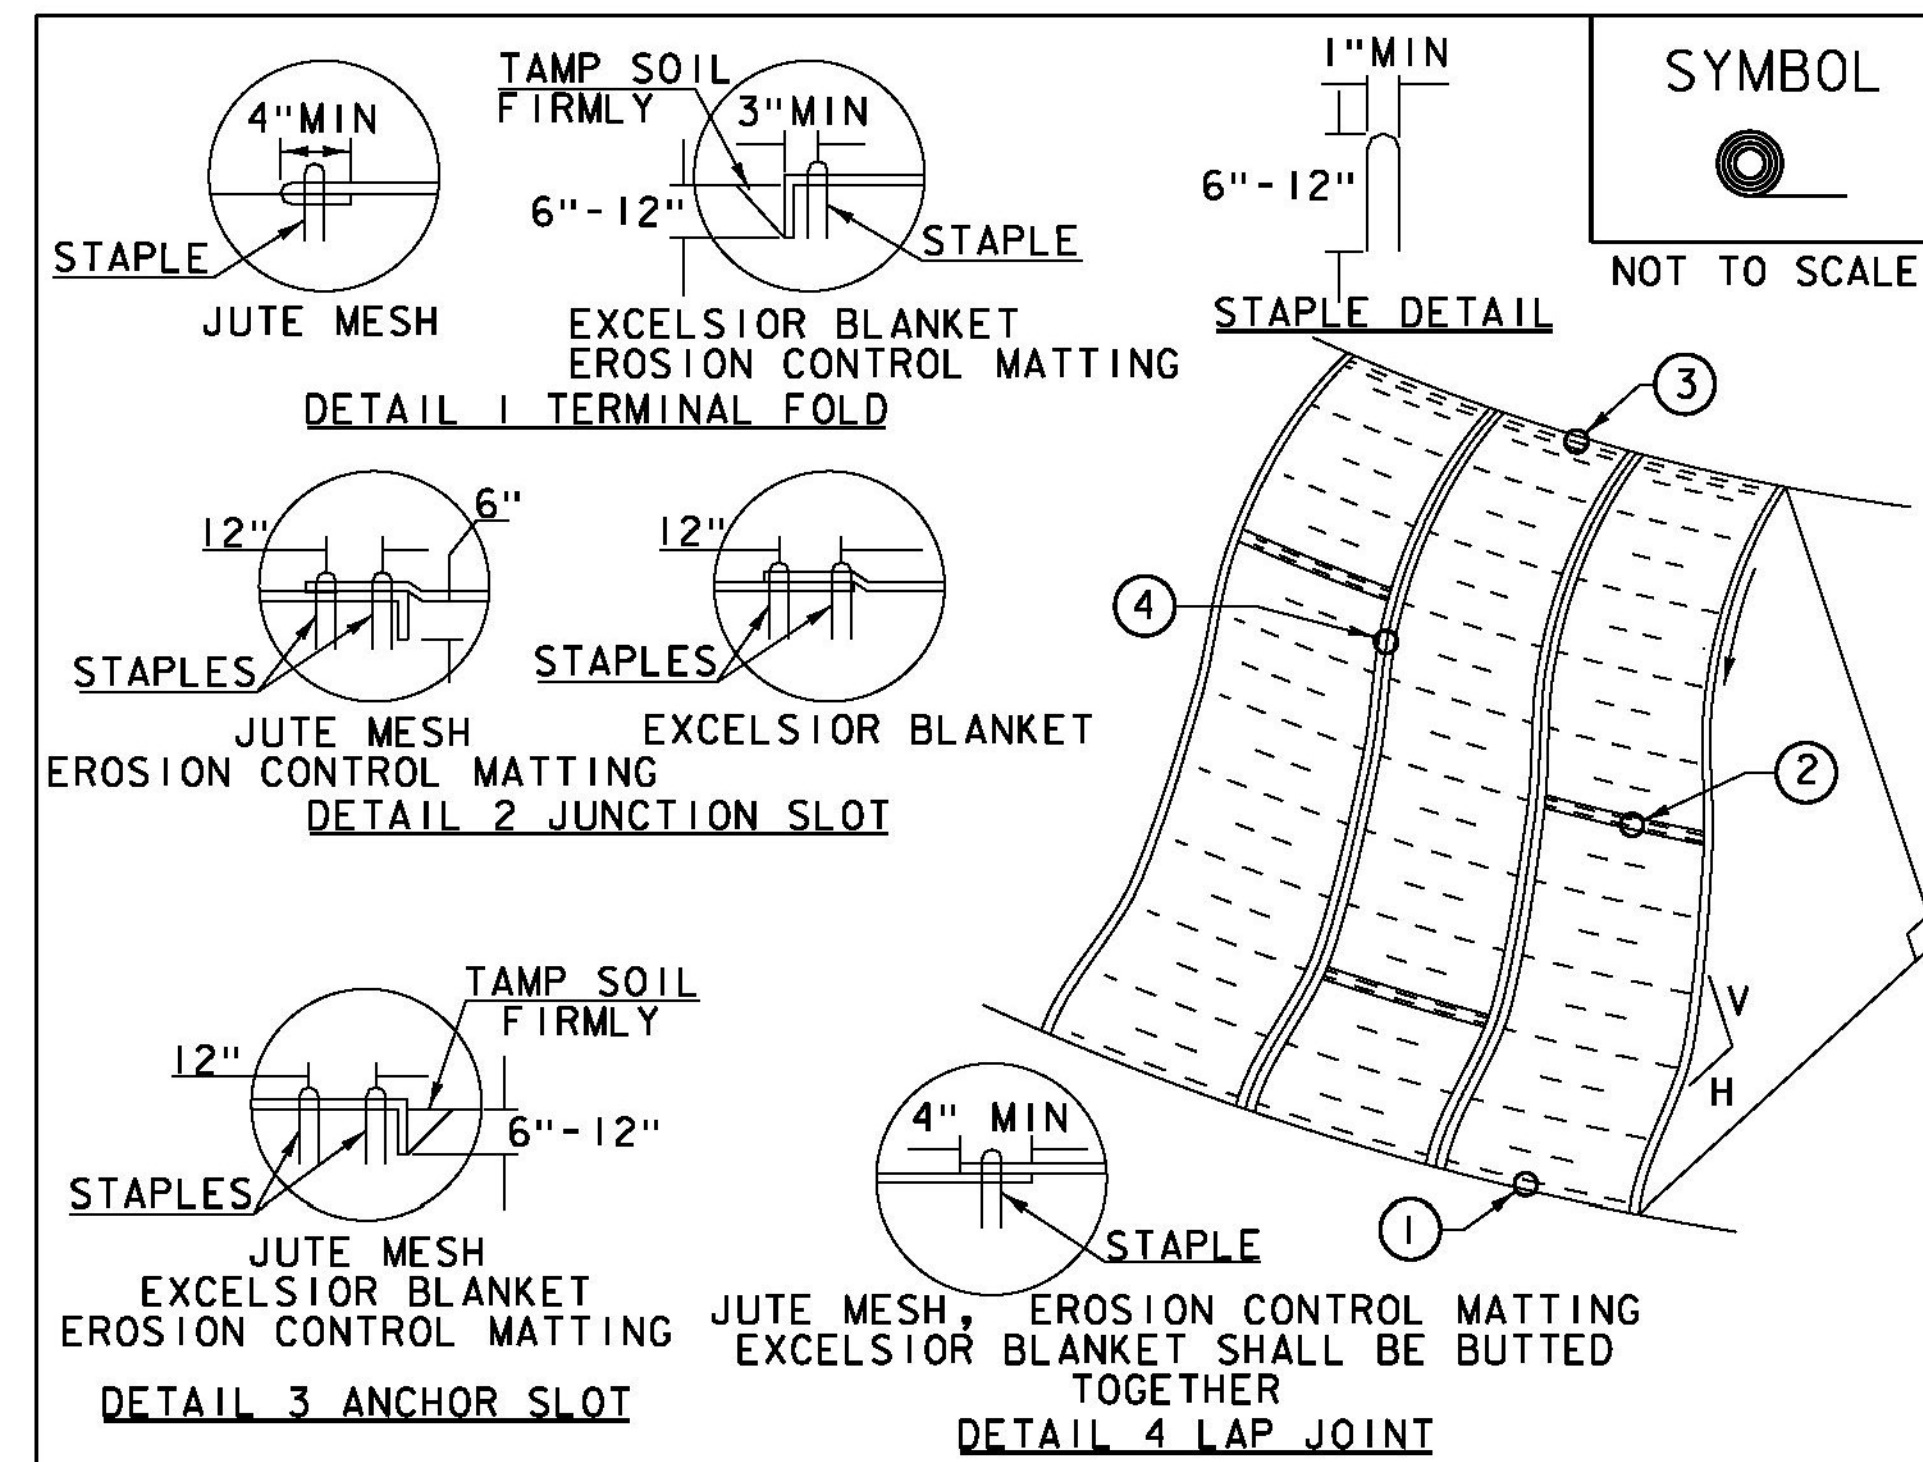

**CONSTRUCTION SPECIFICATIONS**

1. APPLY TO SLOPES GREATER THAN 3H:1V OR WHERE NECESSARY TO AID IN ESTABLISHING VEGETATION.
2. APPLY FERTILIZER, LIME SEED PRIOR TO PLACING MATTING.
3. STAPLES ARE TO BE PLACED ALTERNATELY, IN COLUMNS APPROXIMATELY 2' APART AND IN ROWS APPROXIMATELY 3' APART. APPROXIMATELY 175 STAPLES ARE REQUIRED PER 4' X 225' ROLL OF MATERIAL AND 125 STAPLES ARE REQUIRED PER 4' X 150' ROLL OF MATERIAL.
4. DISTURBED AREAS SHALL BE SMOOTHLY GRADED. EROSION CONTROL MATERIAL SHALL BE PLACED LOOSELY OVER GROUND SURFACE. DO NOT STRETCH.
5. ALL TERMINAL ENDS AND TRANSVERSE LAPS SHALL BE STAPLED AT APPROXIMATELY 12" INTERVALS.

ADAPTED FROM DETAILS PROVIDED BY: NEW YORK STATE DEC  
ORIGINALLY DEVELOPED BY USDA-NRCS  
VERMONT DEPARTMENT OF ENVIRONMENTAL CONSERVATION

**ROLLED EROSION  
CONTROL PRODUCT  
(RECP) SIDE SLOPE**

NOTES:  
REFER TO "THE VERMONT STANDARDS & SPECIFICATIONS FOR  
EROSION PREVENTION & SEDIMENT CONTROL -2006- "FROM  
THE VT AGENCY OF NATURAL RESOURCES FOR ADDITIONAL  
GUIDANCE.  
THIS WORK SHALL BE PERFORMED IN ACCORDANCE WITH SECTION  
653 AND AS SHOWN IN THE PLANS FOR TEMPORARY EROSION  
MATTING (PAY ITEM 653.20) OR PERMANENT EROSION MATTING  
(PAY ITEM 653.21).

REVISIONS	
APRIL 16, 2007	JMF
JANUARY 13, 2009	WHF

PROJECT NAME: PERU  
PROJECT NUMBER: STP SCRP(4)

FILE NAME: z07b106erodet.dgn  
PROJECT LEADER: E. ATKINS  
DESIGNED BY: M. BRADLEY  
EPSC DETAIL SHEET 2

PLOT DATE: 12/31/2014  
DRAWN BY: T. BIGELOW  
CHECKED BY: E. ATKINS  
SHEET 36 OF 45

**LEGEND**

[ ] = EXISTING SIGN  
 R&S = REMOVE AND SALVAGE  
 RET = RETAIN EXISTING SIGN OR POST  
 EL = 4" WHITE EDGE LINE  
 DYCL = 4" DOUBLE YELLOW CENTERLINE  
 CL = 4" YELLOW CENTERLINE  
 GORE = GORING

**DURABLE 4 INCH WHITE LINE, THERMOPLASTIC**  
 32+22.7 - 34+91.7 LT, 274 LF (EL)  
 32+22.7 - 34+91.7 RT, 267 LF (EL)  
 13+14.6 - 13+31.6 LT-RT, 126 LF (RESTORE SIX 9' X 18' PARKING STALLS)

**DURABLE 4 INCH YELLOW LINE, THERMOPLASTIC**  
 32+22.7 - 34+91.7 LT, 272 LF (DYCL)  
 32+22.7 - 34+91.7 LT, 260 LF (DYCL)  
 12+31.8 - 12+41.3 LT-RT, 20 LF (CL)


**DURABLE 6 INCH YELLOW LINE, THERMOPLASTIC**  
 32+47.7 - 34+91.7 LT-RT, 288 LF, (GORE)

**REMOVING SIGNS**  
 7 EACH

**RECTING SALVAGED SIGNS**  
 7 EACH

**NOTES:**

- FOR ADDITIONAL TEMPORARY PAVEMENT MARKINGS AND PAVEMENT MARKING MASK, SEE TRAFFIC CONTROL PLAN SHEETS
- THE CONTRACTOR SHALL RESTORE ALL DISTURBED PAVEMENT MARKINGS TO THEIR PRECONSTRUCTION CONDITION OR AS DIRECTED BY THE ENGINEER

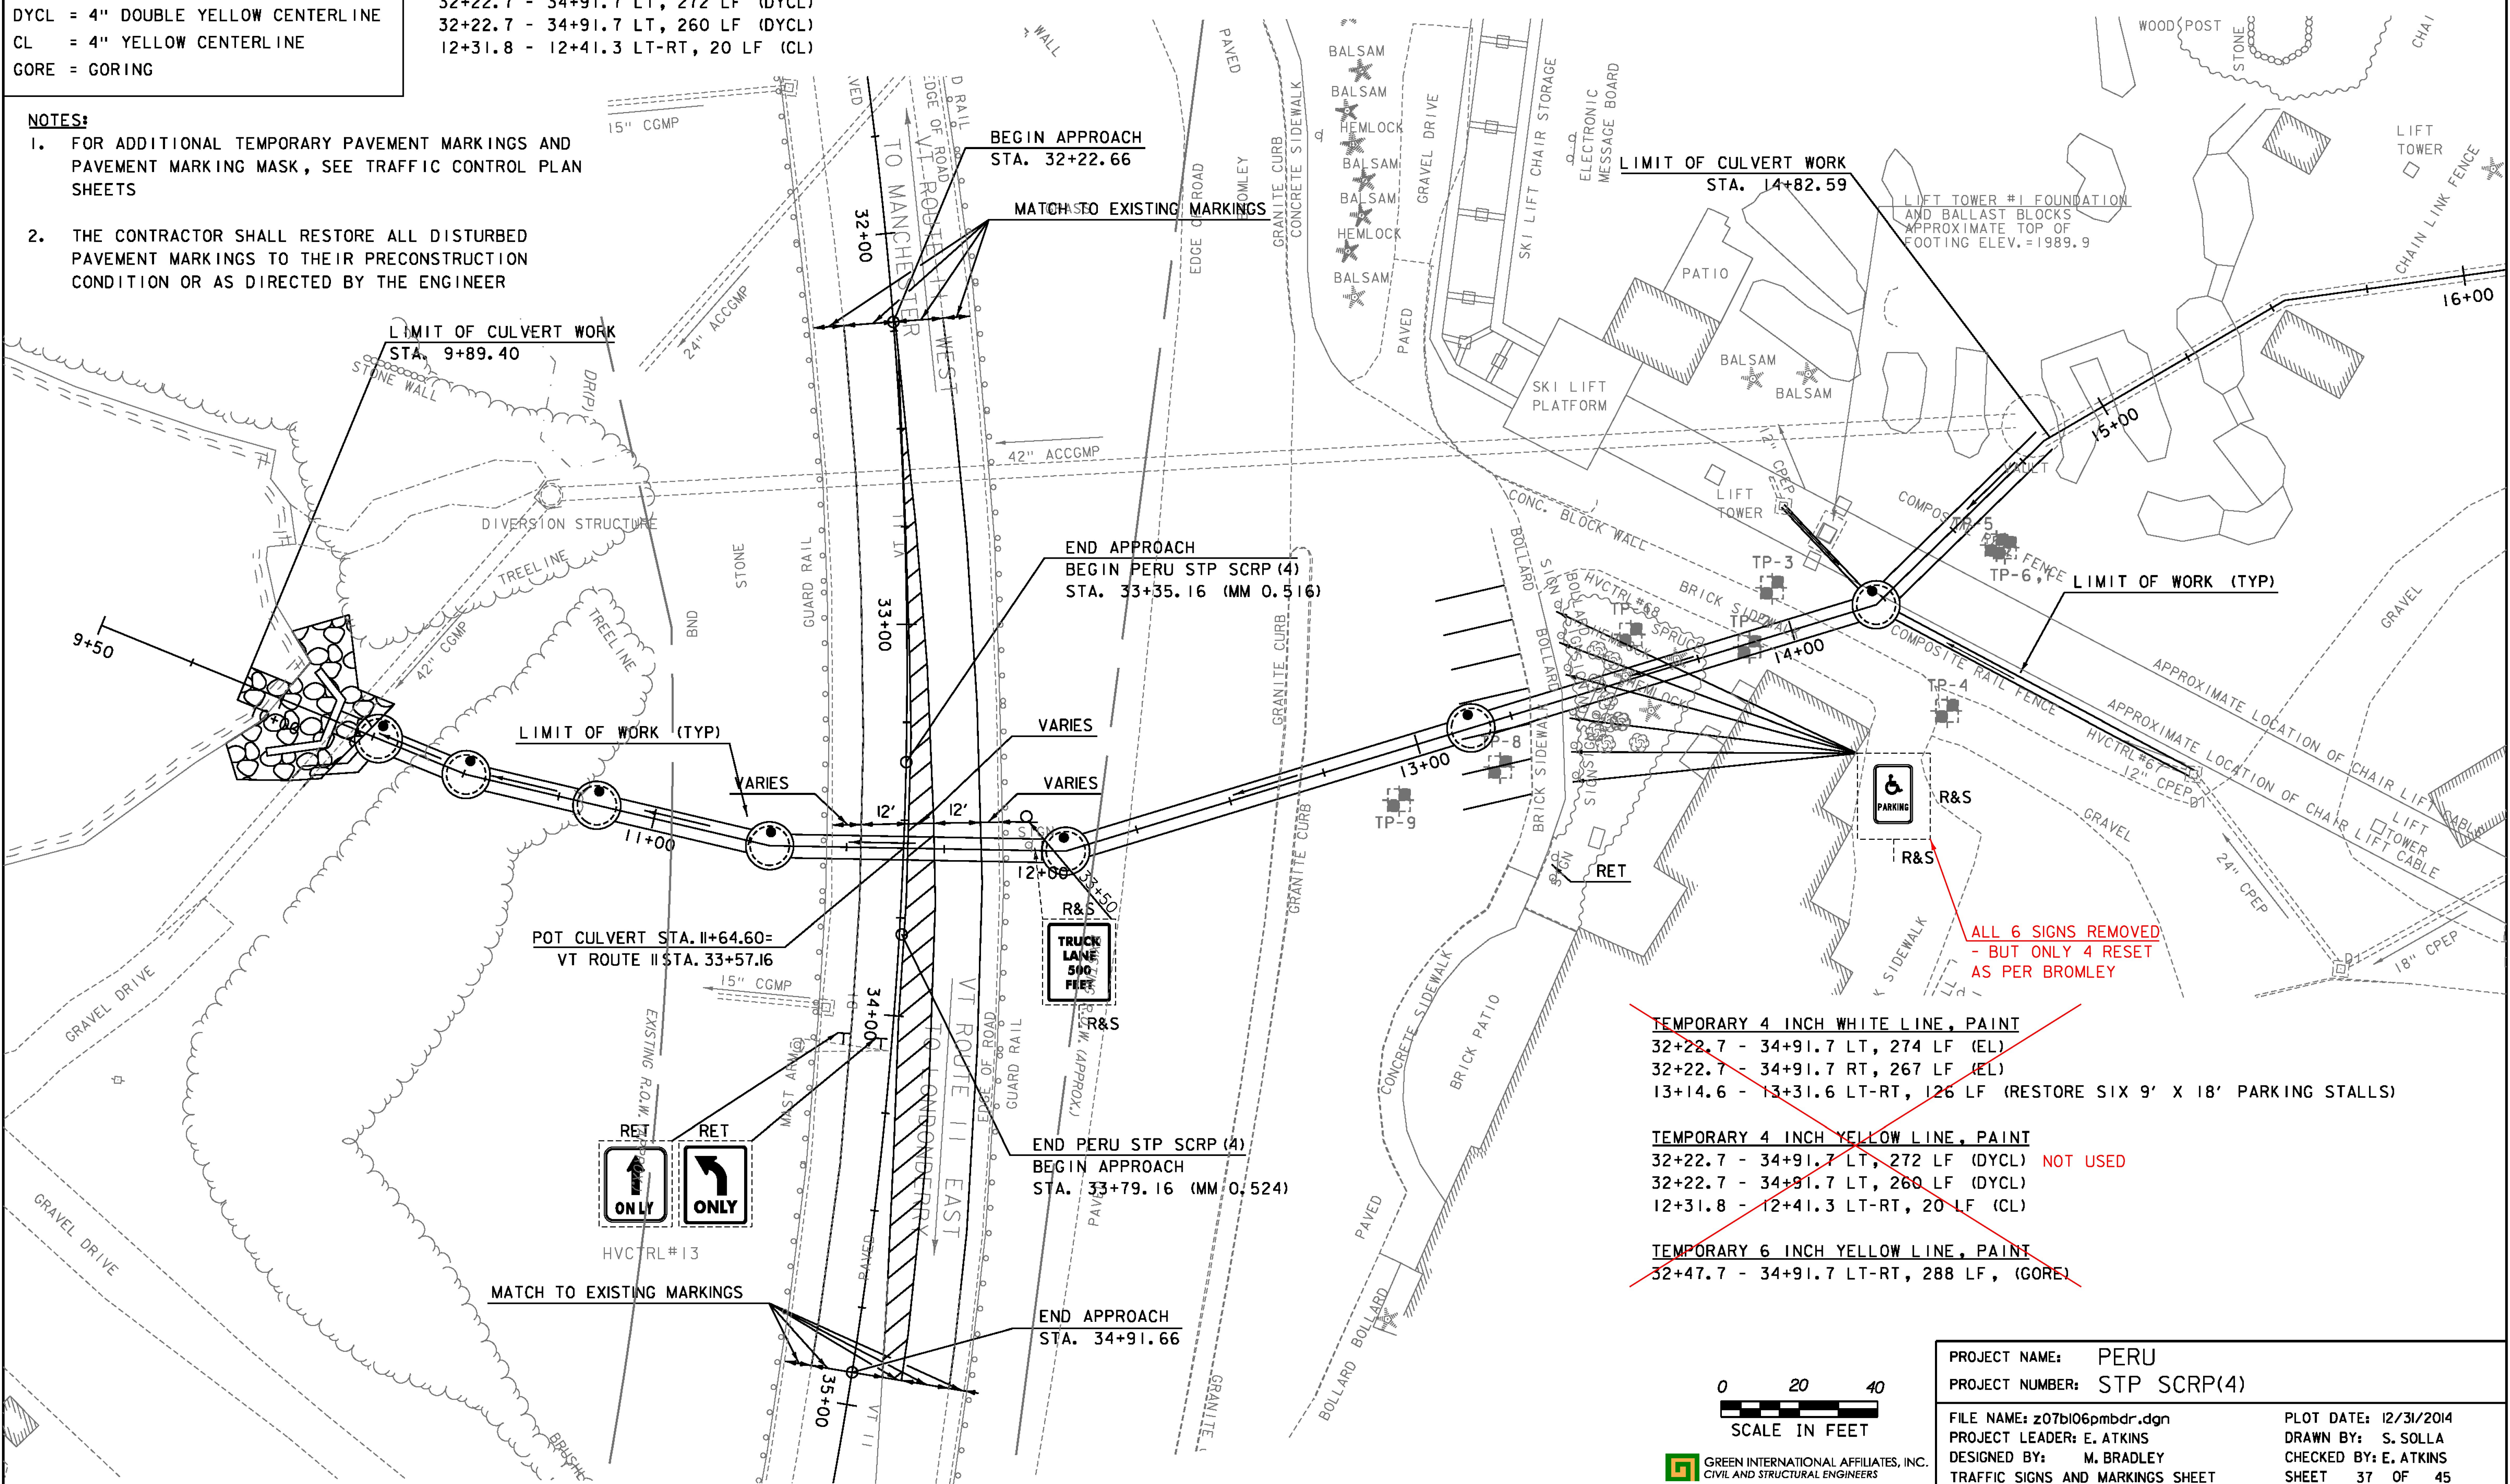


**ALL 6 SIGNS REMOVED - BUT ONLY 4 RESET AS PER BROMLEY**

~~TEMPORARY 4 INCH WHITE LINE, PAINT  
 32+22.7 - 34+91.7 LT, 274 LF (EL)  
 32+22.7 - 34+91.7 RT, 267 LF (EL)  
 13+14.6 - 13+31.6 LT-RT, 126 LF (RESTORE SIX 9' X 18' PARKING STALLS)~~

~~TEMPORARY 4 INCH YELLOW LINE, PAINT  
 32+22.7 - 34+91.7 LT, 272 LF (DYCL) NOT USED  
 32+22.7 - 34+91.7 LT, 260 LF (DYCL)  
 12+31.8 - 12+41.3 LT-RT, 20 LF (CL)~~


~~TEMPORARY 6 INCH YELLOW LINE, PAINT  
 32+47.7 - 34+91.7 LT-RT, 288 LF, (GORE)~~

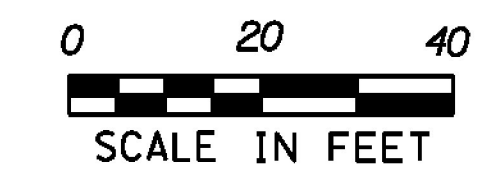


PROJECT NAME: PERU  
 PROJECT NUMBER: STP SCRP(4)

FILE NAME: z07b106pmbdr.dgn  
 PROJECT LEADER: E. ATKINS  
 DESIGNED BY: M. BRADLEY  
 TRAFFIC SIGNS AND MARKINGS SHEET


PLOT DATE: 12/31/2014  
 DRAWN BY: S. SOLLA  
 CHECKED BY: E. ATKINS  
 SHEET 37 OF 45

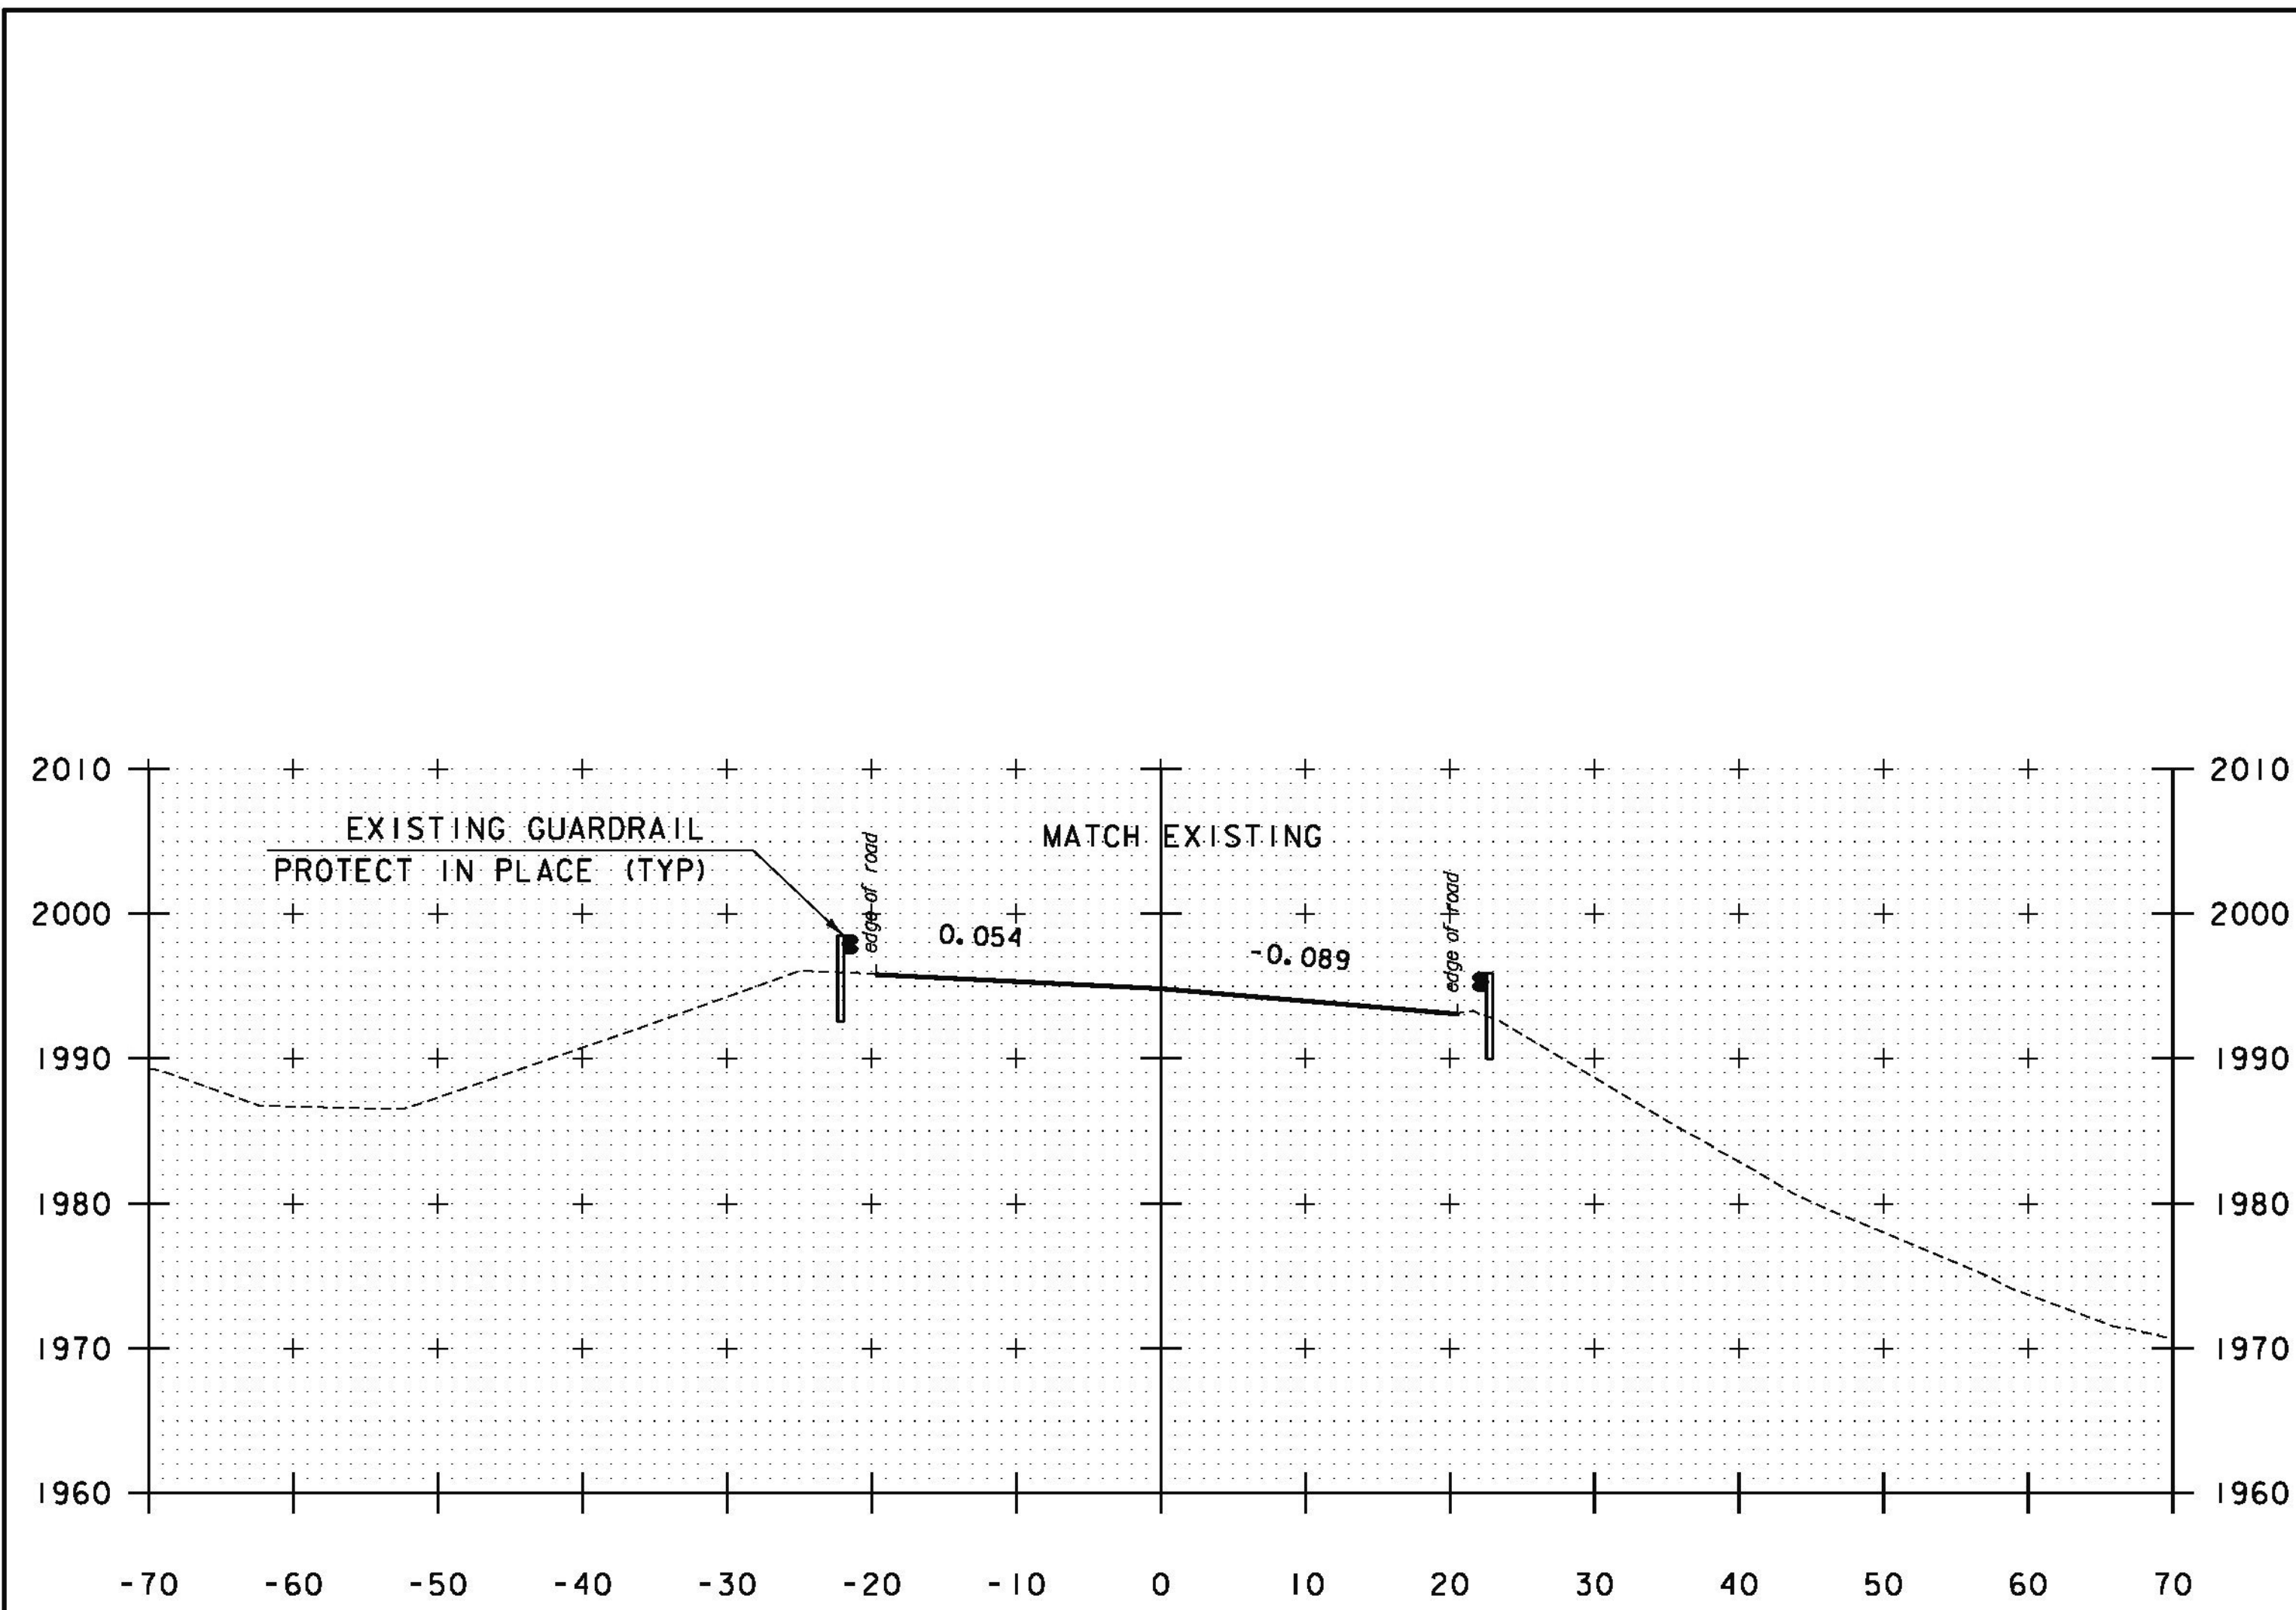


32+22.66 BEGIN APPROACH

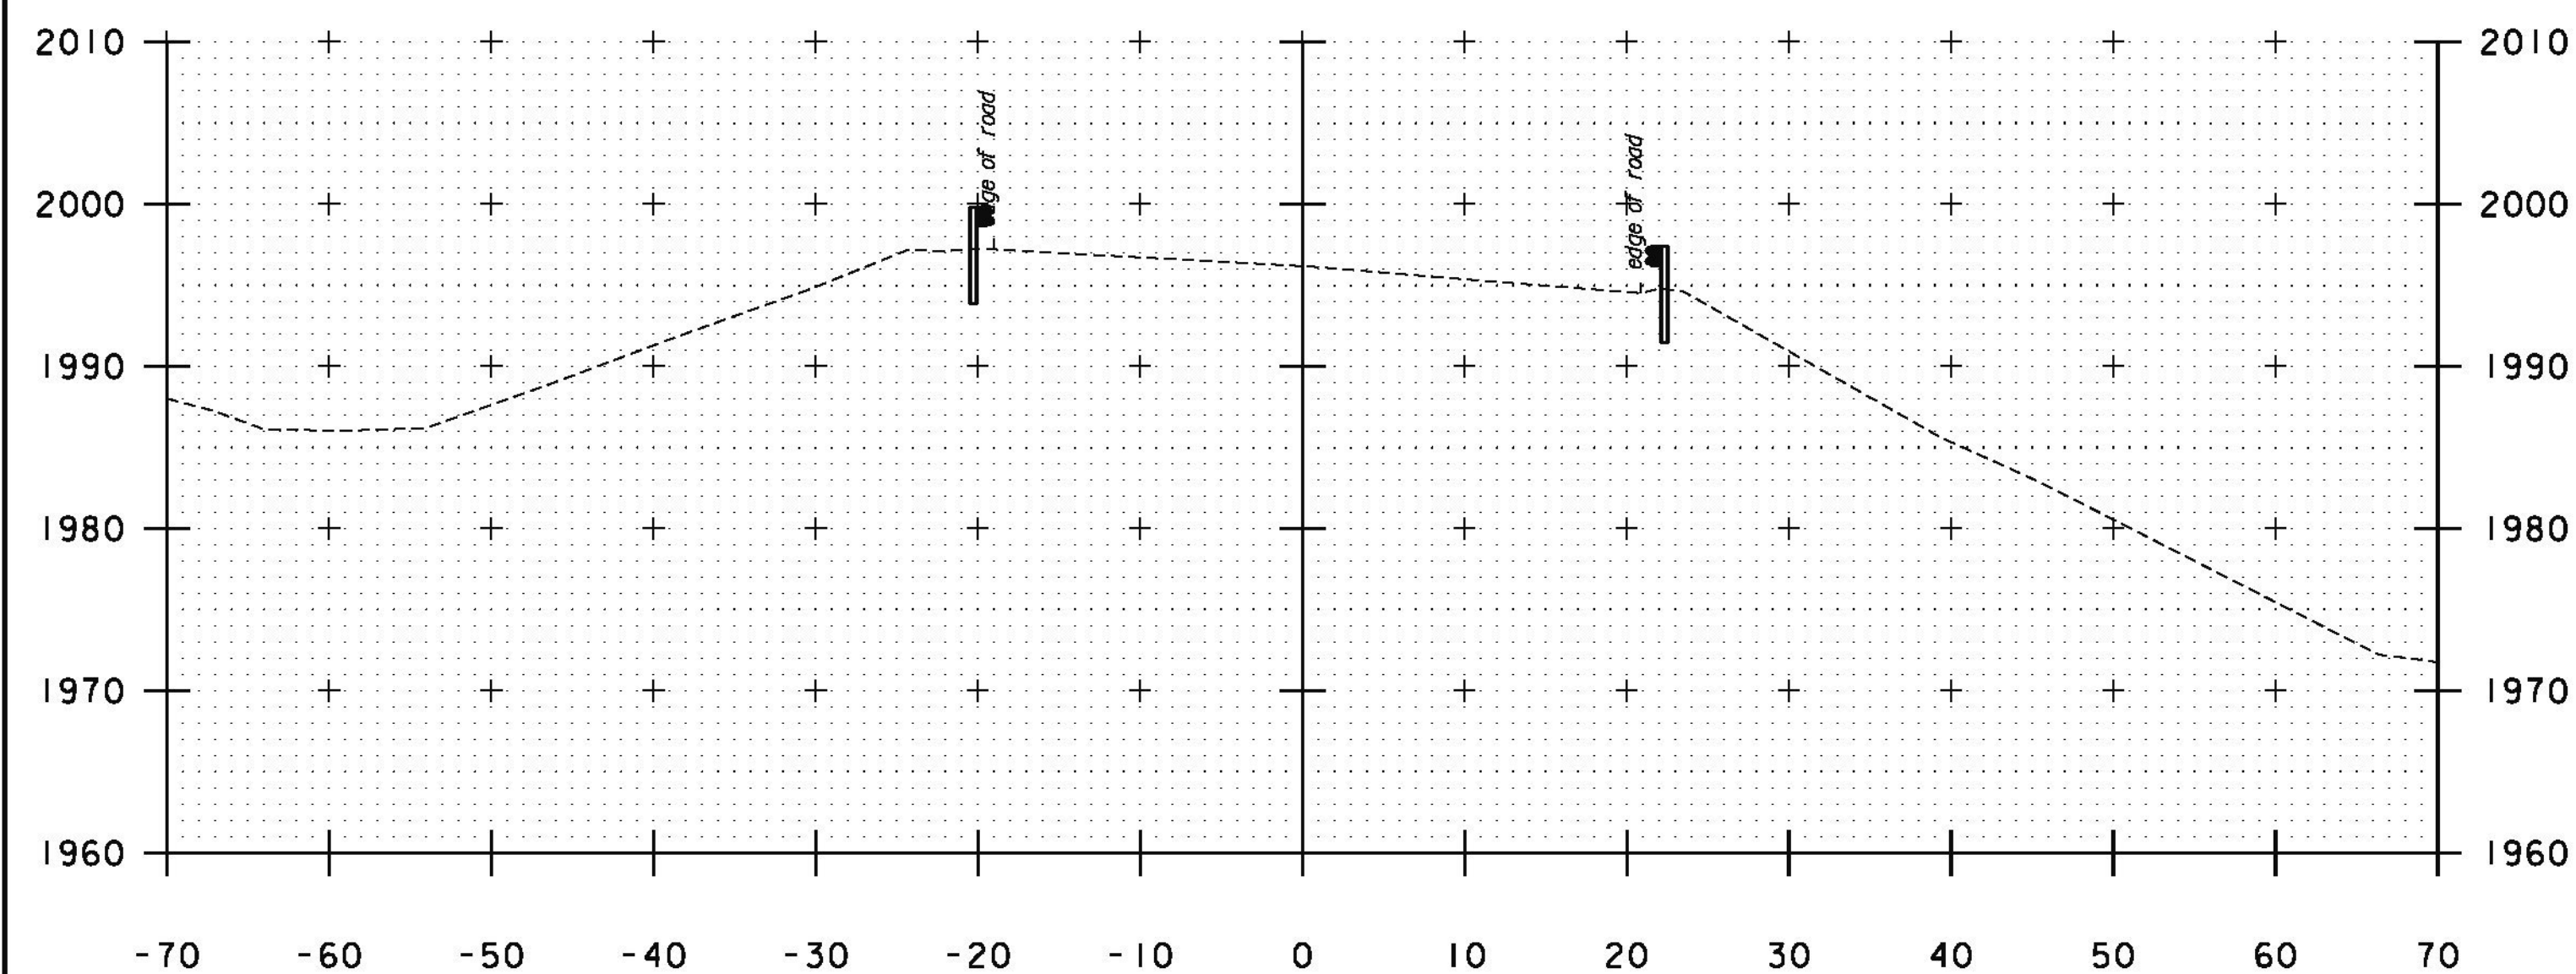

32+00

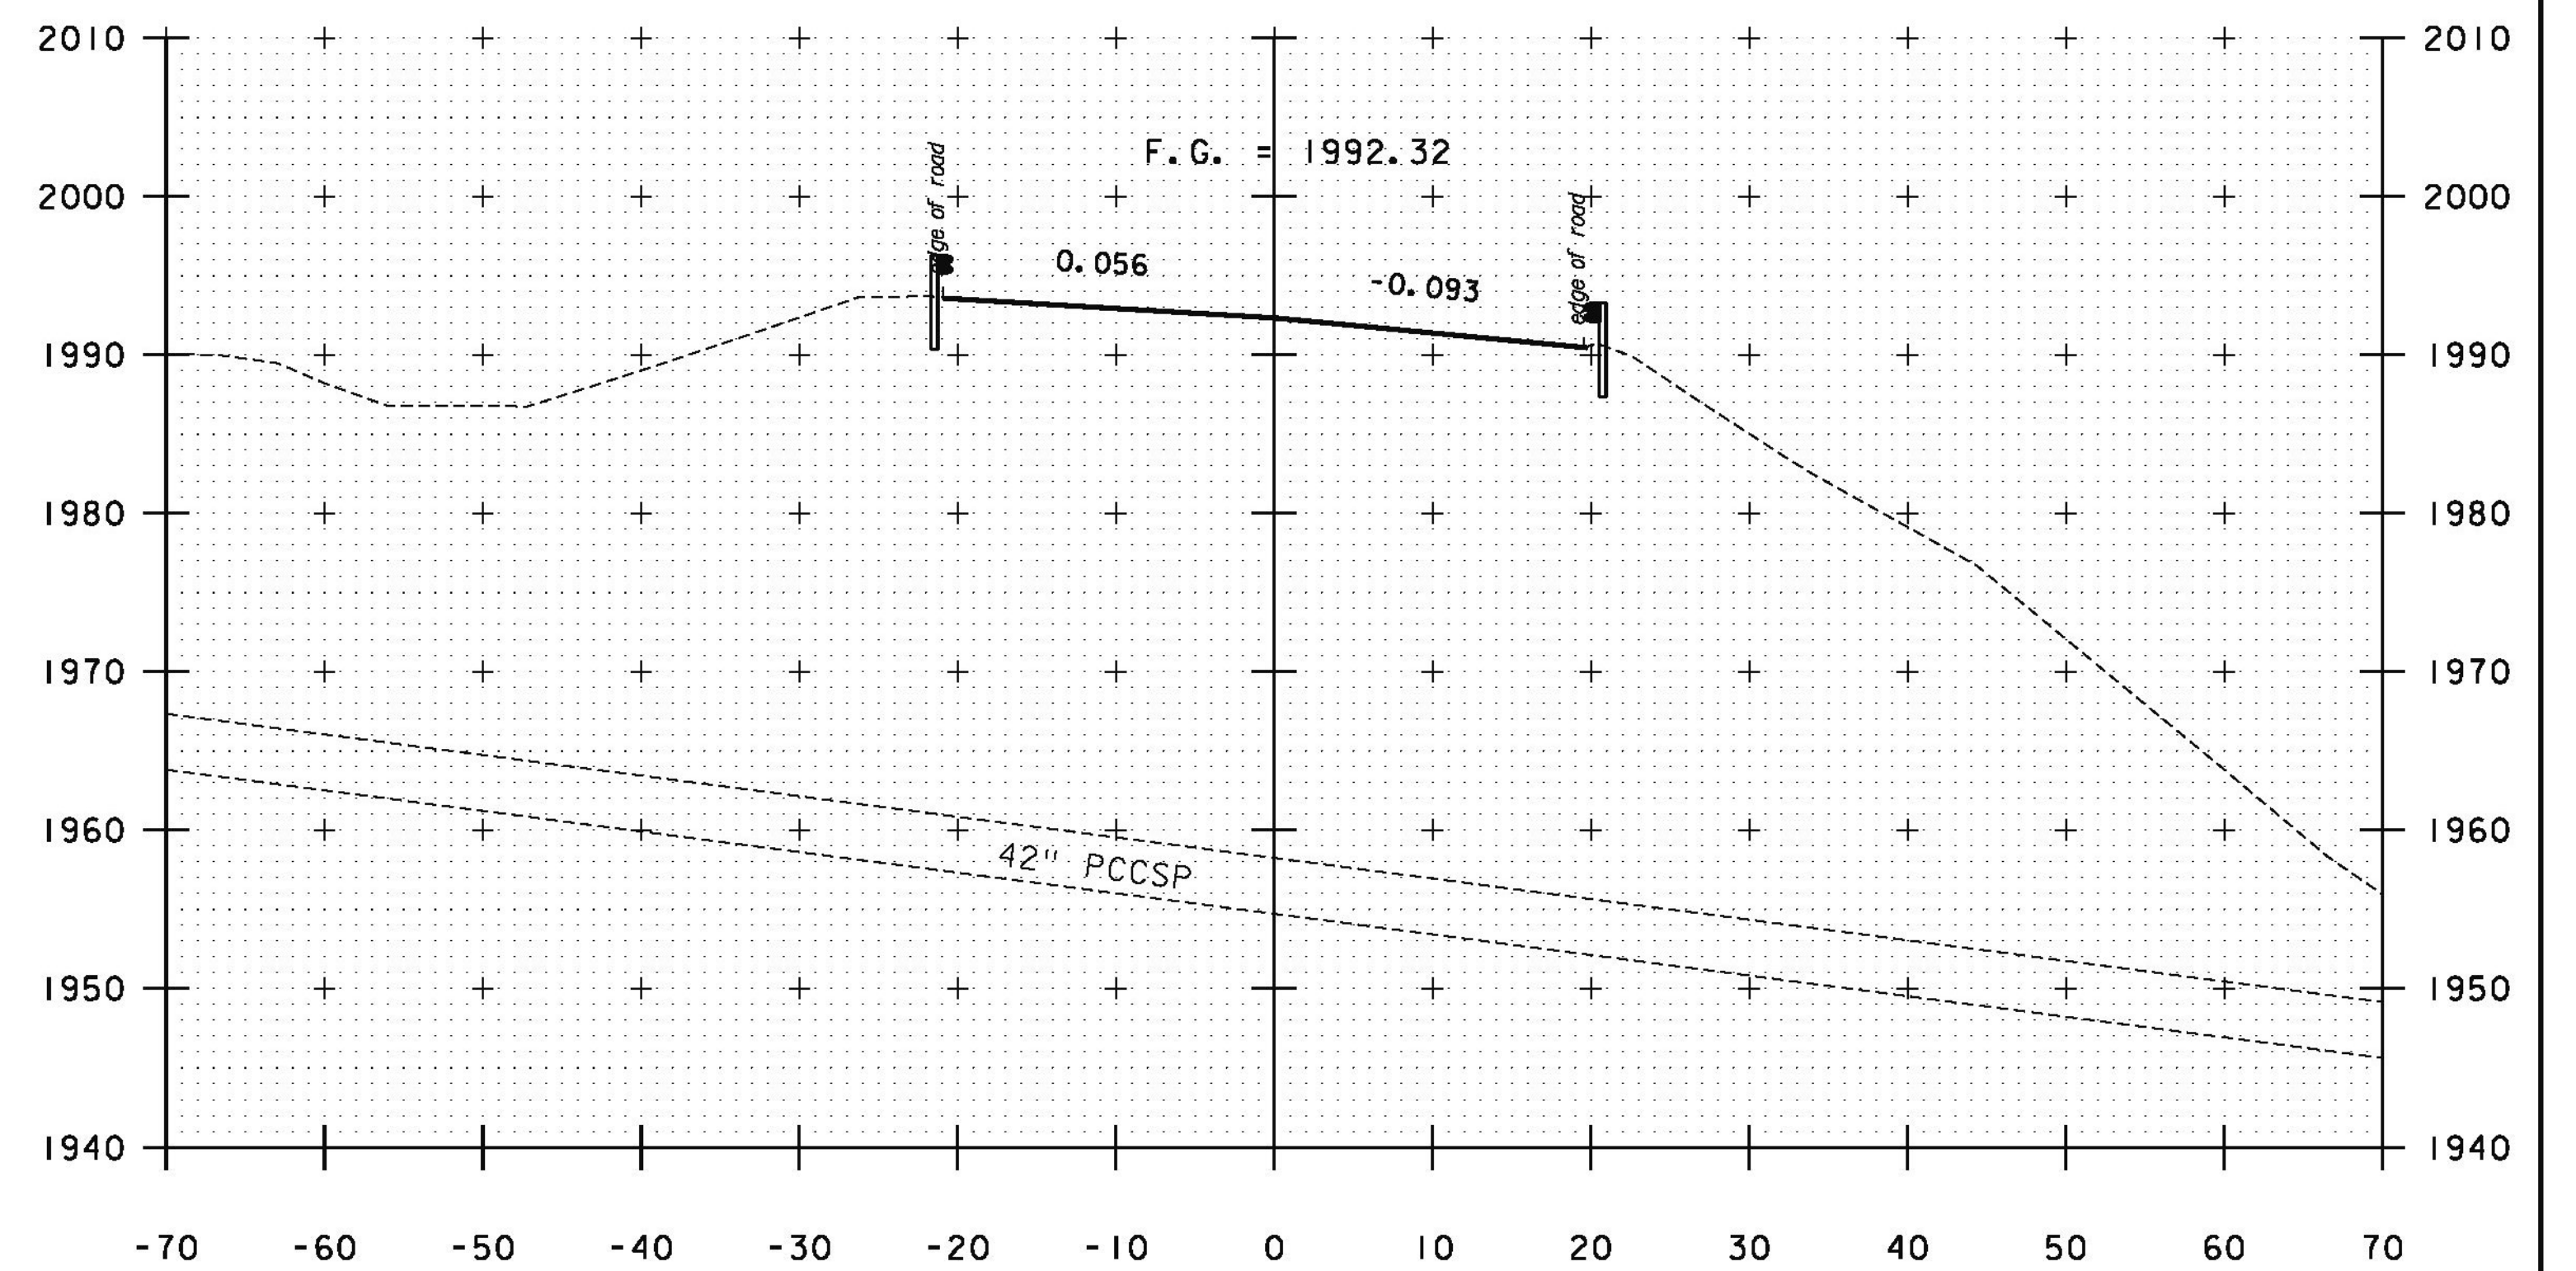


32+64.55

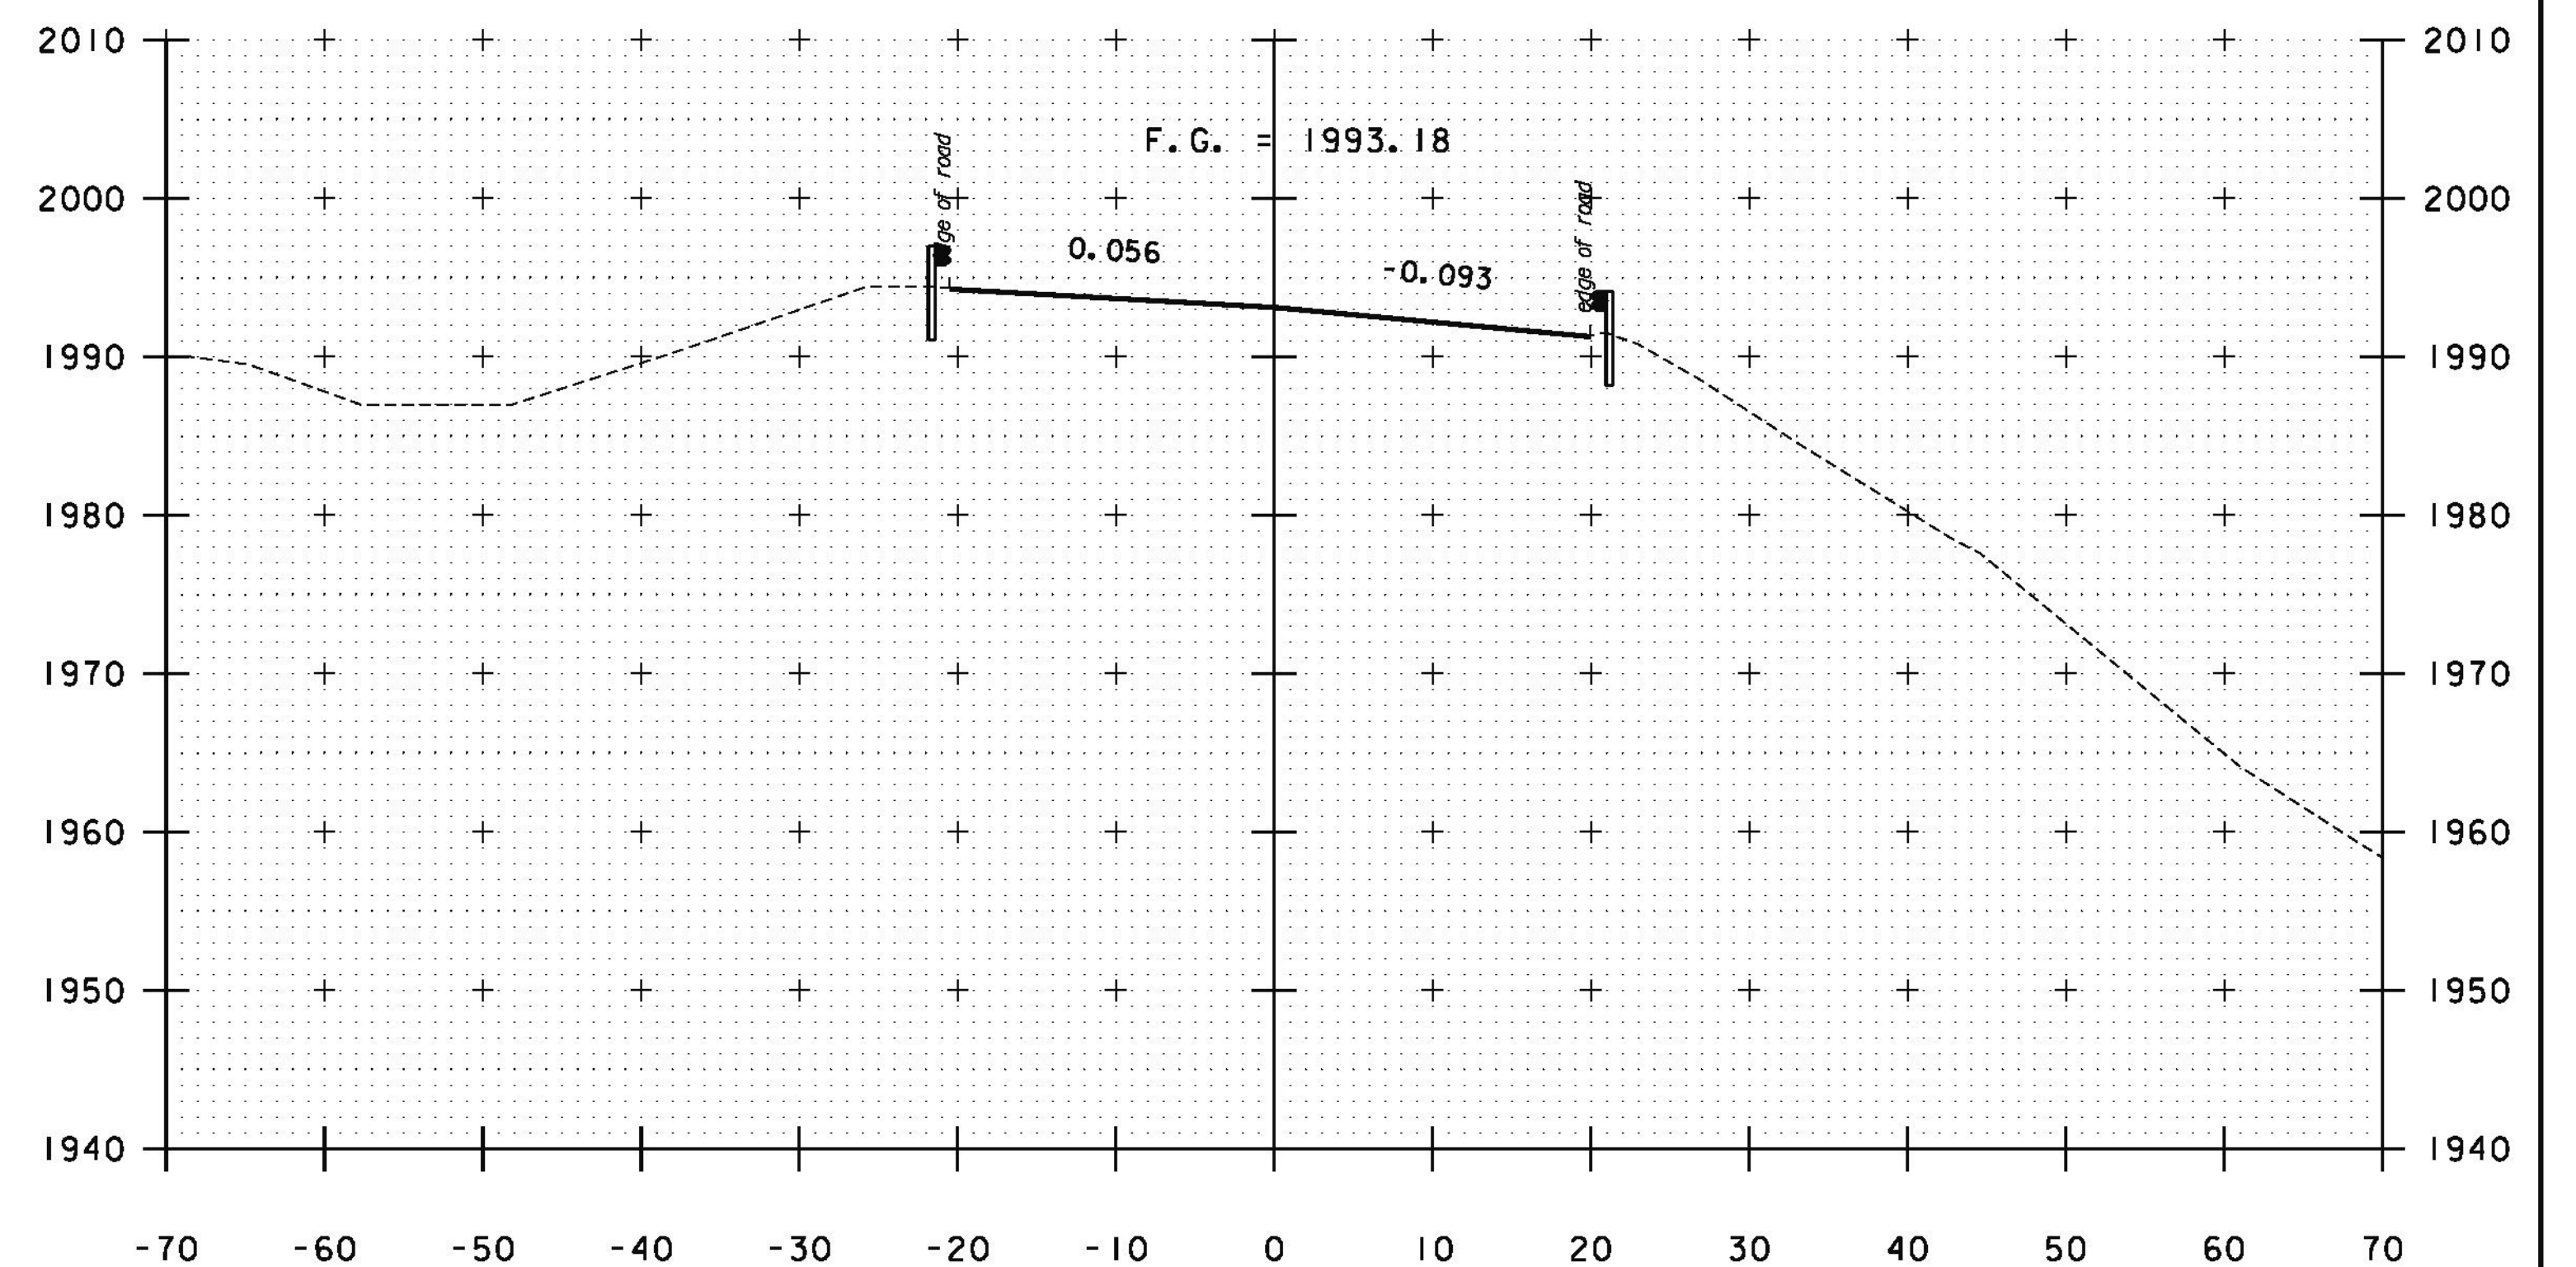


32+50

STA. 32+00 TO STA. 32+64.55


PROJECT NAME:	PERU	PLOT DATE:	12/31/2014
PROJECT NUMBER:	STP SCRP(4)	DRAWN BY:	M. BRADLEY
FILE NAME:	z07bi06xsl.dgn	DESIGNED BY:	M. BRADLEY
PROJECT LEADER:	E. ATKINS	CHECKED BY:	E. ATKINS
CROSS SECTION SHEET 1		SHEET	38 OF 45

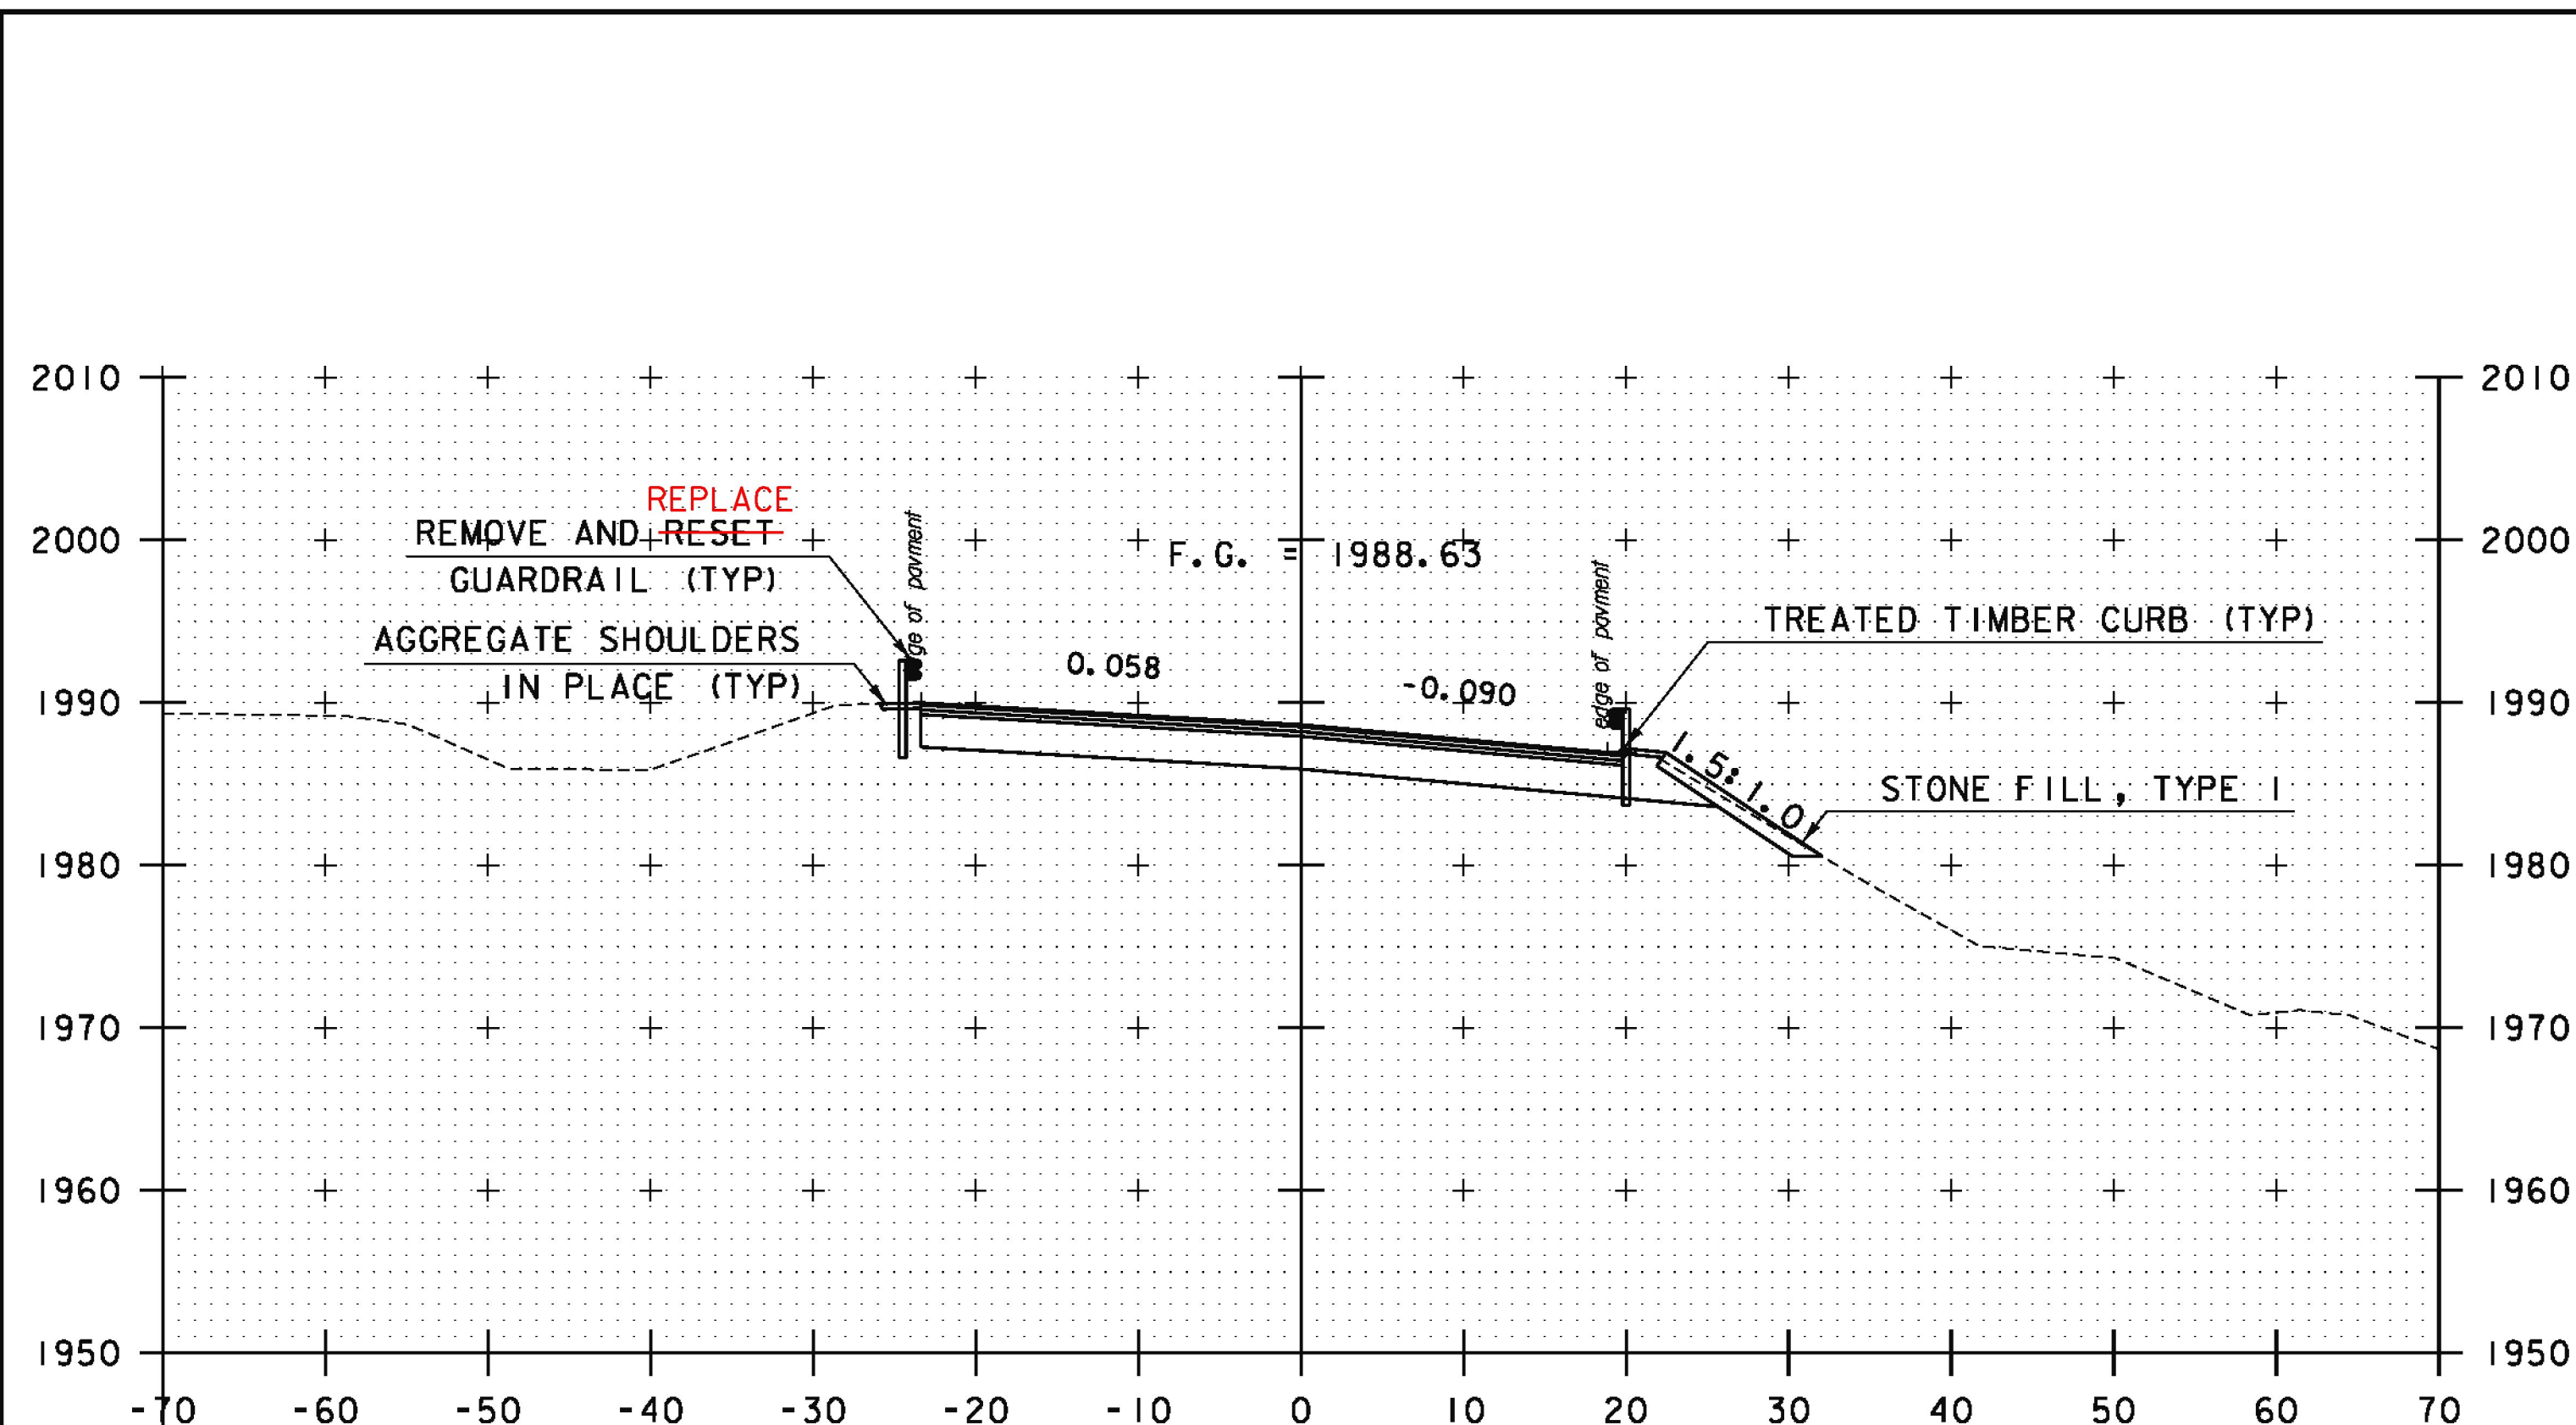


33+35.16 END APPROACH  
BEGIN PERU STP SCRP (4)

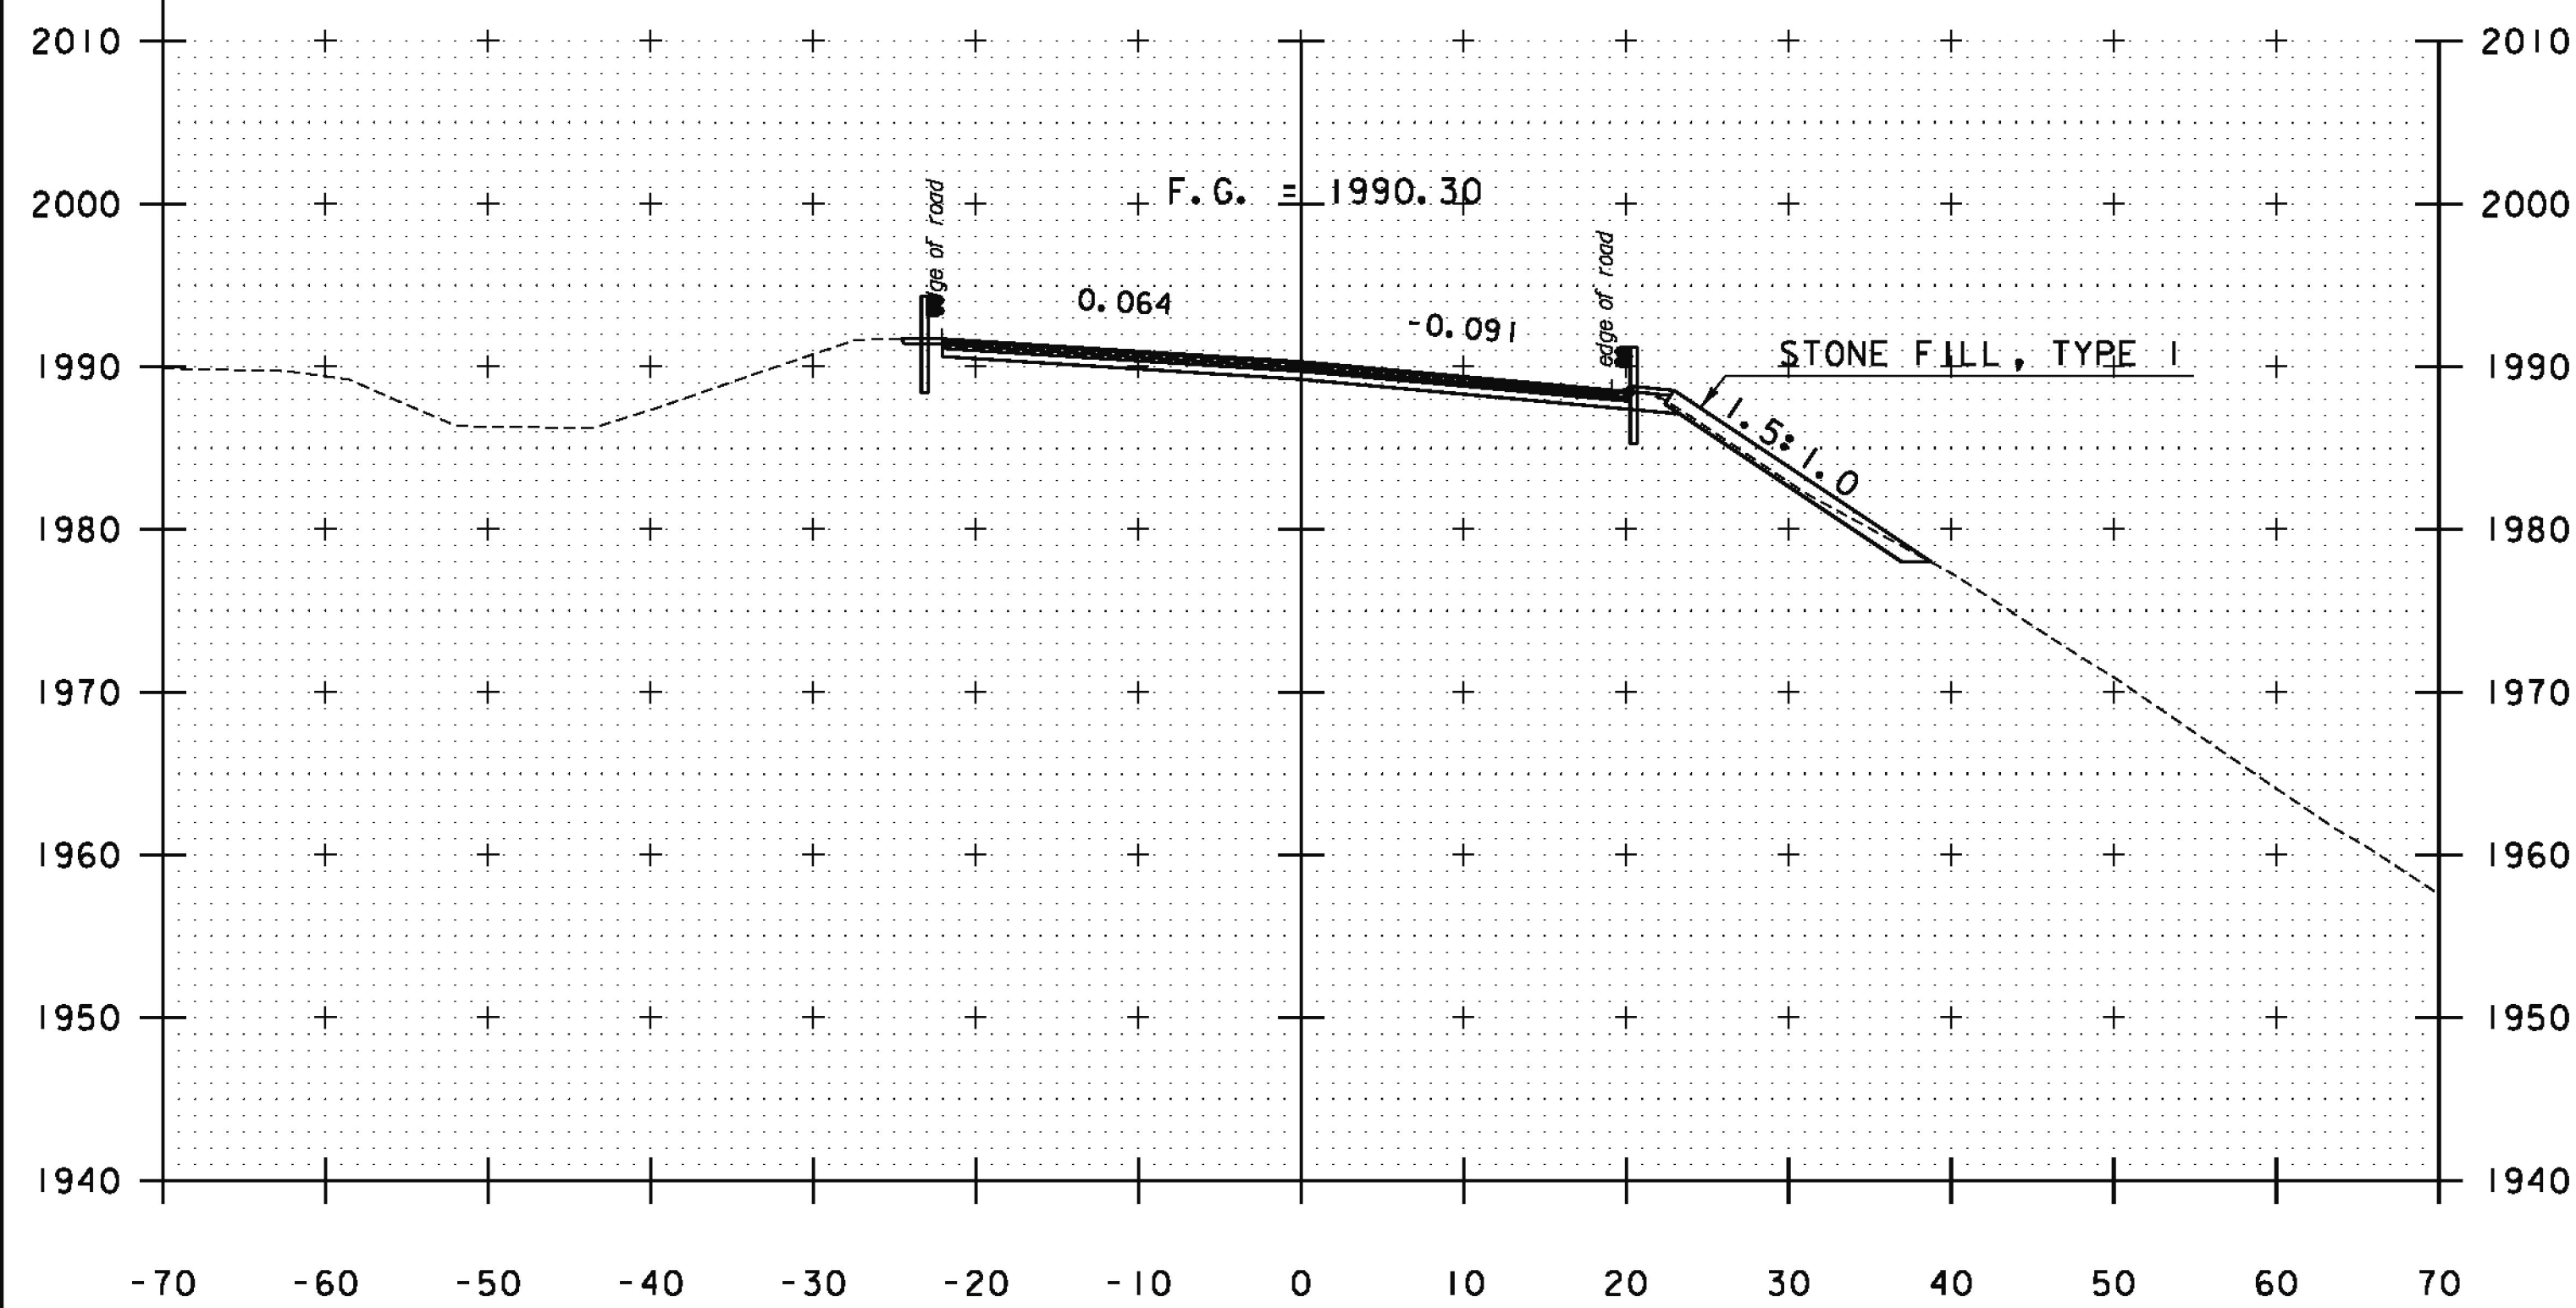


33+00

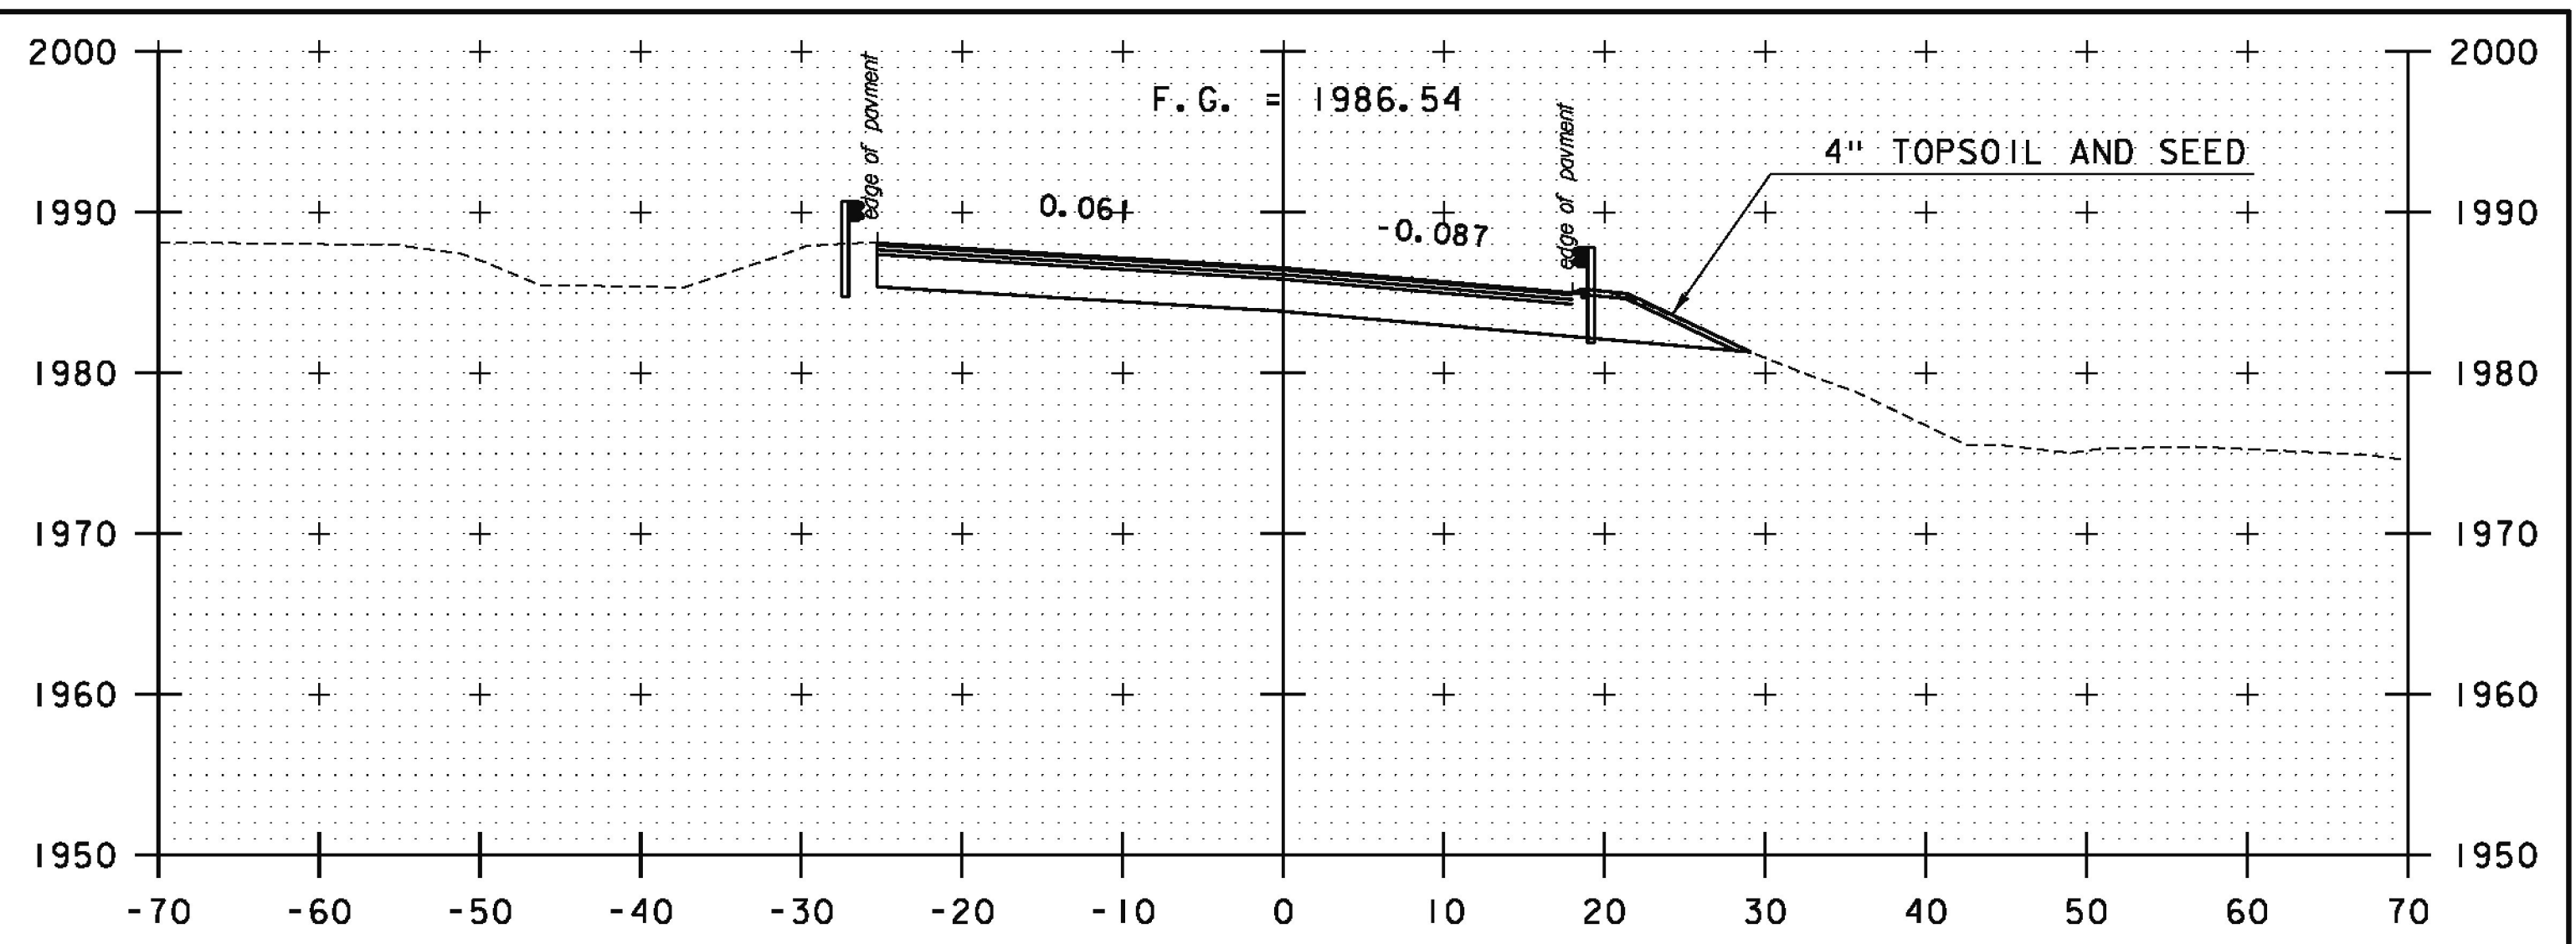

33+79.16 END PERU STP SCRP (4)  
BEGIN APPROACH

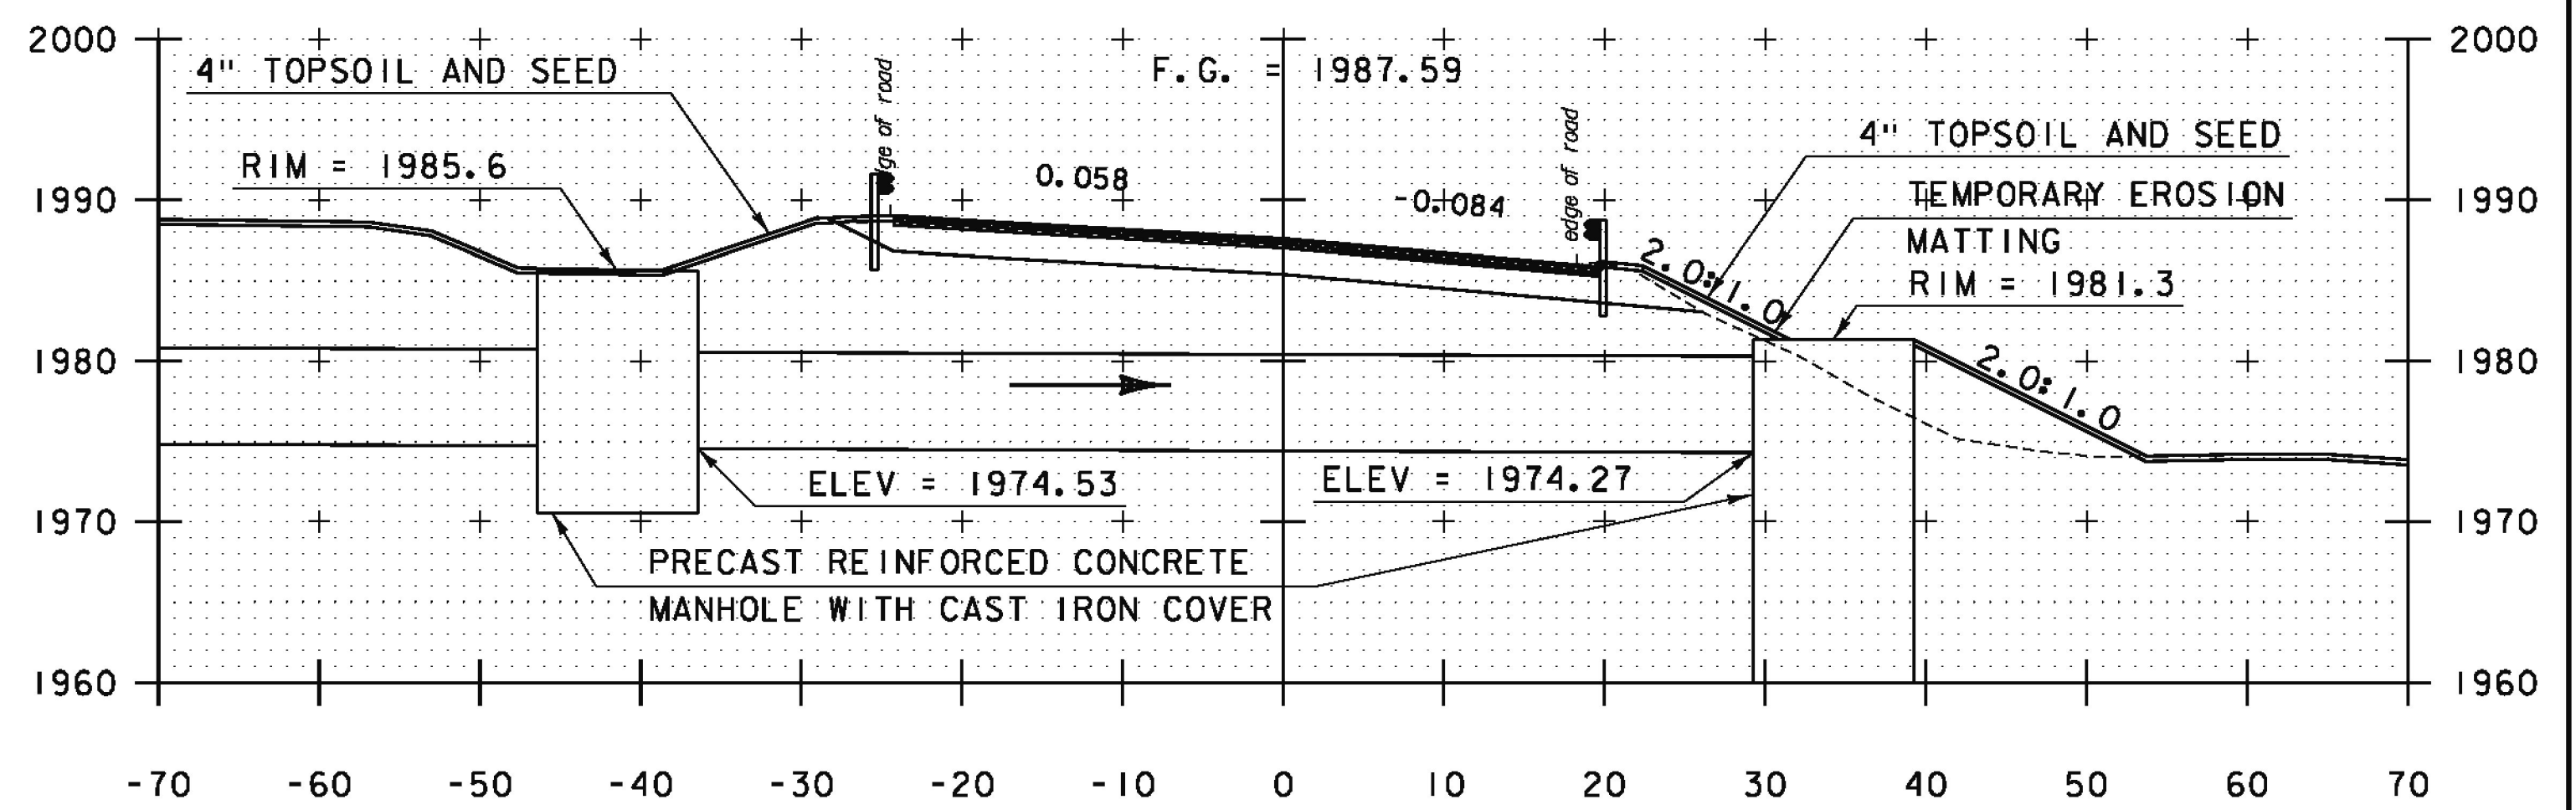

33+57 SPECIAL PROVISION (72" PCCSP/CAAP)  
SKEWED 91° 1' 48.00"

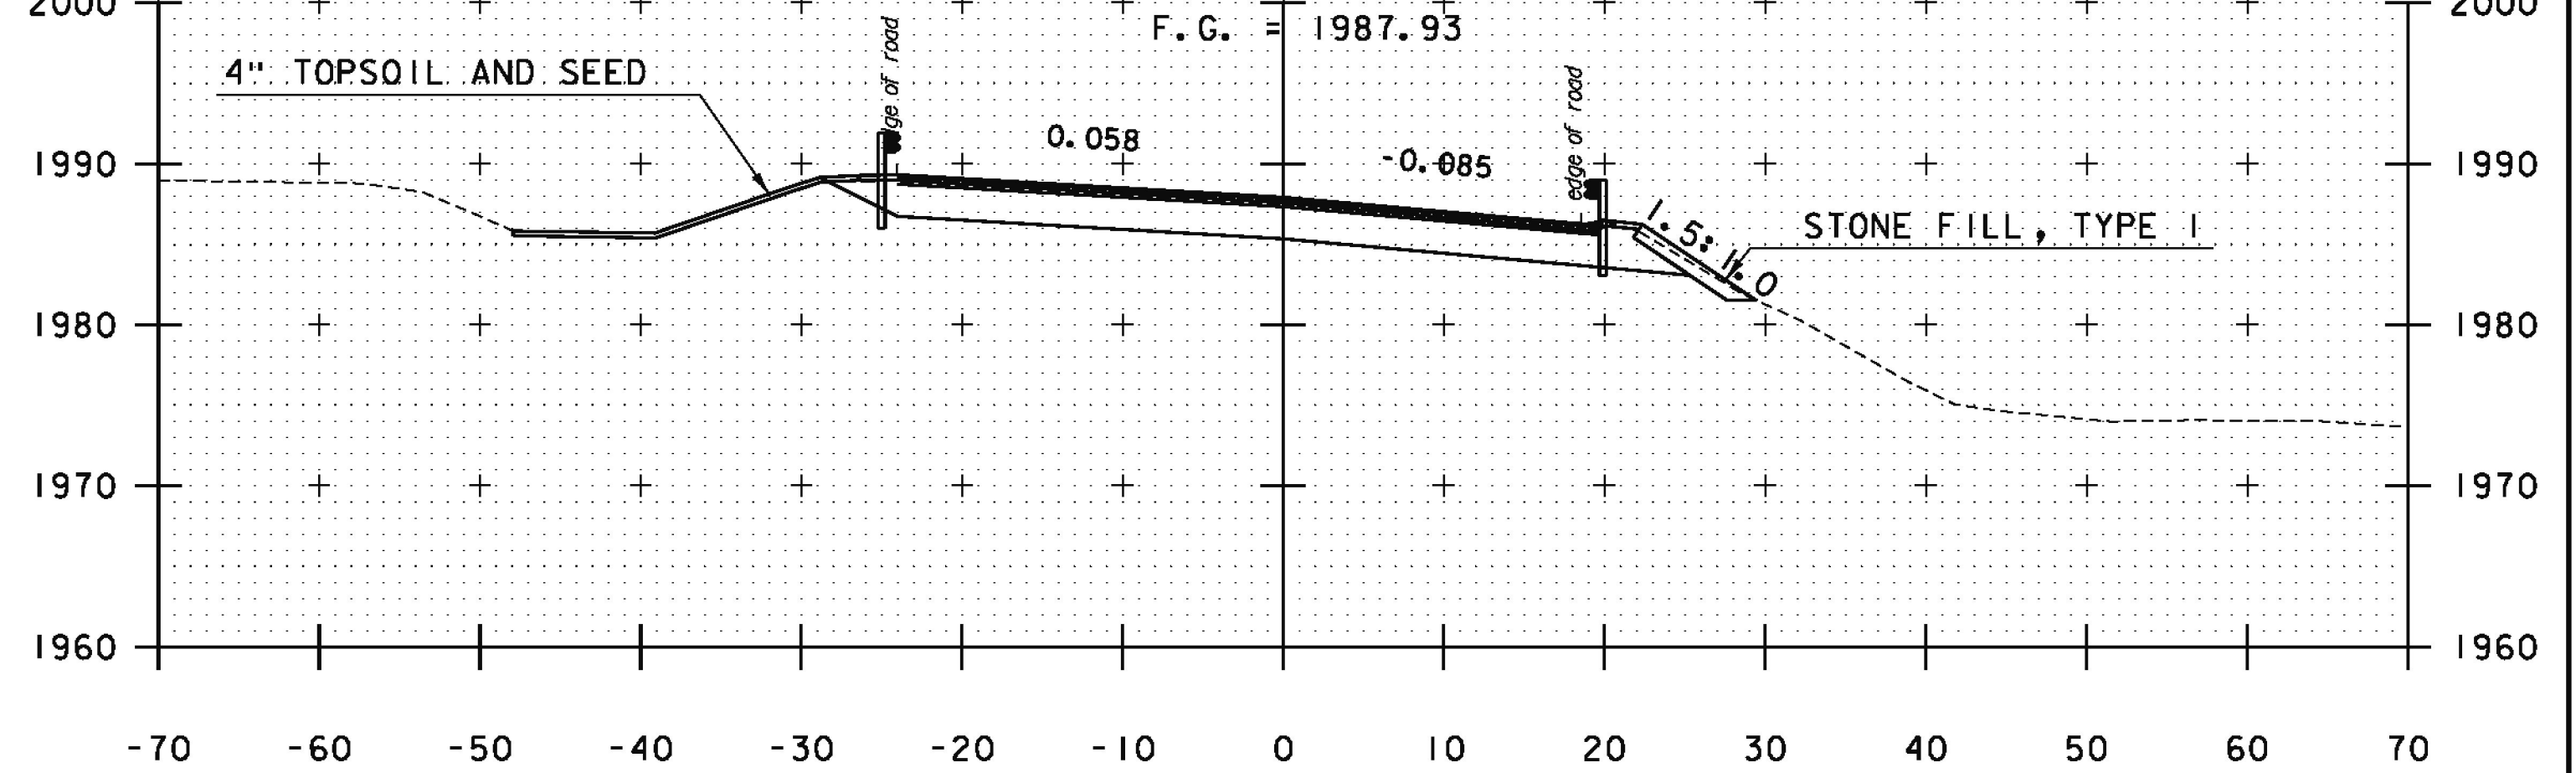


33+50


STA. 33+00 TO STA. 33+79.16

PROJECT NAME: PERU	PLOT DATE: 12/31/2014
PROJECT NUMBER: STP SCRP(4)	DRAWN BY: M. BRADLEY
FILE NAME: z07b106xsl.dgn	CHECKED BY: E. ATKINS
PROJECT LEADER: E. ATKINS	SHEET 39 OF 45
DESIGNED BY: M. BRADLEY	
CROSS SECTION SHEET 2	




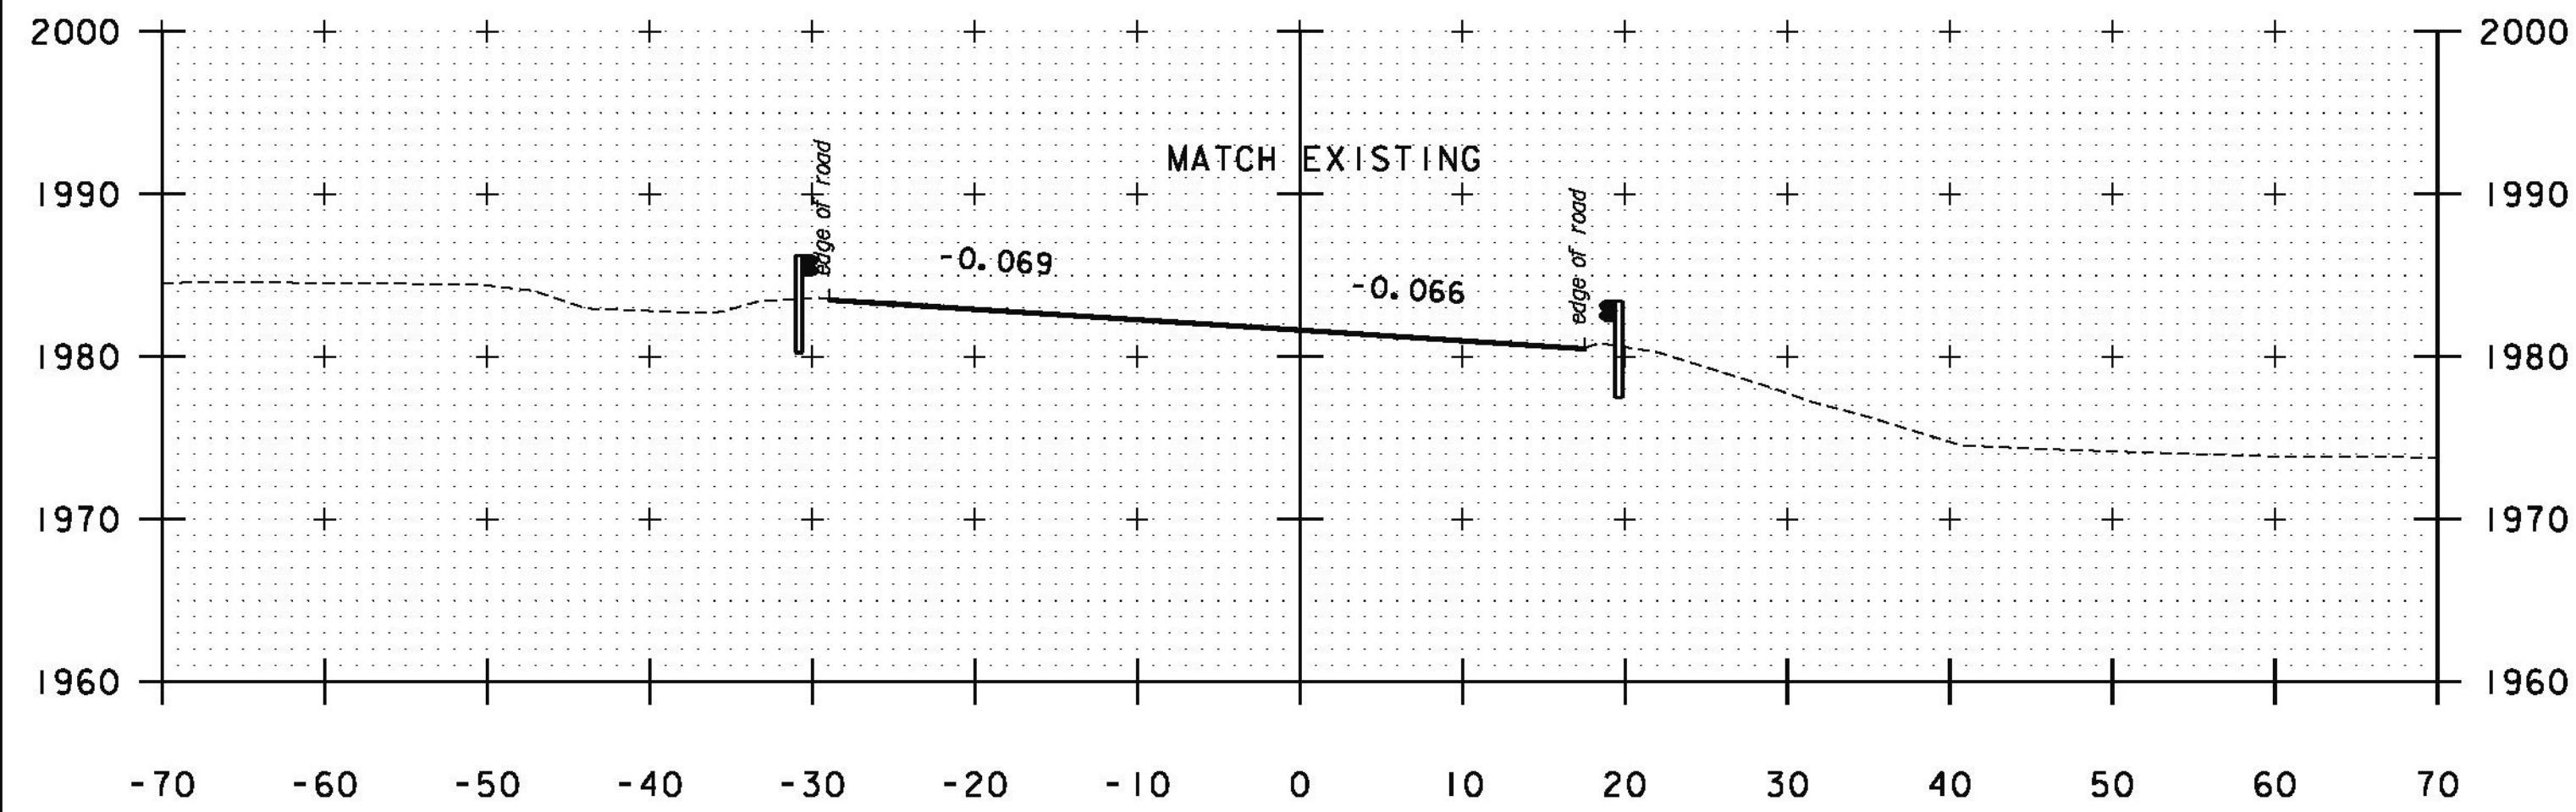


34+91.66 END APPROACH

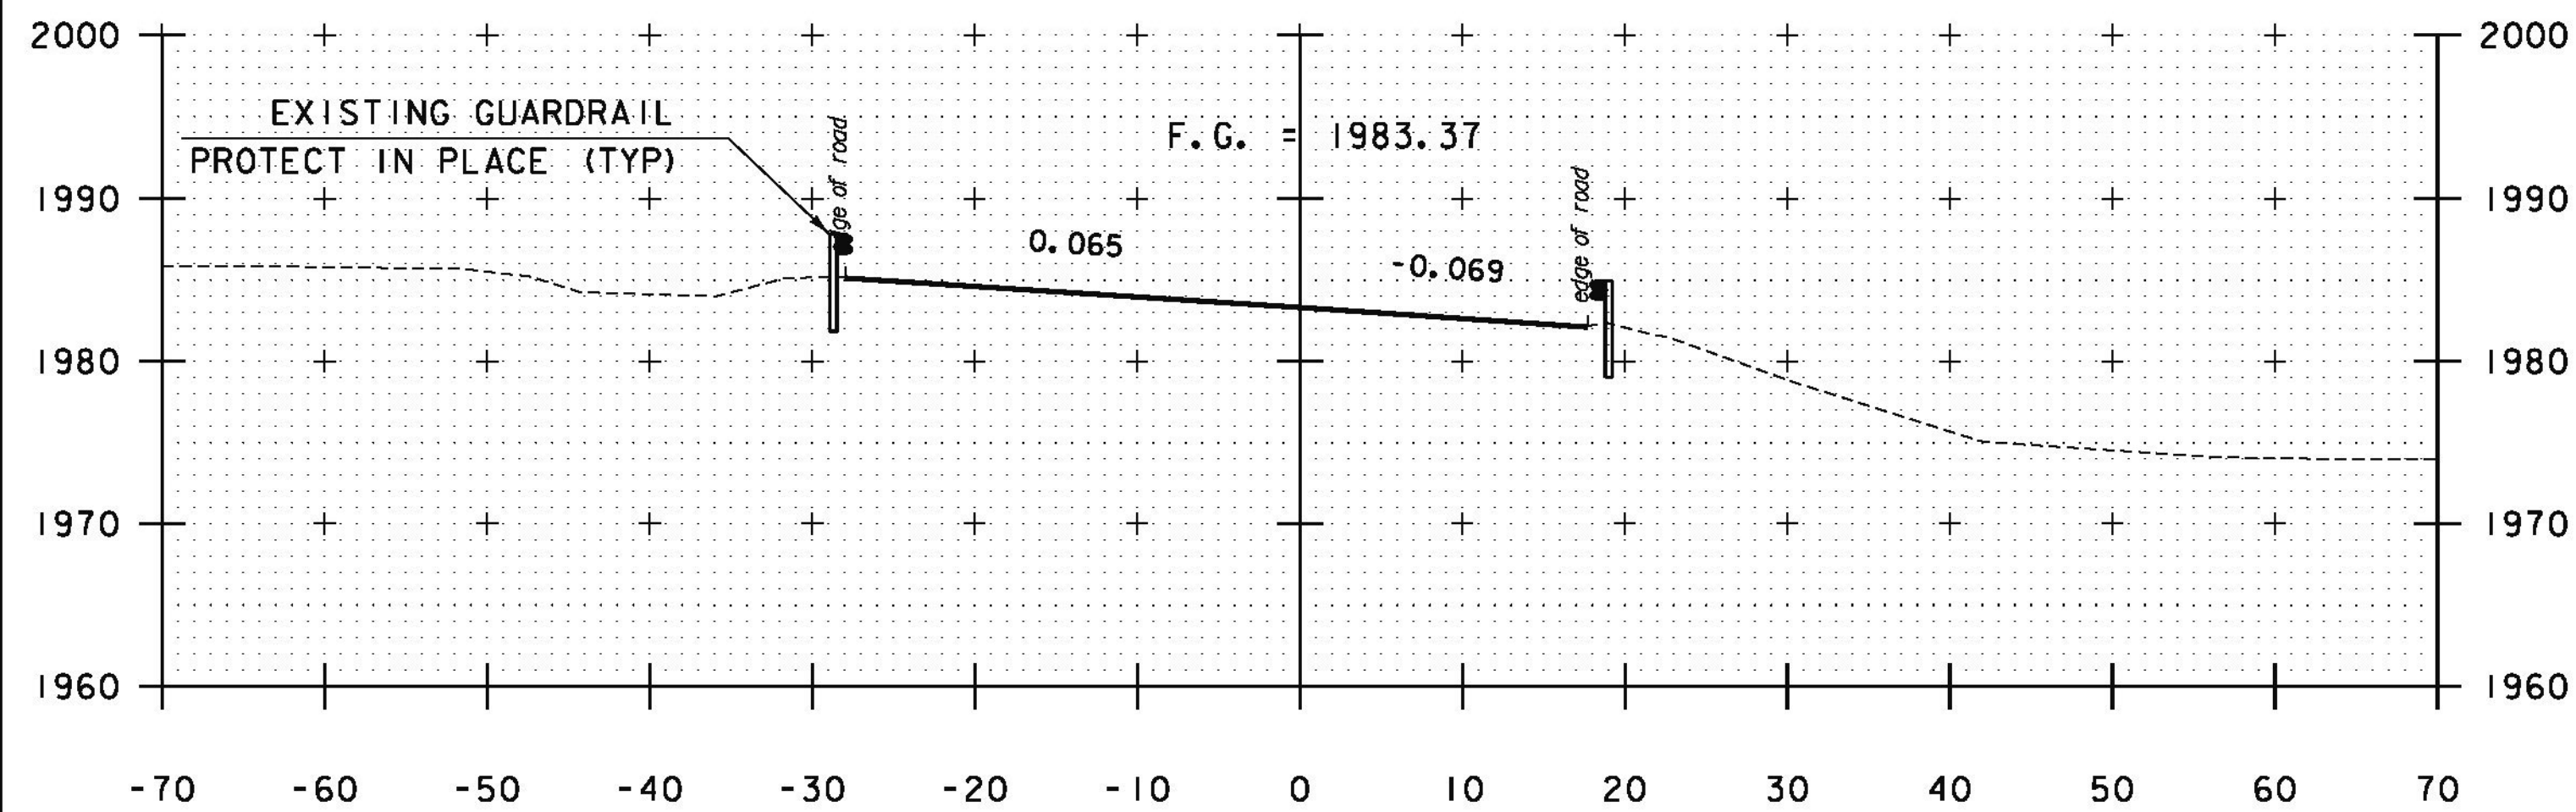

34+50

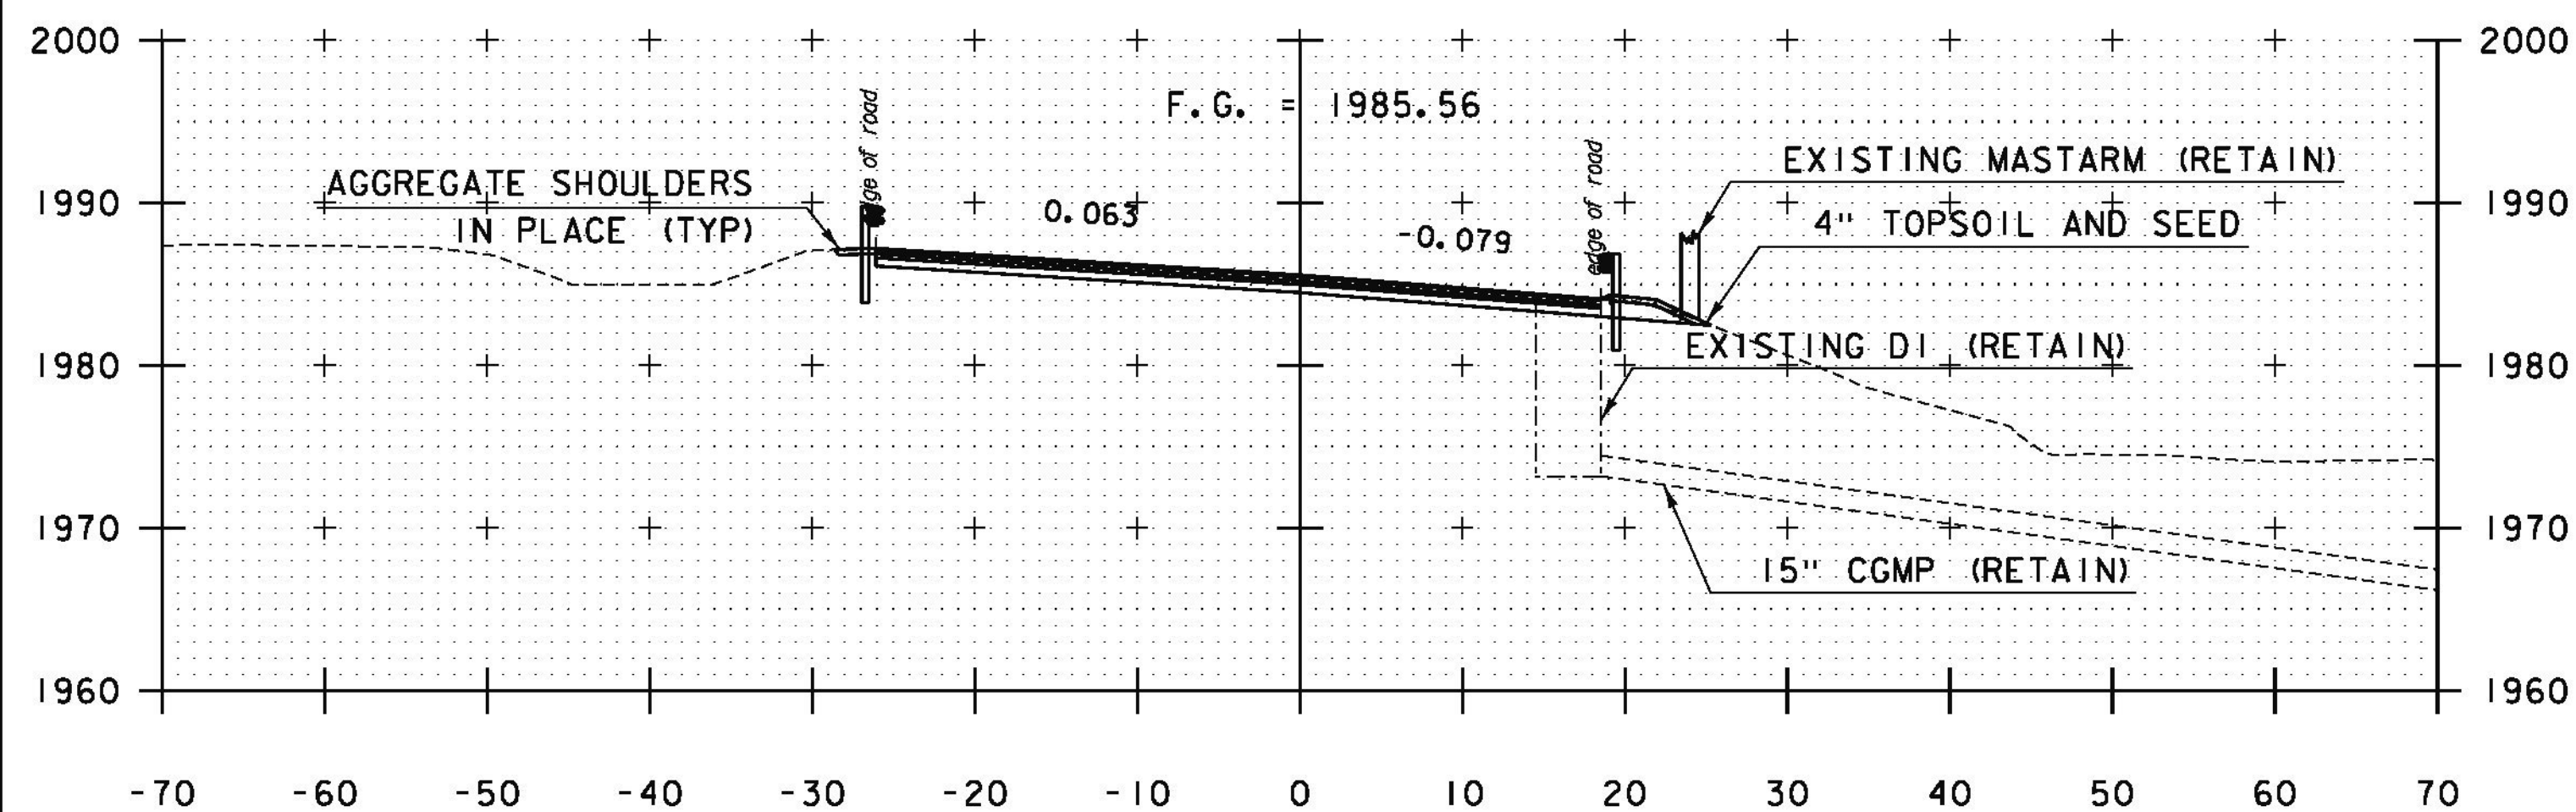

34+00

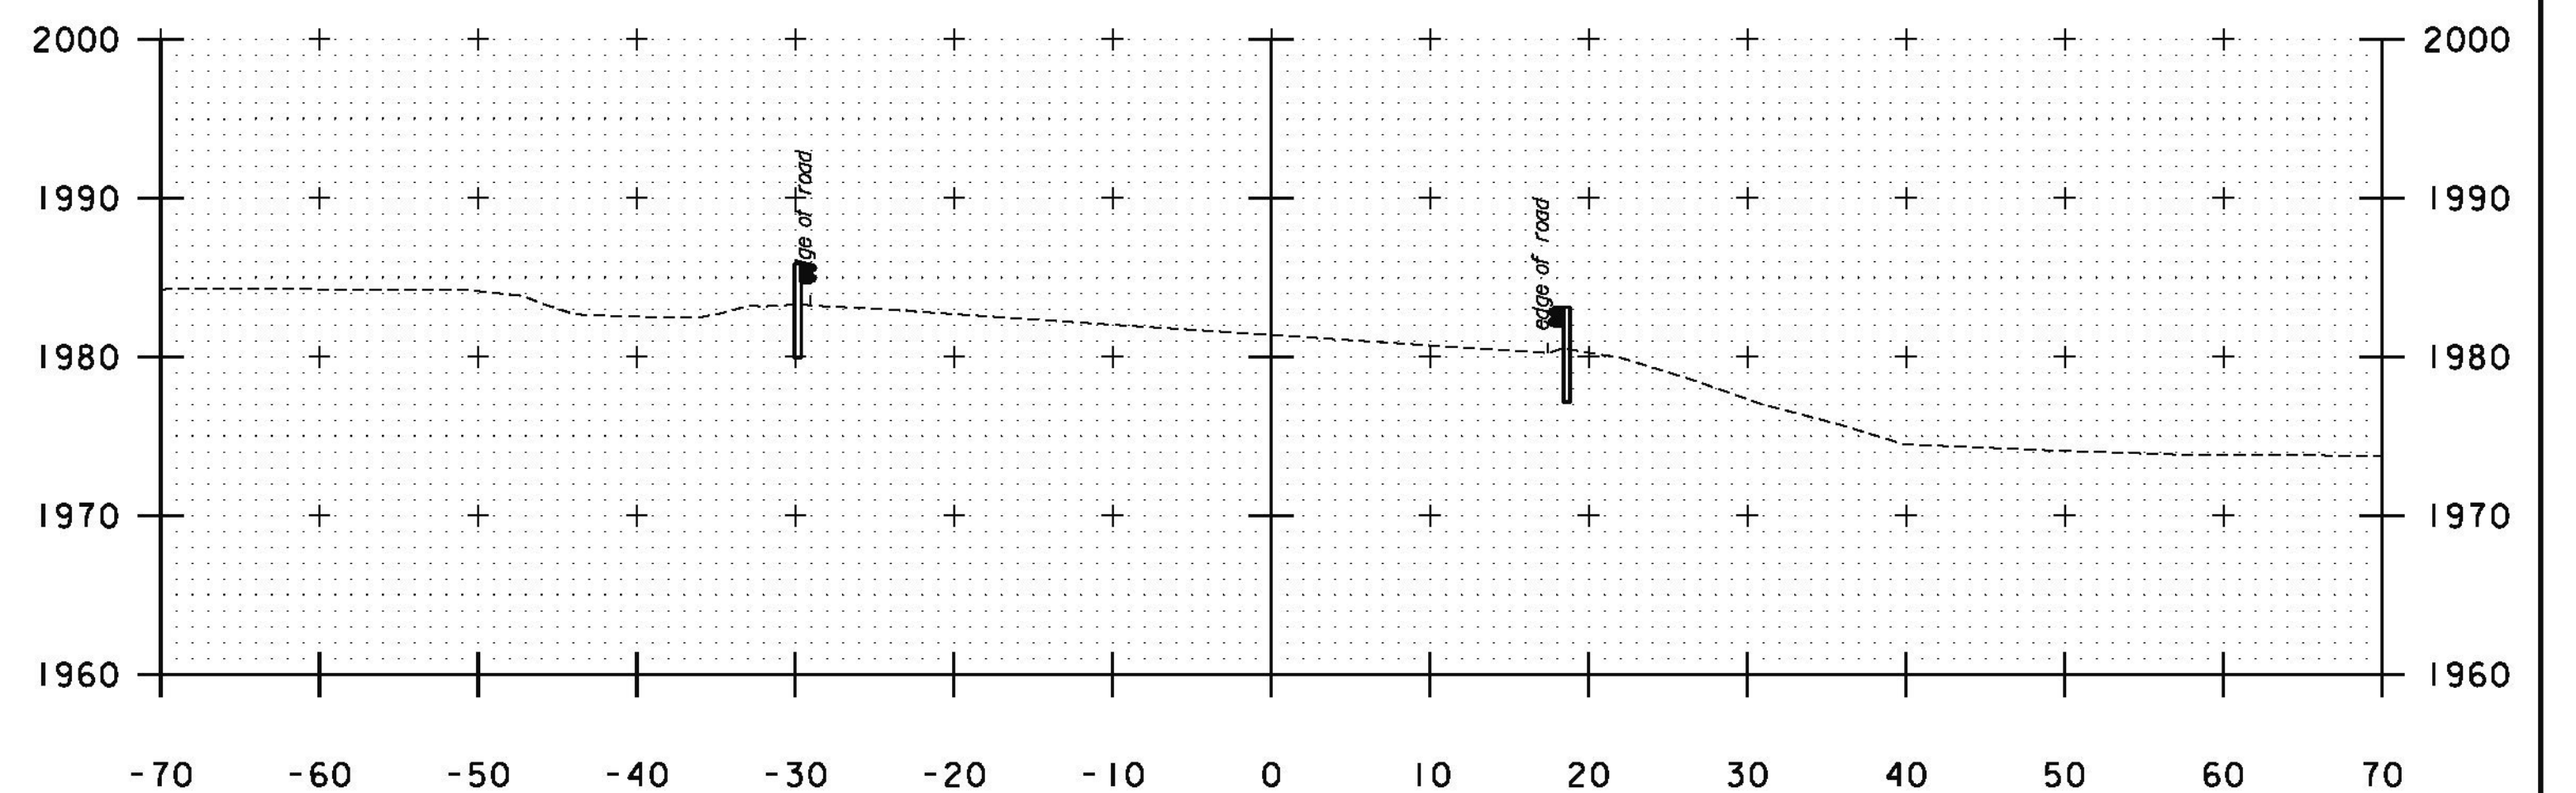

35+00

STA. 34+00 TO STA. 35+00

PROJECT NAME: PERU  
PROJECT NUMBER: STP SCRP(4)

FILE NAME: z07bi06xsl.dgn  
PROJECT LEADER: E. ATKINS  
DESIGNED BY: M. BRADLEY  
CROSS SECTION SHEET 3

PLOT DATE: 12/31/2014  
DRAWN BY: M. BRADLEY  
CHECKED BY: E. ATKINS  
SHEET 40 OF 45

**PHASE 1 NOTES:**

1. THE CONTRACTOR SHALL WORK FROM DOWNSTREAM TO UPSTREAM
2. THE CONTRACTOR SHALL COORDINATE WITH THE BROMLEY MOUNTAIN SKI RESORT TO HAVE THE SNOW MAKING POND LOWERED OR DRAINED DURING PHASE 1 WORK
3. CONTRACTOR SHALL NOT DISTURB VT ROUTE 11 DURING PHASE 1 WORK.

LOWER PARKING AREA

**GENERAL NOTES:**

1. THESE STAGING PLANS ARE FOR THE CULVERT INSTALLATION WORK ONLY AND ARE NOT INTENDED TO LIMIT THE CONTRACTOR'S APPROACH TO SCHEDULE WORK BUT TO OUTLINE ONE WAY OF PROGRESSING. THE CONTRACTOR IS EXPECTED TO USE KNOWLEDGE AND EXPERIENCE TO PERFORM THE WORK IN THE MOST EFFICIENT AND SAFE MANNER IN COMPLIANCE WITH THE LATEST EDITION OF THE "MANUAL ON UNIFORM TRAFFIC CONTROL DEVICES" (MUTCD) AND VTRANS STANDARDS.
2. THE CONTRACTOR SHALL IMPLEMENT THE NECESSARY TRAFFIC CONTROL FOR THE OTHER ROADWAY WORK PROPOSED UNDER THIS PROJECT IN ACCORDANCE WITH THE RELEVANT VTRANS STANDARDS AND THE MUTCD.
3. CONTRACTOR SHALL RELOCATE OR COVER ALL EXISTING SIGNS WHERE THEY WOULD CONFLICT WITH CONSTRUCTION SIGNAGE. THE COST SHALL BE CONSIDERED INCIDENTAL TO THE UNIT PRICE BID FOR ITEM 641.10 TRAFFIC CONTROL. THE CONTRACTOR SHALL RESTORE EXISTING SIGNS AT THE COMPLETION OF THE WORK.
4. THE CONTRACTOR SHALL BE RESPONSIBLE FOR LOCATING CONSTRUCTION SIGNAGE SO AS NOT TO INTERFERE OR OBSTRUCT THE VIEW OF EXISTING TRAFFIC CONTROL DEVICES, STOPPING SIGHT DISTANCE AND CORNER SIGHT DISTANCE. THE COST SHALL BE CONSIDERED INCIDENTAL TO UNIT PRICE BID FOR ITEM 641.10 TRAFFIC CONTROL.
5. FINAL LOCATION OF SIGNS, PCMS, AND MESSAGES USED ARE TO BE APPROVED BY THE ENGINEER. THE CONTRACTOR SHALL PROVIDE PCMS ON BOTH APPROACHES OF VT ROUTE 11 DURING CONSTRUCTION AND 2 WEEKS IN ADVANCE BEFORE THE TEMPORARY SIGNAL IS ACTIVATED. REFER TO CONSTRUCTION PHASE 2A & 2B STAGING AND TRAFFIC CONTROL SHEETS, FOR MESSAGE RECOMMENDATIONS.
6. PAYMENT FOR FURNISHING AND PLACING TEMPORARY TRAFFIC SIGNS AND REMOVING AND RELOCATING TEMPORARY TRAFFIC SIGNS SHALL BE CONSIDERED INCIDENTAL TO THE UNIT PRICE BID FOR ITEM 641.10 TRAFFIC CONTROL.
7. THE CONTRACTOR SHALL FURNISH, INSTALL AND MAINTAIN CORRUGATED REFLECTIVE METAL STRIPS (ALTERNATING ORANGE AND WHITE) ON TEMPORARY TRAFFIC BARRIER. STRIPS SHALL BE INSTALLED ON TRAFFIC SIDE FACE OF BARRIER PER MANUFACTURER'S RECOMMENDATIONS AND AS APPROVED BY THE ENGINEER. THIS WORK SHALL BE INCIDENTAL TO ITEM 621.90, TEMPORARY TRAFFIC BARRIER.
8. THE CONTRACTOR SHALL REMOVE THE EXISTING STEEL BEAM GUARDRAIL AND POSTS AS REQUIRED TO ALLOW THE INSTALLATION OF THE TEMPORARY TRAFFIC BARRIER. THE STEEL BEAM RAIL AND POSTS SHALL BE PROTECTED AND STORED ON THE PROJECT SITE IN A LOCATION AS APPROVED BY THE ENGINEER. WHEN THE TEMPORARY TRAFFIC BARRIER IS REMOVED, THE CONTRACTOR SHALL REINSTALL THE EXISTING STEEL BEAM GUARDRAIL AND POSTS. ANY POSTS AND/OR BEAM RAIL THAT ARE NOT SALVAGEABLE SHALL BE REPLACED WITH NEW. THIS WORK WILL BE INCLUDED IN THE UNIT PRICE BID FOR CONTRACT ITEM ITEM 621.75.

PHASE 2 CONSTRUCTION AREA  
SEE CONSTRUCTION PHASE 2A & 2B  
TRAFFIC CONTROL SHEETS FOR  
ADDITIONAL REQUIREMENTS

MAGNETIC




PHASE 1  
CONSTRUCTION AREA

SUGGESTED STAGING AREA

**PHASE 2 NOTES:**

1. THE CONTRACTOR SHALL WORK DOWNSTREAM TO UPSTREAM.
2. SEE TRAFFIC CONTROL SHEETS 42 & 43 FOR ADDITIONAL REQUIREMENTS DURING PHASE 2.
3. WORK REQUIRING LANE CLOSURES AND TEMPORARY SIGNS ON VT ROUTE 11 SHALL BE COMPLETED WITHIN 10 BUSINESS DAYS.

**PHASES 1&2**

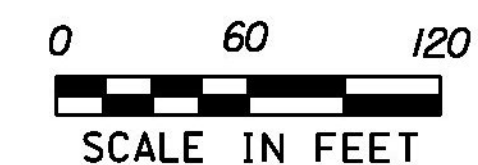


GREEN INTERNATIONAL AFFILIATES, INC.  
CIVIL AND STRUCTURAL ENGINEERS

PROJECT NAME: PERU  
PROJECT NUMBER: STP SCRP(4)

FILE NAME: z07b106phasebdr.dgn  
PROJECT LEADER: E. ATKINS  
DESIGNED BY: M. BRADLEY  
STAGING AND TRAFFIC CONTROL SHEET 1

PLOT DATE: 12/31/2014  
DRAWN BY: M. BRADLEY  
CHECKED BY: E. ATKINS  
SHEET 41 OF 45

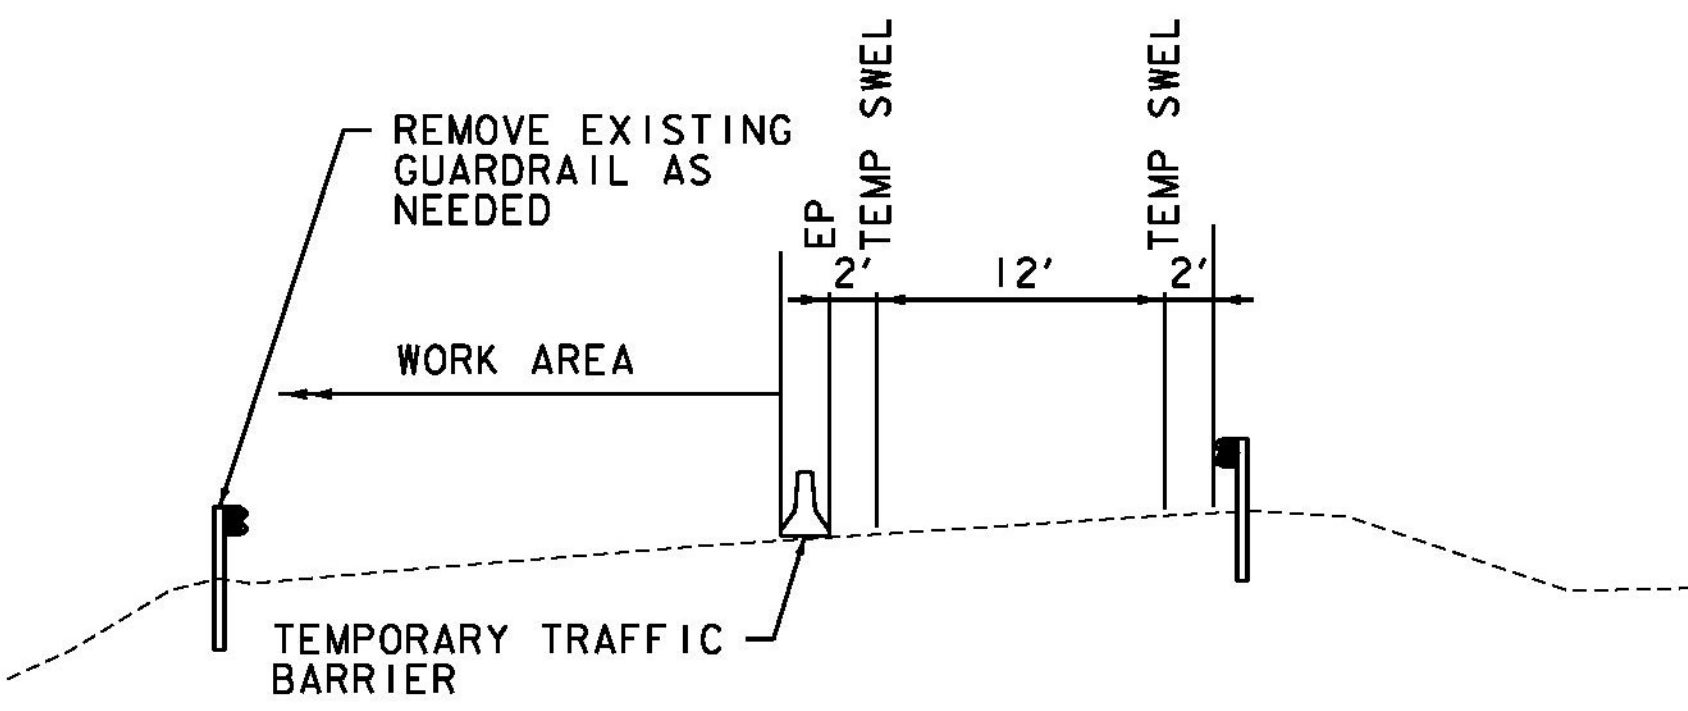

PHASE 2A TYPICAL ROADWAY SECTION  
NOT TO SCALE

**LEGEND**


- ▬ TEMPORARY TRAFFIC BARRIER
- REFLECTORIZED PLASTIC DRUM
- TRAFFIC FLOW
- SL TEMPORARY STOP LINE
- SWEL SOLID WHITE EDGE LINE
- B-B MOUNTED BACK TO BACK
- DYCL DOUBLE YELLOW CENTERLINE
- ⊕ TRAFFIC SIGN
- ⊙ VIDEO DETECTION CAMERA
- TEMPORARY SPAN WIRE POLE (WOOD UTILITY POLE)
- I PORTABLE CHANGEABLE MESSAGE SIGN (PCMS)
- OVERHEAD WIRES
- ⊕ TEMPORARY TRAFFIC SIGNAL HEAD
- ▨ WORK AREA
- ▩ VIDEO DETECTION ZONE

**TEMPORARY 4 INCH WHITE LINE, PAINT**  
31+66.7 - 35+46.7 LT, 388 LF (SWEL)  
31+91.6 - 34+87.2 LT - RT, 306 LF (SWEL)



**TEMPORARY 24 INCH STOP BAR, PAINT**  
31+66.8 RT, 20 LF (SL)  
35+46.1 LT, 17 LF (SL)

**TEMPORARY TRAFFIC SIGNAL SYSTEM NOTES**


1. THE TIMING OF THE TEMPORARY SIGNAL SHALL BE SUBJECT TO FIELD ADJUSTMENTS AS NEEDED OR AS DIRECTED BY THE ENGINEER. THE CONTRACTOR IS RESPONSIBLE FOR ANY NECESSARY ADJUSTMENTS TO TIMINGS APPROVED BY THE ENGINEER. THIS WORK SHALL BE INCIDENTAL TO ITEM 678.40, TEMPORARY TRAFFIC SIGNAL SYSTEM.
2. UNIFORMED TRAFFIC OFFICERS SHALL BE NOTIFIED IMMEDIATELY AND SHALL PERFORM TRAFFIC CONTROL IN THE EVENT THAT THE TEMPORARY TRAFFIC SIGNAL IS OUT OF ORDER.
3. TEMPORARY TRAFFIC CONTROL SIGNAL SHALL BE INCLUDED FOR PAYMENT UNDER ITEM 678.40 TEMPORARY TRAFFIC SIGNAL SYSTEM AND SHALL INCLUDE ALL TEMPORARY TRAFFIC CONTROL ITEMS INCLUDING BUT NOT LIMITED TO TEMPORARY SIGNALS, VIDEO DETECTION SYSTEM, SERVICE CONNECTION, SIGNAL HEADS, REMOVING SIGNALS AT THE COMPLETION OF WORK AND ALL OTHER INCIDENTALS NECESSARY TO FURNISH, INSTALL AND MAINTAIN THE TEMPORARY TRAFFIC SIGNAL SYSTEM.
4. DESIGN OF THE SIGNAL SUPPORTS AND ANY REQUIRED GUYING SHALL BE THE RESPONSIBILITY OF THE CONTRACTOR.
5. SIGNAL FACES SHALL BE L.E.D AND CONSIST OF 12" LENSES (RED, YELLOW AND GREEN).
6. THE BOTTOM OF THE HOUSING OF A SIGNAL FACE SUSPENDED OVER A ROADWAY SHALL NOT BE LESS THAN 16.5 FEET NOR MORE THAN 19.0 FEET ABOVE THE PAVEMENT GRADE AT THE CENTER OF THE ROADWAY. THE BOTTOM OF A SIGNAL FACE NOT MOUNTED OVER A ROADWAY SHALL NOT BE LESS THAN 8.0 FEET NOR MORE THAN 15.0 FEET ABOVE THE GROUND. CAUTION SHOULD BE USED TO ENSURE COMPLIANCE WITH THE HEIGHT REQUIREMENTS IN THE EVENT THE NEW APPROACH GRADES DIFFER SIGNIFICANTLY FROM THE OLD ROADWAY GRADE.
7. SIGNAL FACES FOR ANY ONE APPROACH SHALL NOT BE LESS THAN 8 FEET APART MEASURED HORIZONTALLY BETWEEN CENTER FACES.
8. SIGNAL HEADS MAY BE HUNG ON A SPAN WIRE OR ON A CANTILEVER MAST ARM. HOWEVER, THE USE OF PORTABLE SIGNALS IS ENCOURAGED. AT LEAST ONE SIGNAL HEAD SHALL BE UNMISTAKABLY IN LINE WITH THE CENTER OF APPROACHING TRAFFIC AT ALL TIMES. THE SECOND SIGNAL HEAD MAY BE POST MOUNTED, LOCATED AT A DISTANCE OF 14.5 FEET FROM THE CENTER OF THE APPROACH LANE WHEN THE STOP BAR IS 40 FEET FROM THE SIGNAL HEAD. CONSULT THE LATEST EDITION OF THE MUTCD FOR ADDITIONAL INFORMATION CONCERNING SIGNAL PLACEMENT.
9. SIGNAL HEAD PLACEMENT IS CRITICAL. HEADS SHALL BE ADJUSTED TO REFLECT LANE LOCATION CHANGES.
10. THE SIGNAL SYSTEM SHALL CONSIST OF POLES, SIGNS AND POSTS, WARNING SIGNS, LUMINAIRES, FLASHING BEACONS, ASSOCIATED PAVEMENT MARKINGS AND SIGNAL EQUIPMENT TO PROVIDE FOR AN ADEQUATE DESIGN. IT ALSO INCLUDES PERMITS AND COSTS ASSOCIATED WITH PROVIDING ELECTRICAL POWER.
11. INSTALL WIRING BETWEEN SIGNAL POLES TO PROVIDE FOR A SAFE INSTALLATION. ATTACHMENT TO UTILITY POLES SHALL BE COORDINATED BY THE CONTRACTOR WITH THE UTILITY COMPANY.
12. PLACE TEMPORARY POLES BEHIND GUARDRAIL OR OUTSIDE OF THE CLEAR ZONE.
13. POLES SUPPORTING SPAN WIRES AND/OR MAST ARMS SHALL BE ADEQUATELY BRACED OR GUYED AND SHALL NOT BE PLACED SO AS TO CREATE A HAZARD TO THE TRAVELING PUBLIC.
14. LUMINAIRES SHALL BE INSTALLED AT EACH OF THE APPROACHES TO ADEQUATELY LIGHT THE STOP BAR AREAS. HIGH PRESSURE SODIUM OR L.E.D. LUMINAIRES ARE ACCEPTABLE FORMS OF LAMPS. THE MOUNTING HEIGHT OF THE LUMINAIRES SHALL BE DETERMINED BY THE CONTRACTOR. ILLUMINANCE SHALL BE MEASURED AT NIGHTTIME AFTER INSTALLATION AND AT EACH STOP BAR SHALL BE NO LESS THAN 1.0 FOOT-CANDLES AND NOT TO EXCEED 2.0 FOOT-CANDLES.
15. ALL TEMPORARY SIGNAL EQUIPMENT, SIGNS, ETC., SHALL BELONG TO THE CONTRACTOR AT THE END OF THE PROJECT AND THE CONTRACTOR SHALL BE RESPONSIBLE FOR THEIR REMOVAL INCLUDING ANY TEMPORARY PAVEMENT MARKINGS, UTILITY POLES, WIRES, ETC.

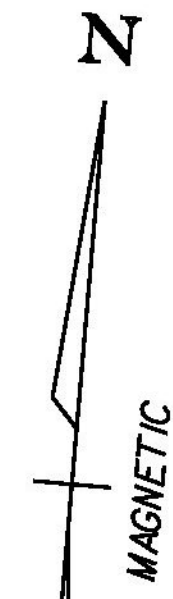

TEMPORARY AERIAL POWER AND COMMUNICATION WIRING

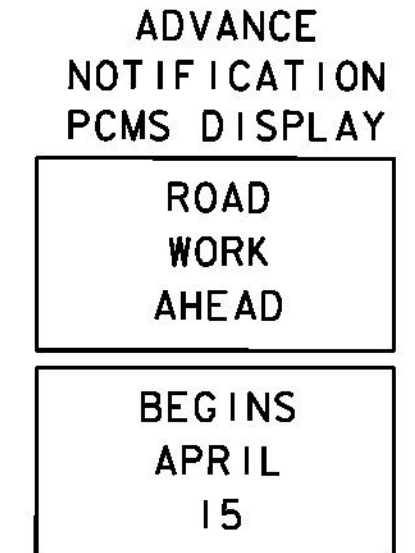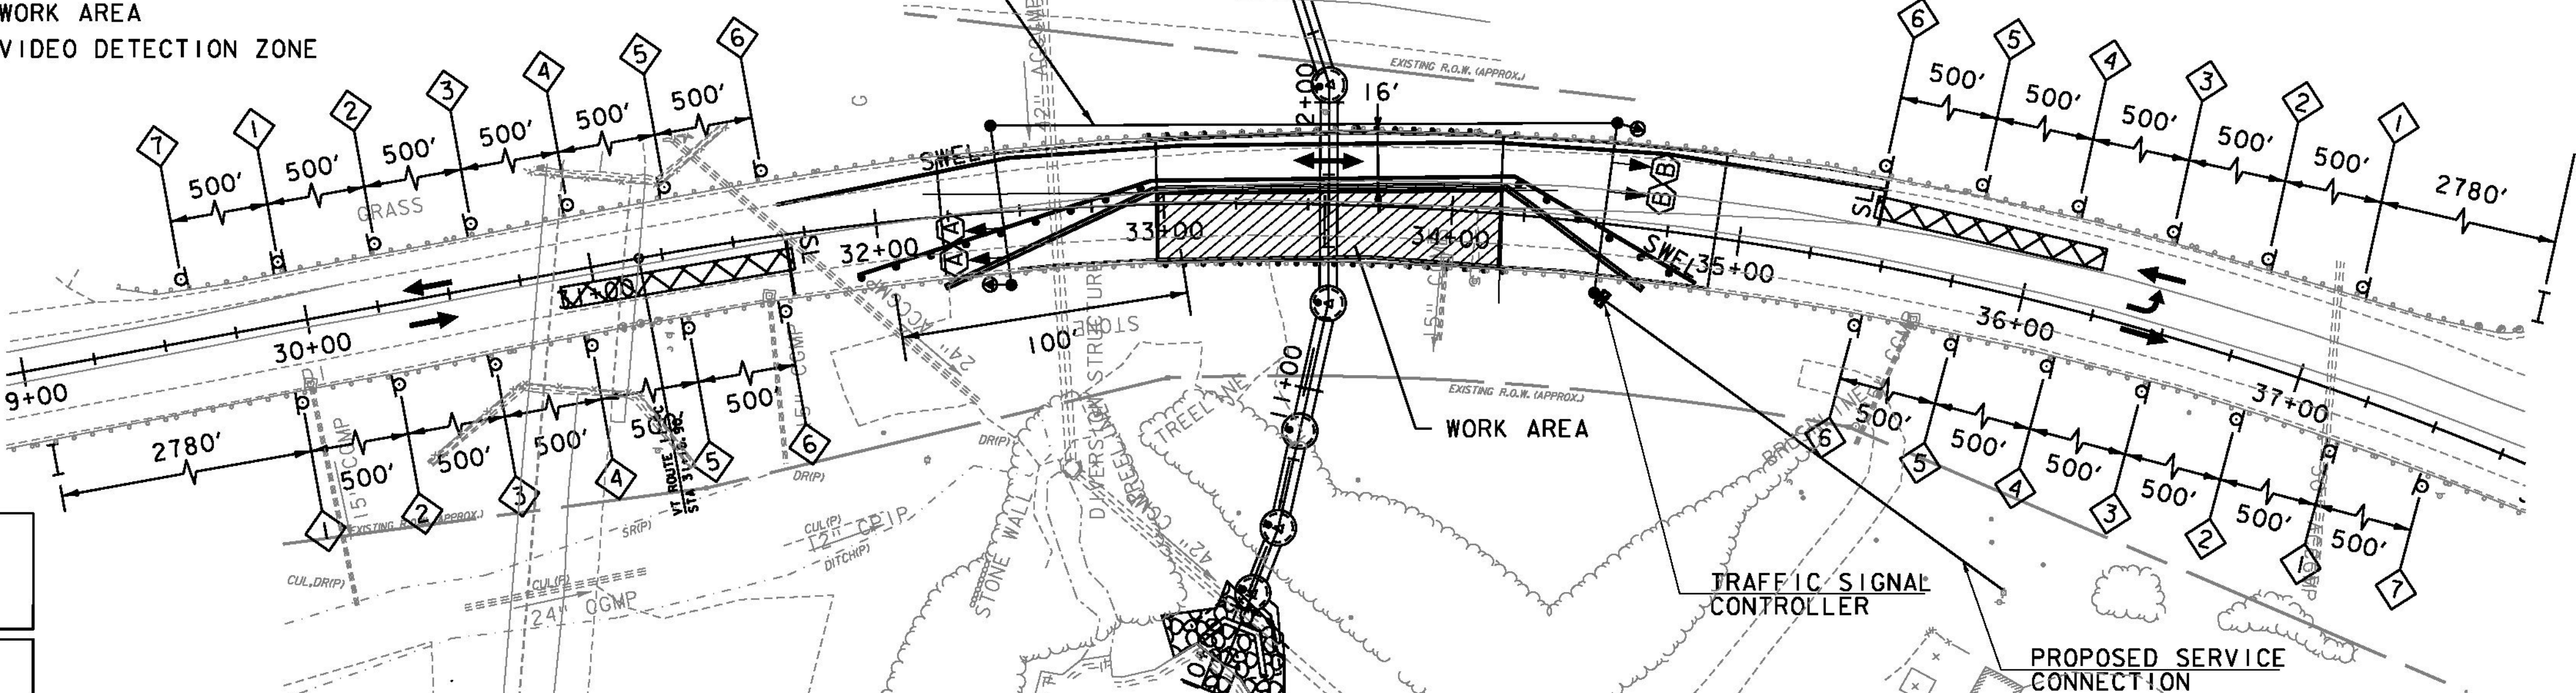

MONTH AND DATE SHOWN ON PCMS ARE FOR ILLUSTRATION ONLY


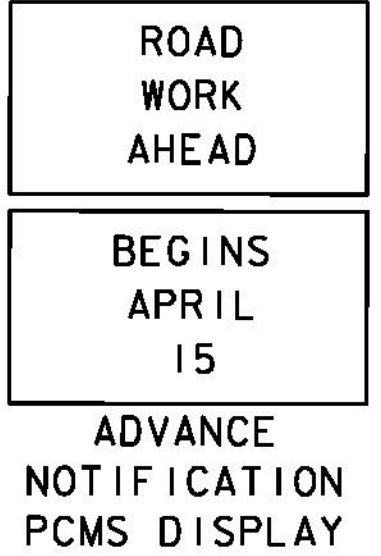


**NOTE**

SEE PHASE 2B PLAN SHEET FOR PROPOSED SIGNAL FACE ARRANGEMENT, MAJOR EQUIPMENT LIST, PROPOSED SIGNAL PHASING, TABLE OF CHANGE SEQUENCE, AND CONTROLLER TIMING CHART.

**PHASE 2A NOTES**

1. INSTALL TEMPORARY TRAFFIC CONTROL SIGNS, SIGNALS, AND BARRIERS AS SHOWN ON THIS PLAN.
2. MASK EXISTING PAVEMENT MARKINGS THAT ARE IN CONFLICT WITH THE TEMPORARY PAVEMENT MARKINGS SHOWN ON THIS PLAN. MASK SHALL BE DONE WITH TRAFFIC TAPE OR REMOVE PAVEMENT MARKINGS VIA GRINDING ONLY. PAINT OR ASPHALT CEMENT ARE NOT ALLOWED. MATCH PROPOSED PAVEMENT MARKINGS WITH EXISTING PAVEMENT MARKINGS AT LIMIT OF WORK.
3. INSTALL TEMPORARY PAVEMENT MARKINGS, AND MAINTAIN ONE LANE ALTERNATING TRAFFIC WITH A MINIMUM OF 12 FOOT WIDE TRAVEL LANE WITH 2 FOOT SHOULDER ON EACH SIDE.
4. REMOVE EXISTING GUARDRAIL AS NEEDED TO INSTALL PROPOSED DRAINAGE. PERFORM EXCAVATION, COLD PLANING, INSTALL PROPOSED DRAINAGE, PAVEMENT, TIMBER CURB AND RESET EXISTING HIGHWAY GUARDRAIL. THE DRAINAGE PIPE INSTALLED ON THIS PHASE SHALL BE SUFFICIENT TO ALLOW ONE 12 FOOT LANE WITH 2 FOOT SHOULDERS ON BOTH SIDES FOR ALTERNATING TRAFFIC AS SHOWN ON PHASE 2B.
5. REMOVE TEMPORARY BARRIERS AND TEMPORARY PAVEMENT MARKINGS AFTER COMPLETION OF PHASE 2A WORK AND RESET TO LOCATION FOR PHASE 2B. RETAIN TEMPORARY SIGNAL AND SIGNS FOR USE IN PHASE 2B.

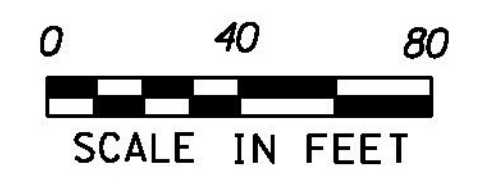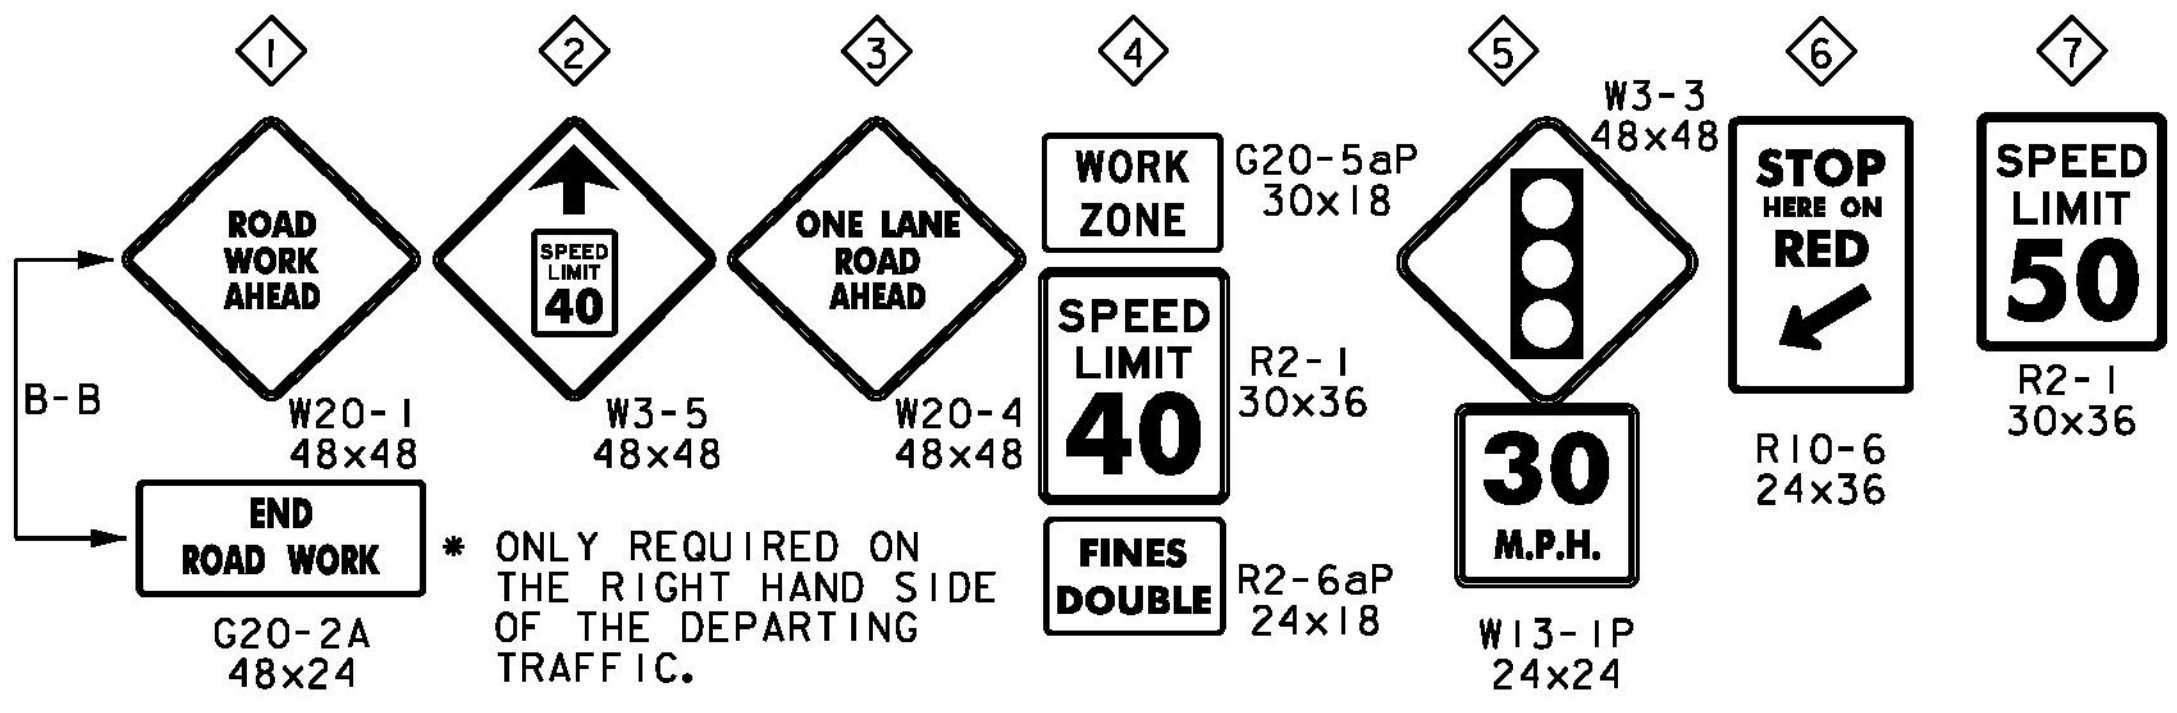

**PHASE 2A**

PROJECT NAME: PERU	PLOT DATE: 12/31/2014
PROJECT NUMBER: STP SCR(4)	DRAWN BY: D. VERTIYEV
FILE NAME: z07b1061mpbdr.dgn	CHECKED BY: E. ATKINS
DESIGNED BY: A. ACHARYA	SHEET 42 OF 45
STAGING AND TRAFFIC CONTROL SHEET 2	

MAJOR EQUIPMENT LIST

EQUIPMENT ITEM NO.	US ROUTE 11
CONTROLLER/CABINET (POLE MOUNTED)	1
TEMPORARY SPAN WIRE POLE (WOOD UTILITY POLE)	4
SIGNAL HEAD 1WAY 3-SECTION A,B	4
VIDEO DETECTION SYSTEM	1

VT ROUTE 11


TABLE OF CHANGE SEQUENCE

FACE	R/W	Ø2		Ø6		FLASHING OPERATION
		CLEAR TO ALL OTHER PHASES	R	R	R	
A	G	Y	R	R	R	FR
B	R	R	R	G	Y	FR

NOTE

SEE SHEETS 41-42 FOR NOTES AND LEGEND.

PROPOSED SIGNAL PHASING

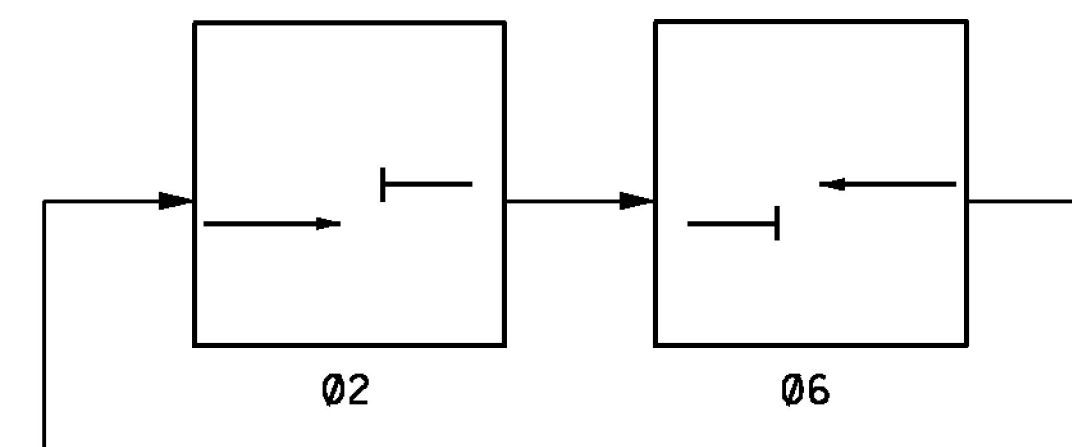


US ROUTE 11

CONTROLLER TIMING CHART

LOCAL PROGRAMMING	PHASE	
	2	6
MINIMUM GREEN	5	5
PASSAGE/VEHICLE EXT	3	3
YELLOW CLEARANCE	4.5	4.5
ALL RED CLEARANCE	13	13
MAX. I GREEN-80 SEC	25.5	25.5
RECALL	MIN	MIN


NOTE: 01, 03, 04, 05, 07, 08 ARE NOT IN USE

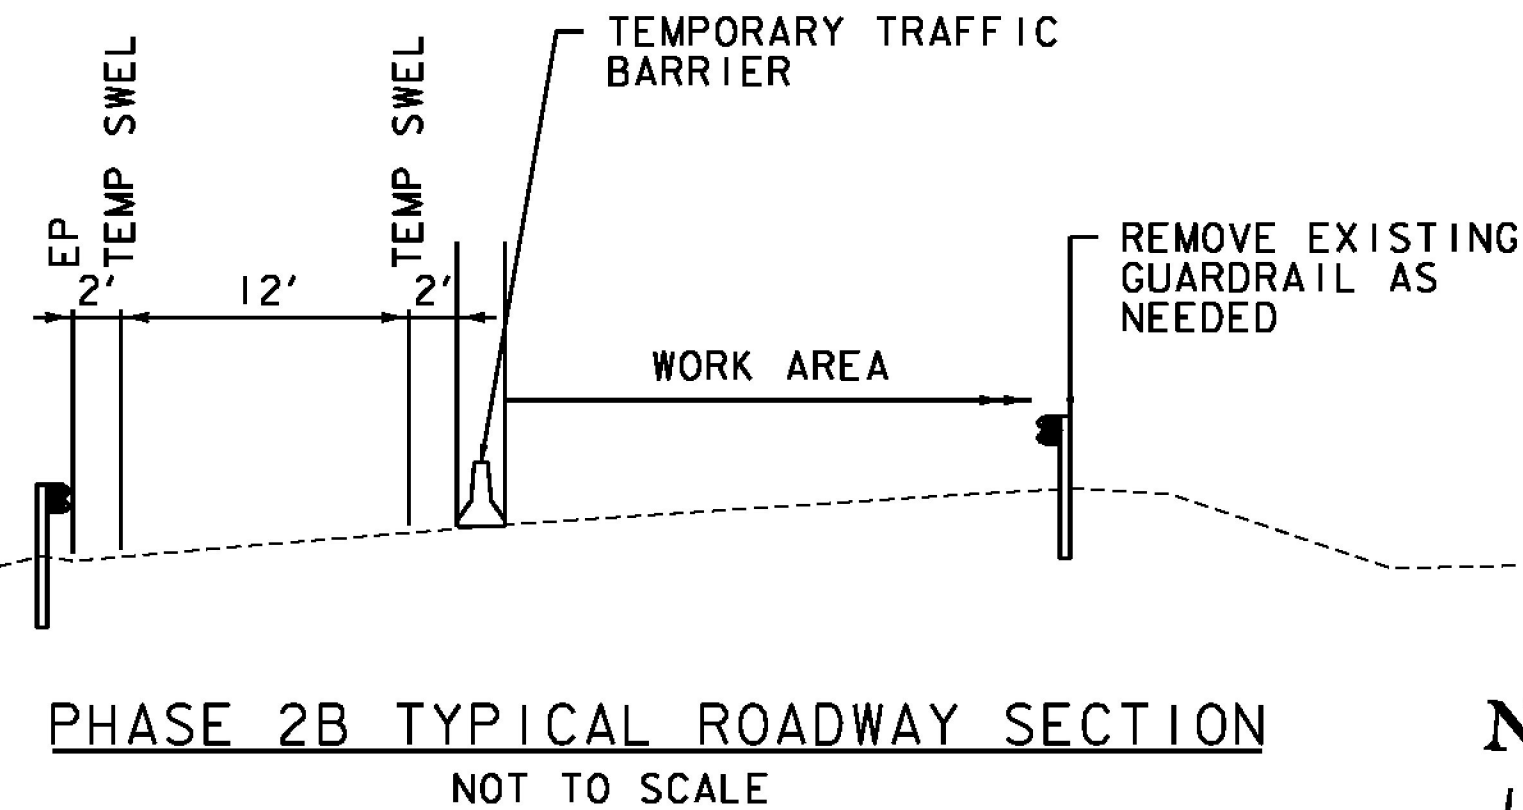

TEMPORARY 4 INCH WHITE LINE, PAINT  
31+68.4 - 35+08.5 RT, 337 LF (SWEL)  
32+22.4 - 35+25.8 RT-LT, 328 LF (SWEL)


TEMPORARY 24 INCH STOP BAR, PAINT  
31+66.8 RT, 20 LF (SL)  
35+46.1 LT, 17 LF (SL)

PROPOSED SIGNAL FACE ARRANGEMENT (LED)

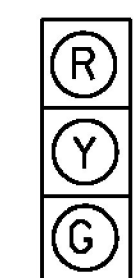

(A, B)

TEMPORARY AERIAL POWER AND COMMUNICATION WIRING

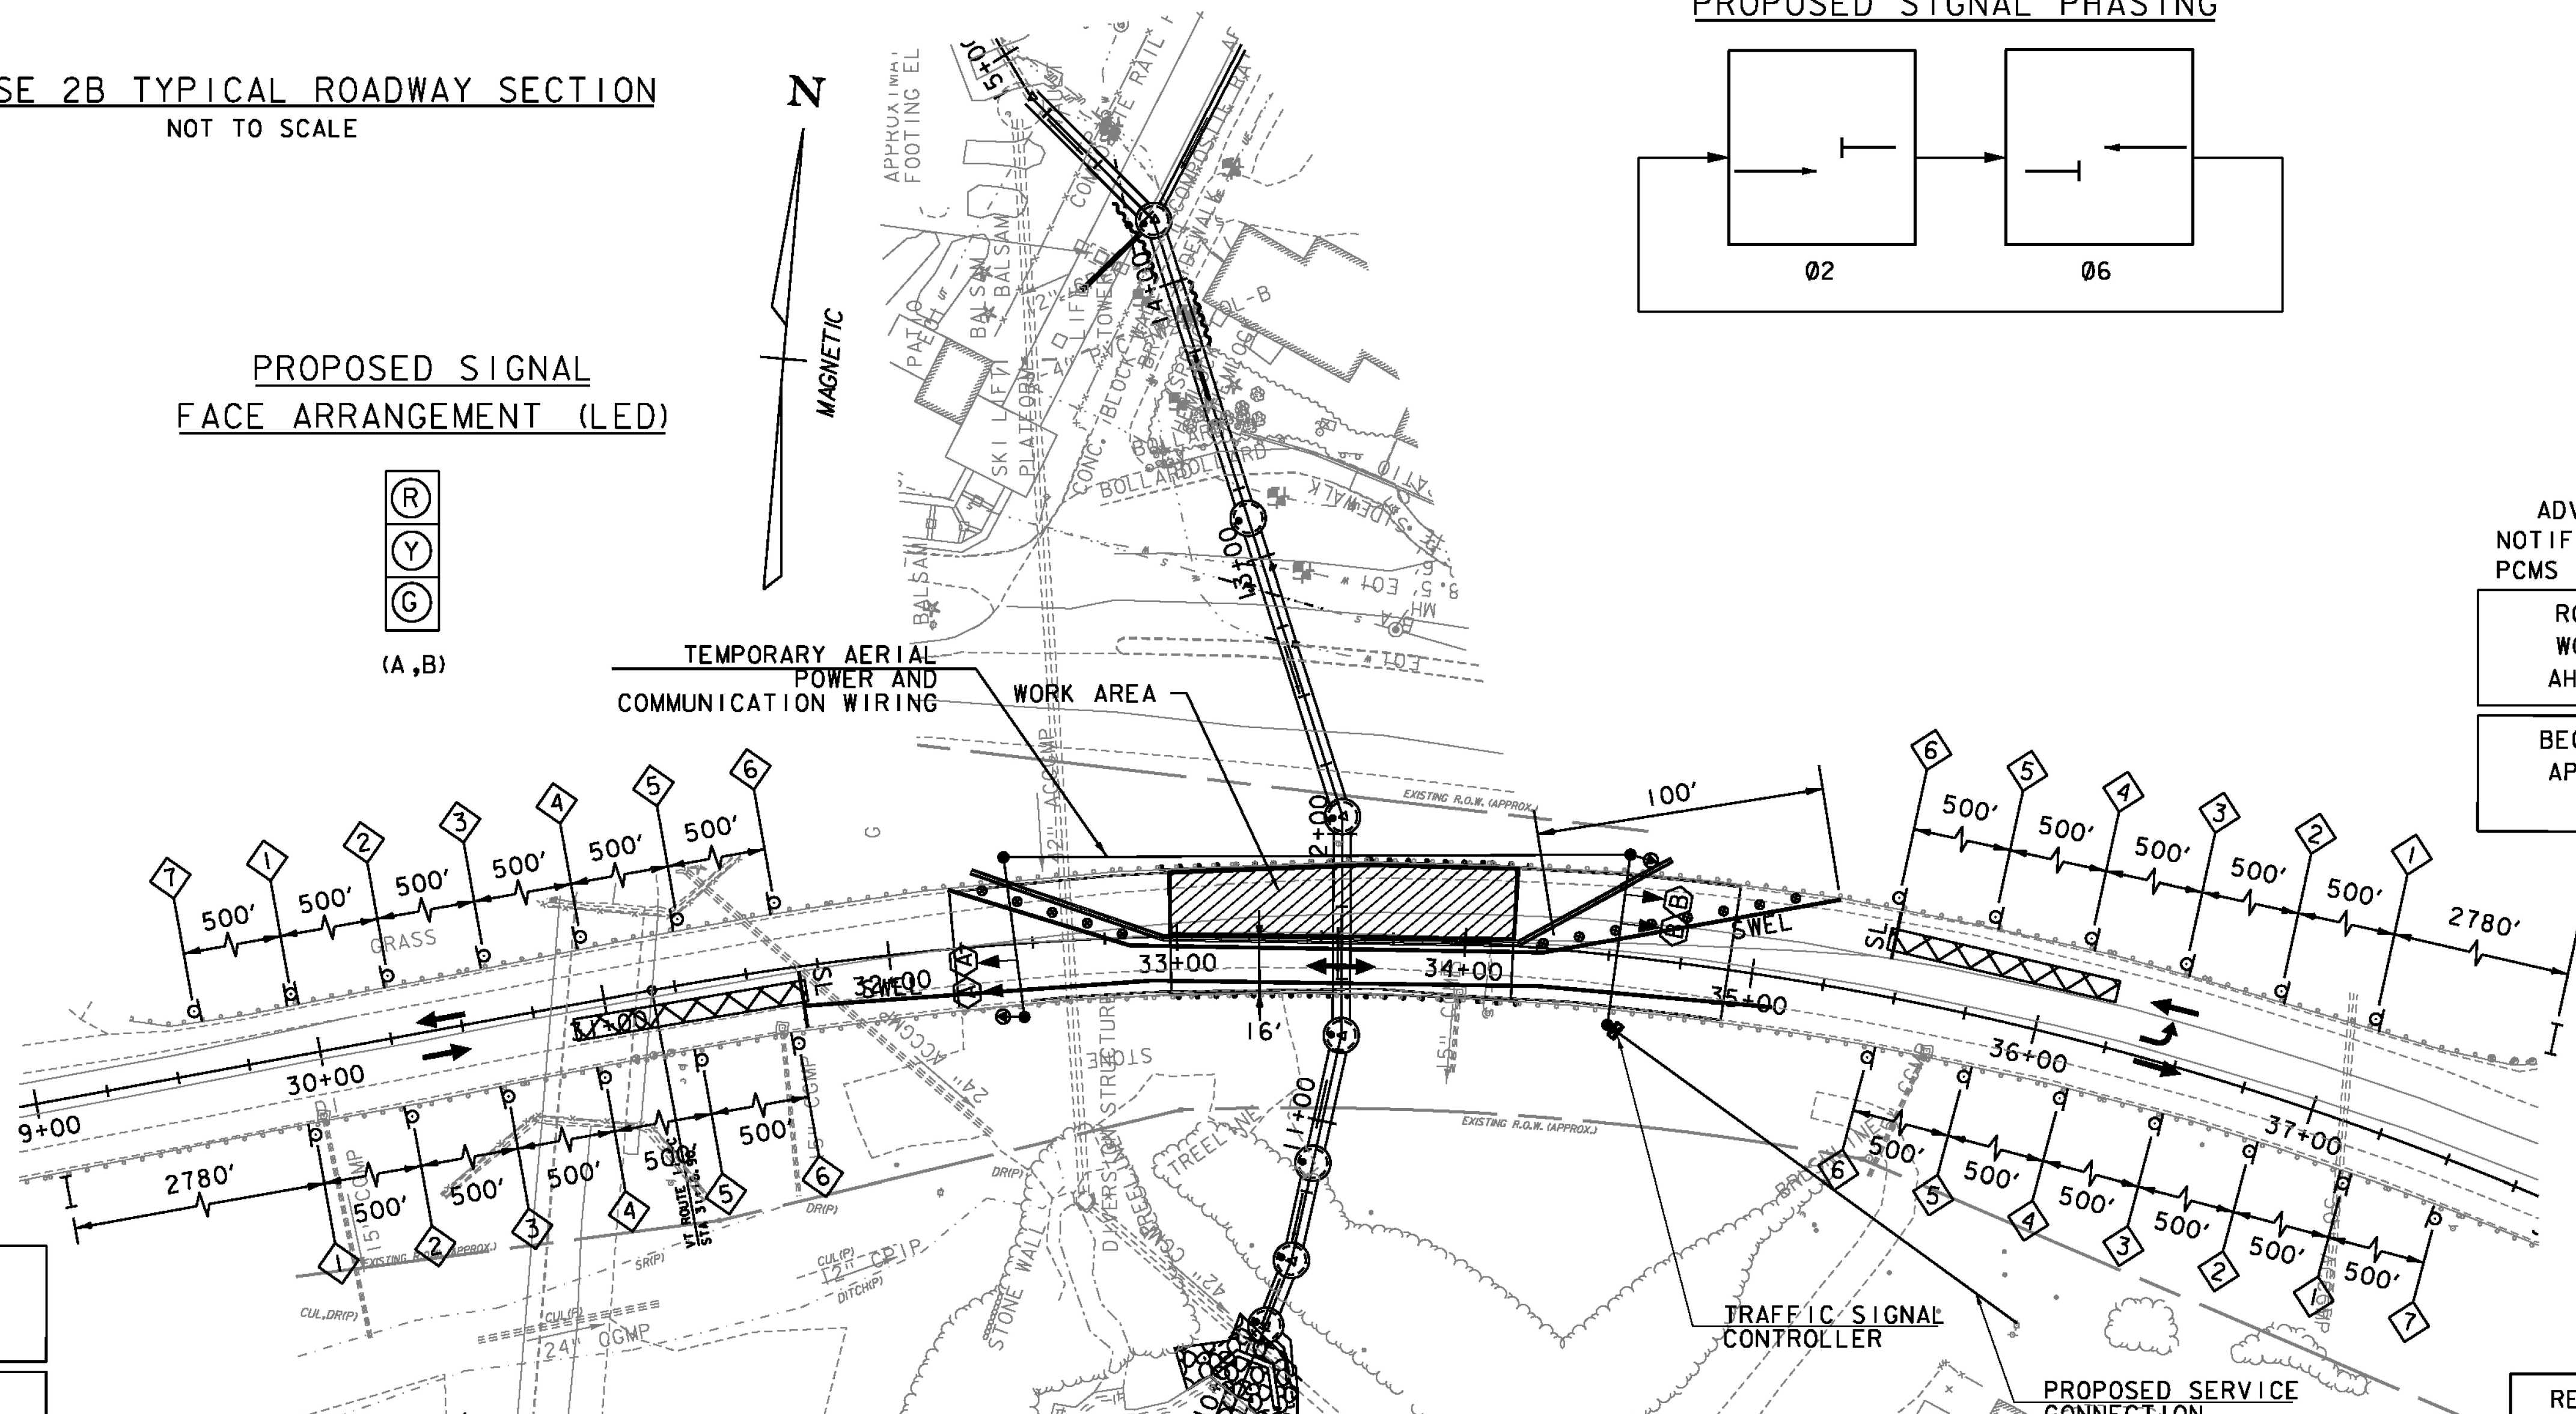

ADVANCE NOTIFICATION PCMS DISPLAY

ROAD WORK AHEAD

BEGINS APRIL 15

ROAD WORK AHEAD



BEGINS APRIL 15

ADVANCE NOTIFICATION PCMS DISPLAY

PHASE 2B NOTES

- RETAIN TEMPORARY SIGNAL AND CONSTRUCTION SIGNING UTILIZED ON PHASE 2A.
- RESET TEMPORARY CONCRETE BARRIER AS SHOWN ON THIS PLAN.
- MASK EXISTING PAVEMENT MARKINGS IN CONFLICT WITH THE TEMPORARY PAVEMENT MARKINGS SHOWN ON THIS PLAN. MASK SHALL BE DONE WITH TRAFFIC TAPE OR REMOVE PAVEMENT MARKINGS VIA GRINDING ONLY. PAINT OR ASPHALT CEMENT ARE NOT ALLOWED. MATCH PROPOSED PAVEMENT MARKINGS WITH EXISTING PAVEMENT MARKINGS AT LIMIT OF WORK.
- INSTALL TEMPORARY PAVEMENT MARKINGS, AND MAINTAIN ONE LANE ALTERNATING TRAFFIC WITH A MINIMUM OF 12 FOOT WIDE TRAVEL LANE WITH 2 FOOT SHOULDER ON EACH SIDE.
- REMOVE EXISTING HIGHWAY GUARDRAILS AS NEEDED TO INSTALL PROPOSED DRAINAGE.
- PERFORM EXCAVATION TO INSTALL PROPOSED BARRIER AND DRAINAGE.
- INSTALL PROPOSED DRAINAGE AND RESET EXISTING HIGHWAY GUARDRAIL.
- A MINIMUM OF THE BASE COURSE AND INTERMEDIATE COURSE OF PAVEMENT SHALL BE IN PLACE PRIOR TO REMOVAL OF TEMPORARY TRAFFIC CONTROL. PROVIDE A 1-INCH IN 50-FOOT APPROACH TAPER FROM INTERMEDIATE COURSE TO EXISTING PAVEMENT. THE COST FOR THIS TAPER SHALL BE INCIDENTAL TO THE CONTRACT.
- REMOVE TEMPORARY SIGNAL, PAVEMENT MASKING, SIGNAGE, AND BARRIERS.
- RESTRIPE TO ORIGINAL CONDITION AND REMOVE PAVEMENT MARKING MASK. RESTORE THE NORMAL TRAFFIC OPERATION AT THE COMPLETION OF PHASE 2B WORK.
- PAVEMENT SHALL BE RESTORED TO MATCH THE TYPICAL SECTIONS PRIOR TO PROJECT COMPLETION.

REVISION	BY	DATE
△ NOTE 8 REVISED AND NOTE 11 ADDED	MAB	2/10/2015

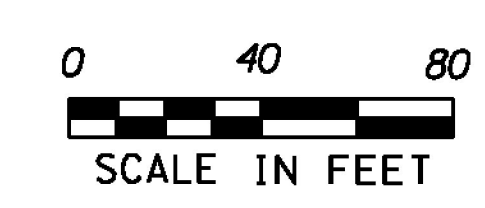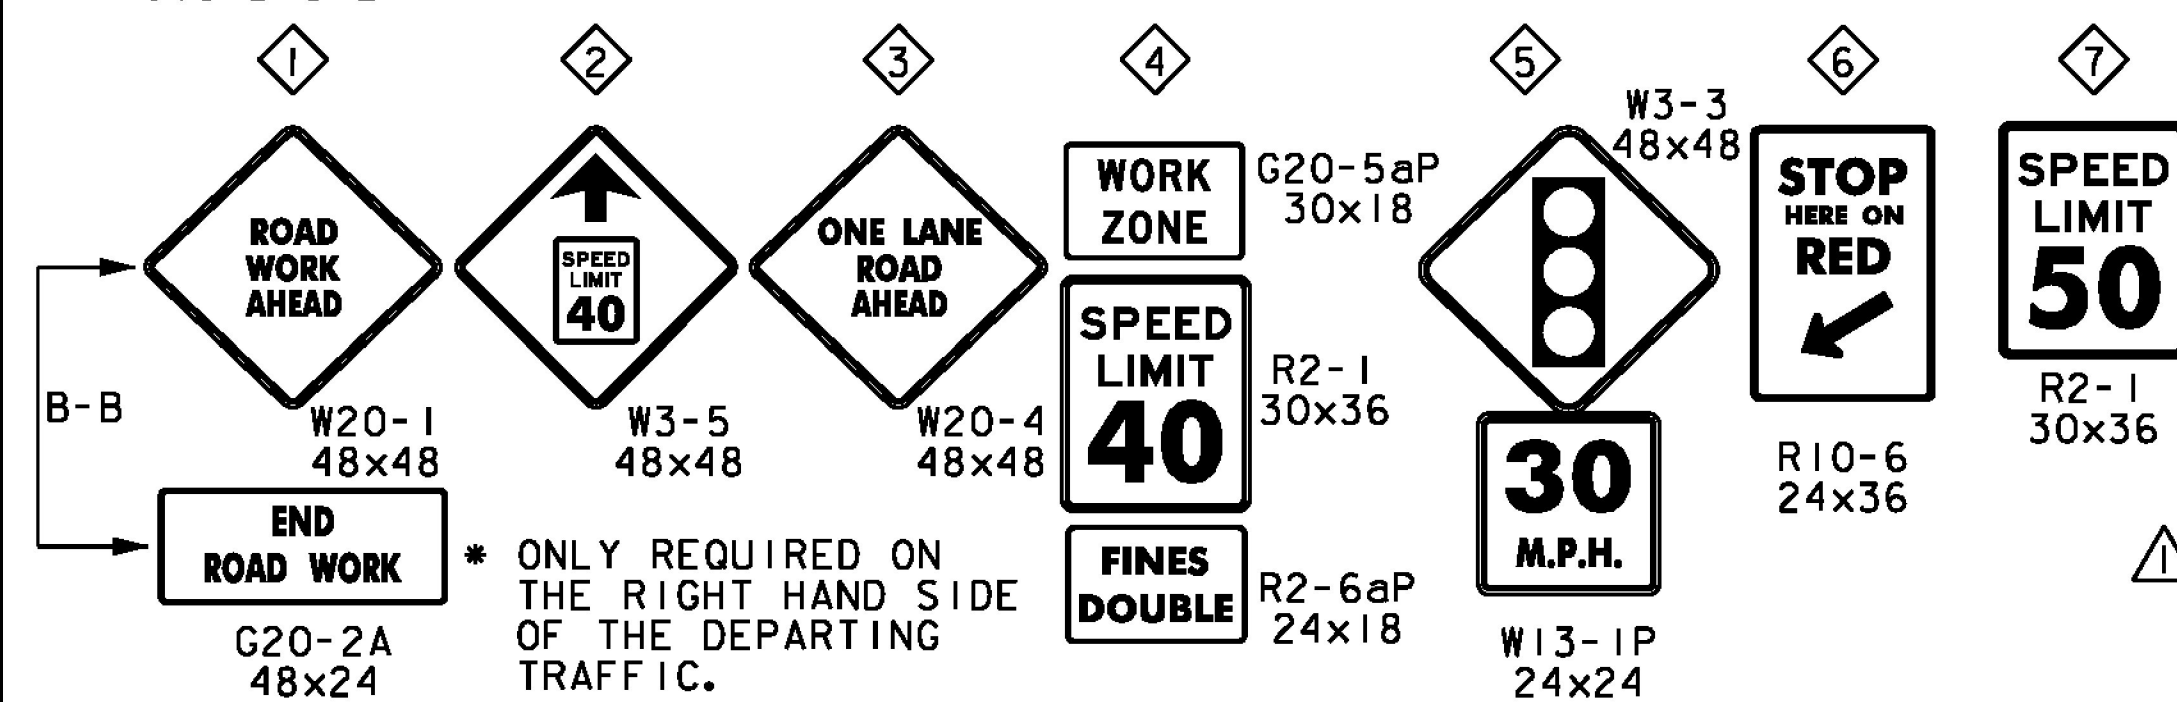

PHASE 2B

PROJECT NAME: PERU  
PROJECT NUMBER: STP SCRP(4)



FILE NAME: z07b106tmpbdr.dgn  
PROJECT LEADER: E. ATKINS  
DESIGNED BY: A. ACHARYA  
STAGING AND TRAFFIC CONTROL SHEET 3

PLOT DATE: 12/31/2014  
DRAWN BY: D. VERTIYEV  
CHECKED BY: E. ATKINS  
SHEET 43 OF 45


GREEN INTERNATIONAL AFFILIATES, INC.  
CIVIL AND STRUCTURAL ENGINEERS

- PHASE 3 NOTES:**
1. CONSTRUCTION SIGNAGE SHOULD BE IN PLACE AND APPROVED BEFORE ANY WORK ON PHASE 3 BEGINS.
  2. CONTRACTOR SHALL WORK DOWNSTREAM TO UPSTREAM.
  3. CONTRACTOR SHALL MAINTAIN ADA COMPLIANT ACCESS FOR PEDESTRIANS AT ALL TIMES
  4. NO WORK IN PHASE 4 WORK AREA SHALL BEGIN UNTIL PHASE 3 WORK IS COMPLETE.

- LEGEND:**
- PHASE 3 WORK AREA
  - PHASE 4 WORK AREA

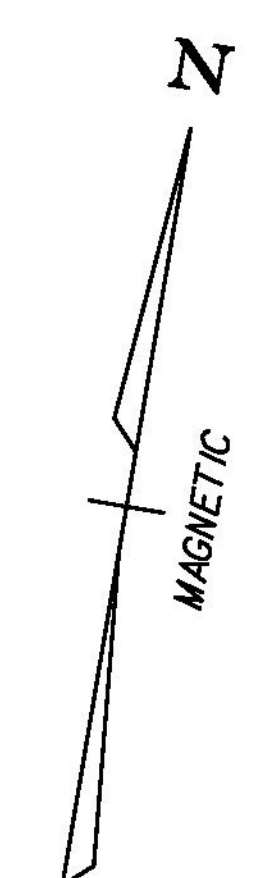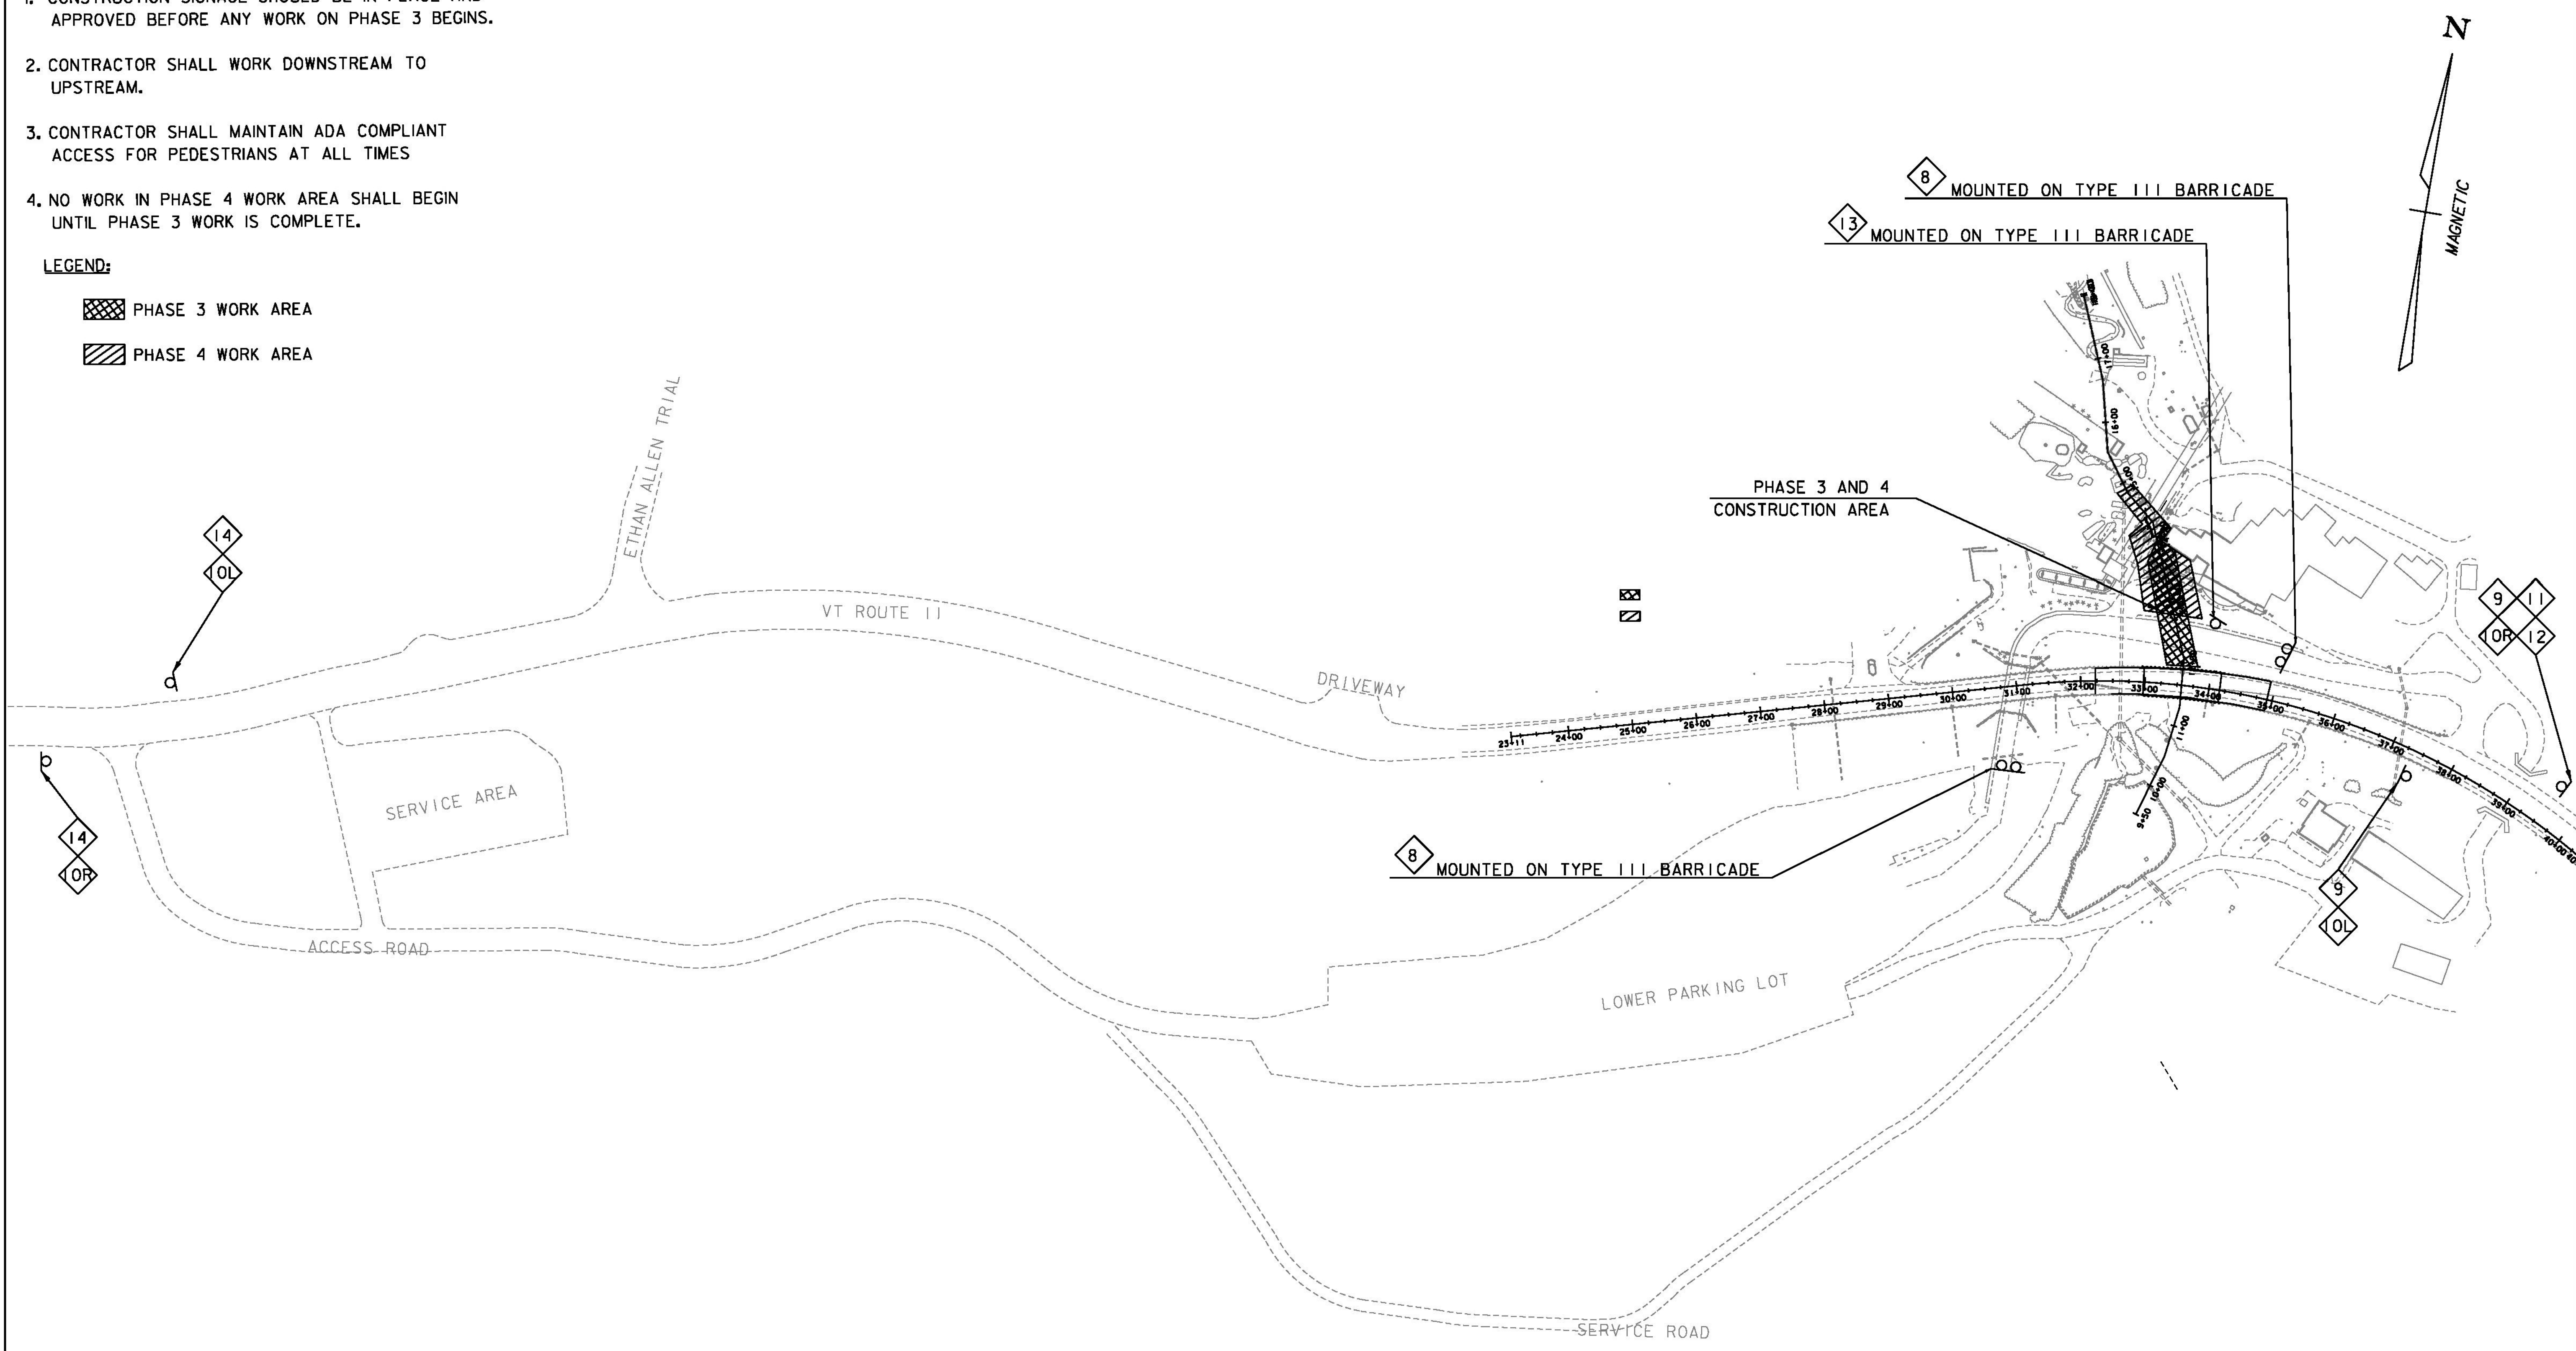

 R11-2 48 X 30	 60 X 24	 M6-1L OR M6-1R 21 X 15	 42 X 30	 M6-3 21 X 15	 M9-9 24 X 12	 30 X 24
----------------------	-------------	-------------------------------	-------------	---------------------	---------------------	-------------

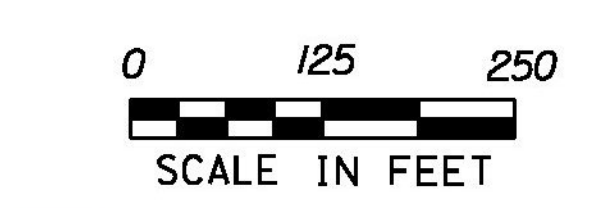



**PHASES 3&4**



PROJECT NAME: PERU	PLOT DATE: 12/31/2014
PROJECT NUMBER: STP SCR(4)	DRAWN BY: M. BRADLEY
FILE NAME: z07b106phasebdr.dgn	CHECKED BY: E. ATKINS
DESIGNED BY: M. BRADLEY	SHEET 44 OF 45
STAGING AND TRAFFIC CONTROL SHEET 4	








**PHASE 3 & 4 NOTES:**

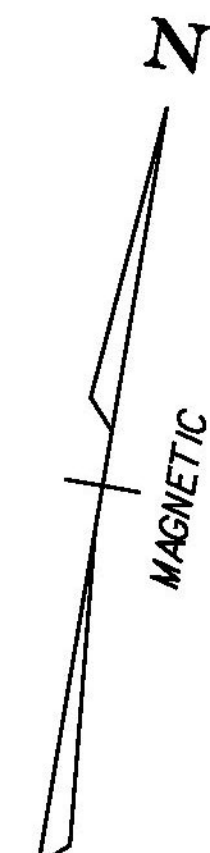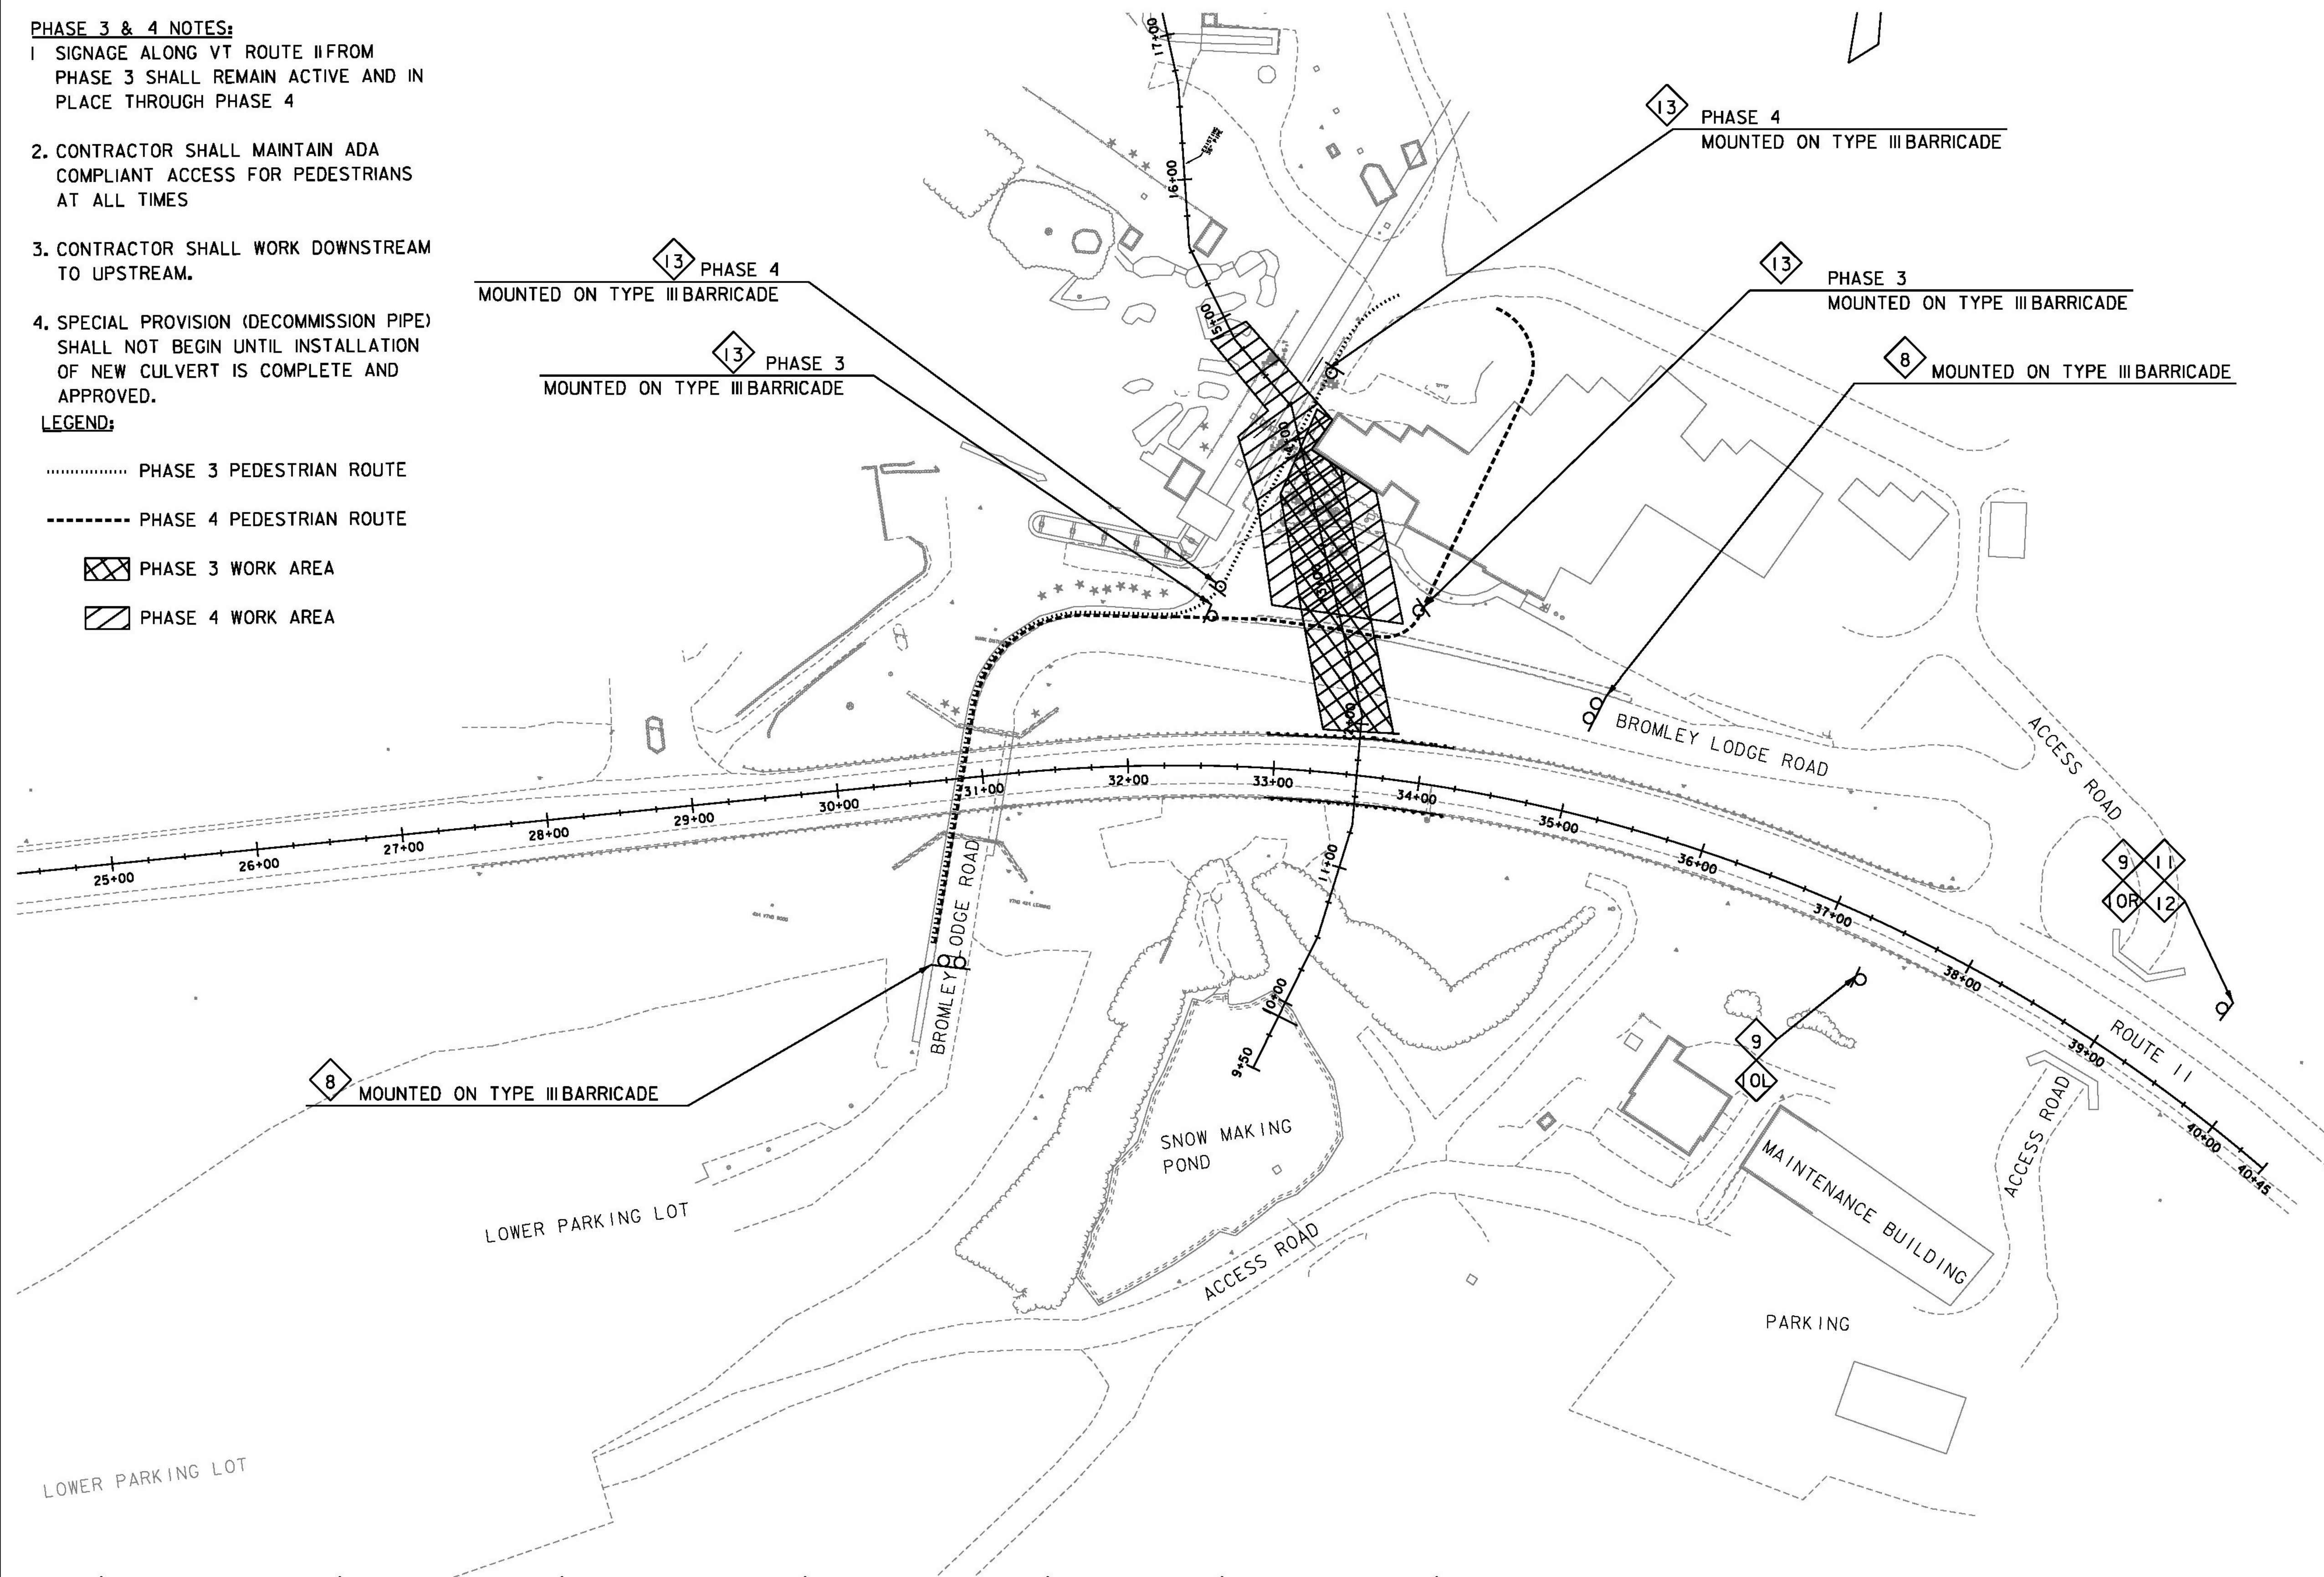1. SIGNAGE ALONG VT ROUTE 11 FROM PHASE 3 SHALL REMAIN ACTIVE AND IN PLACE THROUGH PHASE 4
2. CONTRACTOR SHALL MAINTAIN ADA COMPLIANT ACCESS FOR PEDESTRIANS AT ALL TIMES
3. CONTRACTOR SHALL WORK DOWNSTREAM TO UPSTREAM.
4. SPECIAL PROVISION (DECOMMISSION PIPE) SHALL NOT BEGIN UNTIL INSTALLATION OF NEW CULVERT IS COMPLETE AND APPROVED.

**LEGEND:**

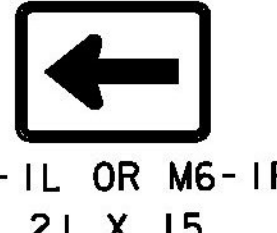- ..... PHASE 3 PEDESTRIAN ROUTE
- PHASE 4 PEDESTRIAN ROUTE
-  PHASE 3 WORK AREA
-  PHASE 4 WORK AREA



 R11-2 48 X 30	 60 X 24	 M6-1L OR M6-1R 21 X 15	 42 X 30	 M6-3 21 X 15	 M9-9 24 X 12	 30 X 24
---------------------------------------------------------------------------------------------------------	------------------------------------------------------------------------------------------------	------------------------------------------------------------------------------------------------------------------	-------------------------------------------------------------------------------------------------	----------------------------------------------------------------------------------------------------------	----------------------------------------------------------------------------------------------------------	--------------------------------------------------------------------------------------------------



**PHASES 3&4**

PROJECT NAME: PERU	PLOT DATE: 12/31/2014
PROJECT NUMBER: STP SCR(4)	DRAWN BY: M. BRADLEY
FILE NAME: z07b106phasebdr.dgn	CHECKED BY: E. ATKINS
PROJECT LEADER: E. ATKINS	SHEET 45 OF 45
DESIGNED BY: M. BRADLEY	
STAGING AND TRAFFIC CONTROL SHEET 5	

This review is for the 72x72 Waterman Model QS-5000-F-Y Sluice Gate Fabrication Drawing dated August 18, 2017 and revised November 7, 2017 and the revised calculations dated November 7, 2017

SUBMITTAL REVIEW	
	APPROVED
<b>X</b>	APPROVED AS NOTED
	REVISE AND RESUBMIT
	REJECTED

CHECKING IS ONLY FOR GENERAL CONFORMANCE WITH THE DESIGN CONCEPT OF THE PROJECT AND GENERAL COMPLIANCE WITH THE INFORMATION GIVEN IN THE CONTRACT DOCUMENTS. ANY ACTION SHOWN IS SUBJECT TO THE REQUIREMENTS OF THE PLANS AND SPECIFICATIONS. CONTRACTOR IS RESPONSIBLE FOR DIMENSIONS WHICH SHALL BE CONFIRMED AND CORRELATED AT THE JOB SITE; FABRICATION PROCESSES AND TECHNIQUES OF CONSTRUCTION; COORDINATION OF HIS WORK WITH THAT OF ALL OTHER TRADES; AND THE SATISFACTORY PERFORMANCE OF THE WORK.

**GREEN INTERNATIONAL AFFILIATES, INC.**  
CIVIL AND STRUCTURAL ENGINEERS

CHECKED BY DV/BK      DATE 11/15/17  
SIGNED BY EABK      DATE 11/15/17

See the following sheets for the comments

Approved AsNoted

BY: Ken Upmal

DATE: 11/29/2017

RESUBMIT: NO

RECEIVED: November 13, 2017

CKD BY: DV/BK (Green Int'l.)

---

STATE OF VERMONT  
AGENCY OF TRANSPORTATION

State Civil Design Approval on Form 11-20







Profis Anchor 2.7.5

www.hilti.us

Company: Waterman Industries
Specifier: Amanuel Wubneh P.E.
Address: 25500 Road 204
Phone | Fax: (800) 331-0808 | (559) 562-8629
E-Mail: amanuel.wubneh@watermanusa.com

Page: 2
Project: Renaud Bros, Inc.
Sub-Project | Pos. No.: RB-17-0351 Rev.1
Date: 11/7/2017


2 Load case/Resulting anchor forces

Load case: Design loads

Anchor reactions [lb]

Tension force: (+Tension, -Compression)

Table with 5 columns: Anchor, Tension force, Shear force, Shear force x, Shear force y. Row 1: 1, 6035, 667, 667, -8. Row 2: 2, 5956, 667, 667, -5. Row 3: 3, 5877, 667, 667, -1. Row 4: 4, 5797, 667, 667, 2. Row 5: 5, 5718, 667, 667, 5. Row 6: 6, 5667, 667, 667, 7.

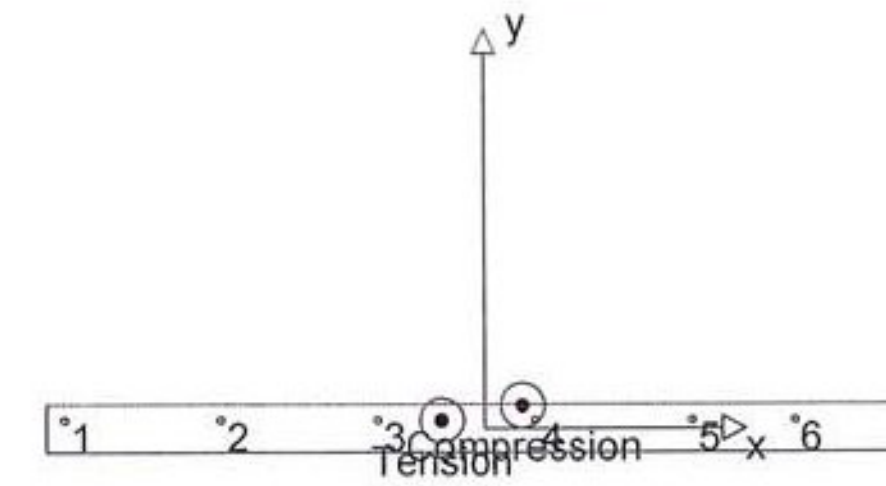

max. concrete compressive strain: 0.19 [‰]
max. concrete compressive stress: 238 [psi]
resulting tension force in (x/y)=(-5.383/1.000): 35050 [lb]
resulting compression force in (x/y)=(4.906/2.851): 18202 [lb]

3 Tension load

Table with 5 columns: Load Nsa [lb], Capacity phi Nn [lb], Utilization beta = Nsa/phi Nn, Status. Row 1: Steel Strength*, 6035, 18479, 33, OK. Row 2: Bond Strength**, 35050, 77651, 46, OK. Row 3: Sustained Tension Load Bond Strength*, N/A, N/A, N/A, N/A. Row 4: Concrete Breakout Strength**, 35050, 47970, 74, OK.

* anchor having the highest loading ** anchor group (anchors in tension)

3.1 Steel Strength

Nsa = ESR value refer to ICC-ES ESR-3814
phi Nsa >= Nua ACI 318-11 Table D.4.1.1

Variables

Table with 2 columns: A308,N [in.²], futa [psi]. Row 1: 0.33, 85000.

Calculations

Table with 1 column: Nsa [lb]. Row 1: 28430.

Results

Table with 4 columns: Nsa [lb], phi steel, phi Nsa [lb], Nua [lb]. Row 1: 28430, 0.650, 18479, 6035.

The load factors per code are not shown. However, the utilization column shows enough capacity & results in a sufficient factor of safety.

Approved AsNoted
BY: Ken Upmal
DATE: 11/29/2017
RESUBMIT: NO
RECEIVED: November 13, 2017
CD BY: DV/BK (Green Int'l)
STATE OF VERMONT
AGENCY OF TRANSPORTATION



**Profis Anchor 2.7.5**

www.hilti.us

Company: Waterman Industries  
 Specifier: Amanuel Wubneh P.E.  
 Address: 25500 Road 204  
 Phone | Fax: (800) 331-0808 | (559) 562-8629  
 E-Mail: amanuel.wubneh@watermanusa.com

Page: 3  
 Project: Renaud Bros, Inc.  
 Sub-Project | Pos. No.: RB-17-0351 Rev.1  
 Date: 11/7/2017

**3.2 Bond Strength**

$$N_{ag} = \left( \frac{A_{Na}}{A_{Na0}} \right) \Psi_{ec1,Na} \Psi_{ec2,Na} \Psi_{ed,Na} \Psi_{cp,Na} N_{ba} \quad \text{ACI 318-11 Eq. (D-19)}$$

$$\phi N_{ag} \geq N_{ua} \quad \text{ACI 318-11 Table D.4.1.1}$$

$$A_{Na} = \text{see ACI 318-11, Part D.5.5.1, Fig. RD.5.5.1(b)}$$

$$A_{Na0} = (2 C_{Na})^2 \quad \text{ACI 318-11 Eq. (D-20)}$$

$$C_{Na} = 10 d_a \sqrt{\frac{\tau_{uncr}}{1100}} \quad \text{ACI 318-11 Eq. (D-21)}$$

$$\Psi_{ec,Na} = \left( \frac{1}{1 + \frac{e_N}{C_{Na}}} \right) \leq 1.0 \quad \text{ACI 318-11 Eq. (D-23)}$$

$$\Psi_{ed,Na} = 0.7 + 0.3 \left( \frac{C_{a,min}}{C_{Na}} \right) \leq 1.0 \quad \text{ACI 318-11 Eq. (D-25)}$$

$$\Psi_{cp,Na} = \text{MAX} \left( \frac{C_{a,min}}{C_{ac}}, \frac{C_{Na}}{C_{ac}} \right) \leq 1.0 \quad \text{ACI 318-11 Eq. (D-27)}$$

$$N_{ba} = \lambda_a \cdot \tau_{kc} \cdot \pi \cdot d_a \cdot h_{ef} \quad \text{ACI 318-11 Eq. (D-22)}$$

**Variables**

$\tau_{k,c,uncr}$ [psi]	$d_a$ [in.]	$h_{ef}$ [in.]	$C_{a,min}$ [in.]	$\tau_{kc}$ [psi]
2317	0.750	14.000	4.000	1315
$e_{c1,N}$ [in.]	$e_{c2,N}$ [in.]	$C_{ac}$ [in.]	$\lambda_a$	
0.717	0.000	34.701	1.000	

**Calculations**

$C_{Na}$ [in.]	$A_{Na}$ [in. ² ]	$A_{Na0}$ [in. ² ]	$\Psi_{ed,Na}$
10.836	1701.23	469.65	0.811
$\Psi_{ec1,Na}$	$\Psi_{ec2,Na}$	$\Psi_{cp,Na}$	$N_{ba}$ [lb]
0.938	1.000	1.000	43368

**Results**

$N_{ag}$ [lb]	$\phi_{bond}$	$\phi N_{ag}$ [lb]	$N_{ua}$ [lb]
119463	0.650	77651	35050

**Approved AsNoted**

BY: Ken Upmal  
 DATE: 11/29/2017  
 RESUBMIT: NO  
 RECEIVED: November 13, 2017  
 CND BY: DV/BK (Green Int1.)

**STATE OF VERMONT  
 AGENCY OF TRANSPORTATION**



Profis Anchor 2.7.5

www.hilti.us

Company: Waterman Industries  
 Specifier: Amanuel Wubneh P.E.  
 Address: 25500 Road 204  
 Phone | Fax: (800) 331-0808 | (559) 562-8629  
 E-Mail: amanuel.wubneh@watermanusa.com

Page: 4  
 Project: Renaud Bros, Inc.  
 Sub-Project | Pos. No.: RB-17-0351 Rev.1  
 Date: 11/7/2017

3.3 Concrete Breakout Strength

$$N_{cbg} = \left( \frac{A_{Nc}}{A_{Nco}} \right) \psi_{ec,N} \psi_{ed,N} \psi_{c,N} \psi_{cp,N} N_b \quad \text{ACI 318-11 Eq. (D-4)}$$

$$\phi N_{cbg} \geq N_{ua} \quad \text{ACI 318-11 Table D.4.1.1}$$

$A_{Nc}$  see ACI 318-11, Part D.5.2.1, Fig. RD.5.2.1(b)

$$A_{Nco} = 9 h_{ef}^2 \quad \text{ACI 318-11 Eq. (D-5)}$$

$$\psi_{ec,N} = \left( \frac{1}{1 + \frac{2 e_N}{3 h_{ef}}} \right) \leq 1.0 \quad \text{ACI 318-11 Eq. (D-8)}$$

$$\psi_{ed,N} = 0.7 + 0.3 \left( \frac{C_{a,min}}{1.5 h_{ef}} \right) \leq 1.0 \quad \text{ACI 318-11 Eq. (D-10)}$$

$$\psi_{cp,N} = \text{MAX} \left( \frac{C_{a,min}}{C_{ac}}, \frac{1.5 h_{ef}}{C_{ac}} \right) \leq 1.0 \quad \text{ACI 318-11 Eq. (D-12)}$$

$$N_b = k_c \lambda_a \sqrt{f'_c} h_{ef}^{1.5} \quad \text{ACI 318-11 Eq. (D-6)}$$

Variables

$h_{ef}$ [in.]	$e_{c1,N}$ [in.]	$e_{c2,N}$ [in.]	$C_{a,min}$ [in.]	$\psi_{c,N}$
14.000	0.717	0.000	4.000	1.000

$C_{ac}$ [in.]	$k_c$	$\lambda_a$	$f'_c$ [psi]
34.701	17	1.000	3500

Calculations

$A_{Nc}$ [in. ² ]	$A_{Nco}$ [in. ² ]	$\psi_{ec1,N}$	$\psi_{ec2,N}$	$\psi_{ed,N}$	$\psi_{cp,N}$	$N_b$ [lb]
3375.00	1764.00	0.967	1.000	0.757	1.000	52684

Results

$N_{cbg}$ [lb]	$\phi_{concrete}$	$\phi N_{cbg}$ [lb]	$N_{ua}$ [lb]
73800	0.650	47970	35050

**Approved AsNoted**

BY: Ken Upmal  
 DATE: 11/29/2017  
 RESUBMIT: NO  
 RECEIVED: November 13, 2017  
 CKD BY: DV/BK (Green Intl)

**STATE OF VERMONT**  
 AGENCY OF TRANSPORTATION



**Profis Anchor 2.7.5**

www.hilti.us

Company:	Waterman Industries	Page:	5
Specifier:	Amanuel Wubneh P.E.	Project:	Renaud Bros, Inc.
Address:	25500 Road 204	Sub-Project   Pos. No.:	RB-17-0351 Rev.1
Phone   Fax:	(800) 331-0808   (559) 562-8629	Date:	11/7/2017
E-Mail:	amanuel.wubneh@watermanusa.com		

**4 Shear load**

	Load $V_{ua}$ [lb]	Capacity $\phi V_n$ [lb]	Utilization $\beta_v = V_{ua}/\phi V_n$	Status
Steel Strength*	667	8189	9	OK
Steel failure (with lever arm)*	667	1199	56	OK
Pryout Strength (Concrete Breakout Strength controls)*	667	14906	5	OK
Concrete edge failure in direction y-**	4000	17511	23	OK

* anchor having the highest loading **anchor group (relevant anchors)

**4.1 Steel Strength**

$V_{sa}$  = ESR value refer to ICC-ES ESR-3814  
 $\phi V_{steel} \geq V_{ua}$  ACI 318-11 Table D.4.1.1

**Variables**

$A_{se,V}$ [in. ² ]	$f_{ua}$ [psi]
0.33	85000

**Calculations**

$V_{sa}$ [lb]
17060

**Results**

$V_{sa}$ [lb]	$\phi_{steel}$	$\phi_{eb}$	$\phi V_{sa}$ [lb]	$V_{ua}$ [lb]
17060	0.600	0.800	8189	667

**4.2 Steel failure (with lever arm)**

$$V_s^M = \frac{\alpha_M \cdot M_s}{L_b}$$
 bending equation for stand-off  

$$M_s = M_s^0 \left(1 - \frac{N_{ua}}{\phi N_{sa}}\right)$$
 resultant flexural resistance of anchor  

$$M_s^0 = (1.2) (S) (f_{u,min})$$
 characteristic flexural resistance of anchor  

$$\left(1 - \frac{N_{ua}}{\phi N_{sa}}\right)$$
 reduction for tensile force acting simultaneously with a shear force on the anchor  

$$S = \frac{\pi(d)^3}{32}$$
 elastic section modulus of anchor bolt at concrete surface  

$$L_b = z + (n)(d_o)$$
 internal lever arm adjusted for spalling of the surface concrete  

$$\phi V_s^M \geq V_{ua}$$
 ACI 318-11 Table D.4.1.1

**Variables**

$\alpha_M$	$f_{u,min}$ [psi]	$N_{ua}$ [lb]	$\phi N_{sa}$ [lb]	$z$ [in.]	$n$	$d_o$ [in.]
2.00	85000	6035	18479	1.500	0.500	0.750

**Calculations**

$M_s^0$ [in.lb]	$\left(1 - \frac{N_{ua}}{\phi N_{sa}}\right)$	$M_s$ [in.lb]	$L_b$ [in.]
2783.038	0.673	1874.140	1.875

**Results**

$V_s^M$ [lb]	$\phi_{steel}$	$\phi V_s^M$ [lb]	$V_{ua}$ [lb]
1999	0.600	1199	667

Approved AsNoted

BY: Ken Upmal

DATE: 11/29/2017

RESUBMIT: NO

RECEIVED: November 13, 2017

CKD BY: DV/BK (Green Int.)

STATE OF VERMONT  
AGENCY OF TRANSPORTATION



Profis Anchor 2.7.5

www.hilti.us

Company: Waterman Industries  
 Specifier: Amanuel Wubneh P.E.  
 Address: 25500 Road 204  
 Phone | Fax: (800) 331-0808 | (559) 562-8629  
 E-Mail: amanuel.wubneh@watermanusa.com

Page: 6  
 Project: Renaud Bros, Inc.  
 Sub-Project | Pos. No.: RB-17-0351 Rev.1  
 Date: 11/7/2017

4.3 Pryout Strength (Concrete Breakout Strength controls)

$V_{cp} = k_{cp} \left[ \left( \frac{A_{Nc}}{A_{Nc0}} \right) \psi_{ed,N} \psi_{c,N} \psi_{cp,N} N_b \right]$  ACI 318-11 Eq. (D-40)  
 $\phi V_{cp} \geq V_{ua}$  ACI 318-11 Table D.4.1.1  
 $A_{Nc}$  see ACI 318-11, Part D.5.2.1, Fig. RD.5.2.1(b)  
 $A_{Nc0} = 9 h_{ef}^2$  ACI 318-11 Eq. (D-5)  
 $\psi_{ec,N} = \left( \frac{1}{1 + \frac{2 e_N}{3 h_{ef}}} \right) \leq 1.0$  ACI 318-11 Eq. (D-8)  
 $\psi_{ed,N} = 0.7 + 0.3 \left( \frac{C_{a,min}}{1.5 h_{ef}} \right) \leq 1.0$  ACI 318-11 Eq. (D-10)  
 $\psi_{cp,N} = \text{MAX} \left( \frac{C_{a,min}}{C_{ac}}, \frac{1.5 h_{ef}}{C_{ac}} \right) \leq 1.0$  ACI 318-11 Eq. (D-12)  
 $N_b = k_c \lambda_a \sqrt{f_c} h_{ef}^{1.5}$  ACI 318-11 Eq. (D-6)

Variables

$k_{cp}$	$h_{ef}$ [in.]	$e_{c1,N}$ [in.]	$e_{c2,N}$ [in.]	$C_{a,min}$ [in.]
2	14.000	0.000	0.000	4.000
$\psi_{c,N}$	$C_{ac}$ [in.]	$k_c$	$\lambda_a$	$f_c$ [psi]
1.000	34.701	17	1.000	3500

Calculations

$A_{Nc}$ [in. ² ]	$A_{Nc0}$ [in. ² ]	$\psi_{ec1,N}$	$\psi_{ec2,N}$	$\psi_{ed,N}$	$\psi_{cp,N}$	$N_b$ [lb]
470.83	1764.00	1.000	1.000	0.757	1.000	52684

Results

$V_{cp}$ [lb]	$\phi_{concrete}$	$\phi V_{cp}$ [lb]	$V_{ua}$ [lb]
21294	0.700	14906	667

**Approved AsNoted**

BY: Ken Upmal  
 DATE: 11/29/2017  
 RESUBMIT: NO  
 RECEIVED: November 13, 2017  
 CKD BY: DV/BK (Green Int'l)

**STATE OF VERMONT  
AGENCY OF TRANSPORTATION**



**Profis Anchor 2.7.5**

www.hilti.us

Company: Waterman Industries  
 Specifier: Amanuel Wubneh P.E.  
 Address: 25500 Road 204  
 Phone | Fax: (800) 331-0808 | (559) 562-8629  
 E-Mail: amanuel.wubneh@watermanusa.com

Page: 7  
 Project: Renaud Bros, Inc.  
 Sub-Project | Pos. No.: RB-17-0351 Rev.1  
 Date: 11/7/2017

**4.4 Concrete edge failure in direction y-**

$$V_{cbg} = \left( \frac{A_{Vc}}{A_{Vc0}} \right) \Psi_{ec,V} \Psi_{ed,V} \Psi_{c,V} \Psi_{h,V} \Psi_{parallel,V} V_b \quad \text{ACI 318-11 Eq. (D-31)}$$

$$\phi V_{cbg} \geq V_{ua} \quad \text{ACI 318-11 Table D.4.1.1}$$

$$A_{Vc} \text{ see ACI 318-11, Part D.6.2.1, Fig. RD.6.2.1(b)}$$

$$A_{Vc0} = 4.5 c_{a1}^2 \quad \text{ACI 318-11 Eq. (D-32)}$$

$$\Psi_{ec,V} = \left( \frac{1}{1 + \frac{2e_v}{3c_{a1}}} \right) \leq 1.0 \quad \text{ACI 318-11 Eq. (D-36)}$$

$$\Psi_{ed,V} = 0.7 + 0.3 \left( \frac{c_{a2}}{1.5c_{a1}} \right) \leq 1.0 \quad \text{ACI 318-11 Eq. (D-38)}$$

$$\Psi_{h,V} = \sqrt{\frac{1.5c_{a1}}{h_a}} \geq 1.0 \quad \text{ACI 318-11 Eq. (D-39)}$$

$$V_b = 9 \lambda_a \sqrt{f_c} c_{a1}^{1.5} \quad \text{ACI 318-11 Eq. (D-34)}$$

**Approved AsNoted**

BY: Ken Upmal

DATE: 11/29/2017

RESUBMIT: NO

RECEIVED: November 13, 2017

CID BY: DV/BK (Green Intl.)

**STATE OF VERMONT  
AGENCY OF TRANSPORTATION**

**Variables**

$c_{a1}$ [in.]	$c_{a2}$ [in.]	$e_{cV}$ [in.]	$\Psi_{c,V}$	$h_a$ [in.]
4.000	-	0.130	1.000	24.000
$l_a$ [in.]	$\lambda_a$	$d_a$ [in.]	$f_c$ [psi]	$\Psi_{parallel,V}$
6.000	1.000	0.750	3500	1.000

**Calculations**

$A_{Vc}$ [in. ² ]	$A_{Vc0}$ [in. ² ]	$\Psi_{ec,V}$	$\Psi_{ed,V}$	$\Psi_{h,V}$	$V_b$ [lb]
432.00	72.00	0.979	1.000	1.000	4260

**Results**

$V_{cbg}$ [lb]	$\phi_{concrete}$	$\phi V_{cbg}$ [lb]	$V_{ua}$ [lb]
25016	0.700	17511	4000

**5 Combined tension and shear loads**

$\beta_N$	$\beta_V$	$\zeta$	Utilization $\beta_{N,V}$ [%]	Status
0.731	0.556	5/3	97	OK

$$\beta_{NV} = \beta_N + \beta_V \zeta \leq 1$$

**6 Warnings**

- The anchor design methods in PROFIS Anchor require rigid anchor plates per current regulations (ETAG 001/Annex C, EOTA TR029, etc.). This means load re-distribution on the anchors due to elastic deformations of the anchor plate are not considered - the anchor plate is assumed to be sufficiently stiff, in order not to be deformed when subjected to the design loading. PROFIS Anchor calculates the minimum required anchor plate thickness with FEM to limit the stress of the anchor plate based on the assumptions explained above. The proof if the rigid base plate assumption is valid is not carried out by PROFIS Anchor. Input data and results must be checked for agreement with the existing conditions and for plausibility!
- Condition A applies when supplementary reinforcement is used. The  $\Phi$  factor is increased for non-steel Design Strengths except Pullout Strength and Pryout strength. Condition B applies when supplementary reinforcement is not used and for Pullout Strength and Pryout Strength. Refer to your local standard.
- ACI 318 does not specifically address anchor bending when a stand-off condition exists. PROFIS Anchor calculates a shear load corresponding to anchor bending when stand-off exists and includes the results as a shear Design Strength!
- Design Strengths of adhesive anchor systems are influenced by the cleaning method. Refer to the INSTRUCTIONS FOR USE given in the Evaluation Service Report for cleaning and installation instructions
- Checking the transfer of loads into the base material and the shear resistance are required in accordance with ACI 318 or the relevant standard!
- Installation of Hilti adhesive anchor systems shall be performed by personnel trained to install Hilti adhesive anchors. Reference ACI 318-11, Part D.9.1



**Profis Anchor 2.7.5**

[www.hilti.us](http://www.hilti.us)

Company:	Waterman Industries	Page:	8
Specifier:	Amanuel Wubneh P.E.	Project:	Renaud Bros, Inc.
Address:	25500 Road 204	Sub-Project   Pos. No.:	RB-17-0351 Rev.1
Phone   Fax:	(800) 331-0808   (559) 562-8629	Date:	11/7/2017
E-Mail:	amanuel.wubneh@watermanusa.com		

**Fastening meets the design criteria!**

**Approved AsNoted**

BY: Ken Upmal

DATE: 11/29/2017

RESUBMIT: NO

RECEIVED: November 13, 2017

CKD BY: DV/BK (Green Int'l)

**STATE OF VERMONT**  
**AGENCY OF TRANSPORTATION**



Profis Anchor 2.7.5

www.hilti.us

Company: Waterman Industries  
 Specifier: Amanuel Wubneh P.E.  
 Address: 25500 Road 204  
 Phone | Fax: (800) 331-0808 | (559) 562-8629  
 E-Mail: amanuel.wubneh@watermanusa.com

Page: 9  
 Project: Renaud Bros, Inc.  
 Sub-Project | Pos. No.: RB-17-0351 Rev.1  
 Date: 11/7/2017


7 Installation data

Anchor plate, steel: -  
 Profile: no profile  
 Hole diameter in the fixture:  $d_f = 0.813$  in.  
 Plate thickness (input): 1.000 in.  
 Recommended plate thickness: not calculated  
 Drilling method: Hammer drilled  
 Cleaning: Compressed air cleaning of the drilled hole according to instructions for use is required

Anchor type and diameter: HIT-RE 500 V3 + HAS-R 316 SS 3/4  
 Installation torque: 1200.000 in.lb  
 Hole diameter in the base material: 0.875 in.  
 Hole depth in the base material: 14.000 in.  
 Minimum thickness of the base material: 15.750 in.

7.1 Recommended accessories

Drilling	Cleaning	Setting
<ul style="list-style-type: none"> <li>Suitable Rotary Hammer</li> <li>Properly sized drill bit</li> </ul>	<ul style="list-style-type: none"> <li>Compressed air with required accessories to blow from the bottom of the hole</li> <li>Proper diameter wire brush</li> </ul>	<ul style="list-style-type: none"> <li>Dispenser including cassette and mixer</li> <li>Torque wrench</li> </ul>

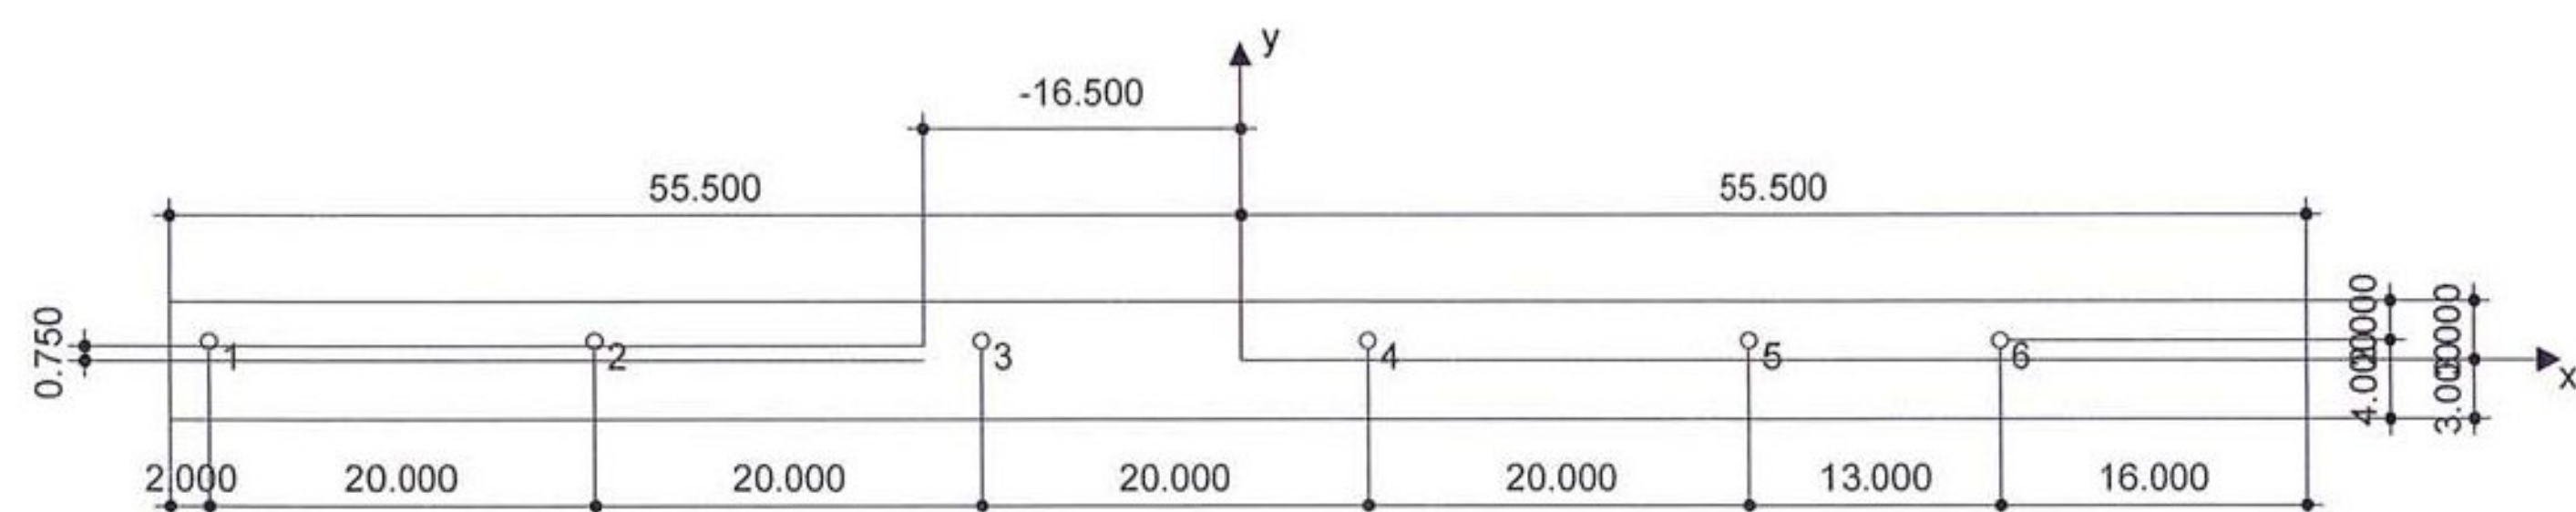

**Approved AsNoted**

BY: Ken Upmal  
 DATE: 11/29/2017  
 RESUBMIT: NO  
 RECEIVED: November 13, 2017  
 CTD BY: DV/BK (Green Int'l)

STATE OF VERMONT  
 AGENCY OF TRANSPORTATION

Coordinates Anchor in.

Anchor	x	y	C-x	C+y	C-y	C+y	Anchor	x	y	C-x	C+y	C-y	C+y
1	-53.500	1.000	-	-	4.000	-	4	6.500	1.000	-	-	4.000	-
2	-33.500	1.000	-	-	4.000	-	5	26.500	1.000	-	-	4.000	-
3	-13.500	1.000	-	-	4.000	-	6	39.500	1.000	-	-	4.000	-

Input data and results must be checked for agreement with the existing conditions and for plausibility!  
 PROFIS Anchor ( c ) 2003-2009 Hilti AG, FL-9494 Schaan Hilti is a registered Trademark of Hilti AG, Schaan



**Profis Anchor 2.7.5**

[www.hilti.us](http://www.hilti.us)

Company:	Waterman Industries	Page:	10
Specifier:	Amanuel Wubneh P.E.	Project:	Renaud Bros,Inc.
Address:	25500 Road 204	Sub-Project   Pos. No.:	RB-17-0351 Rev.1
Phone   Fax:	(800) 331-0808   (559) 562-8629	Date:	11/7/2017
E-Mail:	amanuel.wubneh@watermanusa.com		

**8 Remarks; Your Cooperation Duties**

- Any and all information and data contained in the Software concern solely the use of Hilti products and are based on the principles, formulas and security regulations in accordance with Hilti's technical directions and operating, mounting and assembly instructions, etc., that must be strictly complied with by the user. All figures contained therein are average figures, and therefore use-specific tests are to be conducted prior to using the relevant Hilti product. The results of the calculations carried out by means of the Software are based essentially on the data you put in. Therefore, you bear the sole responsibility for the absence of errors, the completeness and the relevance of the data to be put in by you. Moreover, you bear sole responsibility for having the results of the calculation checked and cleared by an expert, particularly with regard to compliance with applicable norms and permits, prior to using them for your specific facility. The Software serves only as an aid to interpret norms and permits without any guarantee as to the absence of errors, the correctness and the relevance of the results or suitability for a specific application.
- You must take all necessary and reasonable steps to prevent or limit damage caused by the Software. In particular, you must arrange for the regular backup of programs and data and, if applicable, carry out the updates of the Software offered by Hilti on a regular basis. If you do not use the AutoUpdate function of the Software, you must ensure that you are using the current and thus up-to-date version of the Software in each case by carrying out manual updates via the Hilti Website. Hilti will not be liable for consequences, such as the recovery of lost or damaged data or programs, arising from a culpable breach of duty by you.

<b>Approved AsNoted</b>	
<b>BY:</b>	Ken Upmal
<b>DATE:</b>	11/29/2017
<b>RESUBMIT:</b>	NO
<b>RECEIVED:</b>	November 13, 2017
<b>CD BY:</b>	DV/BK (Green Int'l)
<b>STATE OF VERMONT</b> <b>AGENCY OF TRANSPORTATION</b>	



25500 Road 204 , Exeter, Ca. 93221  
 Phone: (303) 288-7873 * Fax: (303) 287-8531  
 www.WatermanUSA.com

Desc. **RB-17-0487 Hydrostatic Load calc**

Order No. M028960C

Calculated by **Amanuel Wubneh P.E.**


Date 9/21/2017

Checked by **REM**

DWG RB-17-0487

Revision. 1

Tag# STP SCR(4)

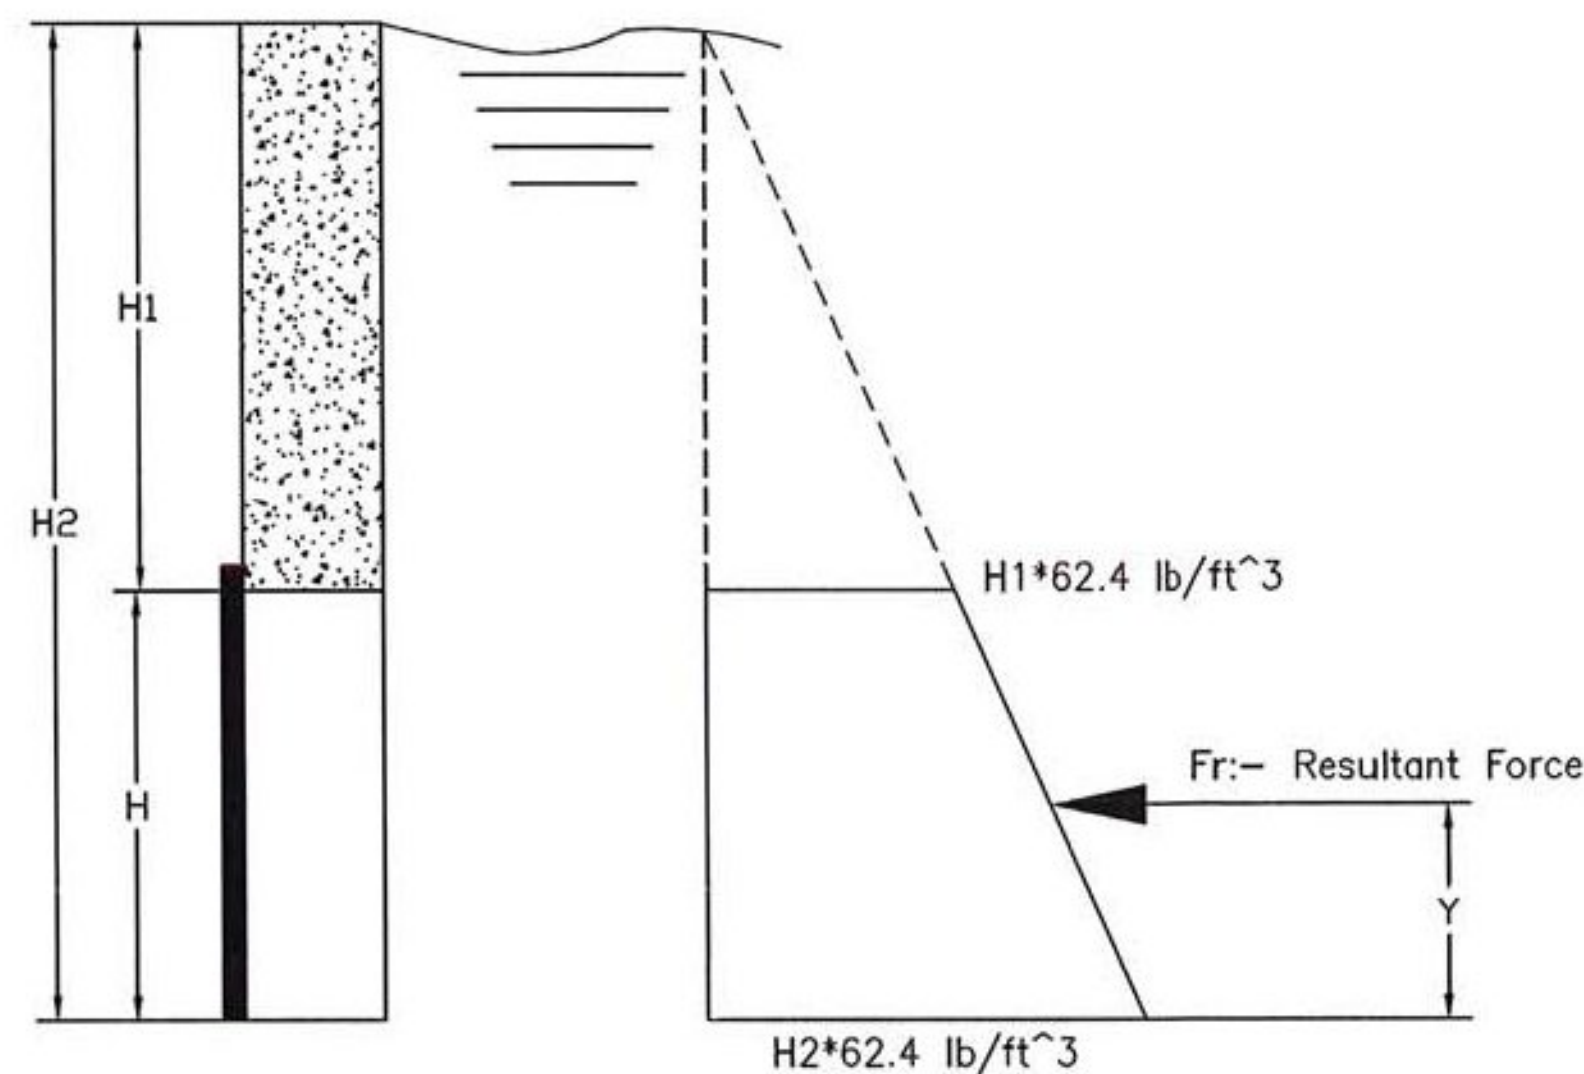

**Design Parameters**

Density of Water,  $\gamma = 62.4$  lb/ft³  
 Height of the gate Opening = **72** in  
 Measurement from max. water level to top of opening, H1 = **144** in  
 Hydraulic Head to the invert, H2 = 216.00 in  
 Width Of the Gate, W = **72** in  
 Hydraulic Head to the center of opening, Hc = 180 in = 15 ft

**Approved AsNoted**

BY: Ken Upmal  
 DATE: 11/29/2017  
 RESUBMIT: NO  
 RECEIVED: November 13, 2017  
 CKD BY: DV/BK (Green Int'l)

STATE OF VERMONT  
 AGENCY OF TRANSPORTATION

**Applied Load**

Hydrostatic Load,  $F := 62.4 \cdot \left(\frac{W}{12}\right) \cdot \left(\frac{H}{12}\right) \cdot Hc = 33696$  lbs

Hydrostatic load per side of the gate, F/2 = 16848 lbs

Moment created due to eccentrical loading, Me = 29484 lb.in

Point of application of the resultant force, Y =  $\frac{[(H_1 * H / 2 + 1 / 2 * (H_2 - H_1) * H / 3)]}{(H_2 + H_1) * 0.5}$

Y = 33.6 in



*Auf*  
 11-7-2017

LIFT & STEM CALCULATIONS

CONTRACTOR'S NAME: RENAUD BROS., INC.  
JOB SITE: Peru, Vermont  
QUOTE #: WQ17-H-28960C  
JOB #: M028960  
ITEM #: 0  
REVISION #: 0  
DATE: 8/22/2017  
BY: AMW

GATE IDENTIFICATION: RB-17-0487  
GATE DESCRIPTION: 72 x 72 S-5000 ; GATE WEIGHT: 3611 LBS  
MAXIMUM OPERATING HEADS: SEATING = 15 FT; UNSEATING = 15 FT  
DIFFERENTIAL = 15 FT  
SOURCE OF OPERATING HEADS: ESTIMATED  
STEM DIAMETER: 2.500 IN; THREADED: 2.5 DIA. ; 1/4 PITCH ; 1/4 LEAD; LEFT  
HAND; STUB ACME  
STEM LENGTH: 135.00 IN; STEM WEIGHT: 188 LBS

LIFTING FORCE CALCULATIONS & OPERATING SPECIFICATIONS

REQUIRED OPERATING FORCE:  $F_o = W \cdot A \cdot H \cdot f_o + W_g + W_s$

$$F_o = 62.4 \frac{\text{LBS}}{\text{FT}^3} \cdot 36.00 \text{ FT}^2 \cdot 15.00 \text{ FT} \cdot 0.35 + 3611 \text{ LBS} + 188 \text{ LBS} = 15,593 \text{ LBS}$$

LIFT USED: 3R7/AS3-12:1

RATED LIFT CAPACITY: 24,545 LBS @ 40 LBS INPUT ON 15" HAND CRANK

STEM CAPACITY CALCULATIONS

CALCULATED FROM EULERS EQUATION,  $P_c = \frac{2\pi^2 EA}{(L/r)^2}$

SOLID PORTION:


$$\text{DIA.} = 2.500 \text{ IN; AREA} = 4.91 \text{ IN}^2; \text{LG}_{\text{max.}} = 125.00; L/r = 200.00; P_c = 66,861 \text{ LBS}$$

THREADED PORTION:

$$\text{DIA.} = 2.359 \text{ IN; AREA} = 4.37 \text{ IN}^2; \text{LG}_{\text{max.}} = 117.95; L/r = 200.00; P_c = 59,520 \text{ LBS}$$

$$\text{SAFETY FACTOR} : S_f = \frac{P_{c \text{ MIN}}}{L_c} = \frac{59,520 \text{ LBS}}{24,545 \text{ LBS}} = 2.43$$

<b>Approved AsNoted</b>	
BY:	Ken Upmal
DATE:	11/29/2017
RESUBMIT:	NO
RECEIVED:	November 13, 2017
CD BY:	DV/BK (Green Int'l)
STATE OF VERMONT AGENCY OF TRANSPORTATION	

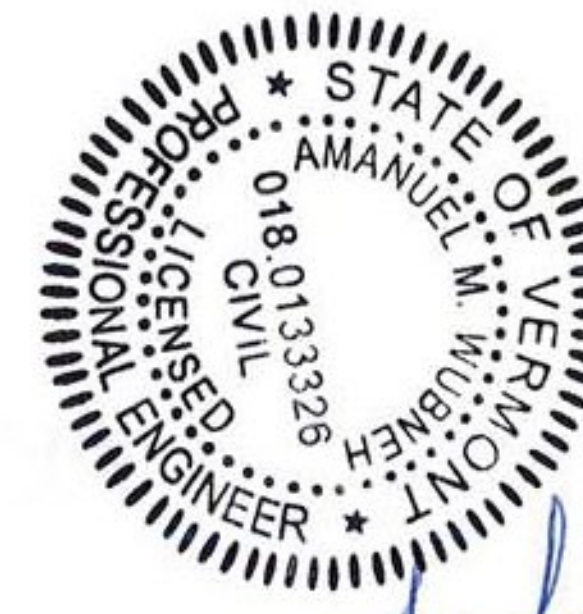

*[Handwritten Signature]* 11-7-2017

$$\text{TENSILE STRENGTH}_{\min} : TS = \frac{F_u * A}{\Omega} = \frac{70,000 \text{ psi} * \pi \left( \frac{D_{2\min} + D_{1\max}}{4} \right)^2}{5.00}$$

(REFER MACHINERY HANDBOOK 26 PAGE 1794)

$$TS = 58,801 \text{ LBS}$$

$$\text{SAFETY FACTOR} : Sf = \frac{58,801 \text{ LBS}}{24,545 \text{ LBS}} = 2.40 \text{ OK!}$$

STEM THREAD SHEAR CAPACITY PER INCH :

$$\frac{V_n}{\Omega} = \frac{F_v * \pi * D_{1\max} (0.5 + n * \tan 14.5^\circ * (D_{2\min} - D_{1\max}))}{1.50} = 44,483.22 \text{ LBS/IN}$$

(REFER MACHINERY HANDBOOK 26 PAGE 1794)

LIFT NUT HEIGHT = 3.386 IN

$$\text{TOTAL STEM THREAD SHEAR CAPACITY} = \frac{V_n}{\Omega} * \text{LIFT NUT HEIGHT} = 150,620 \text{ LBS}$$

$$\text{SAFETY FACTOR} : Sf = \frac{150,620 \text{ LBS}}{24,545 \text{ LBS}} = 6.14 \text{ OK!}$$

