



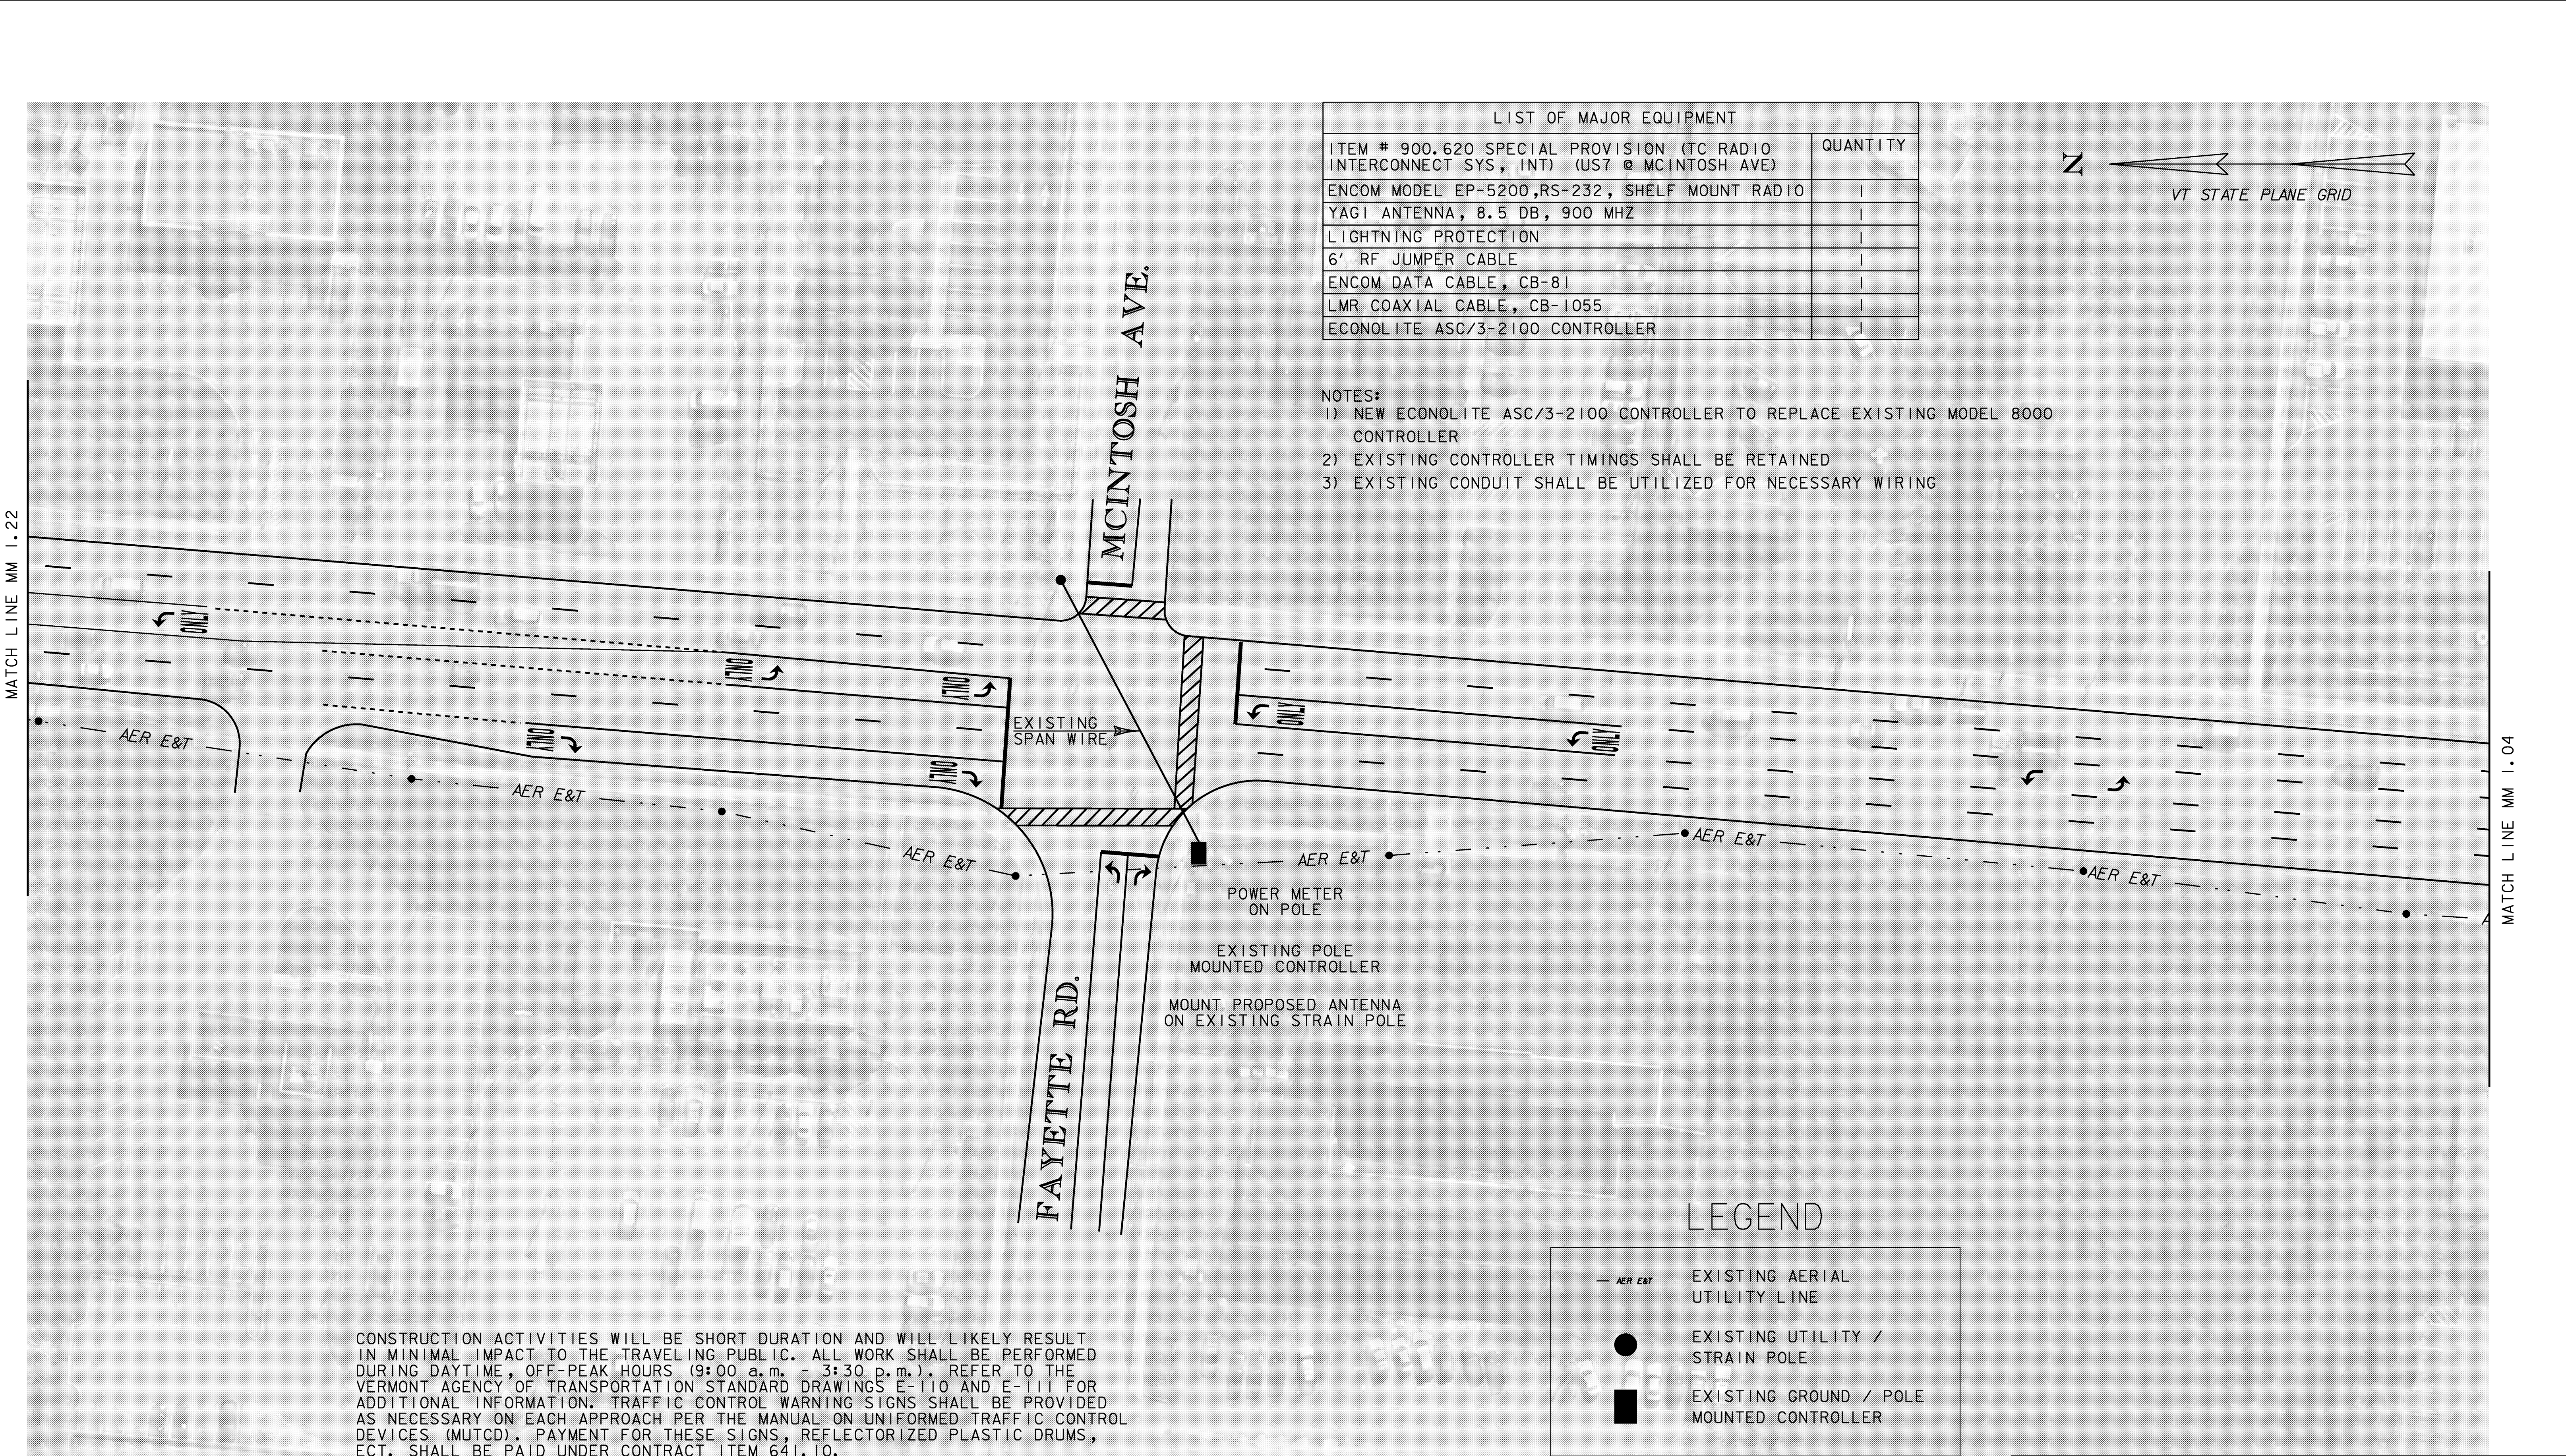

LIST OF MAJOR EQUIPMENT	
ITEM # 900.620 SPECIAL PROVISION (TC RADIO INTERCONNECT SYS, INT) (US7 @ MCINTOSH AVE)	QUANTITY
ENCOM MODEL EP-5200,RS-232, SHELF MOUNT RADIO	1
YAGI ANTENNA, 8.5 DB, 900 MHZ	1
LIGHTNING PROTECTION	1
6' RF JUMPER CABLE	1
ENCOM DATA CABLE, CB-81	1
LMR COAXIAL CABLE, CB-1055	1
ECONOLITE ASC/3-2100 CONTROLLER	1

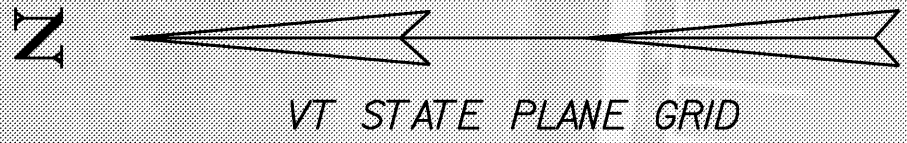


- NOTES:
- 1) NEW ECONOLITE ASC/3-2100 CONTROLLER TO REPLACE EXISTING MODEL 8000 CONTROLLER
 - 2) EXISTING CONTROLLER TIMINGS SHALL BE RETAINED
 - 3) EXISTING CONDUIT SHALL BE UTILIZED FOR NECESSARY WIRING

LEGEND

	EXISTING AERIAL UTILITY LINE
	EXISTING UTILITY / STRAIN POLE
	EXISTING GROUND / POLE MOUNTED CONTROLLER

CONSTRUCTION ACTIVITIES WILL BE SHORT DURATION AND WILL LIKELY RESULT IN MINIMAL IMPACT TO THE TRAVELING PUBLIC. ALL WORK SHALL BE PERFORMED DURING DAYTIME, OFF-PEAK HOURS (9:00 a.m. - 3:30 p.m.). REFER TO THE VERMONT AGENCY OF TRANSPORTATION STANDARD DRAWINGS E-110 AND E-111 FOR ADDITIONAL INFORMATION. TRAFFIC CONTROL WARNING SIGNS SHALL BE PROVIDED AS NECESSARY ON EACH APPROACH PER THE MANUAL ON UNIFORMED TRAFFIC CONTROL DEVICES (MUTCD). PAYMENT FOR THESE SIGNS, REFLECTORIZED PLASTIC DRUMS, ECT. SHALL BE PAID UNDER CONTRACT ITEM 641.10.

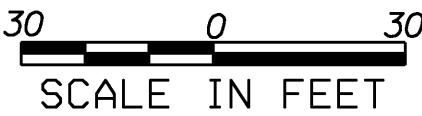

PROJECT NAME:	SOUTH BURLINGTON	FILE NAME:	07b114\Traffic\tbl4LS4.dgn	PLOT DATE:	12-MAR-2009
PROJECT NUMBER:	NHG SGNL(30)	PROJECT LEADER:	J. SCHULTZ	DRAWN BY:	B. MCAVOY
		DESIGNED BY:	B. MCAVOY	CHECKED BY:	J. DEVLIN
		INTERCONNECT LAYOUT SHEET 4		SHEET 6	OF 7