


NOTES:

1. PAVING LIFT SHALL BE A MINIMUM OF 1 1/2" AND A MAXIMUM OF 2".
2. THE COST OF PROVIDING AND PLACING SUBBASE MATERIAL, CLEANING EXISTING PAVED SURFACES, INCLUDING POWER EQUIPMENT, AND FOR FILLING JOINTS, CRACKS AND HOLES WILL NOT BE PAID DIRECTLY BUT WILL BE INCLUDED IN THE UNIT PRICE BID FOR ITEM 900.675 SPECIAL PROVISION (HAND-PLACED BITUMINOUS CONCRETE MATERIAL, DRIVES).
3. EXCAVATION NEEDED TO ACHIEVE PROPER DRIVE SLOPES WILL NOT BE PAID DIRECTLY BUT WILL BE INCLUDED IN THE UNIT PRICE BID FOR ITEM 900.675 SPECIAL PROVISION (HAND-PLACED BITUMINOUS CONCRETE MATERIAL, DRIVES).

LEGEND

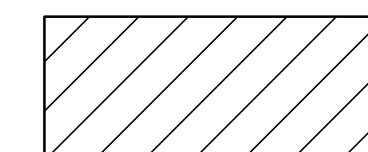

ITEM 900.675 SPECIAL PROVISION (HAND-PLACED BITUMINOUS CONCRETE MATERIAL, DRIVES)



**DRIVE
DETAIL
SHEET #1**

PROJECT NAME: SHELDON-ENOSBURG
PROJECT NUMBER: STP 2714(I)

FILE NAME: p07b180.dgn
PROJECT LEADER: JLL
DESIGNED BY: STANTEC
IPARM FILE: p07b180ds01.i

PLOT DATE: 07-NOV-2011 16:46
DRAWN BY: STANTEC
CHECKED BY: JLL
SHEET 9 OF 29