


SHELDON
MM 2.2, RT
MM 3.9, LT
MM 7.3, RT
MM 8.2, RT
MM 10.1, LT

NOTES:


1. GRADE EXISTING GRAVEL PULL-OUT AS NECESSARY TO PROVIDE A SMOOTH SURFACE OR AS DIRECTED BY RESIDENT ENGINEER. THIS WORK SHALL BE INCLUDED IN THE UNIT PRICE BID FOR ITEM 608.15 POWER GRADER RENTAL.

2. AN ESTIMATED QUANTITY OF ITEM 900.675 SPECIAL PROVISION (HAND-PLACED BITUMINOUS CONCRETE MATERIAL, DRIVES) HAS BEEN INCLUDED FOR WORK AT BOTH ENDS OF THE PULL-OUT AS DIRECTED BY THE RESIDENT ENGINEER.

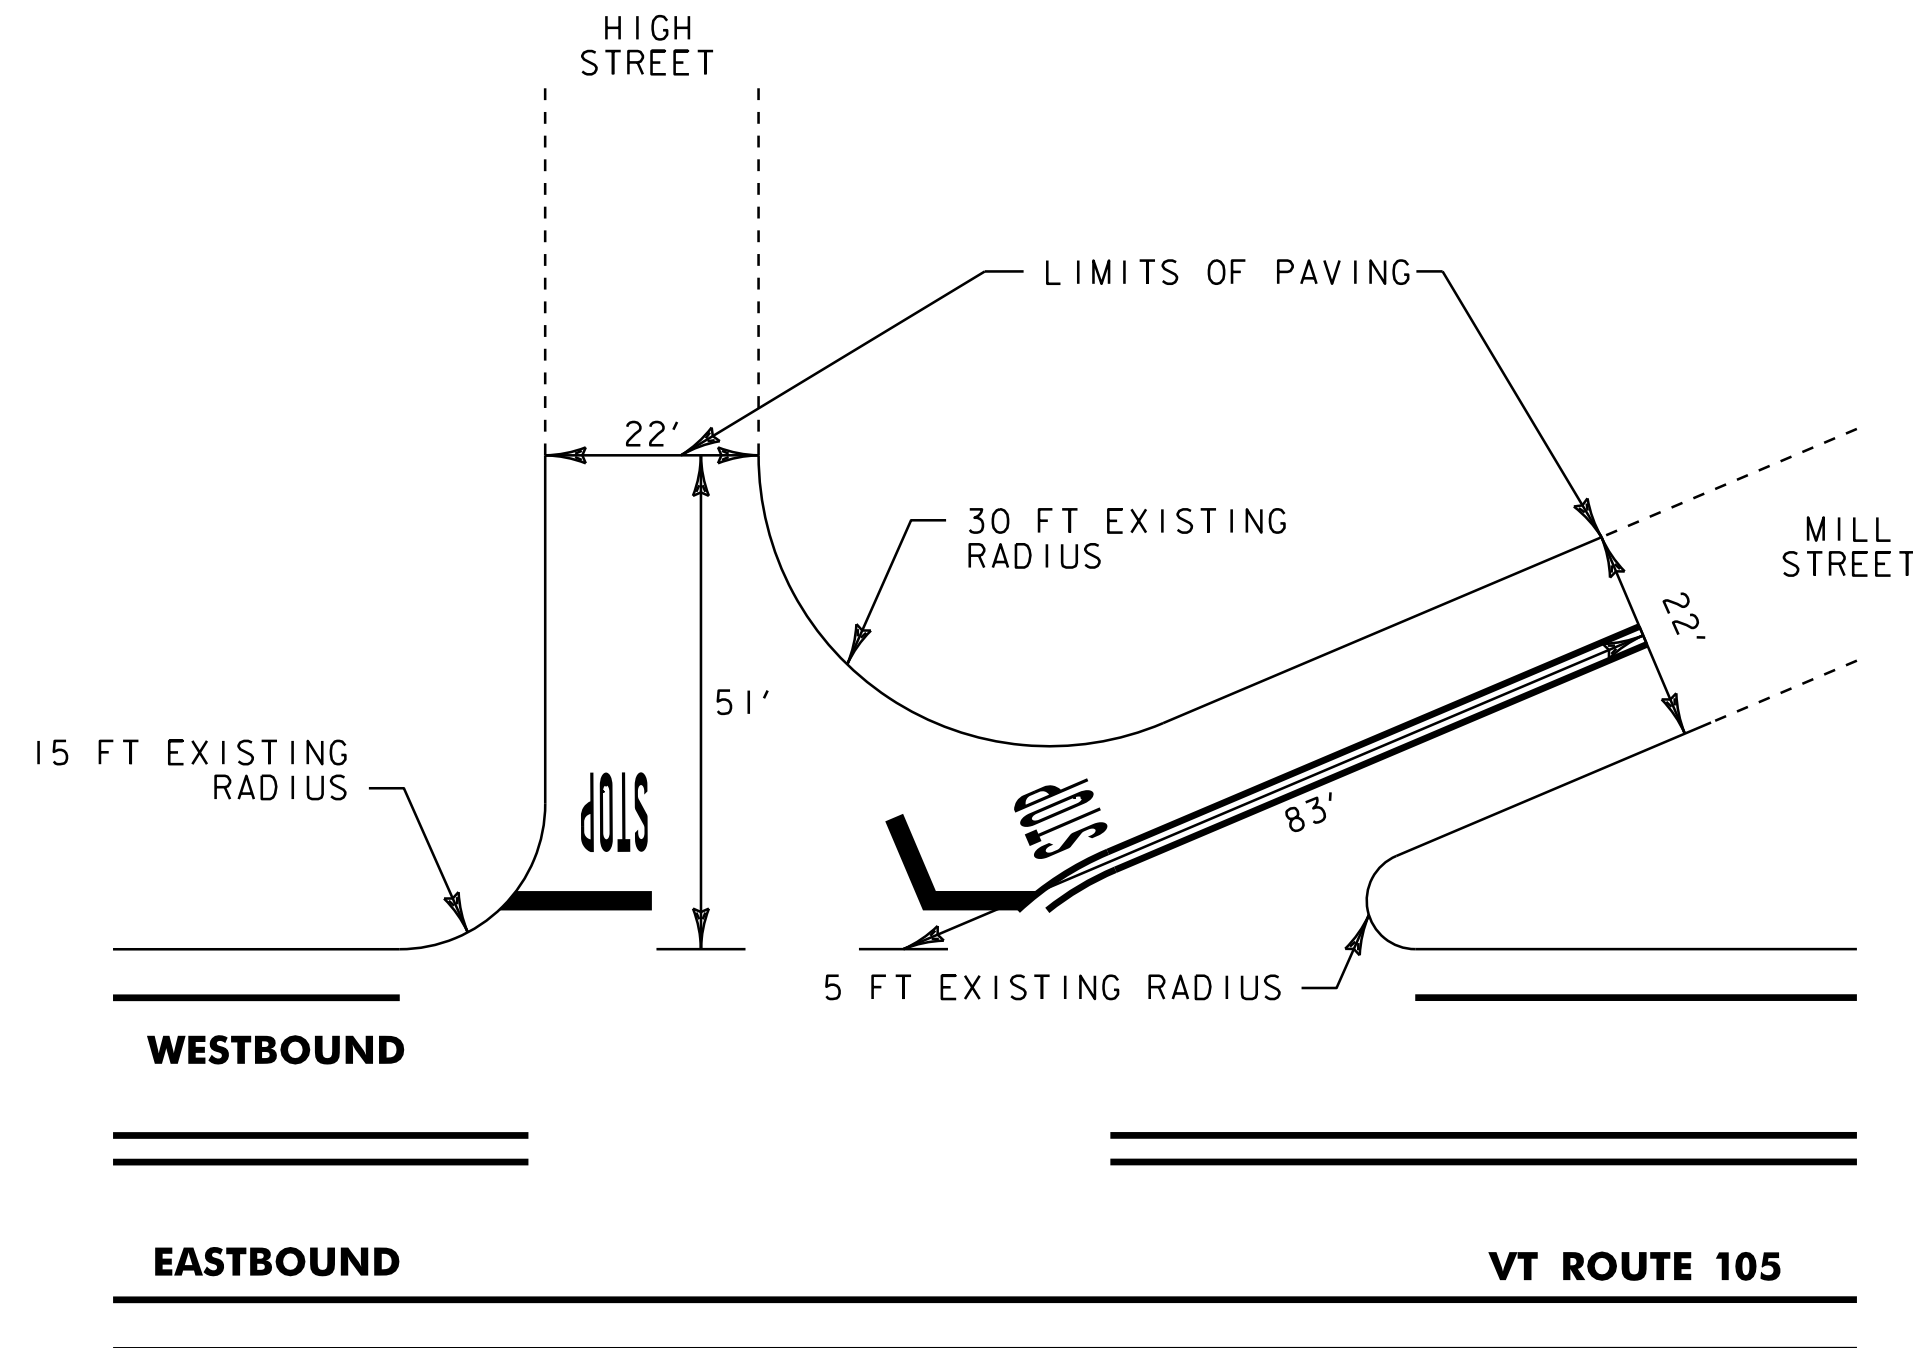

MILL STREET (TH43) PAVING DETAIL


MM 2.354, LT

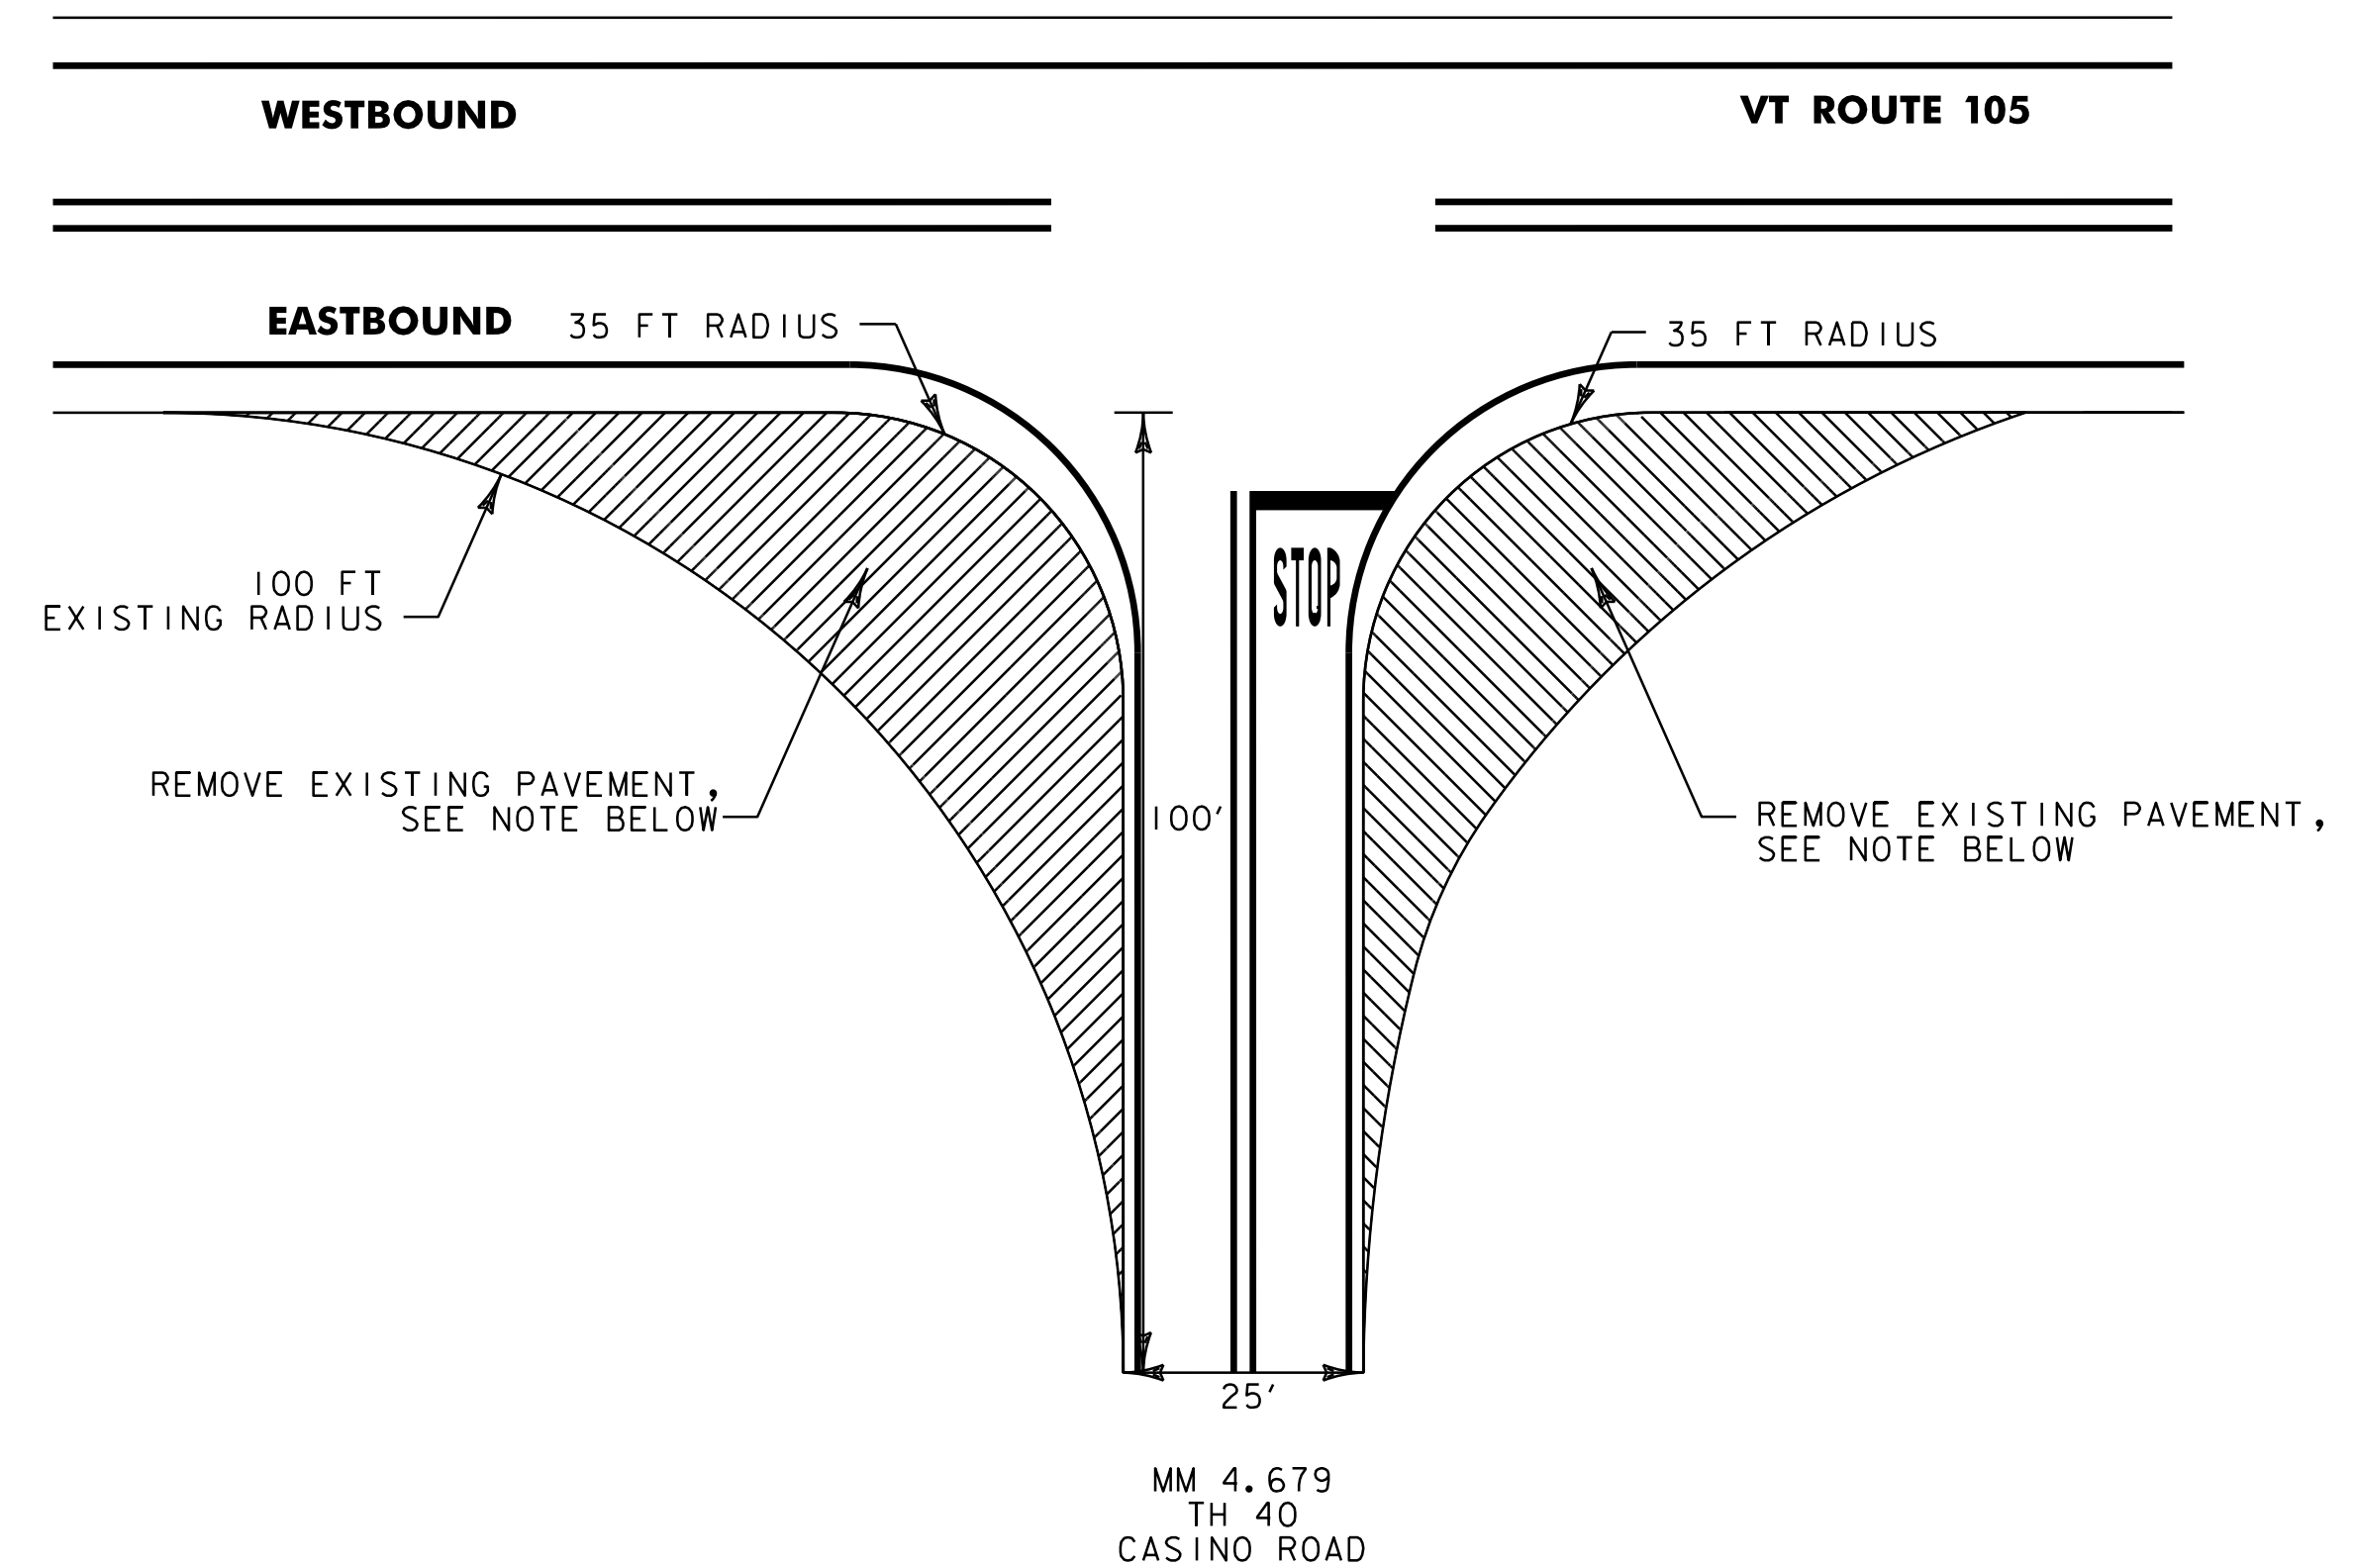


CASINO ROAD PAVEMENT REMOVAL DETAIL

NOTE:


REMOVE 4 INCHES OF EXISTING PAVEMENT AS SHOWN. PAYMENT TO BE MADE UNDER ITEM 203.28 - EXCAVATION OF SURFACES AND PAVEMENTS. IF LESS THAN 4 INCHES OF PAVEMENT IS ENCOUNTERED, REMOVAL OF SUBBASE SHALL BE PAID UNDER ITEM 203.15 - COMMON EXCAVATION. REPLACE WITH 4 INCHES OF ITEM 651.35 - TOPSOIL, 651.15 - SEED, 651.18 - FERTILIZER, 651.20 - AGRICULTURAL LIMESTONE AND 653.20 - TEMPORARY EROSION MATTING. ESTIMATED QUANTITIES OF ALL THESE ITEMS HAVE BEEN INCLUDED FOR USE AS DIRECTED BY THE RESIDENT ENGINEER.

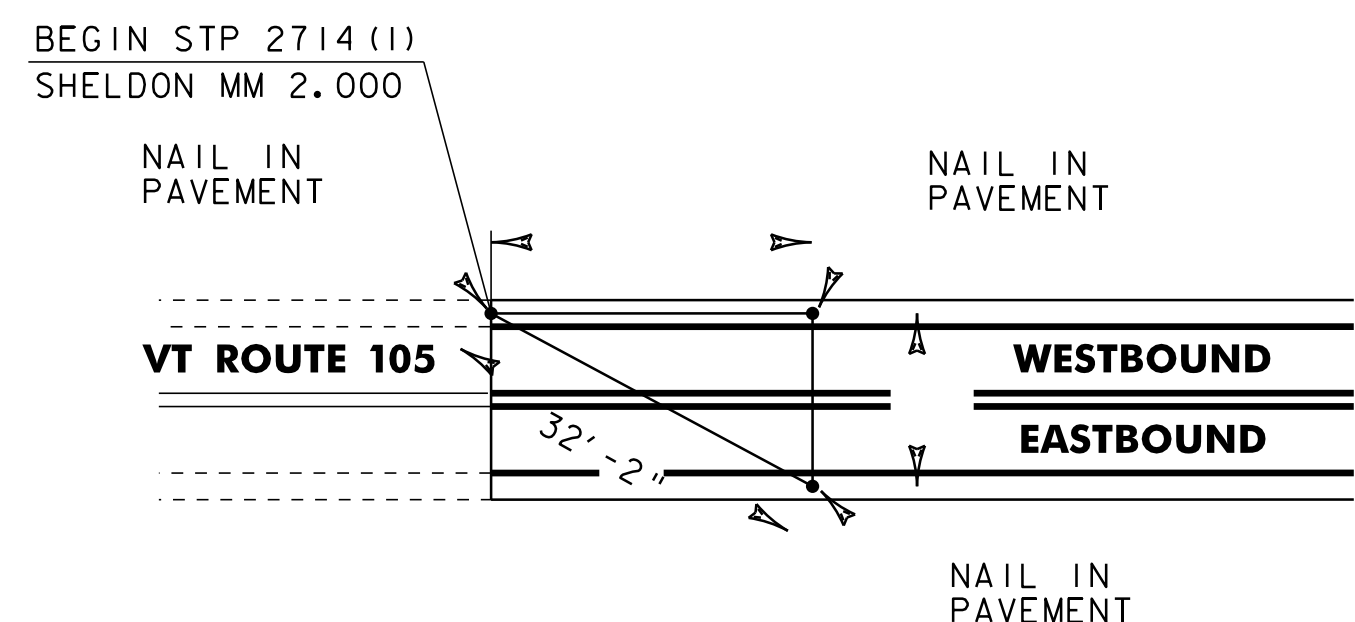

BEGIN PROJECT LOCATION TIES

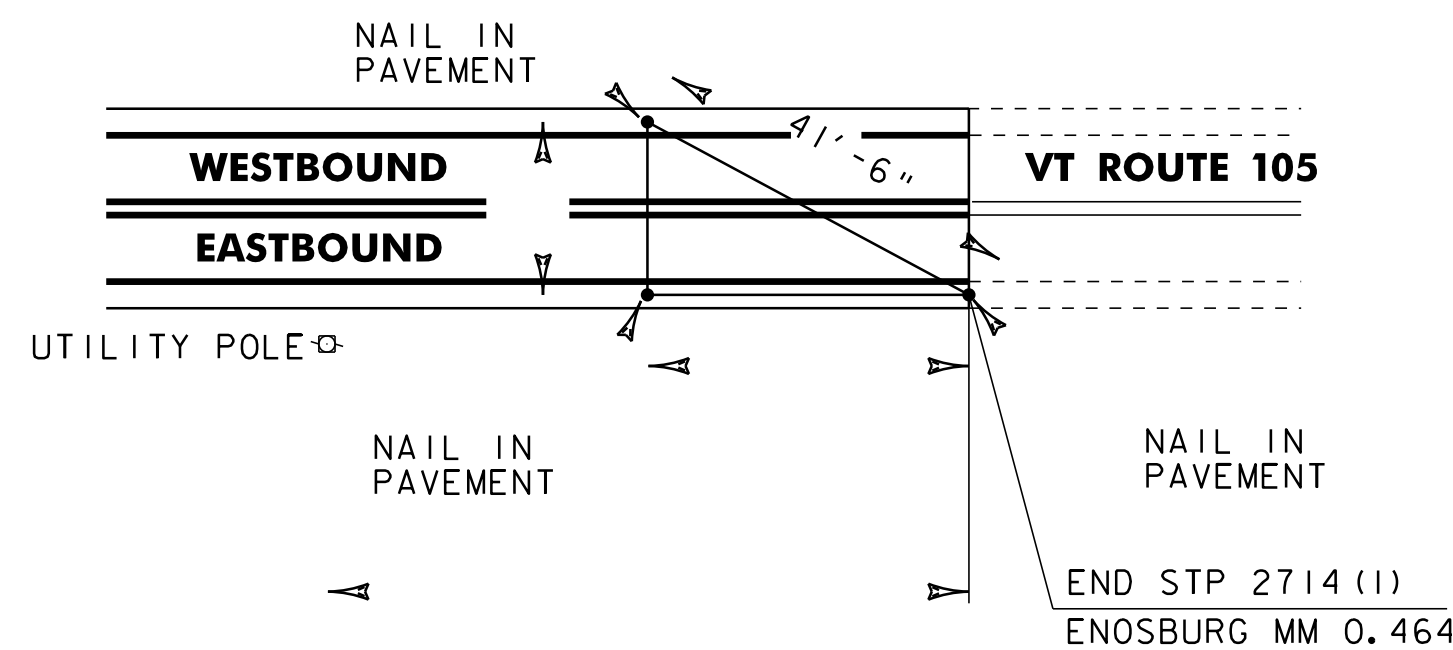

END PROJECT LOCATION TIES

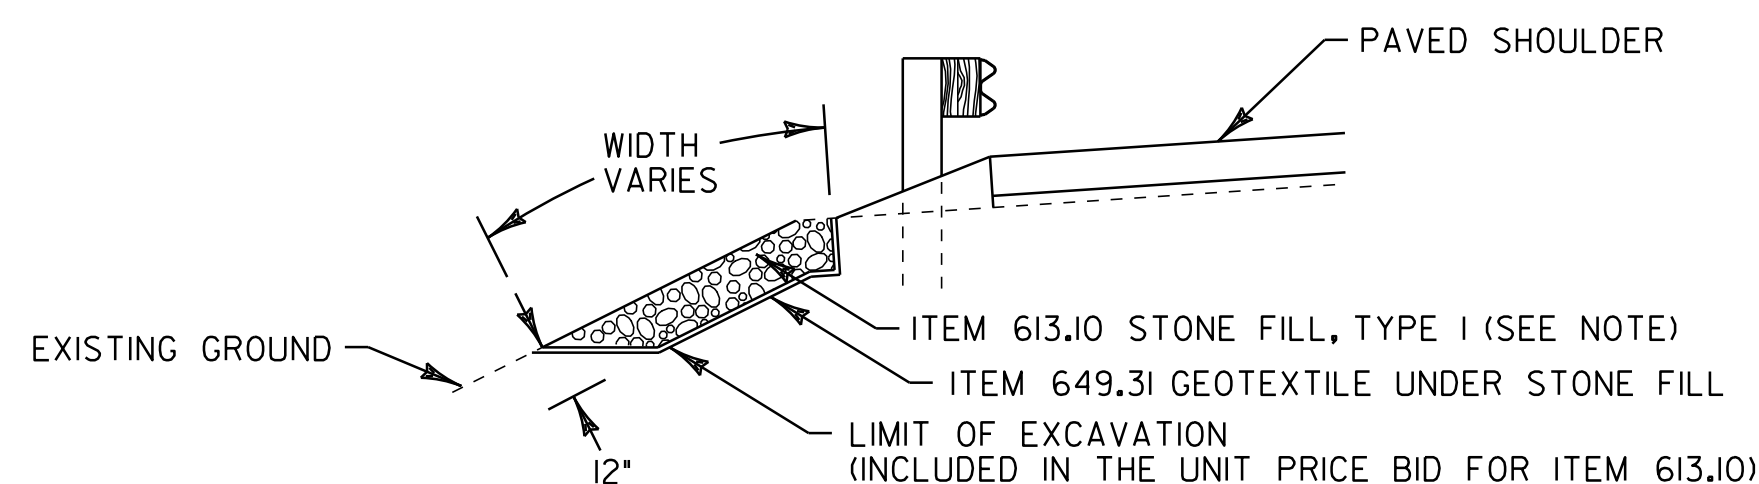


SLOPE EROSION REPAIR DETAIL

(ASSUME A 6' LENGTH UNLESS OTHERWISE NOTED)

SHELDON MM 4.538, RT
MM 5.148, RT
MM 5.738, LT
MM 6.295, RT
MM 9.509, LT
MM 9.510, RT
MM 9.944, RT
ENOSBURG MM 0.402 TO MM 0.412, LT (50' ±)

NOTE:

AN ESTIMATED QUANTITY OF ITEM 613.11 STONE FILL, TYPE II HAS BEEN INCLUDED FOR USE AS DIRECTED BY THE RESIDENT ENGINEER. IF ITEM 613.11 IS NECESSARY, THE ADDITIONAL EXCAVATION DEPTH REQUIRED WILL NOT BE PAID SEPARATELY BUT WILL BE CONSIDERED INCLUDED IN THE UNIT PRICE BID FOR ITEM 613.11 STONE FILL, TYPE II.

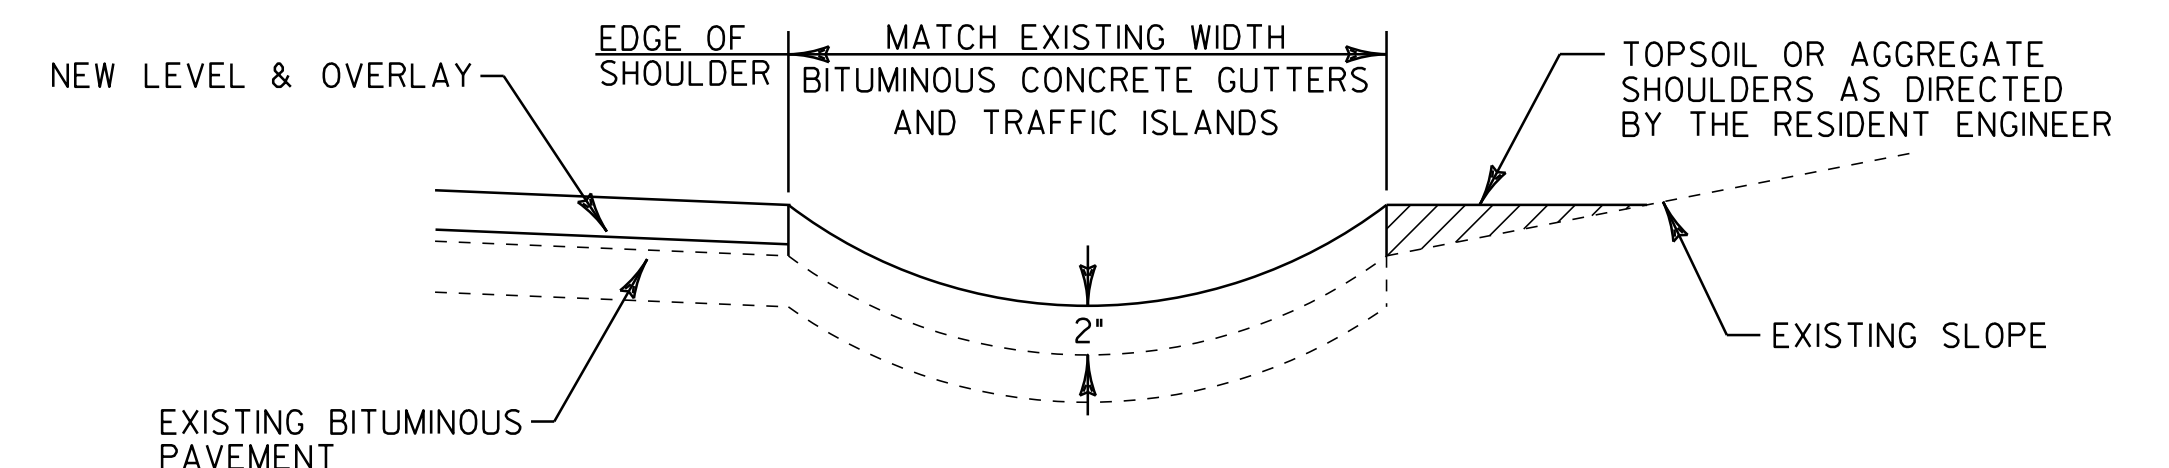

BITUMINOUS CONCRETE GUTTER DETAIL

SHELDON
MM 4.912, LT TO MM 5.083, LT
ENOSBURG
MM 0.338 TO MM 0.417, RT

**MISCELLANEOUS
DETAIL
SHEET**



PROJECT NAME: SHELDON-ENOSBURG
PROJECT NUMBER: STP 2714(1)

FILE NAME: p07b180.dgn
PROJECT LEADER: JLL
DESIGNED BY: STANTEC
IPARM FILE: p07b180md.i

PLOT DATE: 07-NOV-2011 16:46
DRAWN BY: STANTEC
CHECKED BY: JLL
SHEET 28 OF 29