


STATION	POSITION	QUANTITY (SY)	DESCRIPTION
CAMBRIDGE			
0+36	RT	9.5	PAVED
1+50	RT	24.4	PAVED
2+41	RT	16.3	GRAVEL
7+55	LT	3.7	FIELD
13+86	LT	18.4	GRAVEL
16+11	RT	24.8	GRAVEL
16+15	LT	7.2	GRAVEL
22+28	RT	4.4	FIELD
22+58	LT	50.2	GRAVEL
35+51	LT	14.4	GRAVEL
47+47	LT	47.5	GRAVEL
58+38	RT	18.1	GRAVEL
59+43	LT	25.0	GRAVEL
64+22	LT	18.1	GRAVEL
67+15	LT	6.0	WOODS
76+05	LT	6.2	WOODS
76+57	RT	46.0	GRAVEL
82+84	LT	19.8	GRAVEL
84+25	LT	15.4	GRAVEL
87+16	RT	12.6	GRAVEL
97+60	LT	15.6	GRAVEL
FAIRFAX			
17+83	RT	27.7	GRAVEL
19+03	LT	25.6	GRAVEL
25+00	RT	15.2	GRAVEL
28+59	LT	15.2	GRAVEL
35+22	LT	41.4	GRAVEL
37+43	LT	21.4	GRAVEL
37+52	RT	7.3	FIELD
41+11	LT	13.8	GRAVEL
43+40	LT	17.8	GRAVEL
47+53	RT	6.5	FIELD
51+51	LT	31.1	PAVED
51+86	RT	15.8	GRAVEL
53+34	RT	17.2	FIELD
57+65	LT	17.3	GRAVEL
68+80	LT	17.1	GRAVEL
77+16	RT	29.3	GRAVEL
77+95	LT	11.7	GRAVEL
78+85	RT	5.7	FIELD
82+77	RT	7.8	FIELD
97+29	LT	17.7	GRAVEL
101+75	RT	10.3	FIELD
110+63	LT	7.6	GRAVEL
111+13	RT	6.9	FIELD
111+17	LT	13.6	GRAVEL
113+69	LT	24.0	GRAVEL
122+07	LT	16.9	GRAVEL
125+70	LT	9.5	PAVED
130+21	RT	5.8	FIELD
136+44	LT	6.3	FIELD
139+72	RT	8.2	FIELD

STATION	POSITION	QUANTITY (SY)	DESCRIPTION
158+71	LT	27.5	PAVED
176+82	LT	12.6	GRAVEL
185+50	RT	11.1	GRAVEL
187+10	RT	59.7	GRAVEL
189+50	RT	27.6	GRAVEL
192+60	LT	44.6	GRAVEL
193+37	RT	36.0	GRAVEL
205+23	LT	20.0	GRAVEL
206+69	LT	16.0	GRAVEL
207+64	LT	13.8	GRAVEL
207+87	RT	17.0	GRAVEL
209+01	LT	17.3	GRAVEL
212+25	LT	17.3	GRAVEL
212+58	RT	10.2	FIELD
216+36	LT	201.4	PAVED
216+84	RT	30.1	PAVED
220+50	RT	7.1	FIELD
222+62	RT	11.1	GRAVEL
222+88	LT	8.2	GRAVEL
223+55	LT	8.9	GRAVEL
223+88	RT	8.2	PAVED
224+71	RT	14.0	PAVED
226+32	LT	12.6	GRAVEL
227+27	RT	11.6	GRAVEL
228+63	LT	13.1	GRAVEL
228+81	RT	11.0	PAVED
229+28	RT	12.1	GRAVEL
229+63	LT	26.4	GRAVEL
230+36	RT	24.5	GRAVEL
230+81	LT	12.4	GRAVEL
231+21	RT	10.5	GRAVEL
232+27	LT	24.8	GRAVEL
232+54	RT	11.8	PAVED
233+66	RT	19.4	GRAVEL
236+77	RT	26.0	PAVED
239+86	RT	36.3	GRAVEL
244+87	RT	32.4	PAVED
246+43	LT	14.4	PAVED
247+83	LT	23.0	PAVED
248+26	RT	26.9	PAVED
259+59	LT	22.0	GRAVEL
262+21	LT	22.1	GRAVEL
262+68	RT	27.2	GRAVEL
267+39	RT	112.4	GRAVEL
271+67	RT	11.4	GRAVEL
271+84	LT	21.4	PAVED
272+77	LT	13.8	GRAVEL
273+73	LT	23.7	PAVED
274+45	LT	17.3	PAVED
274+50	RT	11.8	PAVED
275+66	RT	10.9	GRAVEL
275+95	RT	7.2	GRAVEL
277+36	RT	9.8	PAVED
283+00	LT	16.3	GRAVEL
283+37	RT	11.8	GRAVEL
283+94	RT	11.4	GRAVEL
284+48	LT	3.7	PAVED
285+02	LT	6.9	GRAVEL
285+53	LT	12.4	PAVED

STATION	POSITION	QUANTITY (SY)	DESCRIPTION
286+78	LT	15.0	GRAVEL
286+90	RT	11.7	PAVED
287+61	RT	7.2	GRAVEL
287+98	RT	7.6	GRAVEL
288+87	RT	7.7	GRAVEL
290+44	RT	8.9	GRAVEL
290+50	LT	26.3	PAVED
291+96	RT	29.5	PAVED
293+16	RT	12.4	GRAVEL
293+62	LT	123.1	PAVED
294+17	RT	29.0	GRAVEL
295+32	RT	8.3	GRAVEL
297+02	LT	8.2	GRAVEL
297+64	RT	13.3	GRAVEL
297+89	LT	28.1	PAVED
298+70	RT	13.7	GRAVEL
298+85	LT	12.7	GRAVEL
299+37	RT	13.7	GRAVEL
300+46	LT	11.9	GRAVEL
301+08	RT	7.1	GRAVEL
301+70	LT	19.3	GRAVEL
301+80	RT	6.6	GRAVEL
302+80	RT	9.8	PAVED
303+25	RT	4.8	GRAVEL
303+55	LT	34.1	GRAVEL
305+03	LT	21.1	PAVED
305+23	RT	6.6	PAVED
305+82	RT	13.5	GRAVEL
306+34	LT	11.6	GRAVEL
307+45	RT	14.9	PAVED
308+83	RT	6.2	GRAVEL
309+13	LT	15.2	GRAVEL
310+64	LT	19.0	PAVED
311+73	LT	7.2	GRAVEL
313+17	RT	27.1	GRAVEL
314+67	RT	11.6	GRAVEL
316+09	RT	8.4	GRAVEL
316+12	LT	29.1	GRAVEL
317+40	LT	7.4	GRAVEL
318+46	LT	11.1	GRAVEL
324+23	RT	149.9	PAVED
325+25	LT	13.2	GRAVEL
326+20	LT	14.6	GRAVEL
331+91	RT	17.1	PAVED
336+06	RT	7.7	GRAVEL
338+20	RT	11.1	GRAVEL
351+03	LT	42.0	GRAVEL
351+87	RT	13.3	GRAVEL
352+65	RT	11.8	GRAVEL
352+70	LT	8.4	FIELD
355+75	RT	8.4	FIELD
SUBTOTAL		3195.2	
ROUNDING		104.8	
TOTAL		3300.0	

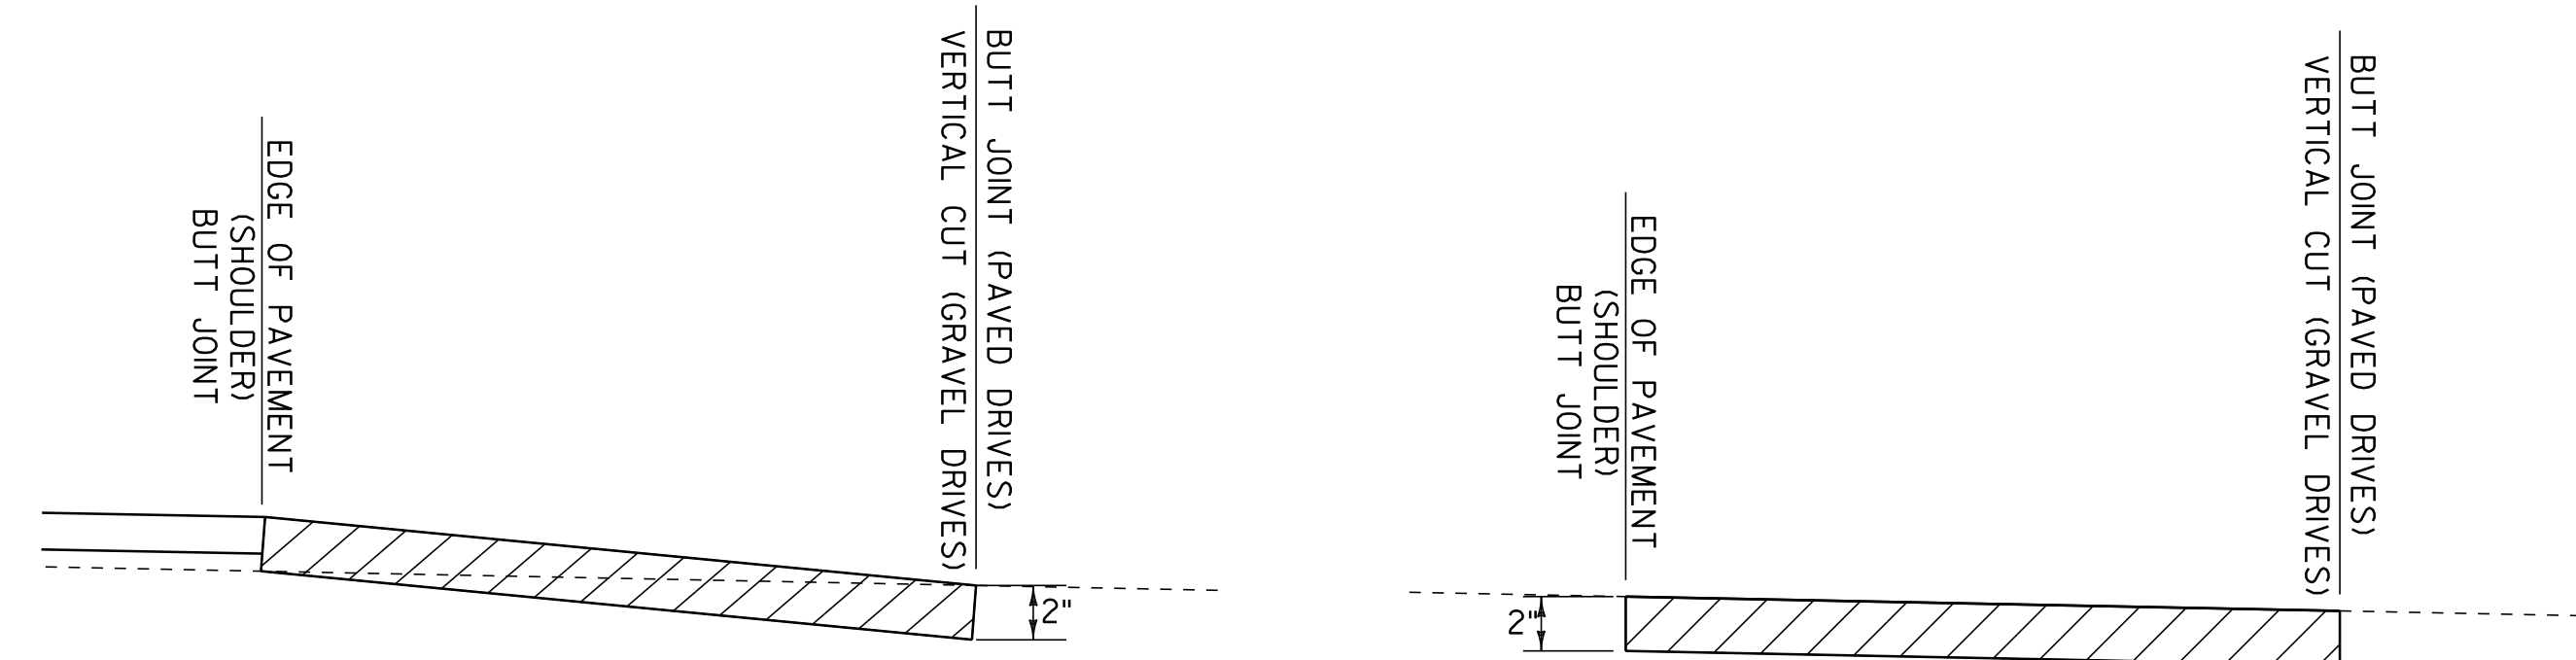

**SECTION A-A
LEVEL AND OVERLAY AREA**

**SECTION A-A
COLD PLANE AND PAVE AREA**

PLAN

HANDWORK DETAILS FOR DRIVES

VT ROUTE 104

LEGEND

BITUMINOUS PAVEMENT, ITEM 900.675 "SPECIAL PROVISION (HAND-PLACED BITUMINOUS CONCRETE MATERIAL, DRIVES)"

NOTES:

1. PAVING LIFT NOT TO EXCEED 2" (50mm)
2. THE COST OF PLACING SUBBASE MATERIAL, CLEANING EXISTING PAVED SURFACES, INCLUDING POWER EQUIPMENT, AND FOR FILLING JOINTS, CRACKS AND HOLES WILL NOT BE PAID DIRECTLY BUT WILL BE CONSIDERED INCIDENTAL TO ITEM 900.675 "SPECIAL PROVISION (HAND-PLACED BITUMINOUS CONCRETE MATERIAL, DRIVES)".
3. EXCAVATION OR FILL NEEDED TO ACHIEVE PROPER DRIVE SLOPES WILL NOT BE PAID DIRECTLY BUT WILL BE CONSIDERED INCIDENTAL TO ITEM 900.675 "SPECIAL PROVISION (HAND-PLACED BITUMINOUS CONCRETE MATERIAL, DRIVES)".

NOT TO SCALE

**HANDWORK
DETAILS FOR
DRIVES**

PROJECT NAME: CAMBRIDGE-FAIRFAX

PROJECT NUMBER: STP 2713(I)

FILE NAME: p07B182.dgn

PROJECT LEADER: CDL

DESIGNED BY: SJL

PLOT FILE: p07B182_I0.I

PLOT DATE: 29-DEC-2014 13:45

DRAWN BY: SJL

CHECKED BY: EPD

SHEET 10 OF 36