


REMOVAL AND DISPOSAL OF GUARDRAIL
 STA. 57+75 - STA. 58+80 LT
 STA. 63+12.5 - STA. 66+00 RT

STEEL BEAM GUARDRAIL, GALVANIZED
 STA. 63+50 - STA. 65+62.5 RT

STEEL BEAM GUARDRAIL, GALVANIZED W/8 FEET POSTS
 STA. 57+75 - STA. 58+42.5 LT

MANUFACTURED TERMINAL SECTION, FLARED
 STA. 58+42.5 - STA. 58+80 LT
 STA. 63+12.5 - STA. 63+50 RT
 STA. 65+62.5 - STA. 66+00 RT

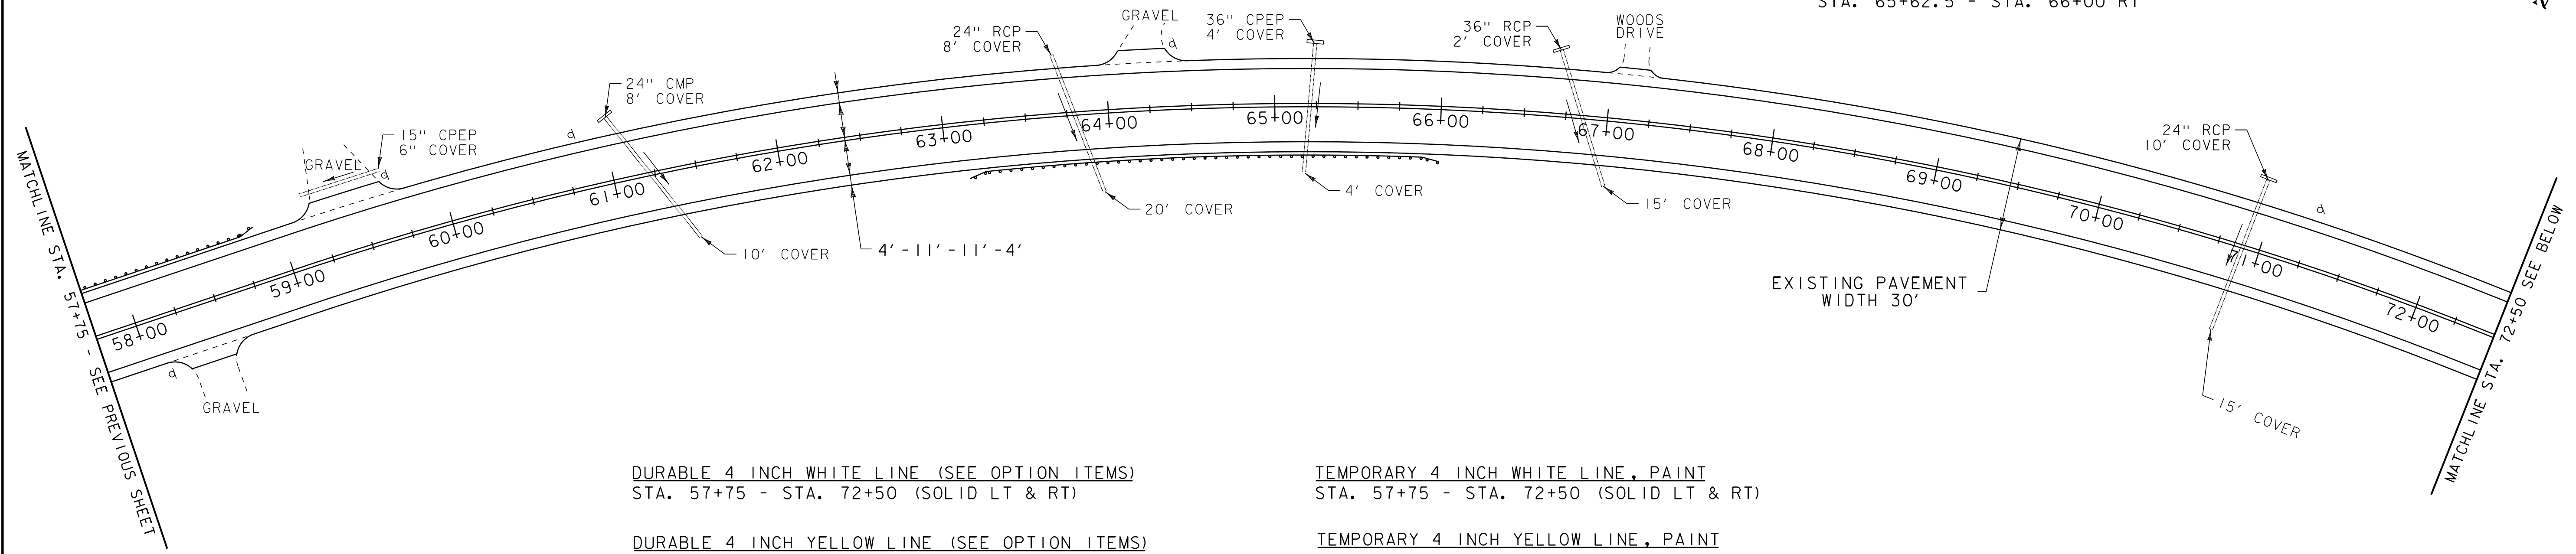

DURABLE 4 INCH WHITE LINE (SEE OPTION ITEMS)
 STA. 57+75 - STA. 72+50 (SOLID LT & RT)

TEMPORARY 4 INCH WHITE LINE, PAINT
 STA. 57+75 - STA. 72+50 (SOLID LT & RT)

DURABLE 4 INCH YELLOW LINE (SEE OPTION ITEMS)
 STA. 57+75 - STA. 72+50 (SOLID LT & RT, CENTERLINE)


TEMPORARY 4 INCH YELLOW LINE, PAINT
 STA. 57+75 - STA. 72+50 (SOLID LT & RT, CENTERLINE)

DURABLE 4 INCH WHITE LINE (SEE OPTION ITEMS)
 STA. 72+50 - STA. 87+50 (SOLID LT & RT)

TEMPORARY 4 INCH WHITE LINE, PAINT
 STA. 72+50 - STA. 87+50 (SOLID LT & RT)

DURABLE 4 INCH YELLOW LINE (SEE OPTION ITEMS)
 STA. 72+50 - STA. 72+86 (SOLID LT & RT, CENTERLINE)
 STA. 72+86 - STA. 80+00 (SOLID LT, DASHED RT, CENTERLINE)
 STA. 80+00 - STA. 85+53 (DASHED, CENTERLINE)
 STA. 85+53 - STA. 87+50 (DASHED LT, SOLID RT, CENTERLINE)

TEMPORARY 4 INCH YELLOW LINE, PAINT
 STA. 72+50 - STA. 72+86 (SOLID LT & RT, CENTERLINE)
 STA. 72+86 - STA. 80+00 (SOLID LT, DASHED RT, CENTERLINE)
 STA. 80+00 - STA. 85+53 (DASHED, CENTERLINE)
 STA. 85+53 - STA. 87+50 (DASHED LT, SOLID RT, CENTERLINE)

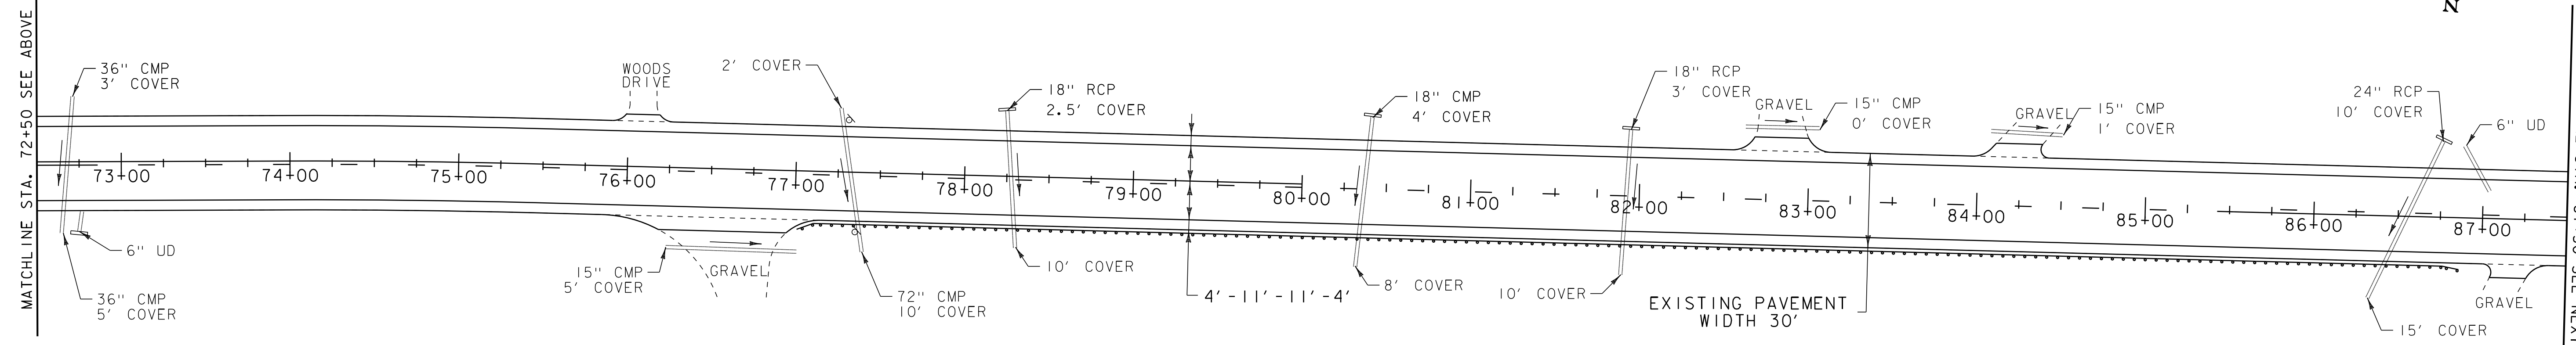

STEEL BEAM GUARDRAIL, GALVANIZED W/8 FEET POSTS
 STA. 77+38.5 - STA. 86+51 RT

MANUFACTURED TERMINAL SECTION, FLARED
 STA. 77+01 - STA. 77+38.5 RT
 STA. 86+51 - STA. 86+88.5 RT

REMOVAL AND DISPOSAL OF GUARDRAIL
 STA. 77+01 - STA. 86+88.5 RT

DATUM	
VERTICAL	N/A
HORIZONTAL	N/A

- LEGEND**
- MAILBOX
 - UTILITY POLE
 - HYDRANT
 - MANHOLE
 - WATER VALVE
 - CATCH BASIN / DROP INLET
 - SIGN

NOT TO SCALE

PROJECT LAYOUT SHEET 3

PROJECT NAME: CAMBRIDGE - FAIRFAX

PROJECT NUMBER: STP 2713(I)

FILE NAME: p07B182.dgn

PROJECT LEADER: CDL

DESIGNED BY: SJL

PLOT FILE: p07B182.21.i

PLOT DATE: 29-DEC-2014 13:46

DRAWN BY: SJL

CHECKED BY: EPD

SHEET 21 OF 36