

STEEL BEAM GUARDRAIL, GALVANIZED W/8 FEET POSTS
 STA. 22+09.5 - STA. 24+34.5 RT
 STA. 22+50.5 - STA. 26+13 LT

DURABLE 4 INCH WHITE LINE (SEE OPTION ITEMS)
 STA. 13+50 - STA. 28+25 (SOLID LT & RT)


TEMPORARY 4 INCH WHITE LINE, PAINT
 STA. 13+50 - STA. 28+25 (SOLID LT & RT)

MANUFACTURED TERMINAL SECTION, FLARED ANCHOR FOR STEEL BEAM G.R.
 STA. 21+72 - STA. 22+09.5 RT
 STA. 22+13 - STA. 22+50.5 LT
~~STA. 24+34.5 - STA. 24+72 RT~~
 STA. 26+13 - STA. 26+50.5 LT

DURABLE 4 INCH YELLOW LINE (SEE OPTION ITEMS)
 STA. 13+50 - STA. 20+07 (SOLID LT & RT, CENTERLINE)
 STA. 20+07 - STA. 28+25 (SOLID LT, DASHED RT, CENTERLINE)

TEMPORARY 4 INCH YELLOW LINE, PAINT
 STA. 13+50 - STA. 20+07 (SOLID LT & RT, CENTERLINE)
 STA. 20+07 - STA. 28+25 (SOLID LT, DASHED RT, CENTERLINE)

REMOVAL AND DISPOSAL OF GUARDRAIL
 STA. 21+72 - STA. 24+72 RT
 STA. 22+13 - STA. 26+50.5 LT

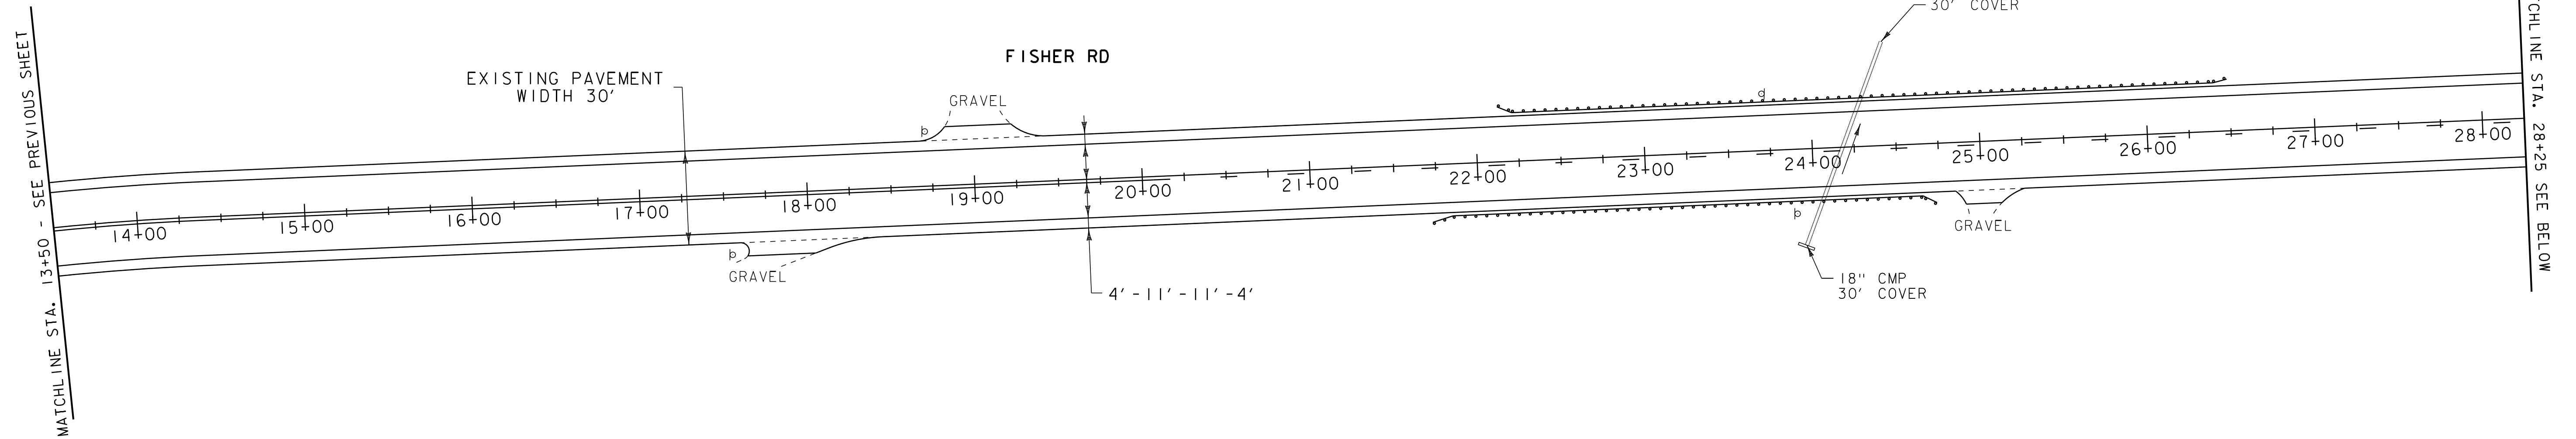

STEEL BEAM GUARDRAIL, GALVANIZED W/8 FEET POSTS
 STA. 30+56 - STA. 30+81 RT
 STA. 30+56 - STA. 30+81 LT
 STA. 32+18.5 - STA. 34+31 RT
 STA. 32+18.5 - STA. 33+06 LT

HD STEEL BEAM GUARDRAIL, GALVANIZED W/8 FEET POSTS
 STA. 30+81 - STA. 31+06 RT
 STA. 30+81 - STA. 31+06 LT
 STA. 31+93.5 - STA. 32+18.5 LT
 STA. 31+93.5 - STA. 32+18.5 RT

NOTE:
 EXTENDED 15' ON EACH CORNER

DURABLE 4 INCH WHITE LINE (SEE OPTION ITEMS)
 STA. 28+25 - STA. 42+75 (SOLID LT & RT)

TEMPORARY 4 INCH WHITE LINE, PAINT
 STA. 28+25 - STA. 42+75 (SOLID LT & RT)


MANUFACTURED TERMINAL SECTION, FLARED
 STA. 30+18.5 - STA. 30+56 RT
 STA. 30+18.5 - STA. 30+56 LT
 STA. 33+06 - STA. 33+43.5 LT
 STA. 34+31 - STA. 34+68.5 RT

REMOVAL AND DISPOSAL OF GUARDRAIL
 STA. 30+18.5 - STA. 31+06 LT & RT
 STA. 31+93.5 - STA. 34+68.5 RT
 STA. 31+93.5 - STA. 33+43.5 LT

DURABLE 4 INCH YELLOW LINE (SEE OPTION ITEMS)
 STA. 28+25 - STA. 42+75 (DASHED, CENTERLINE)

TEMPORARY 4 INCH YELLOW LINE, PAINT
 STA. 28+25 - STA. 42+75 (DASHED, CENTERLINE)

REMOVAL OF EXISTING RAILING
 STA. 31+06 - STA. 31+93.5 LT & RT
 BRIDGE RAILING REPAIR, TYPE II
 STA. 31+06 - STA. 31+93.5 LT & RT

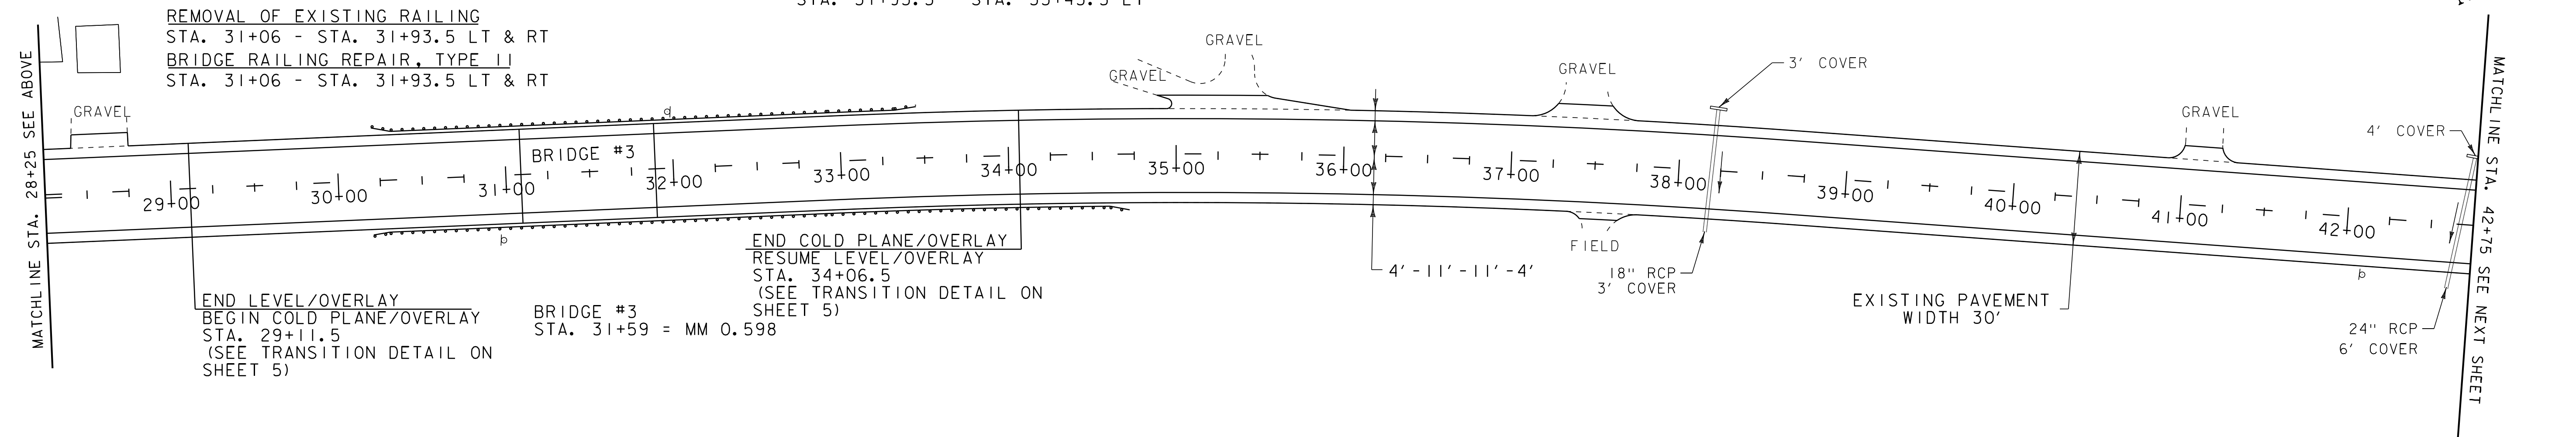

END LEVEL/OVERLAY
 BEGIN COLD PLANE/OVERLAY
 STA. 29+11.5
 (SEE TRANSITION DETAIL ON SHEET 5)

BRIDGE #3
 STA. 31+59 = MM 0.598

END COLD PLANE/OVERLAY
 RESUME LEVEL/OVERLAY
 STA. 34+06.5
 (SEE TRANSITION DETAIL ON SHEET 5)

- LEGEND
- MAILBOX
 - UTILITY POLE
 - HYDRANT
 - MANHOLE
 - WATER VALVE
 - CATCH BASIN / DROP INLET
 - SIGN

DATUM
 VERTICAL N/A
 HORIZONTAL N/A

PROJECT LAYOUT SHEET 5	PROJECT NAME: CAMBRIDGE - FAIRFAX
	PROJECT NUMBER: STP 2713(I)
	FILE NAME: p07B182.dgn
	PLOT DATE: 29-DEC-2014 13:46
	PROJECT LEADER: CDL
	DESIGNED BY: SJL
	PLOT FILE: p07B182_23.i
	DRAWN BY: SJL
	CHECKED BY: EPD
	SHEET 23 OF 36

NOT TO SCALE