


DURABLE 4 INCH WHITE LINE (SEE OPTION ITEMS)
 STA. 100+75 - STA. 115+50 (SOLID LT & RT)

TEMPORARY 4 INCH WHITE LINE, PAINT
 STA. 100+75 - STA. 115+50 (SOLID LT & RT)

DURABLE 4 INCH YELLOW LINE (SEE OPTION ITEMS)
 STA. 100+75 - STA. 102+96 (SOLID LT & RT, CENTERLINE)
 STA. 102+96 - STA. 110+88 (SOLID LT, DASHED RT, CENTERLINE)
 STA. 110+88 - STA. 115+10 (DASHED, CENTERLINE)
 STA. 115+10 - STA. 115+50 (DASHED LT, SOLID RT, CENTERLINE)

TEMPORARY 4 INCH YELLOW LINE, PAINT
 STA. 100+75 - STA. 102+96 (SOLID LT & RT, CENTERLINE)
 STA. 102+96 - STA. 110+88 (SOLID LT, DASHED RT, CENTERLINE)
 STA. 110+88 - STA. 115+10 (DASHED, CENTERLINE)
 STA. 115+10 - STA. 115+50 (DASHED LT, SOLID RT, CENTERLINE)

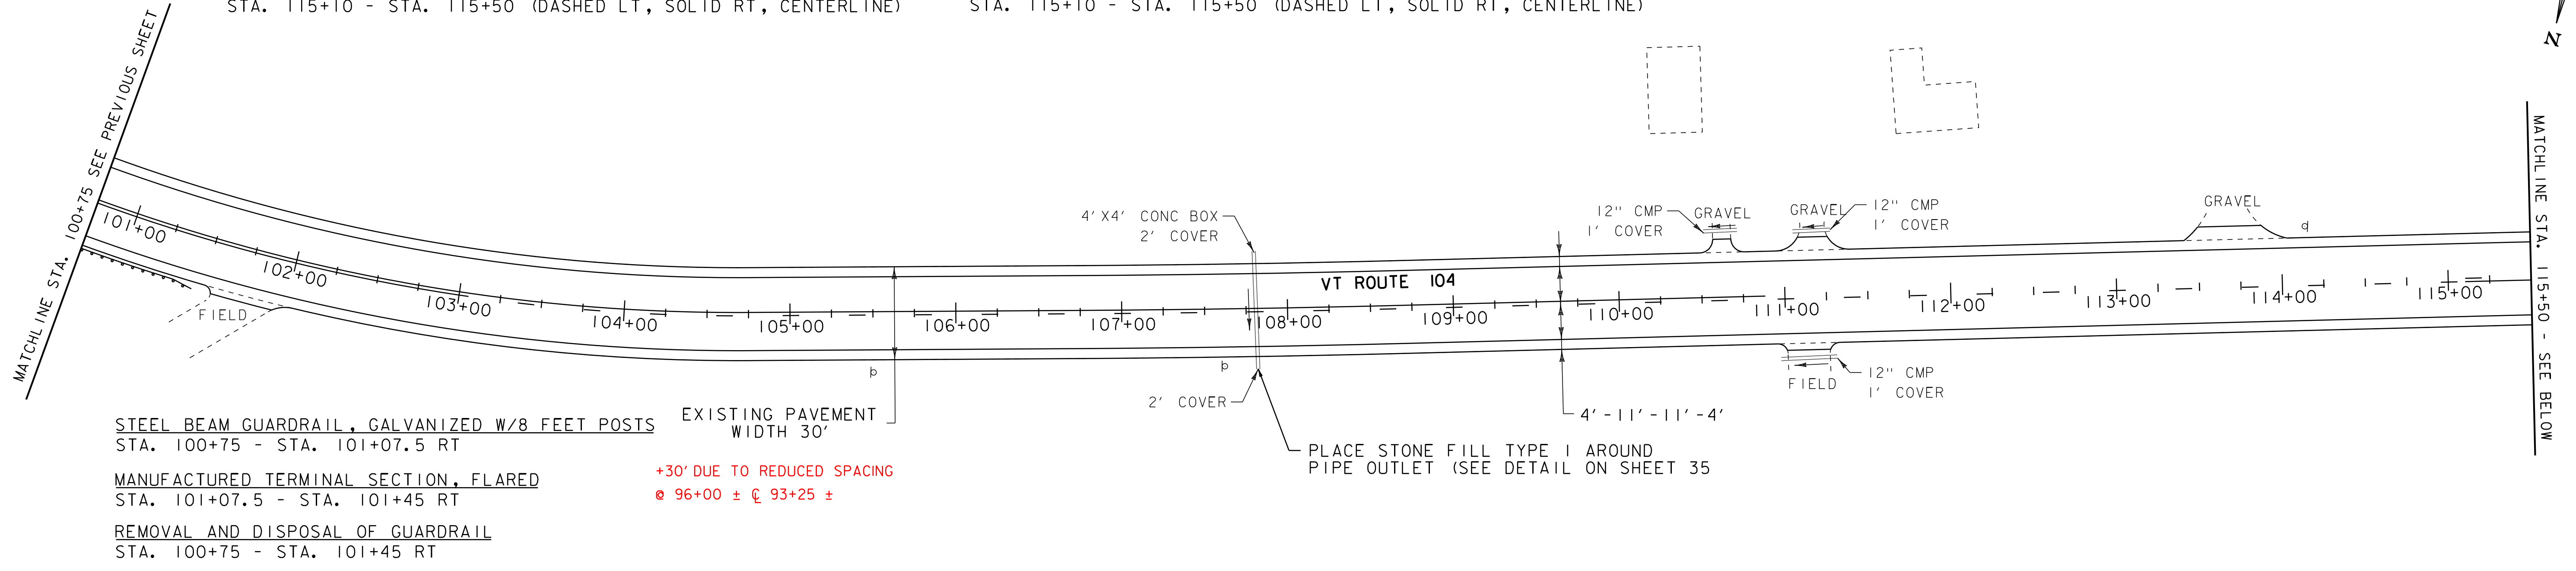

STEEL BEAM GUARDRAIL, GALVANIZED W/8 FEET POSTS
 STA. 100+75 - STA. 101+07.5 RT

MANUFACTURED TERMINAL SECTION, FLARED
 STA. 101+07.5 - STA. 101+45 RT

REMOVAL AND DISPOSAL OF GUARDRAIL
 STA. 100+75 - STA. 101+45 RT

EXISTING PAVEMENT
 WIDTH 30'

+30' DUE TO REDUCED SPACING
 @ 96+00 ± @ 93+25 ±

DURABLE 24 INCH STOP BAR (SEE OPTION ITEMS)
 STA. 119+20 - STA. 119+60 LT (TH #4)

DURABLE LETTER OR SYMBOL (SEE OPTION ITEMS)
 STA. 119+48 LT "STOP" (TH #4)

TEMPORARY 24 INCH STOP BAR, PAINT
 STA. 119+20 - STA. 119+60 LT (TH #4)


TEMPORARY LETTER OR SYMBOL, PAINT
 STA. 119+48 LT "STOP" (TH #4)

DURABLE 4 INCH WHITE LINE (SEE OPTION ITEMS)
 STA. 115+50 - STA. 130+50 (SOLID LT & RT)
 STA. 119+57 LT (EDGELINES TH #4)

DURABLE 4 INCH YELLOW LINE (SEE OPTION ITEMS)
 STA. 115+50 - STA. 119+45 (DASHED LT, SOLID RT, CENTERLINE)
 (WITH BREAKS AT TOWN ROADS)
 STA. 119+45 - STA. 124+35 (SOLID LT & RT, CENTERLINE)
 (WITH BREAKS AT TOWN ROADS)
 STA. 119+57 LT (CENTERLINE TH #4)
 STA. 124+35 - STA. 130+50 (SOLID LT, DASHED RT, CENTERLINE)

TEMPORARY 4 INCH WHITE LINE, PAINT
 STA. 115+50 - STA. 130+50 (SOLID LT & RT)
 STA. 119+57 LT (EDGELINES TH #4)

TEMPORARY 4 INCH YELLOW LINE, PAINT
 STA. 115+50 - STA. 119+45 (DASHED LT, SOLID RT, CENTERLINE)
 (WITH BREAKS AT TOWN ROADS)
 STA. 119+45 - STA. 124+35 (SOLID LT & RT, CENTERLINE)
 (WITH BREAKS AT TOWN ROADS)
 STA. 119+57 LT (CENTERLINE TH #4)
 STA. 124+35 - STA. 130+50 (SOLID LT, DASHED RT, CENTERLINE)

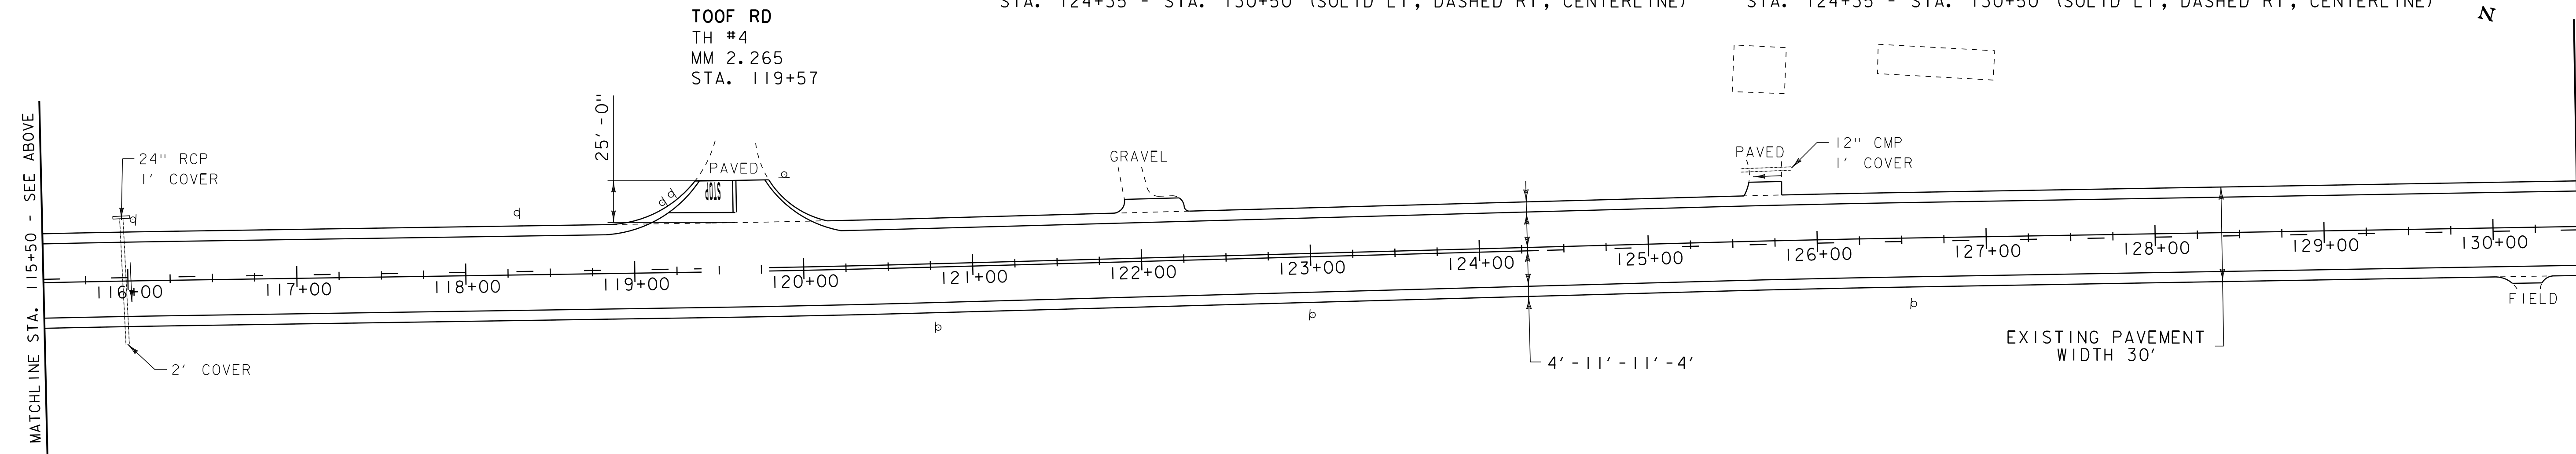

- LEGEND**
- MAILBOX
 - UTILITY POLE
 - HYDRANT
 - MANHOLE
 - WATER VALVE
 - CATCH BASIN / DROP INLET
 - SIGN

DATUM	
VERTICAL	N/A
HORIZONTAL	N/A

NOT TO SCALE

PROJECT LAYOUT SHEET 8	PROJECT NAME: CAMBRIDGE - FAIRFAX
	PROJECT NUMBER: STP 2713(I)
	FILE NAME: p07B182.dgn
	PLOT DATE: 29-DEC-2014 13:46
DESIGNED BY: SJL	DRAWN BY: SJL
PLOT FILE: p07B182_26.i	CHECKED BY: EPD
	SHEET 26 OF 36