


14+25

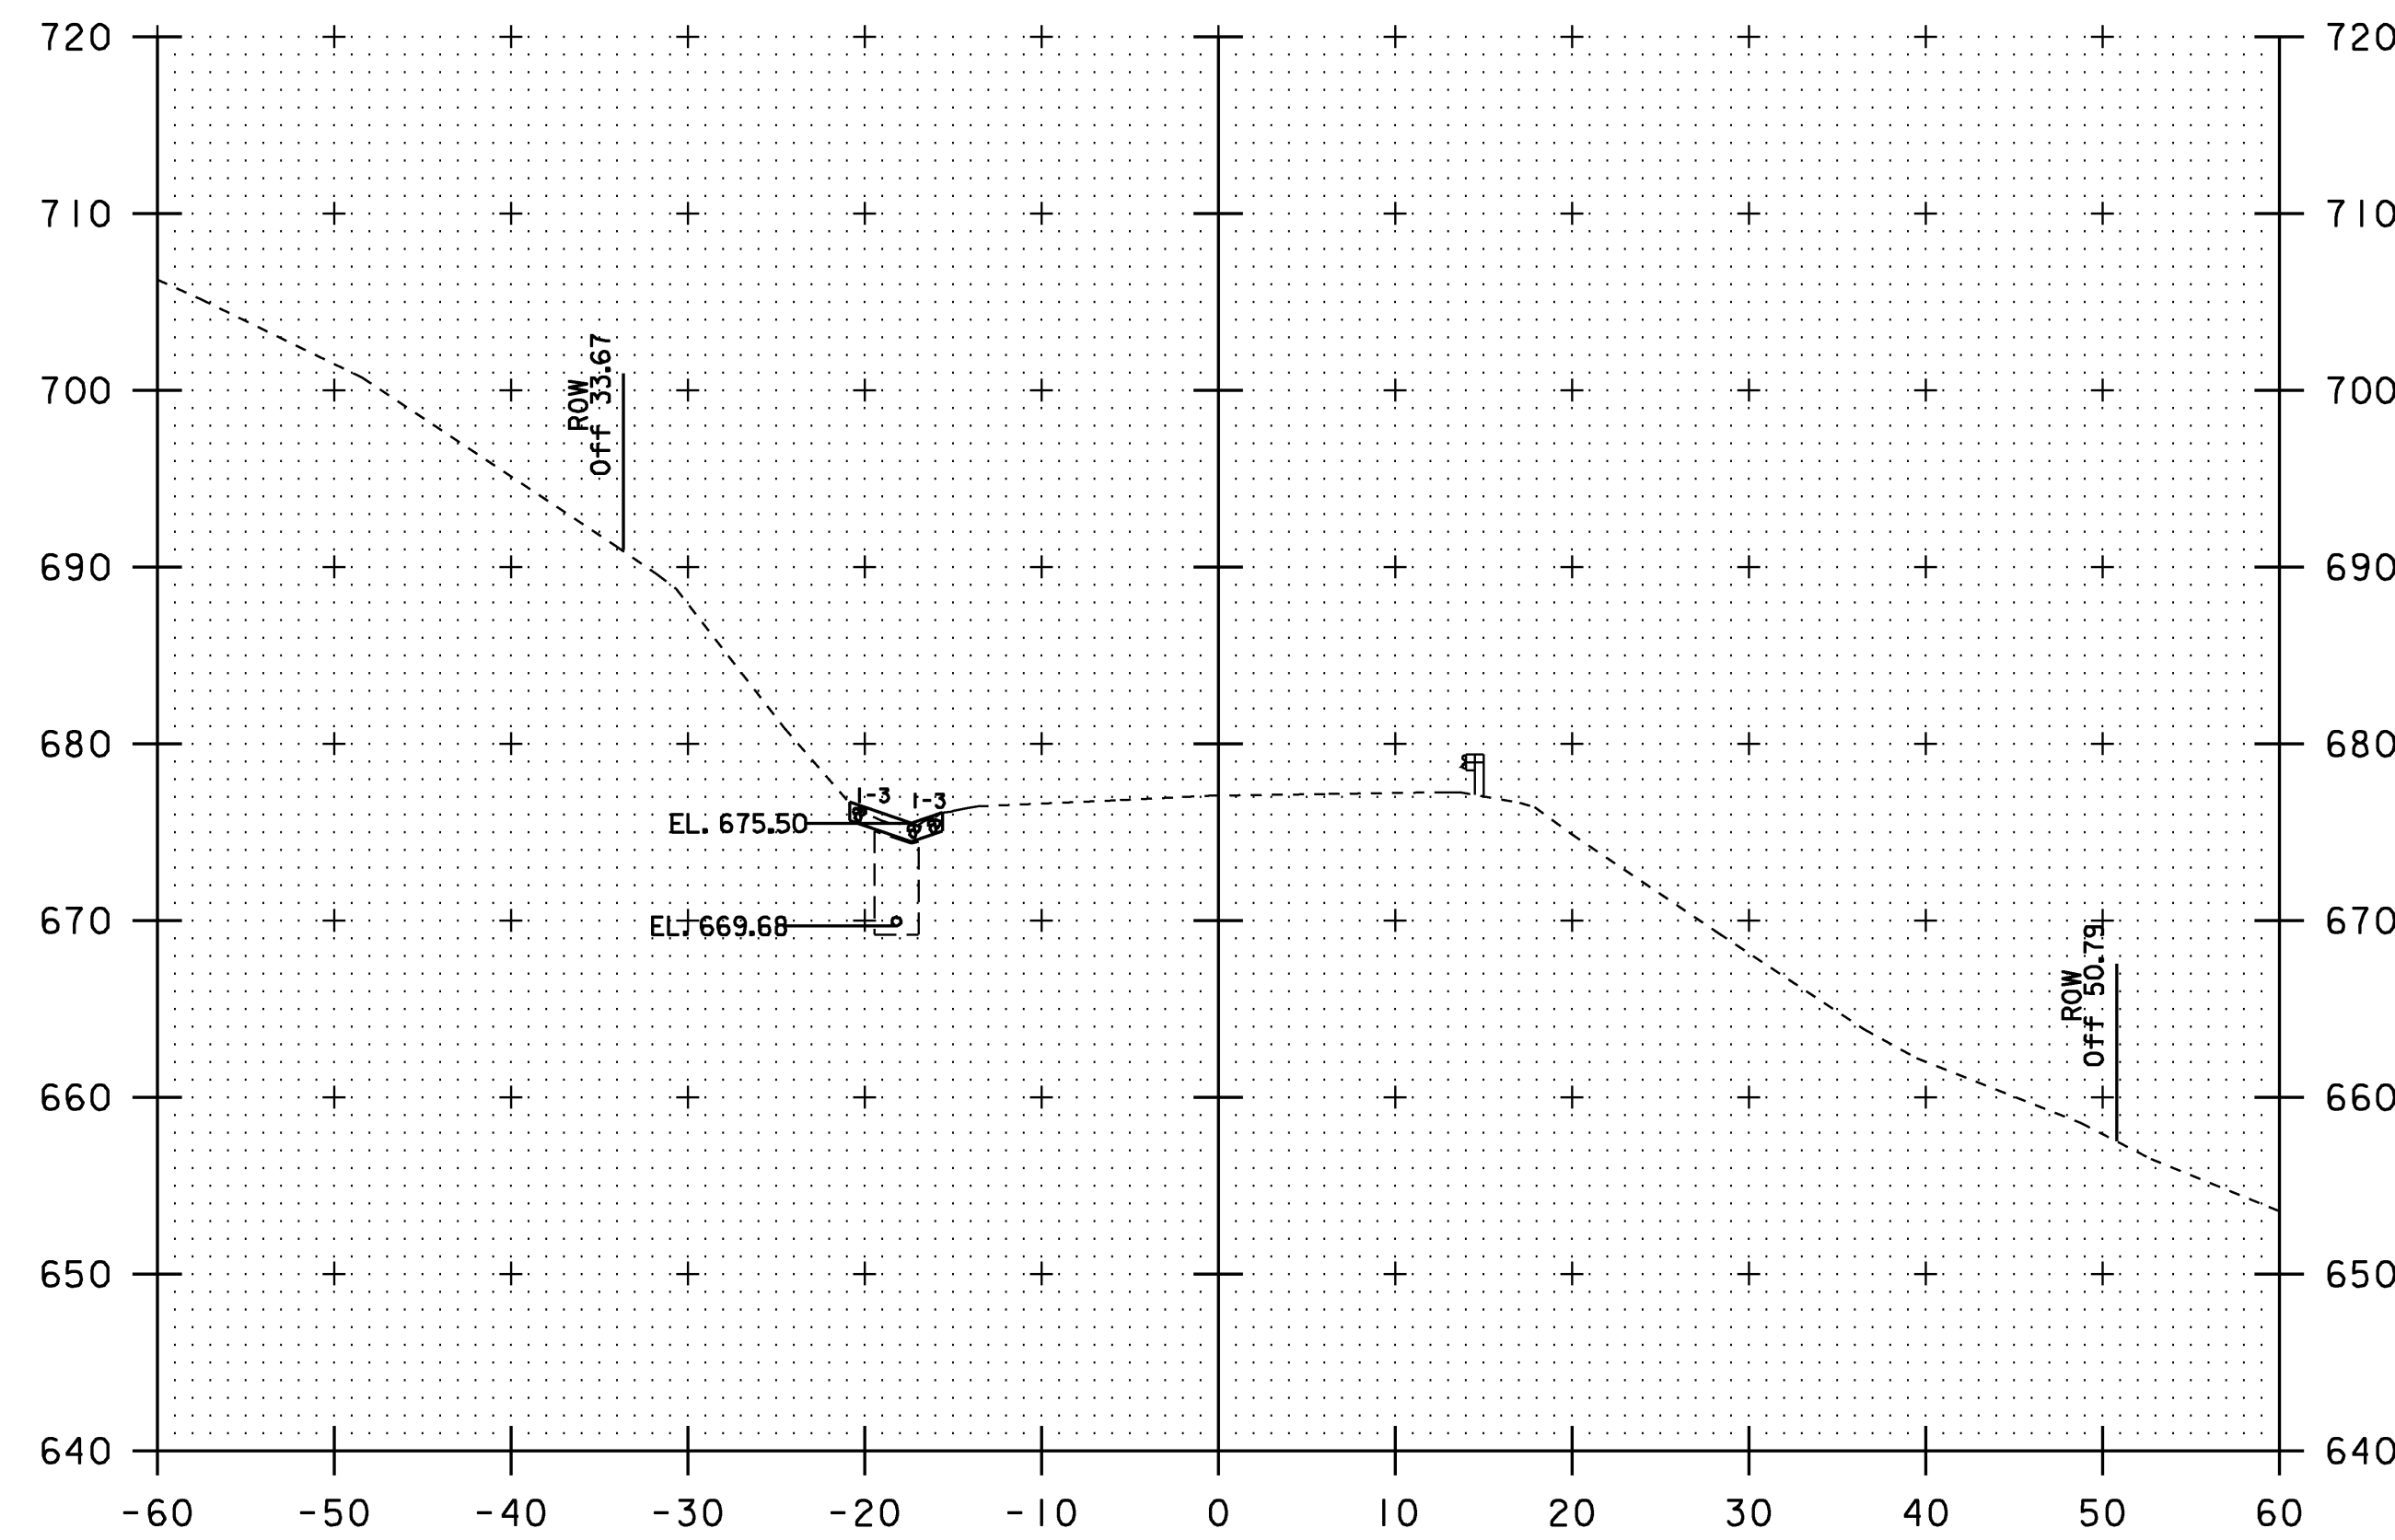

14+50

MAINLINE CROSS SECTIONS 14+25 TO 14+50

PROJECT NAME:	CAMBRIDGE
PROJECT NUMBER:	STP 0235(9)
FILE NAME:	D07C152WRK.DGN
PROJECT LEADER:	K. ROBIE
DESIGNED BY:	N. PAPPAS
IPARM:	d07x152_xs_01
PLOT DATE:	28-JUL-2009
DRAWN BY:	N. PAPPAS
CHECKED BY:	S. MENARD
SHEET	17 OF 28