


14+75

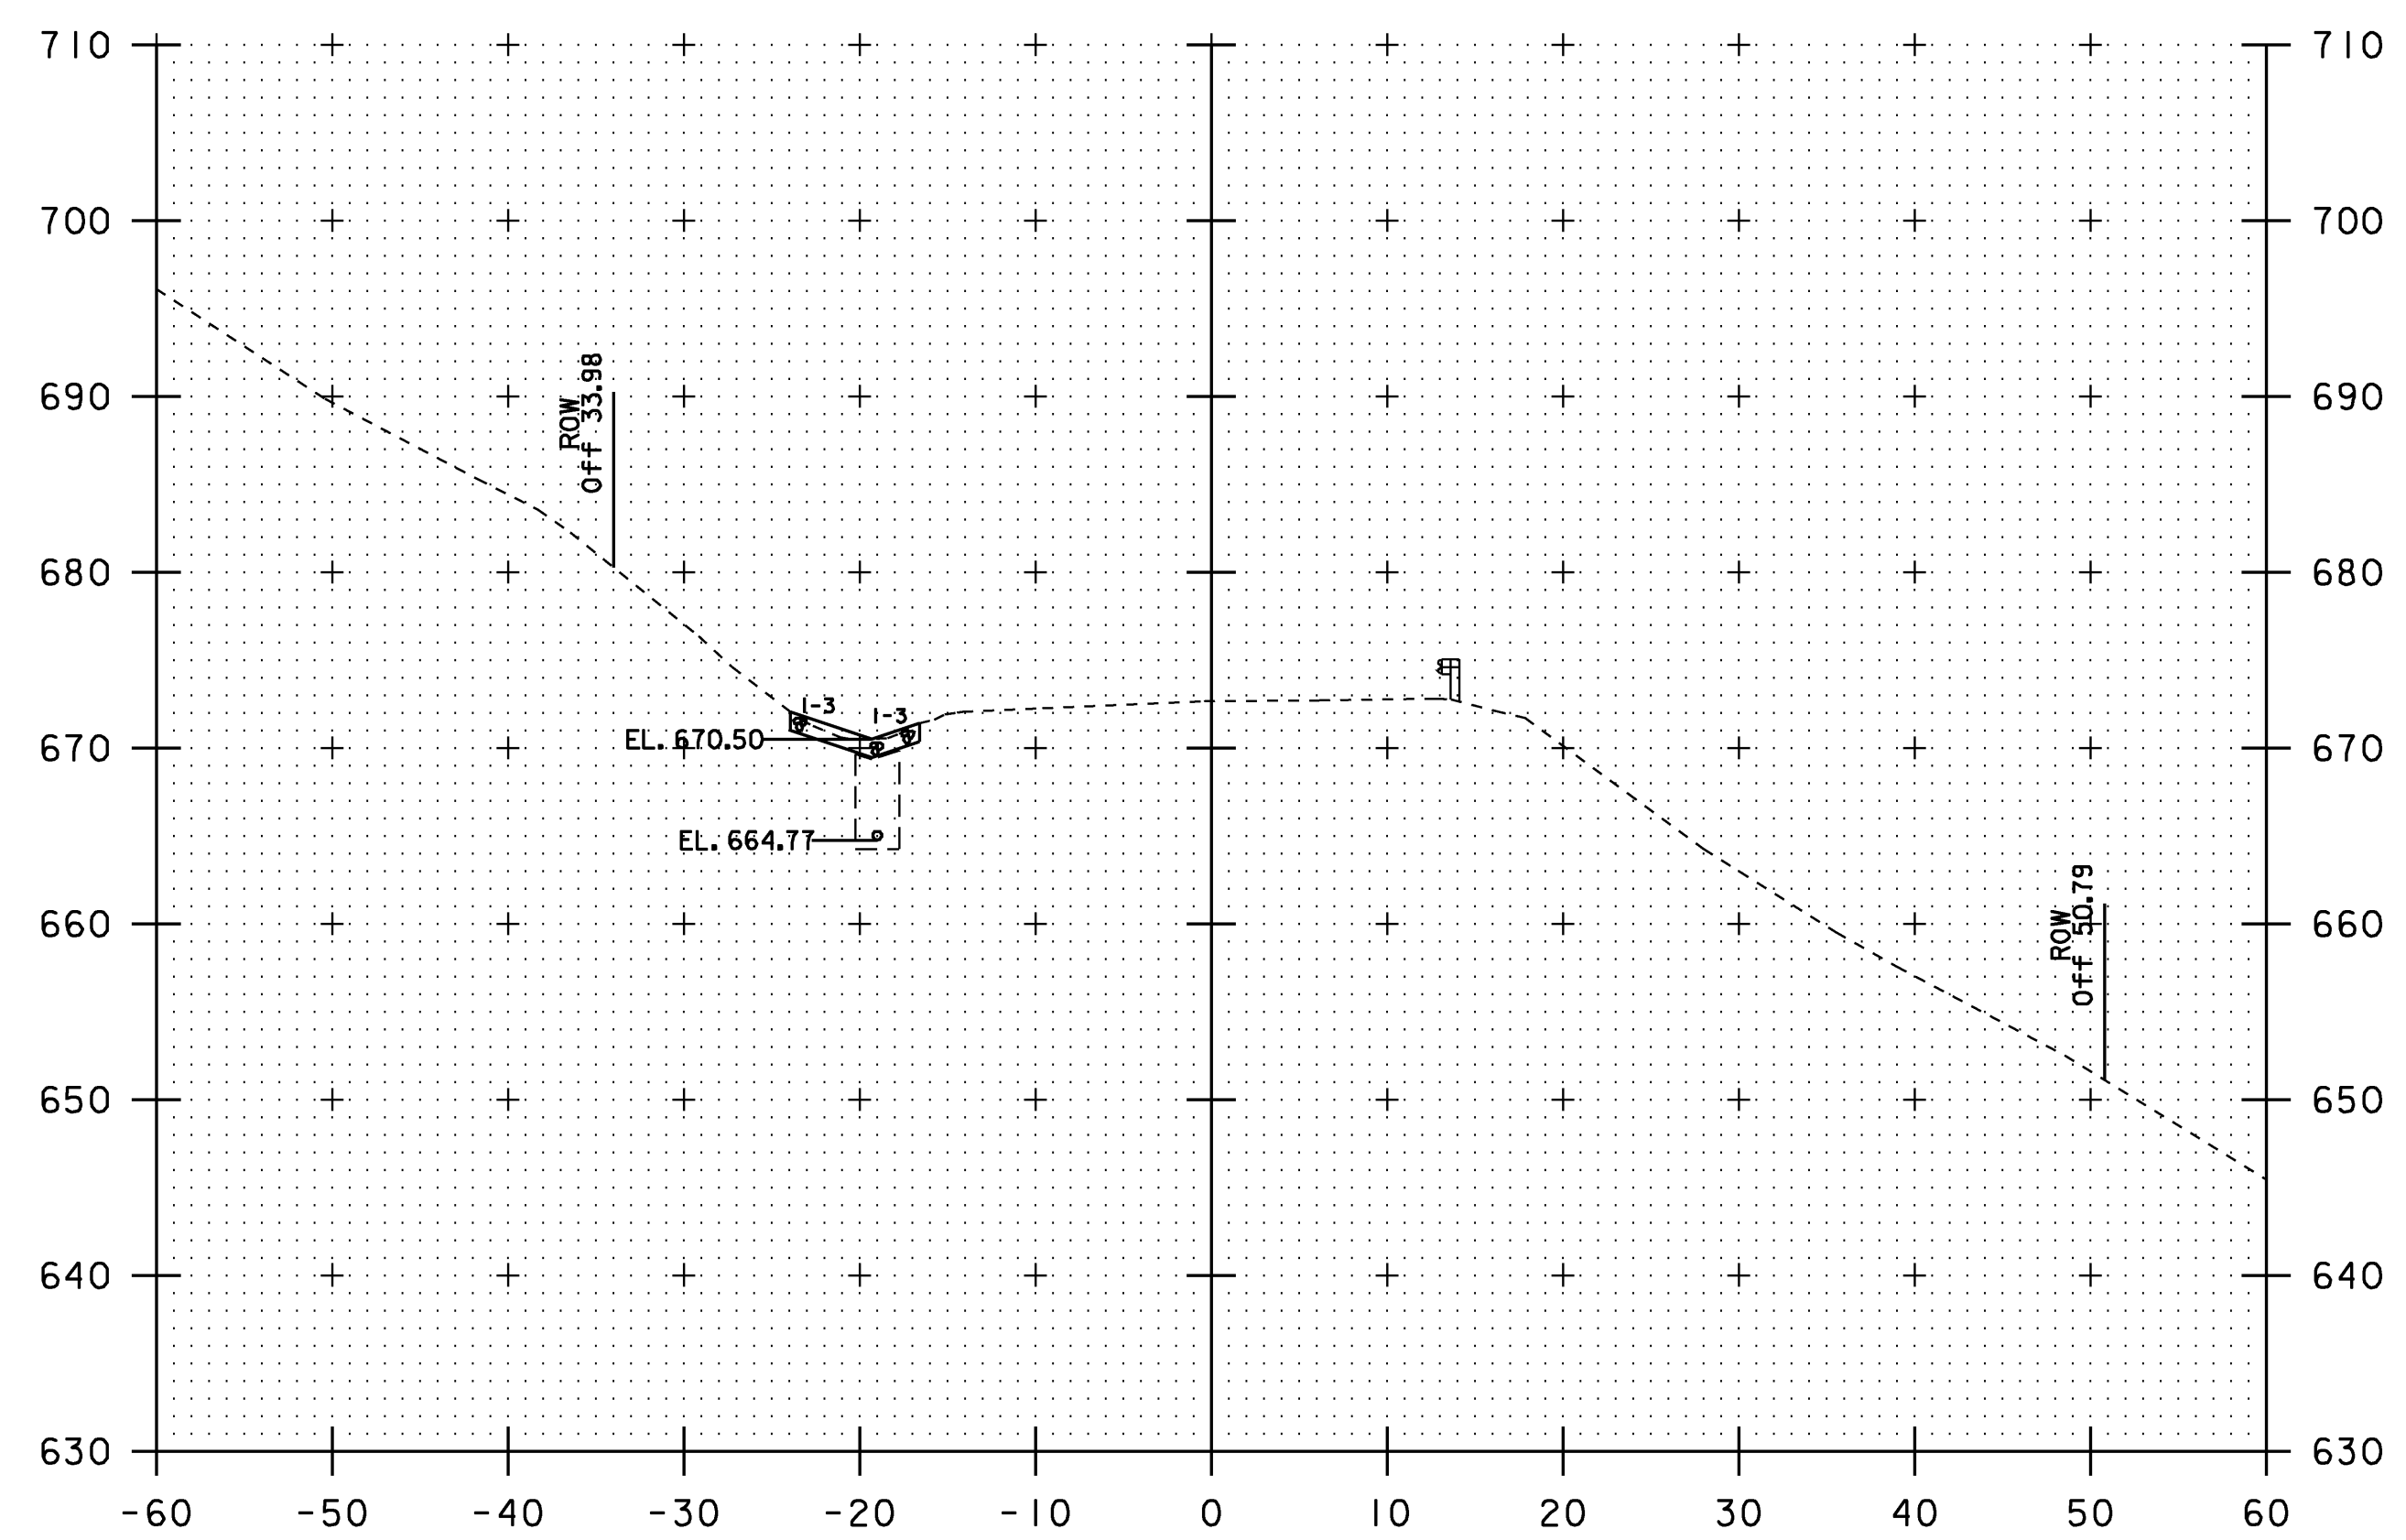

15+00

MAINLINE CROSS SECTIONS 14+75 TO 15+00

PROJECT NAME:	CAMBRIDGE	PLOT DATE:	28-JUL-2009
PROJECT NUMBER:	STP 0235(9)	DRAWN BY:	N. PAPPAS
FILE NAME:	D07C152WRK.DGN	CHECKED BY:	S. MENARD
DESIGNED BY:	N. PAPPAS	SHEET	18 OF 28
IPARM:	d07x152_xs_02		