




15+50

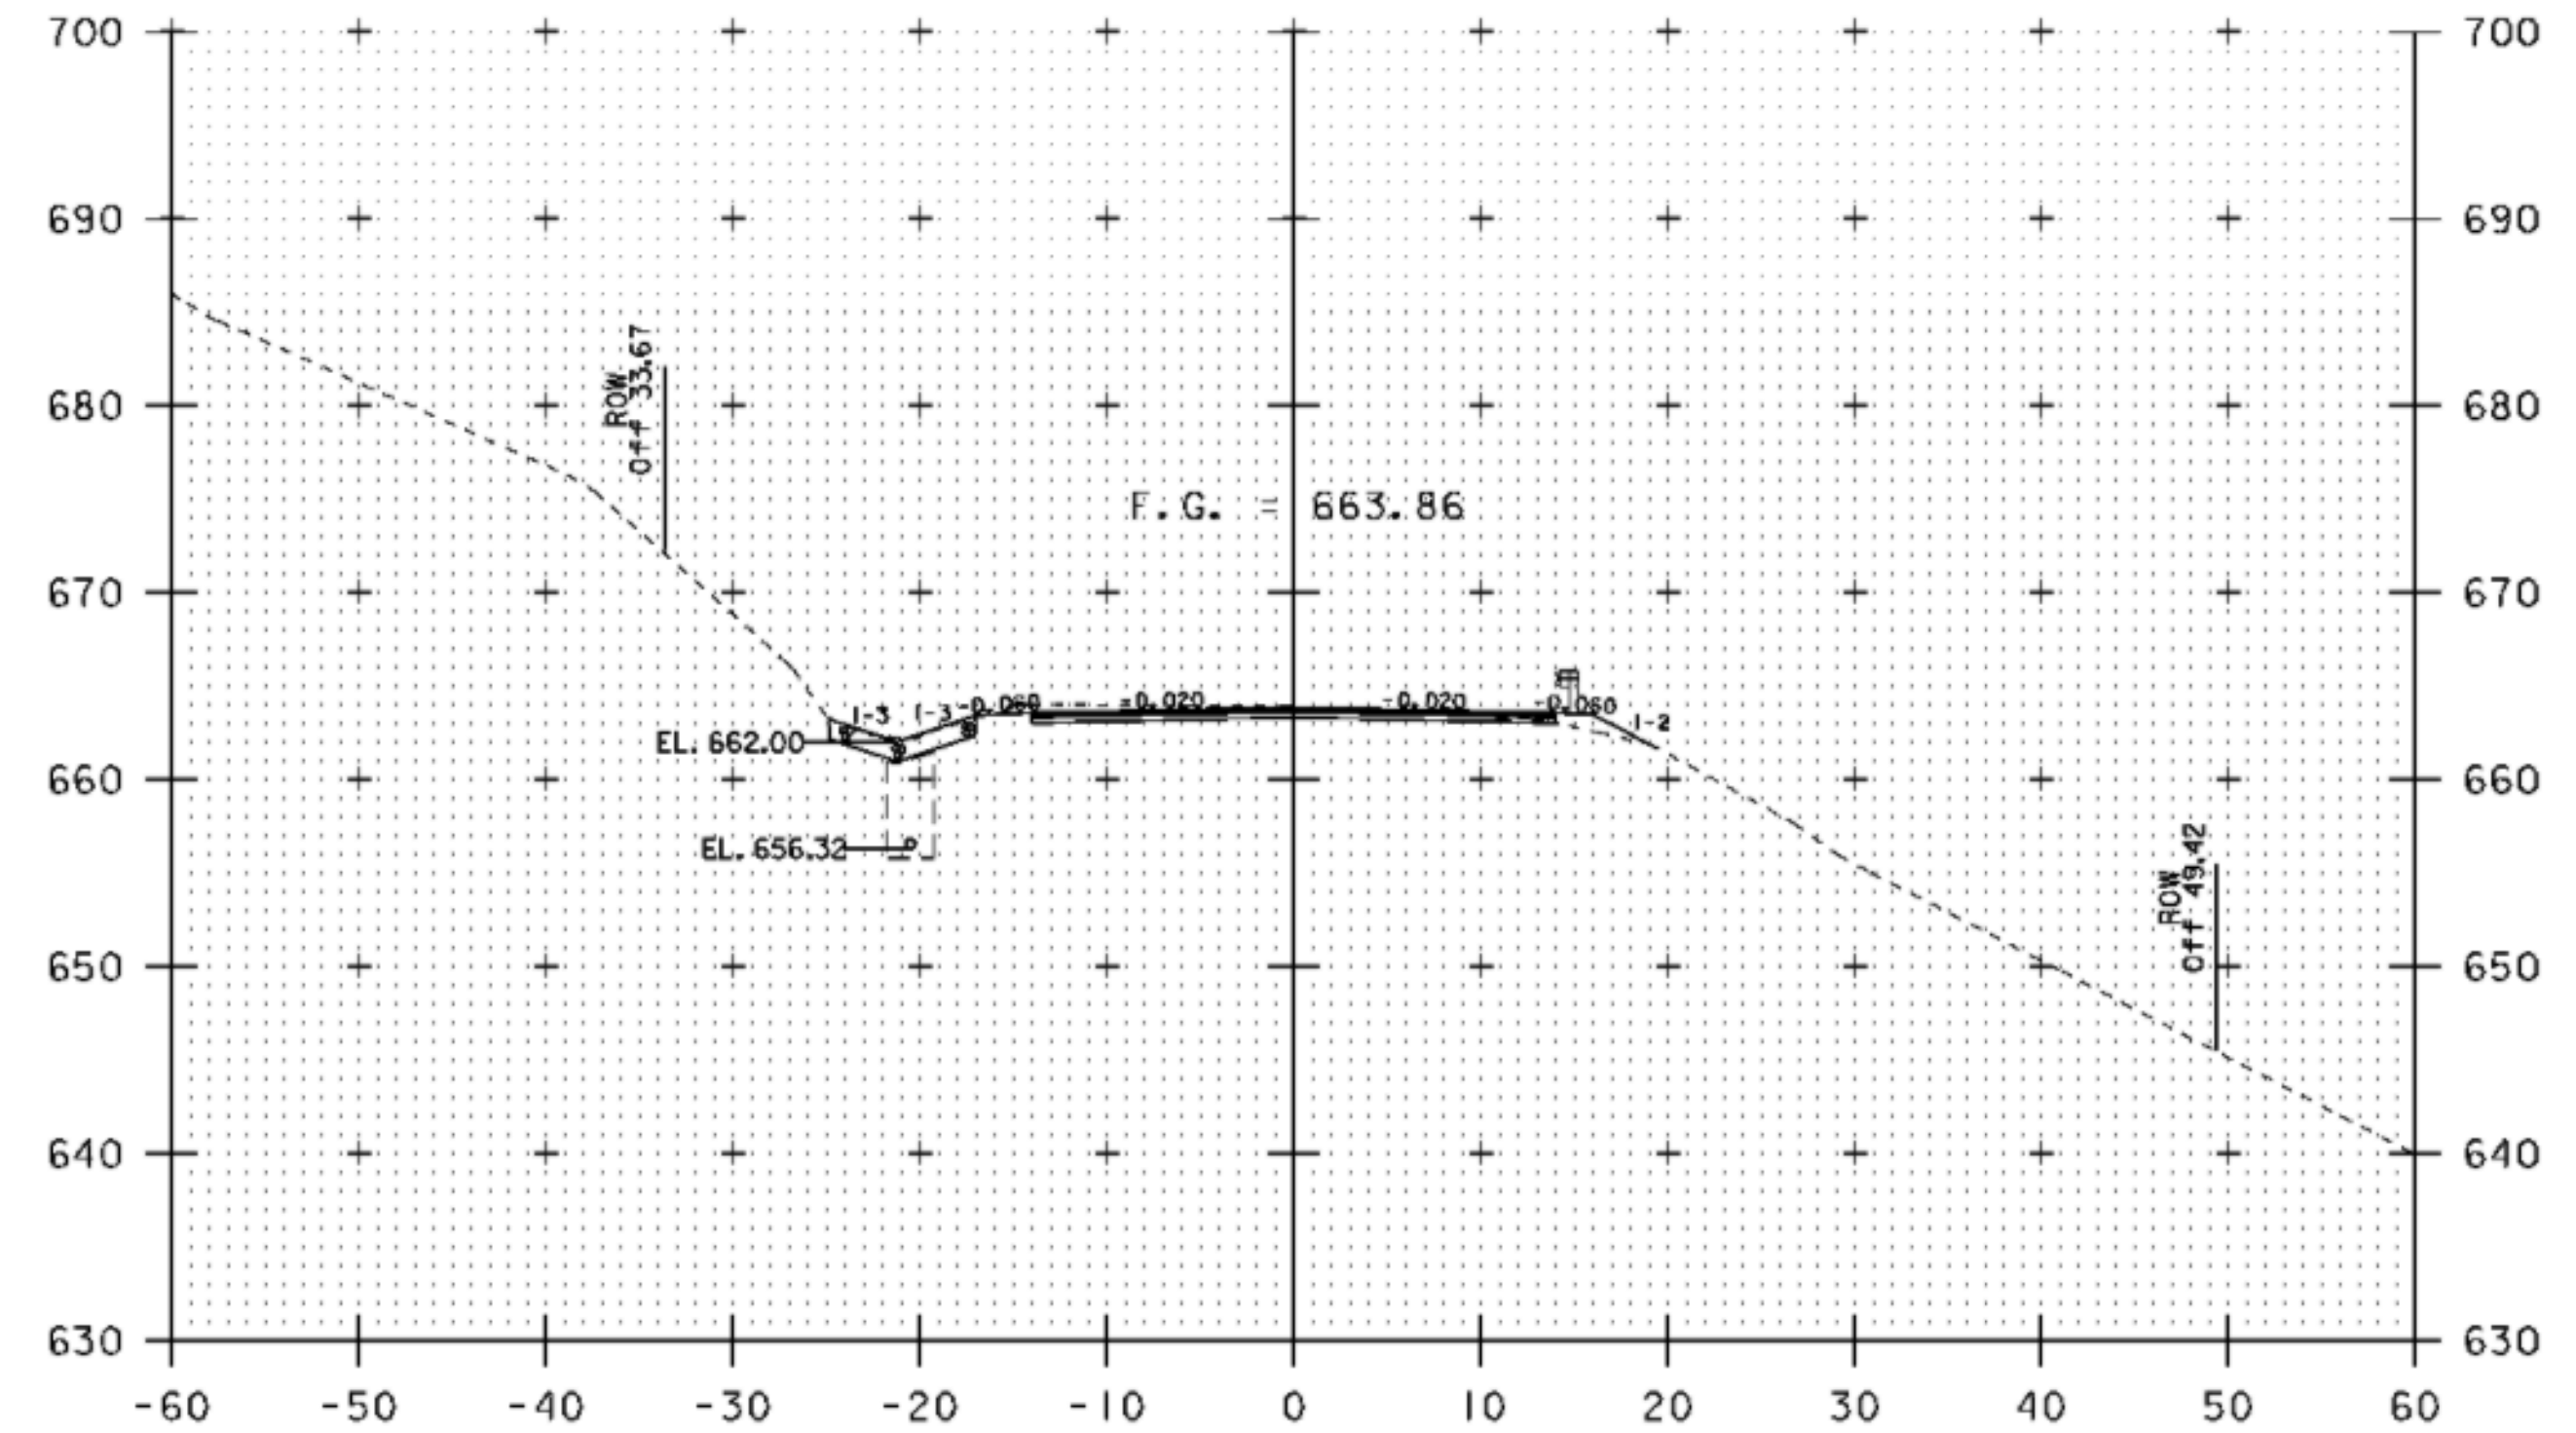

16+00

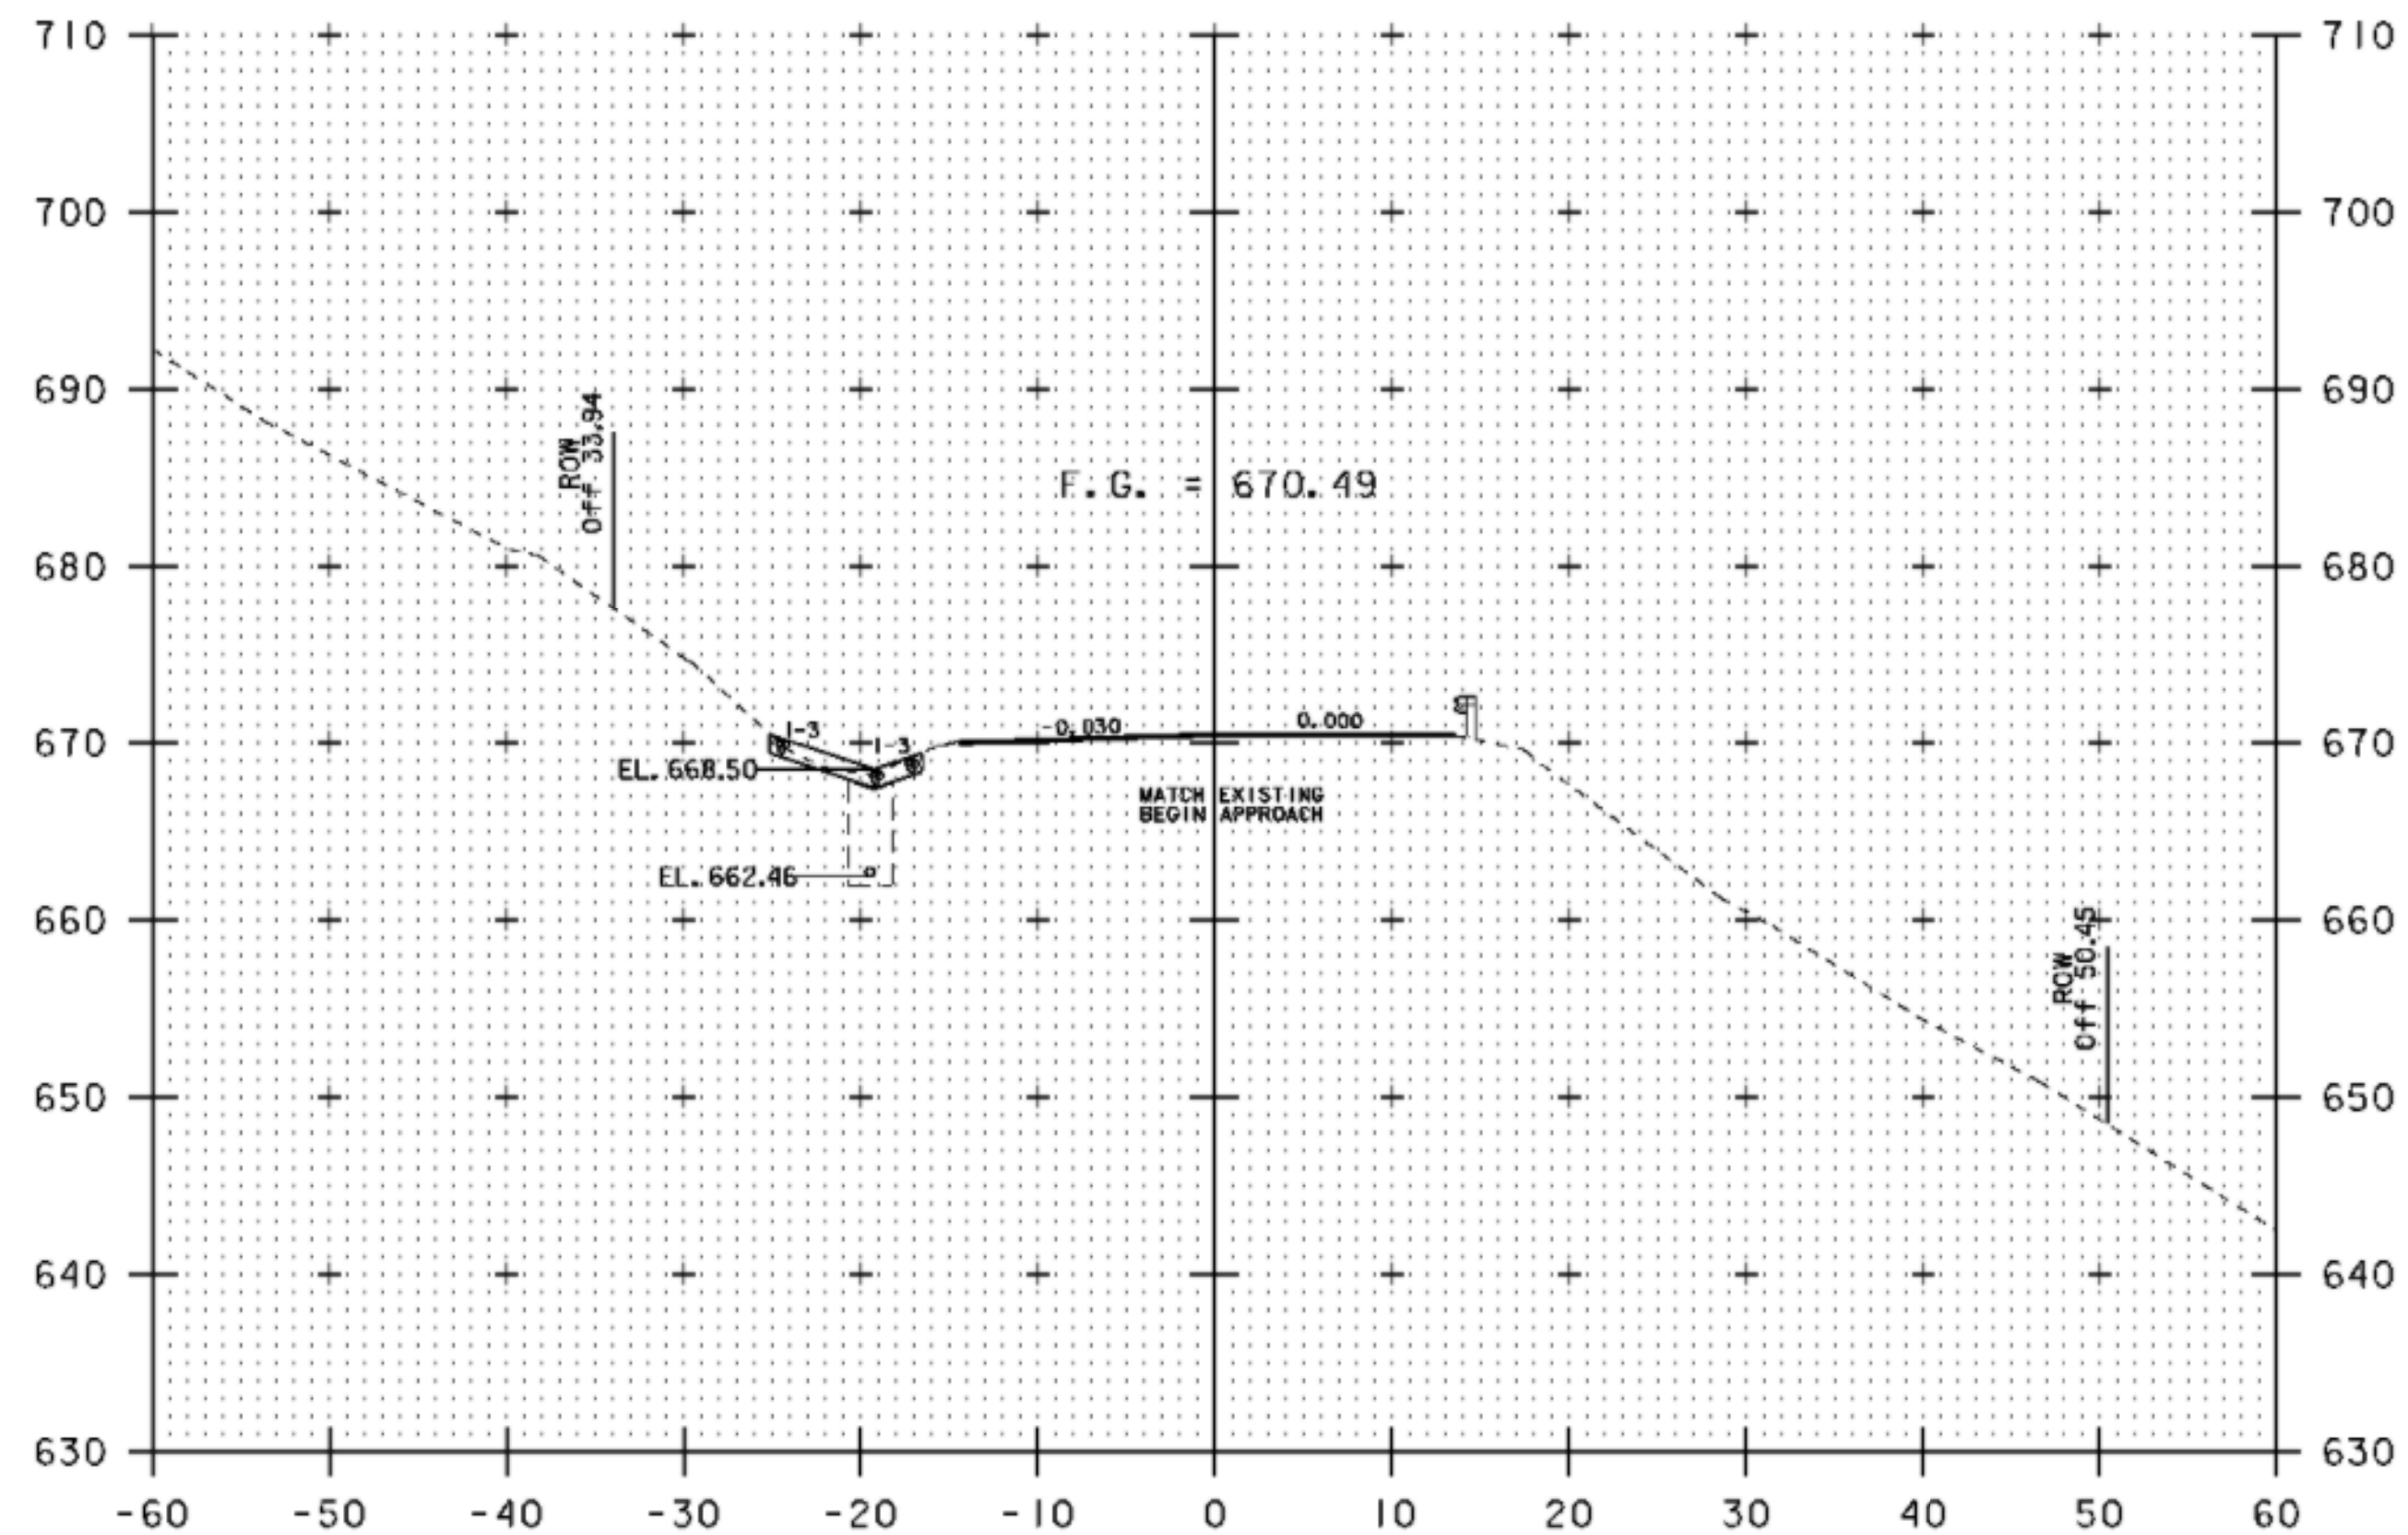

15+25

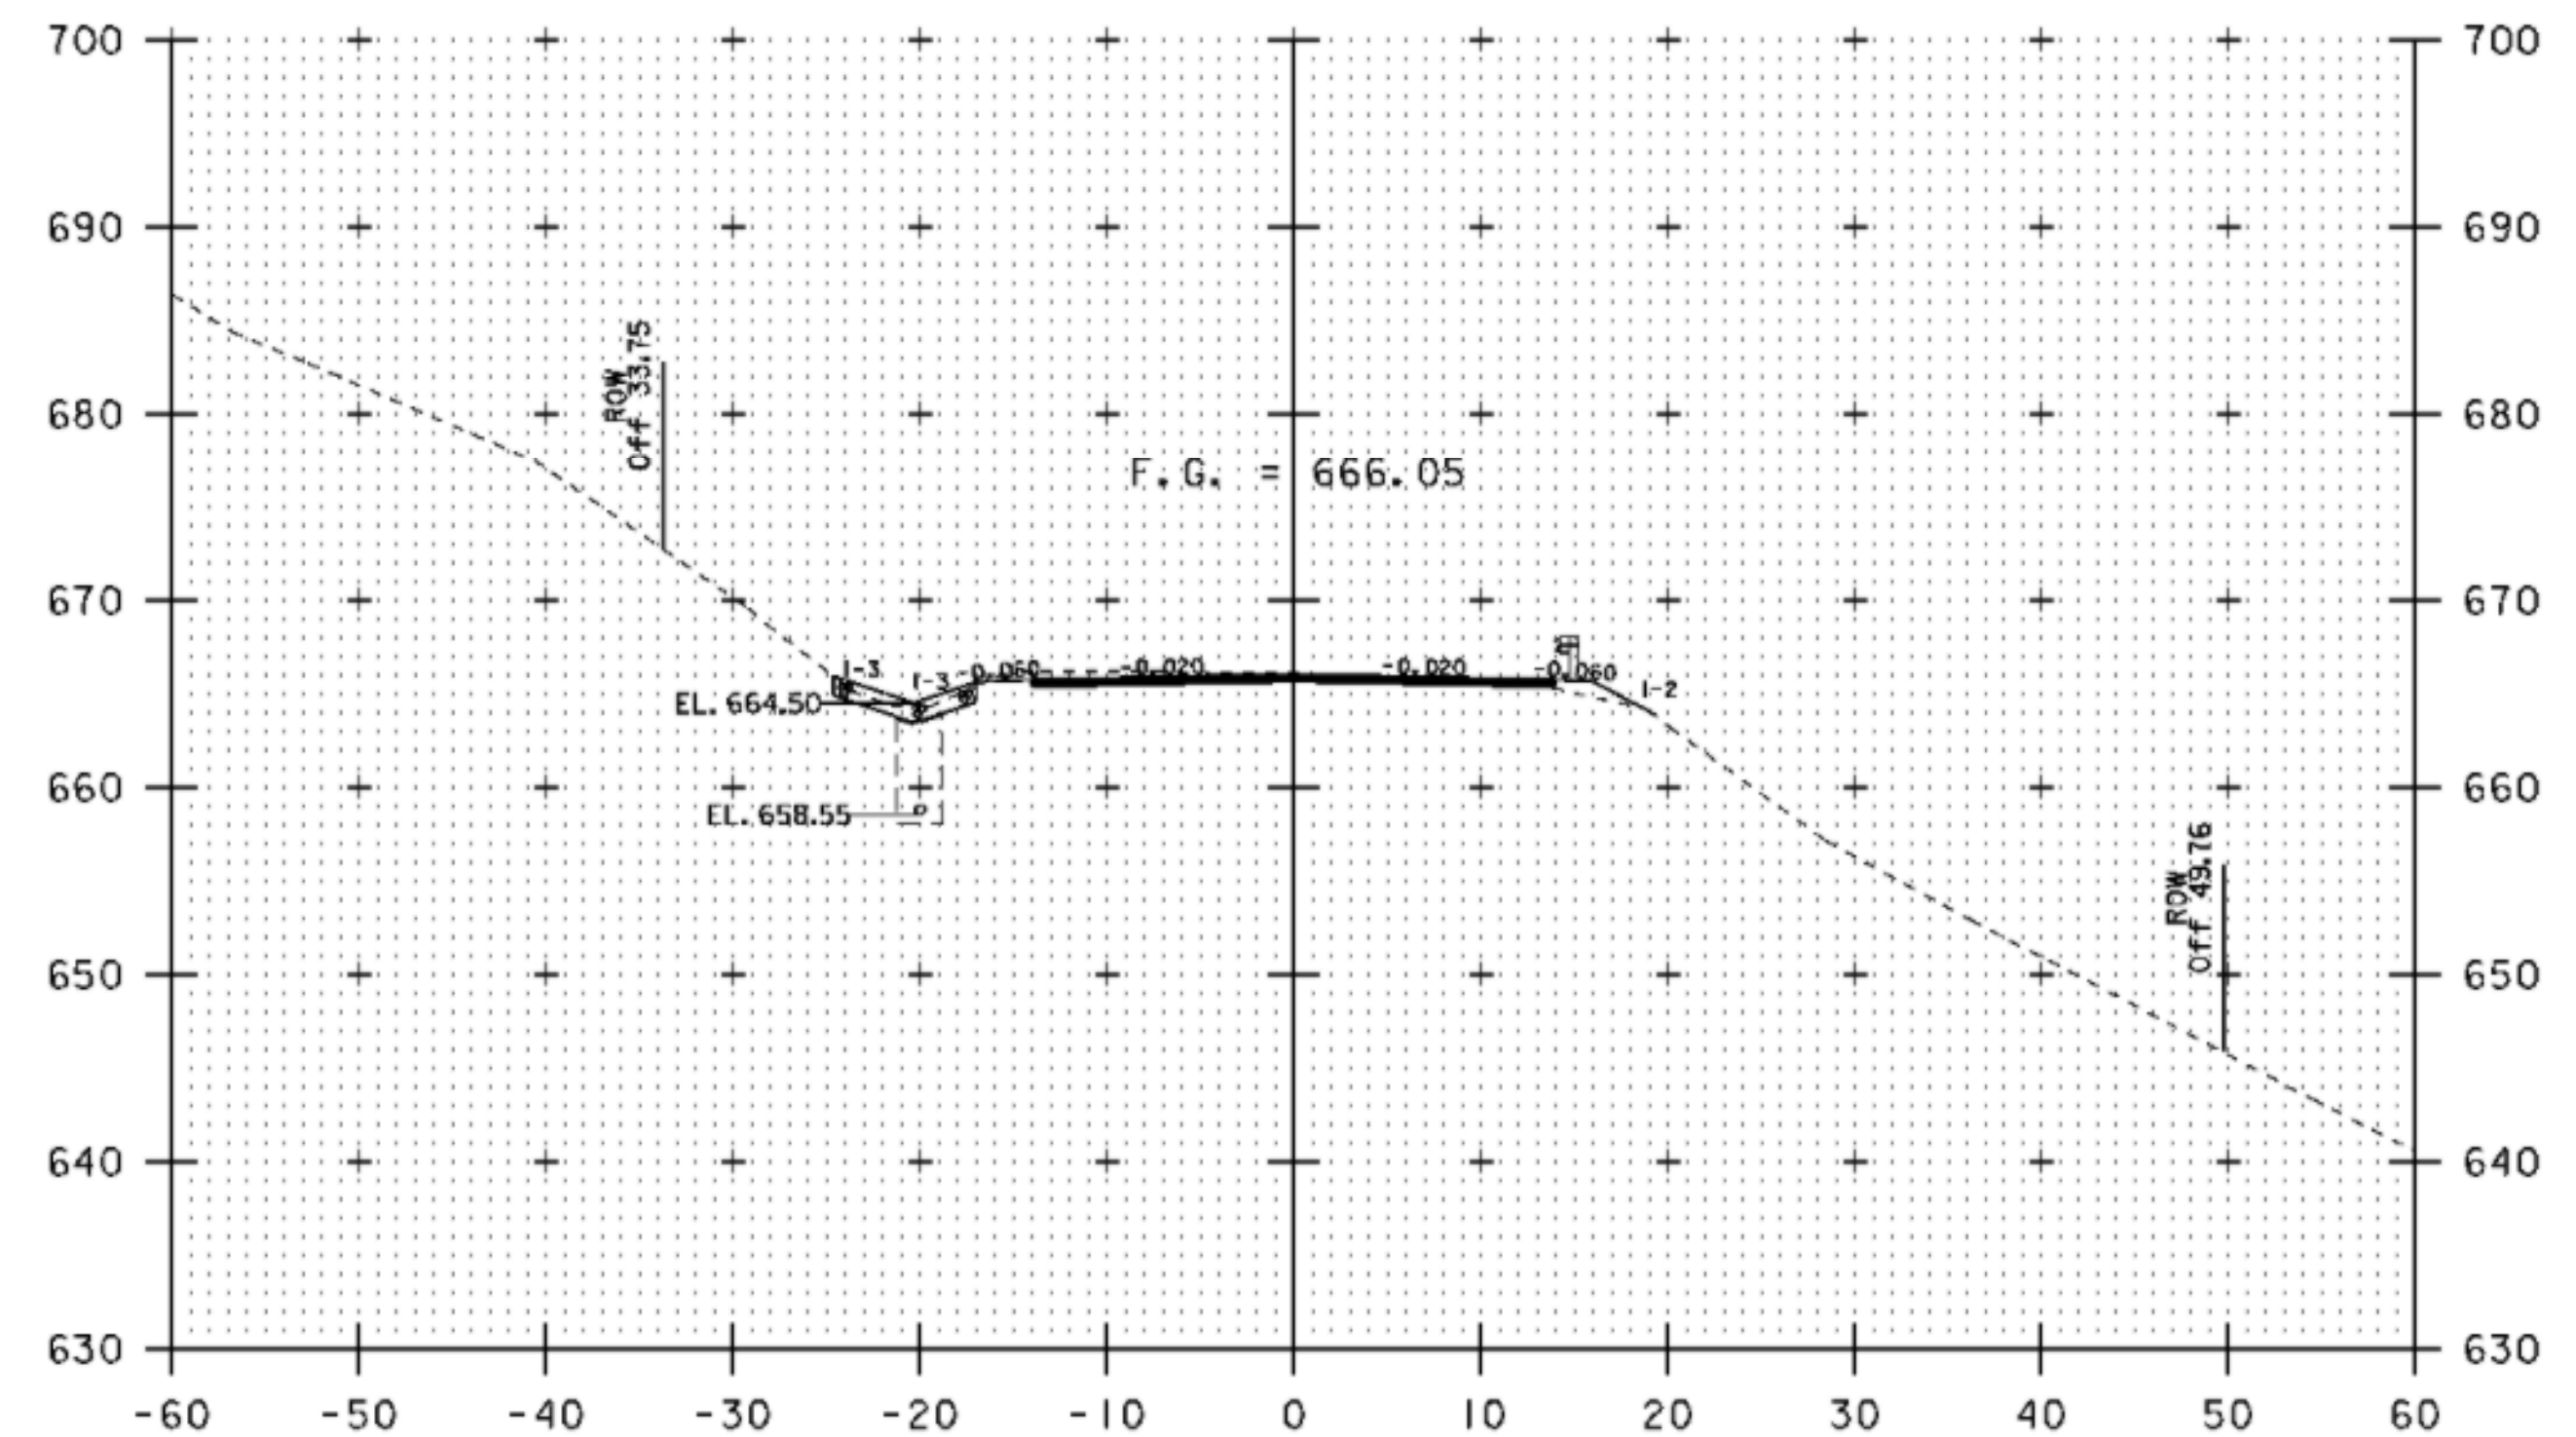

15+75

MAINLINE CROSS SECTIONS 15+25 TO 16+00

PROJECT NAME:	CAMBRIDGE	PLOT DATE:	28-JUL-2009
PROJECT NUMBER:	STP 0235(9)	DRAWN BY:	N. PAPPAS
FILE NAME:	D07C152WRK.DGN	CHECKED BY:	S. MENARD
PROJECT LEADER:	K. ROBBE	SHEET	19 OF 28
DESIGNED BY:	N. PAPPAS		
IPARM:	d07x152_xs_03		