




17+50

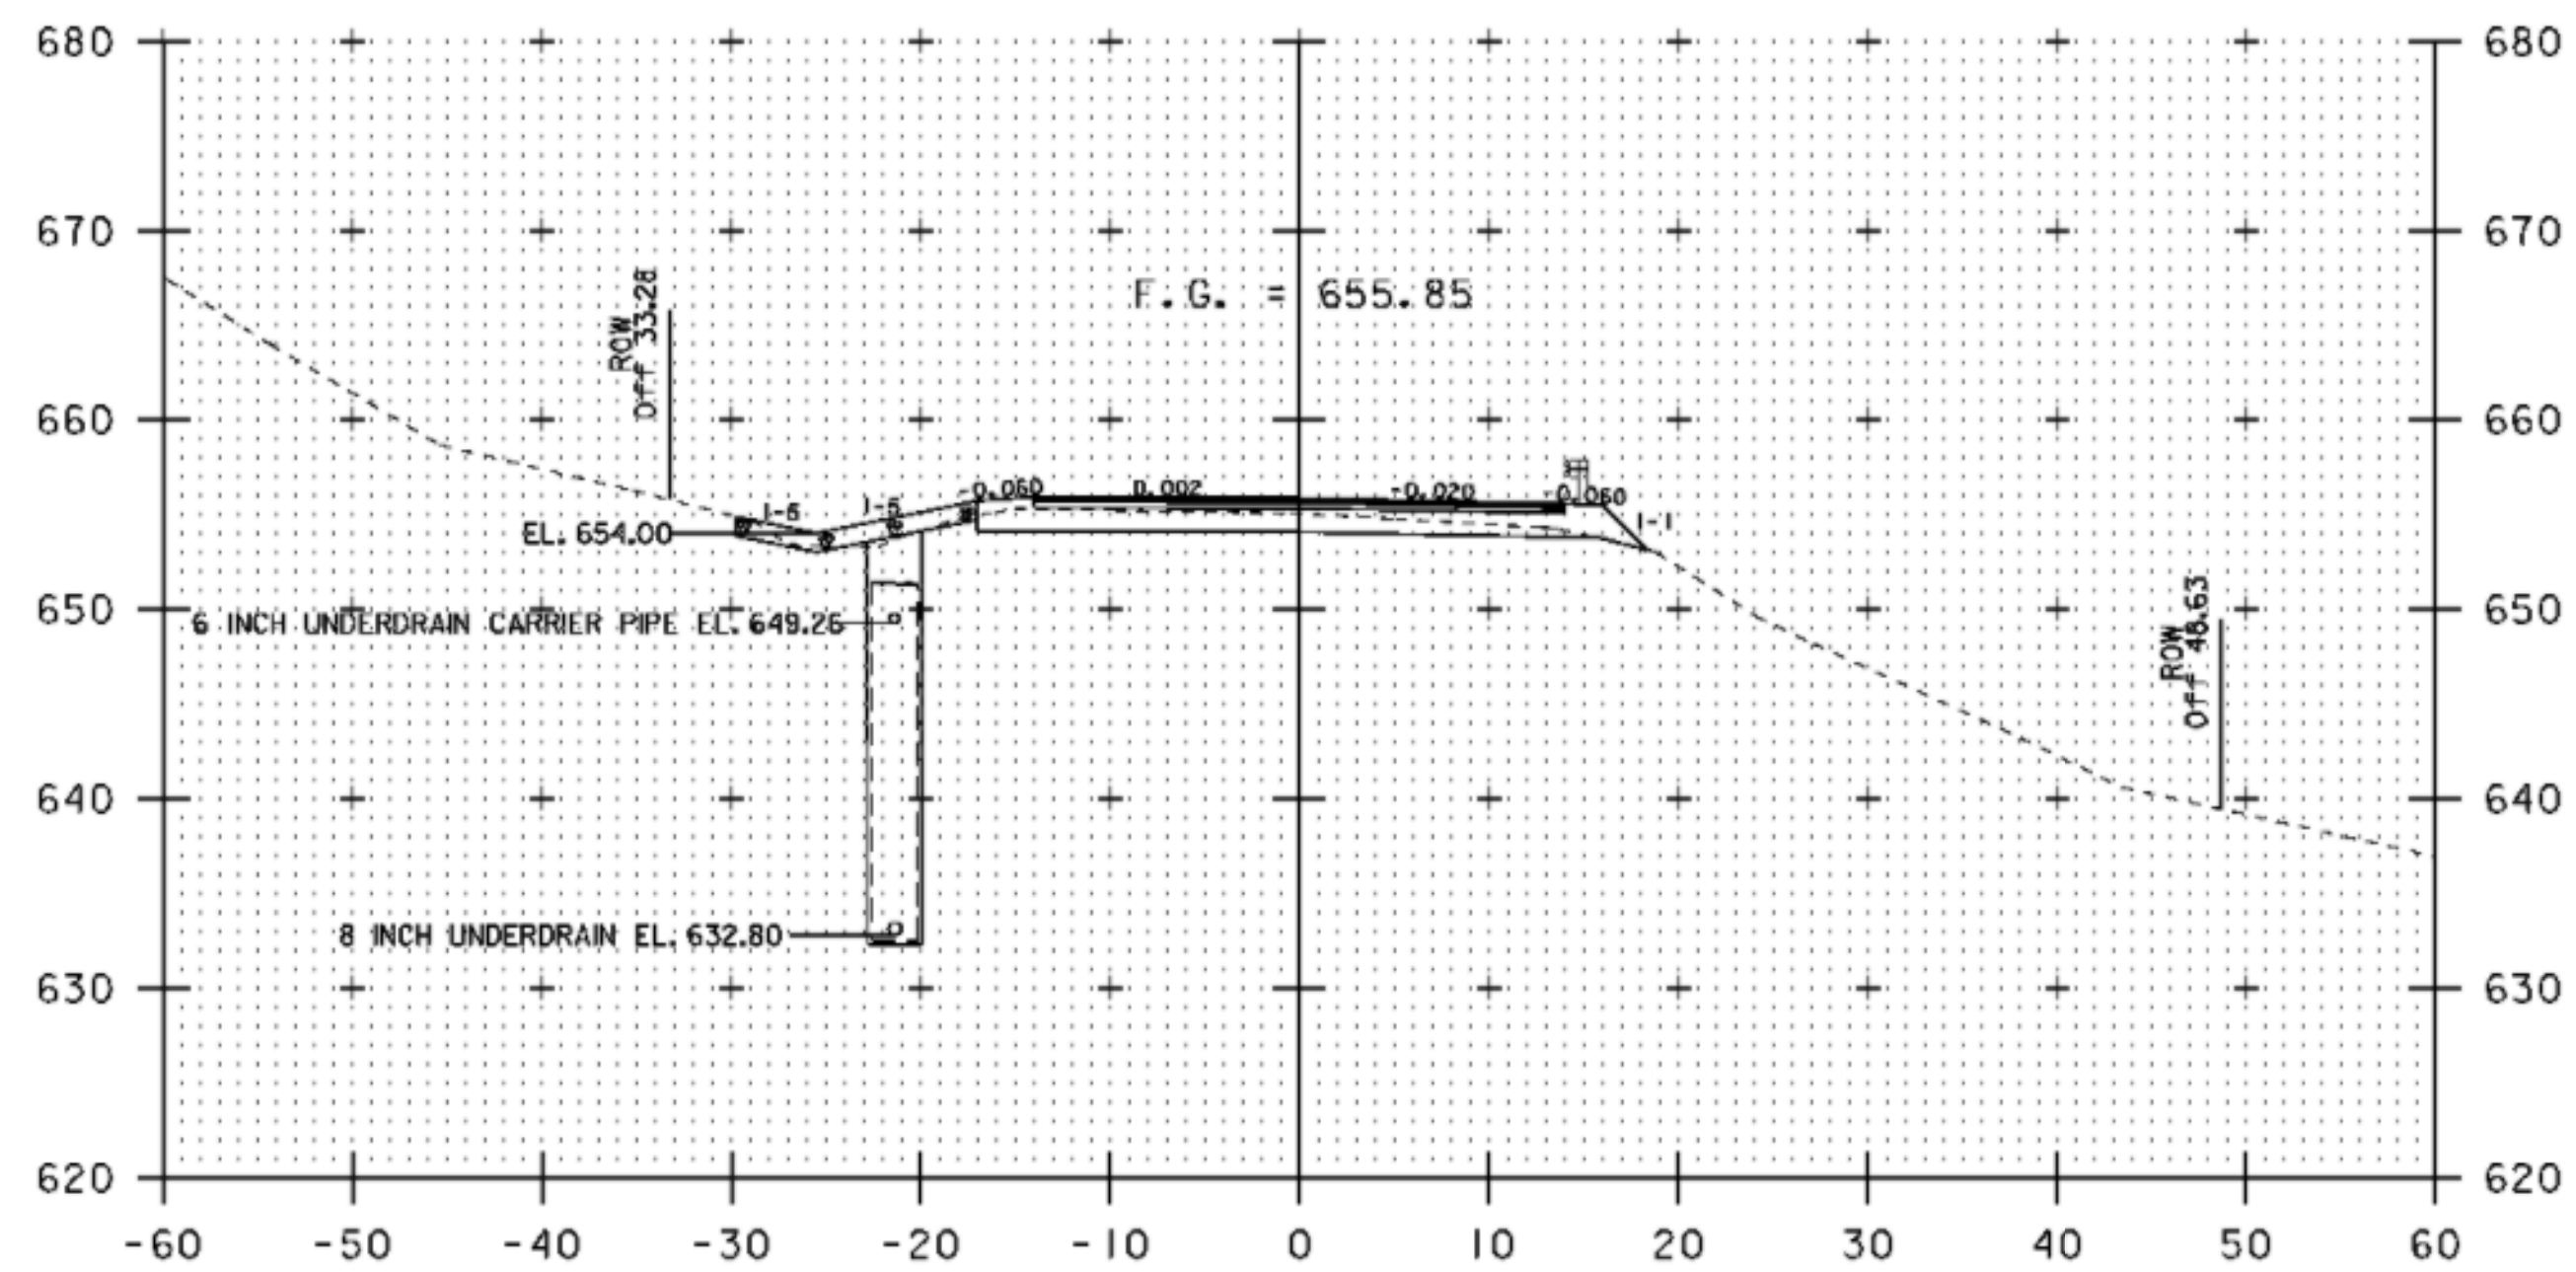

17+25

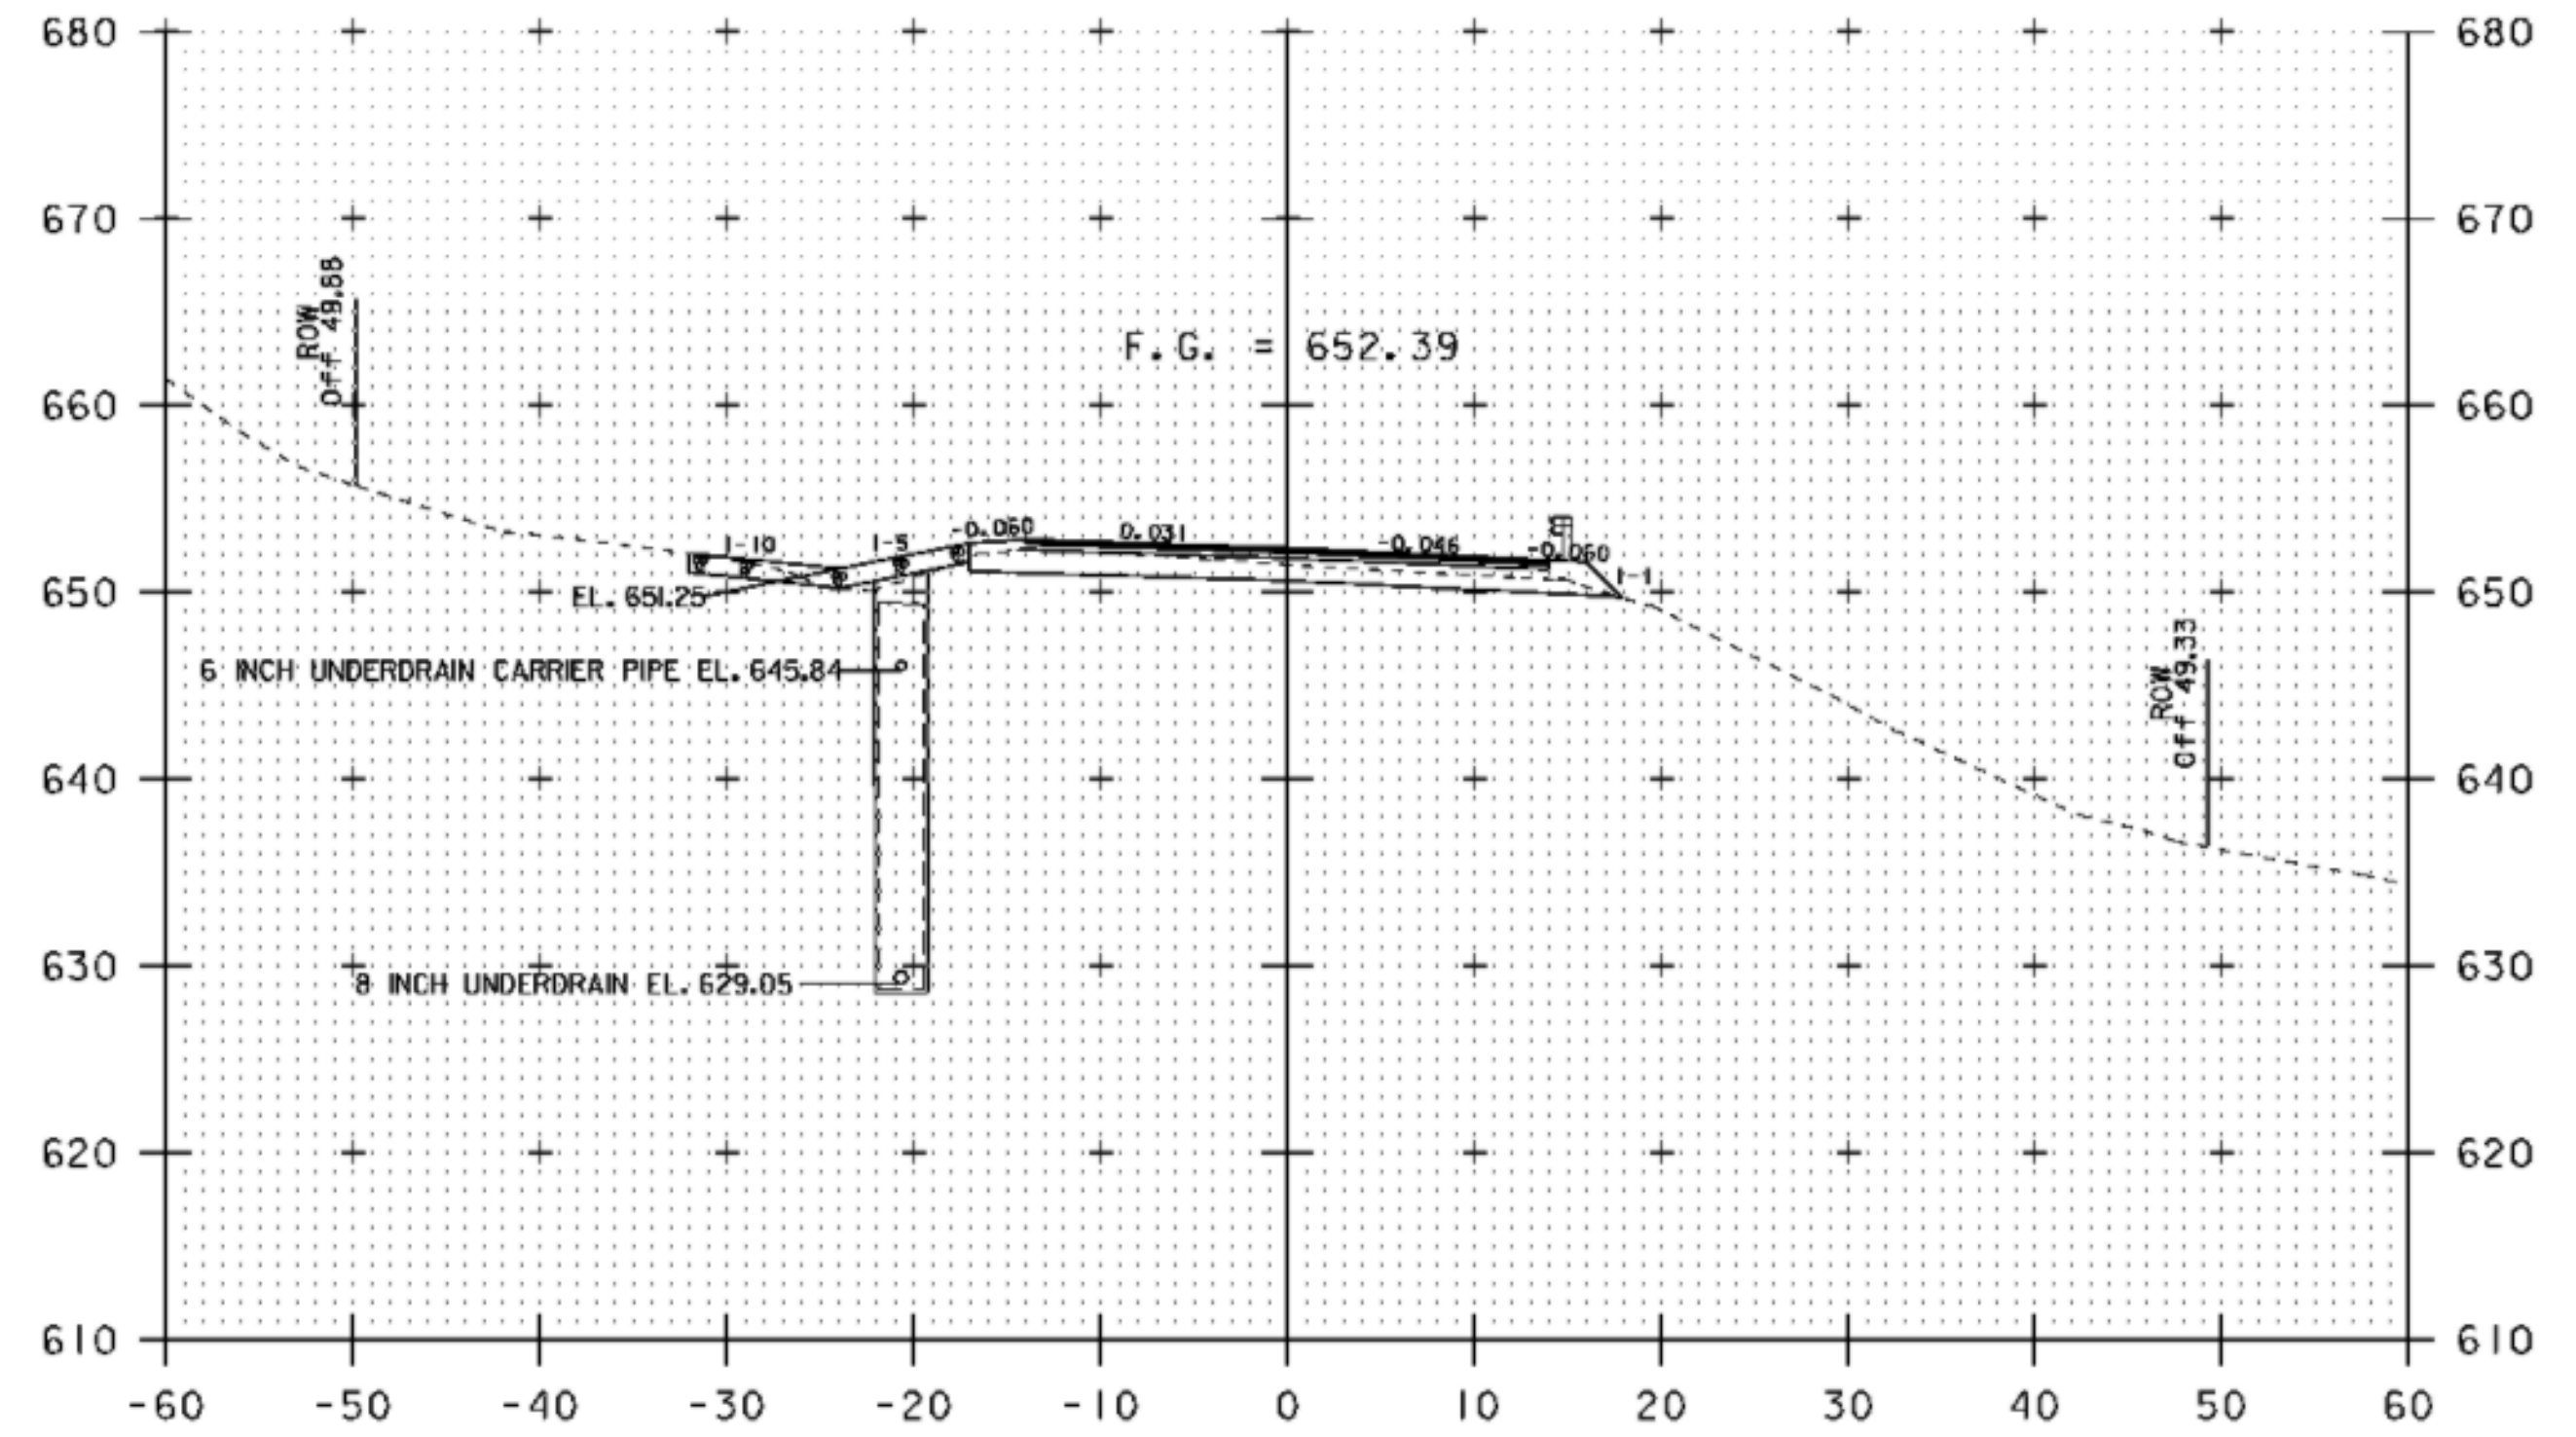

18+00

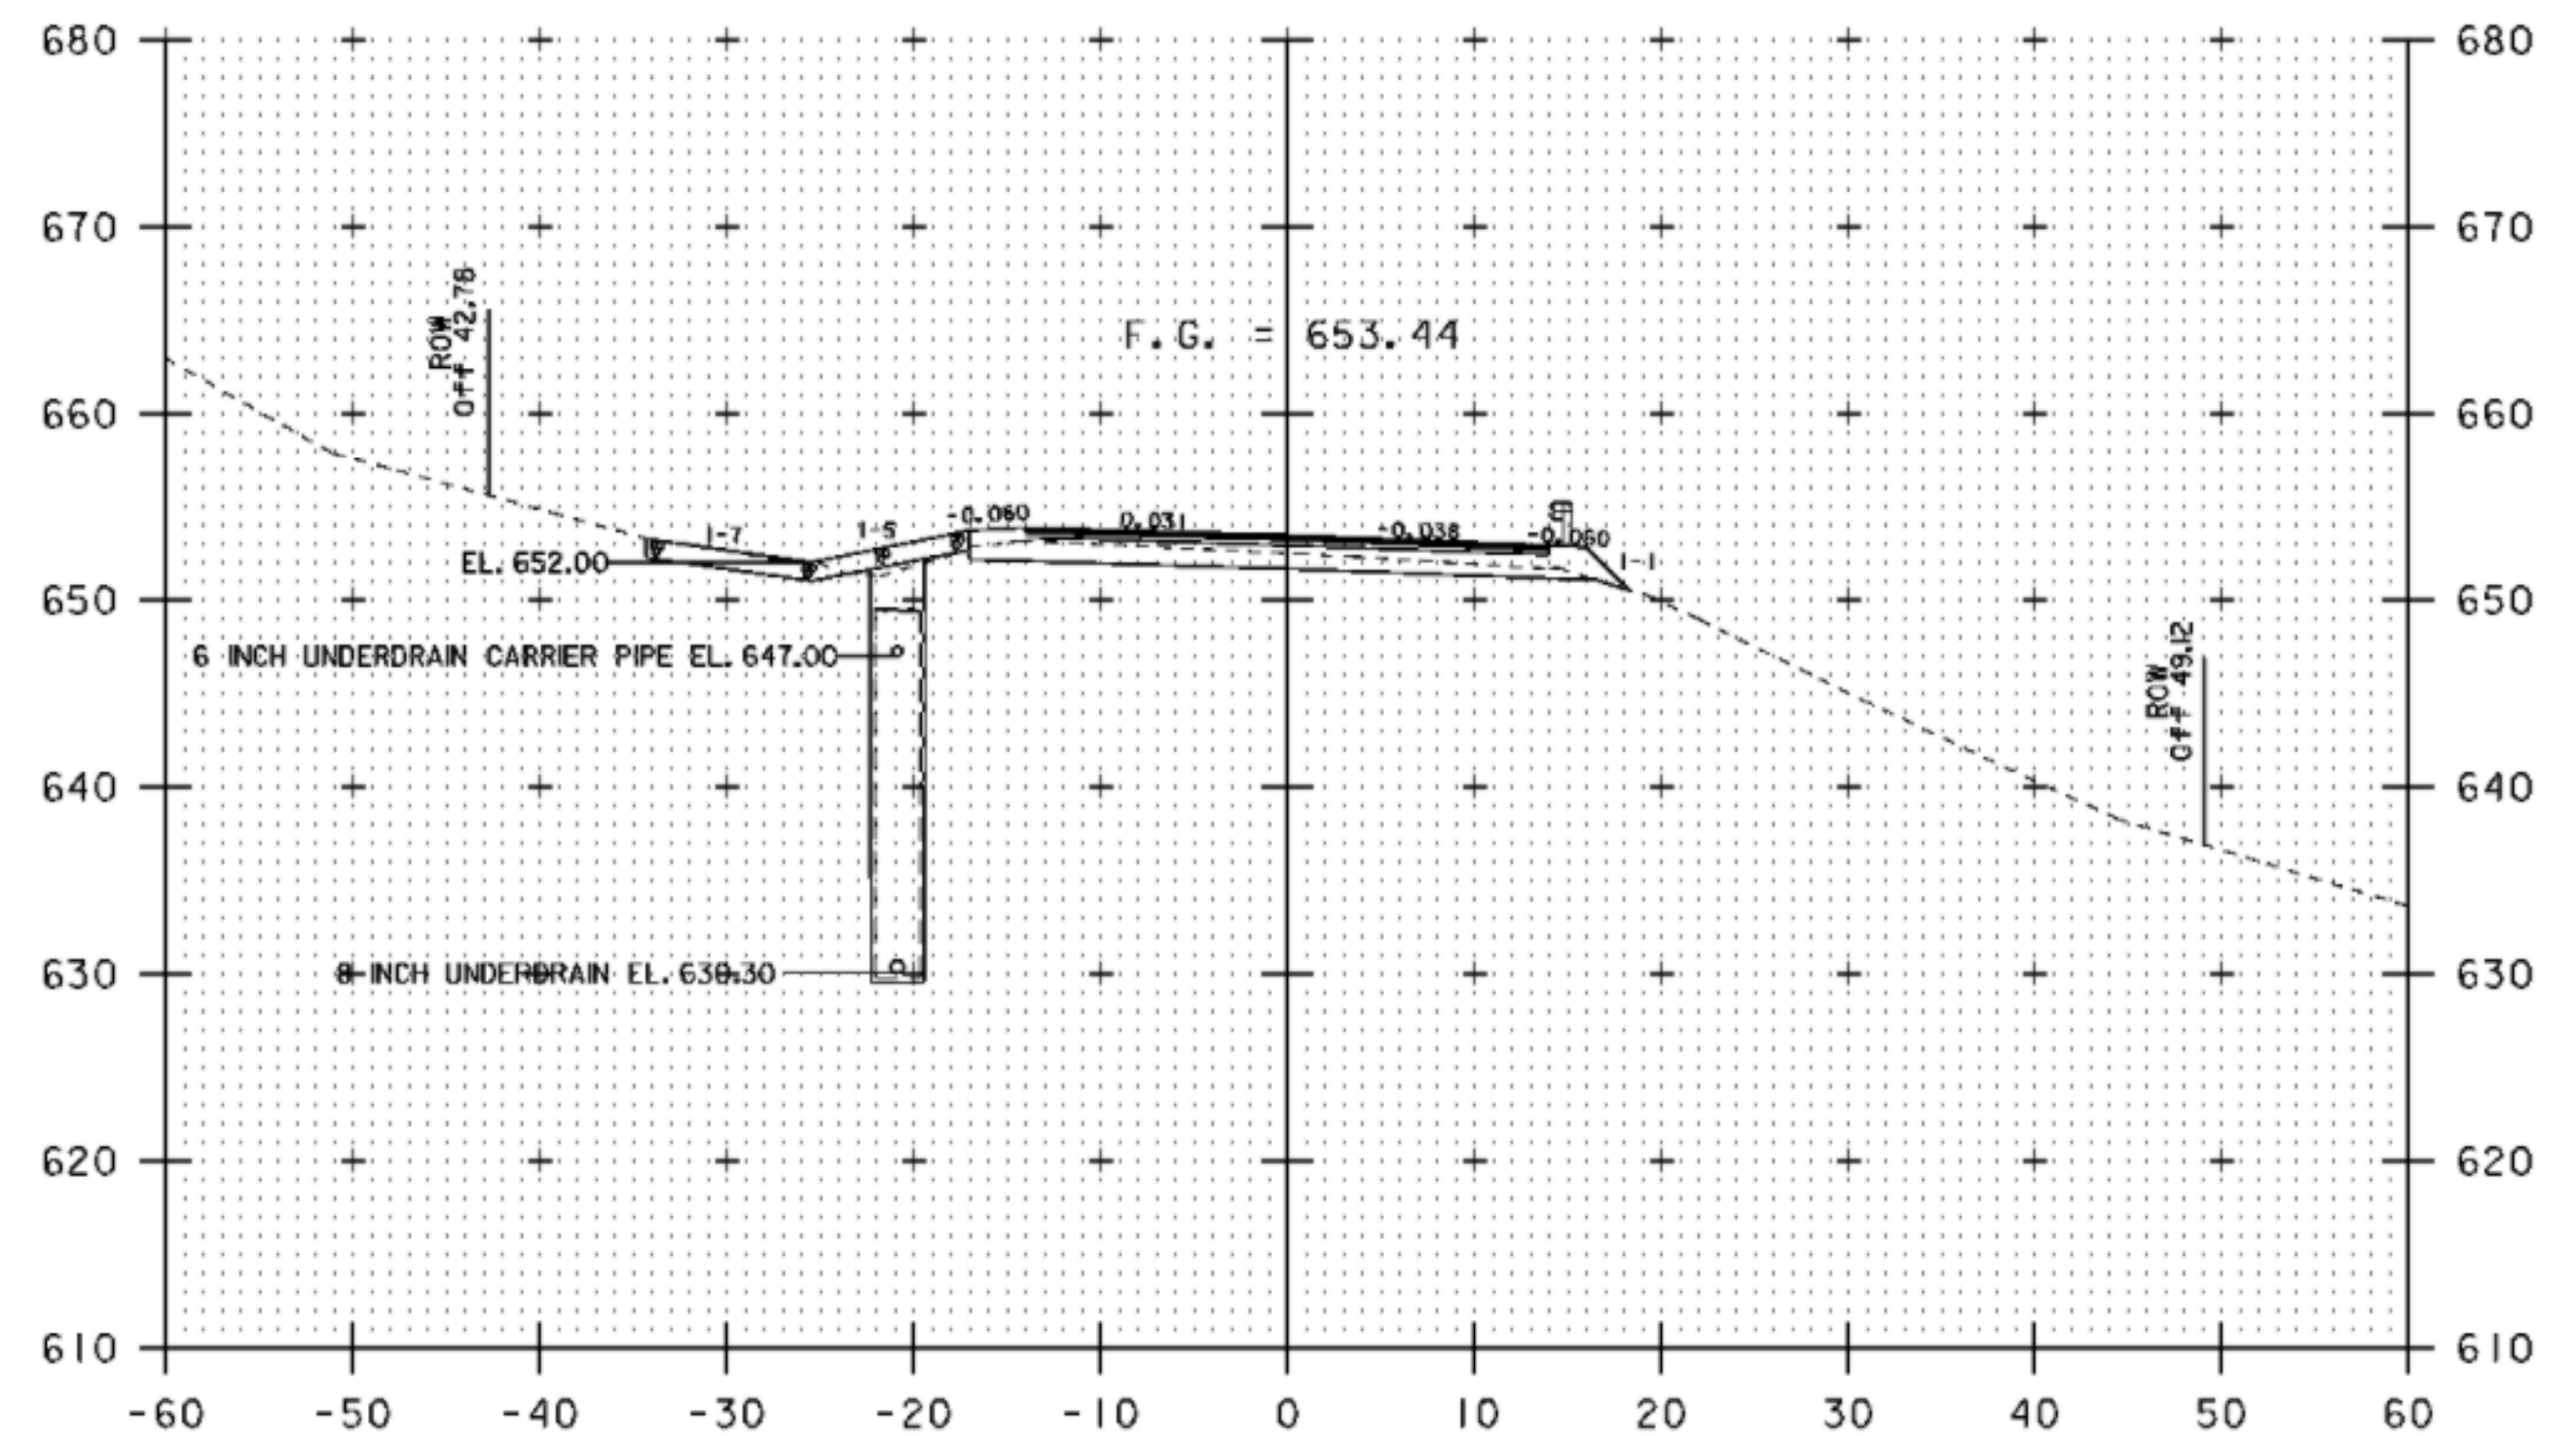

17+75

MAINLINE CROSS SECTIONS 17+25 TO 18+00

PROJECT NAME:	CAMBRIDGE	FILE NAME:	D07CI52WRK.DGN	PLOT DATE:	28-JUL-2009
PROJECT NUMBER:	STP 0235(9)	PROJECT LEADER:	K. ROBIE	DRAWN BY:	N. PAPPAS
		DESIGNED BY:	N. PAPPAS	CHECKED BY:	S. MENARD
		IPARM:	d07x152_xs.05	SHEET	21 OF 28