




19+00

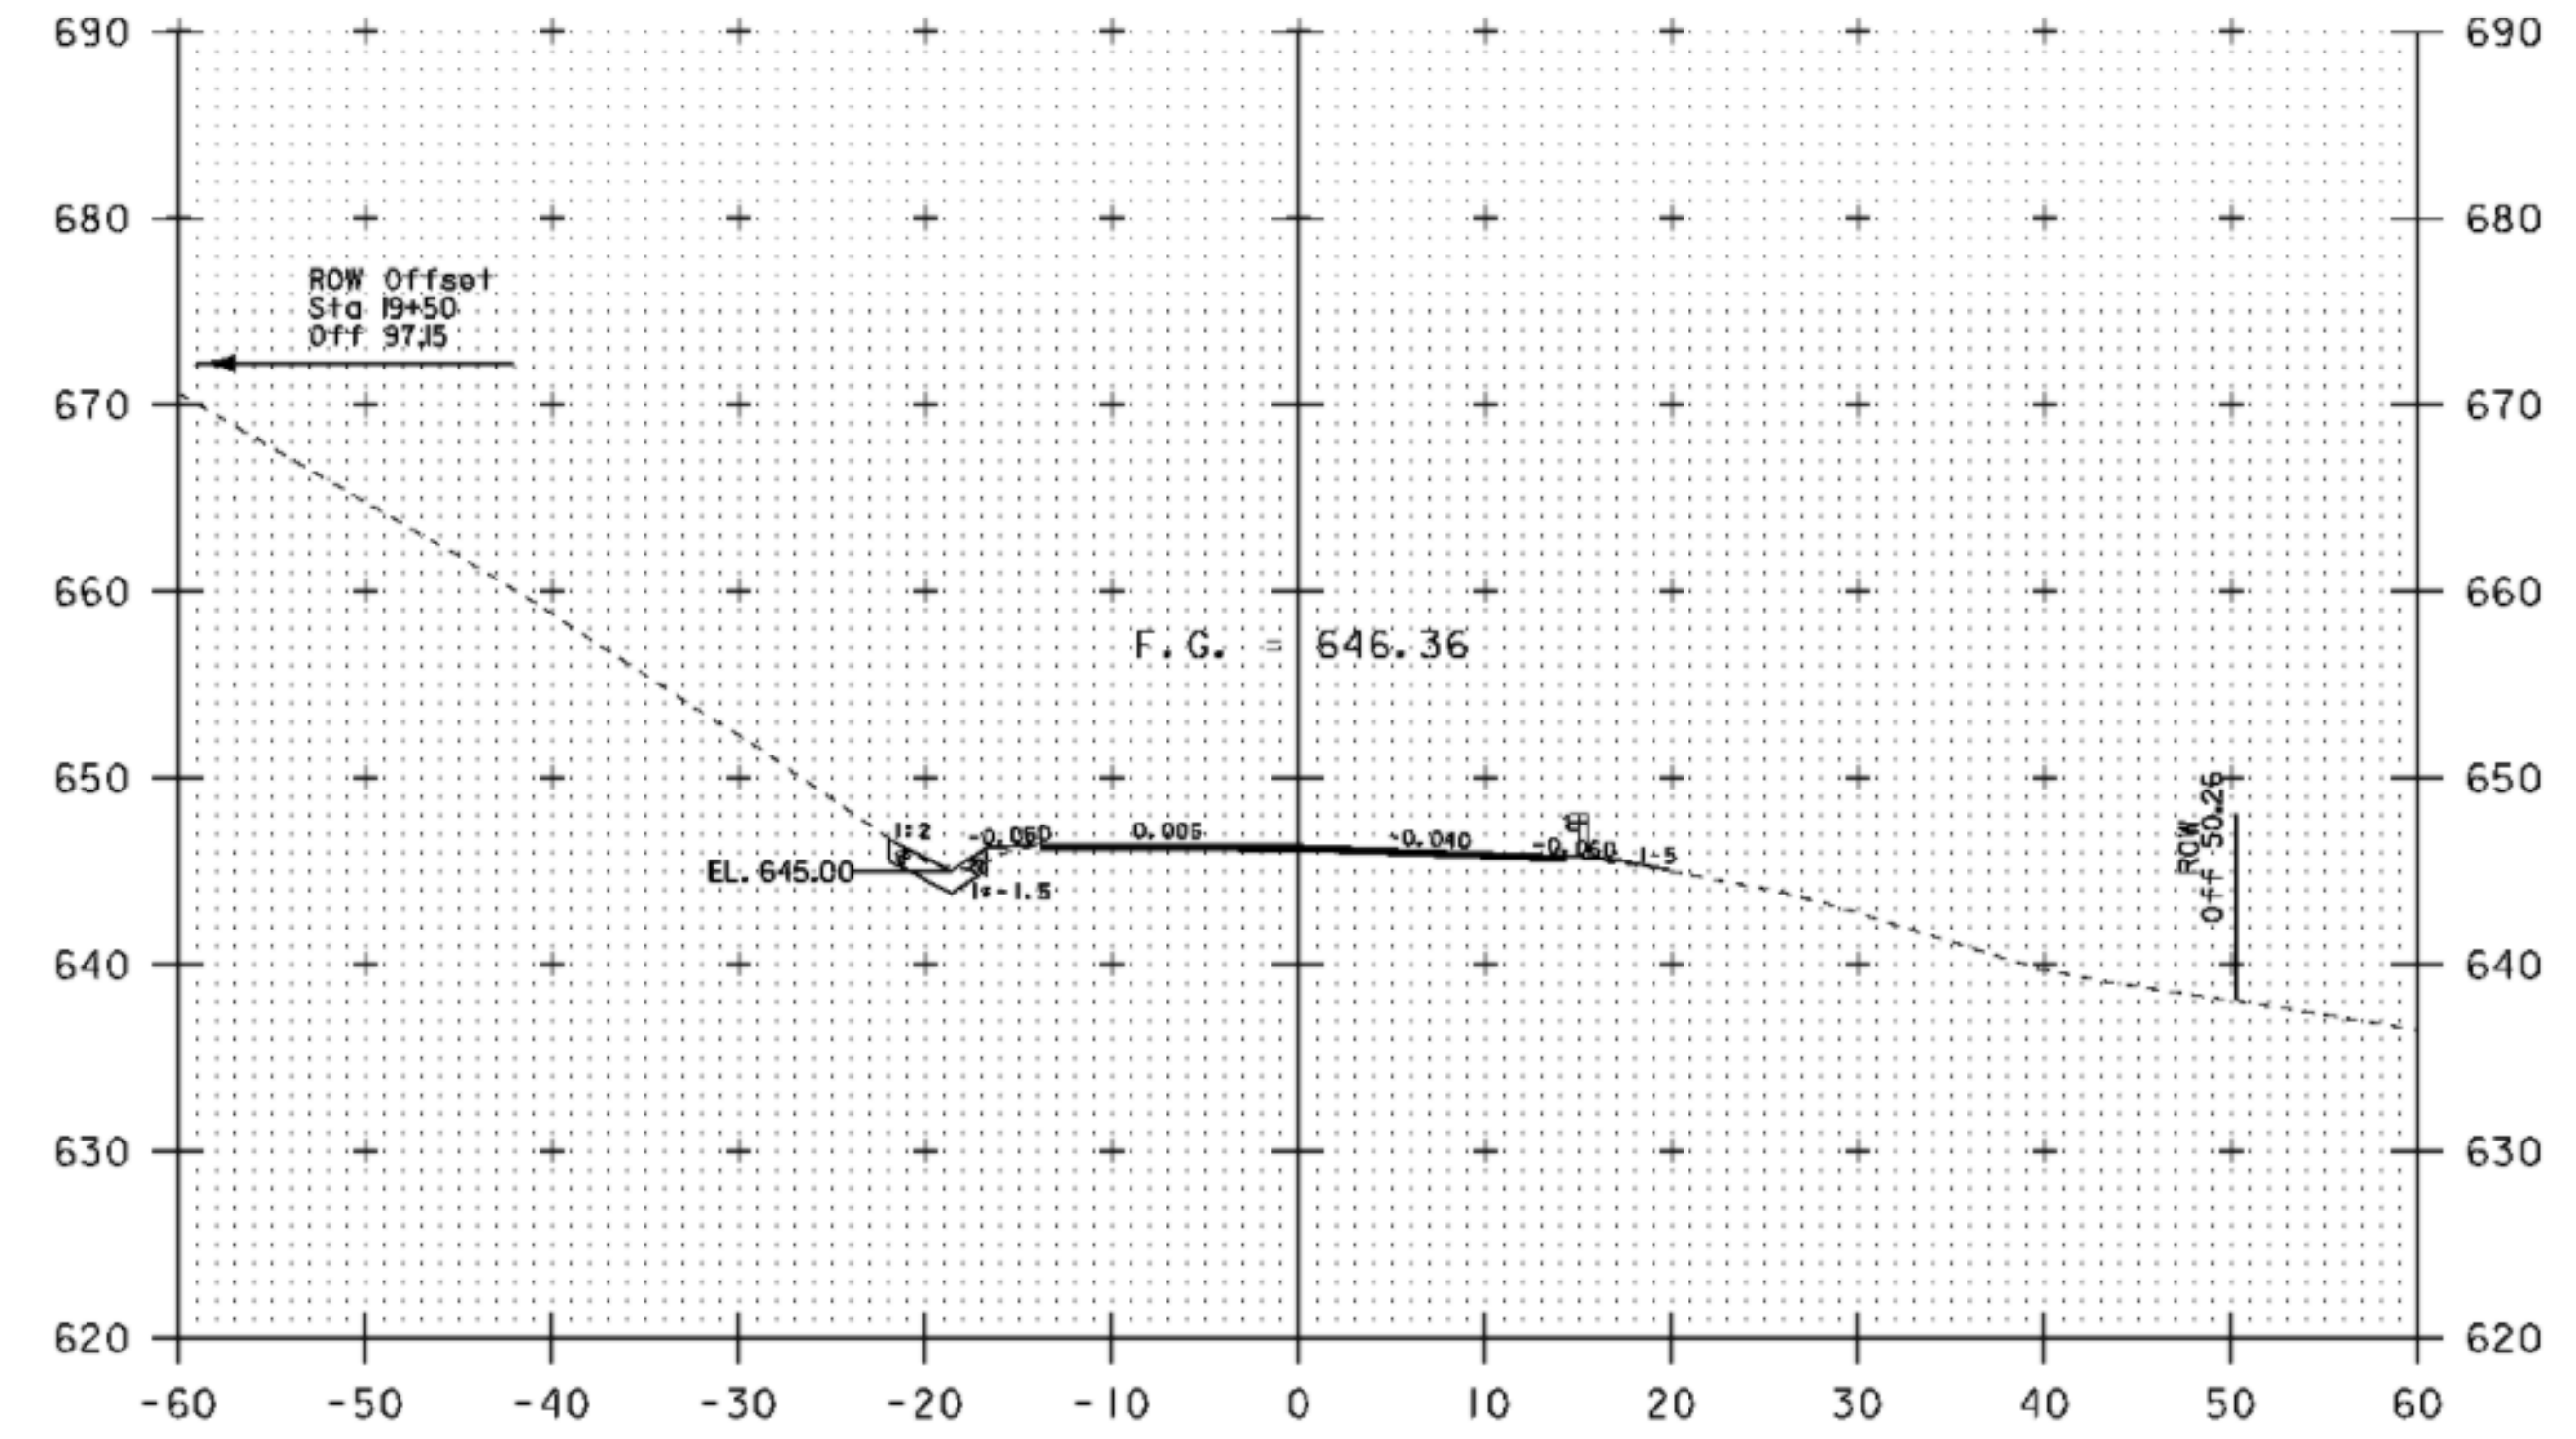

19+50

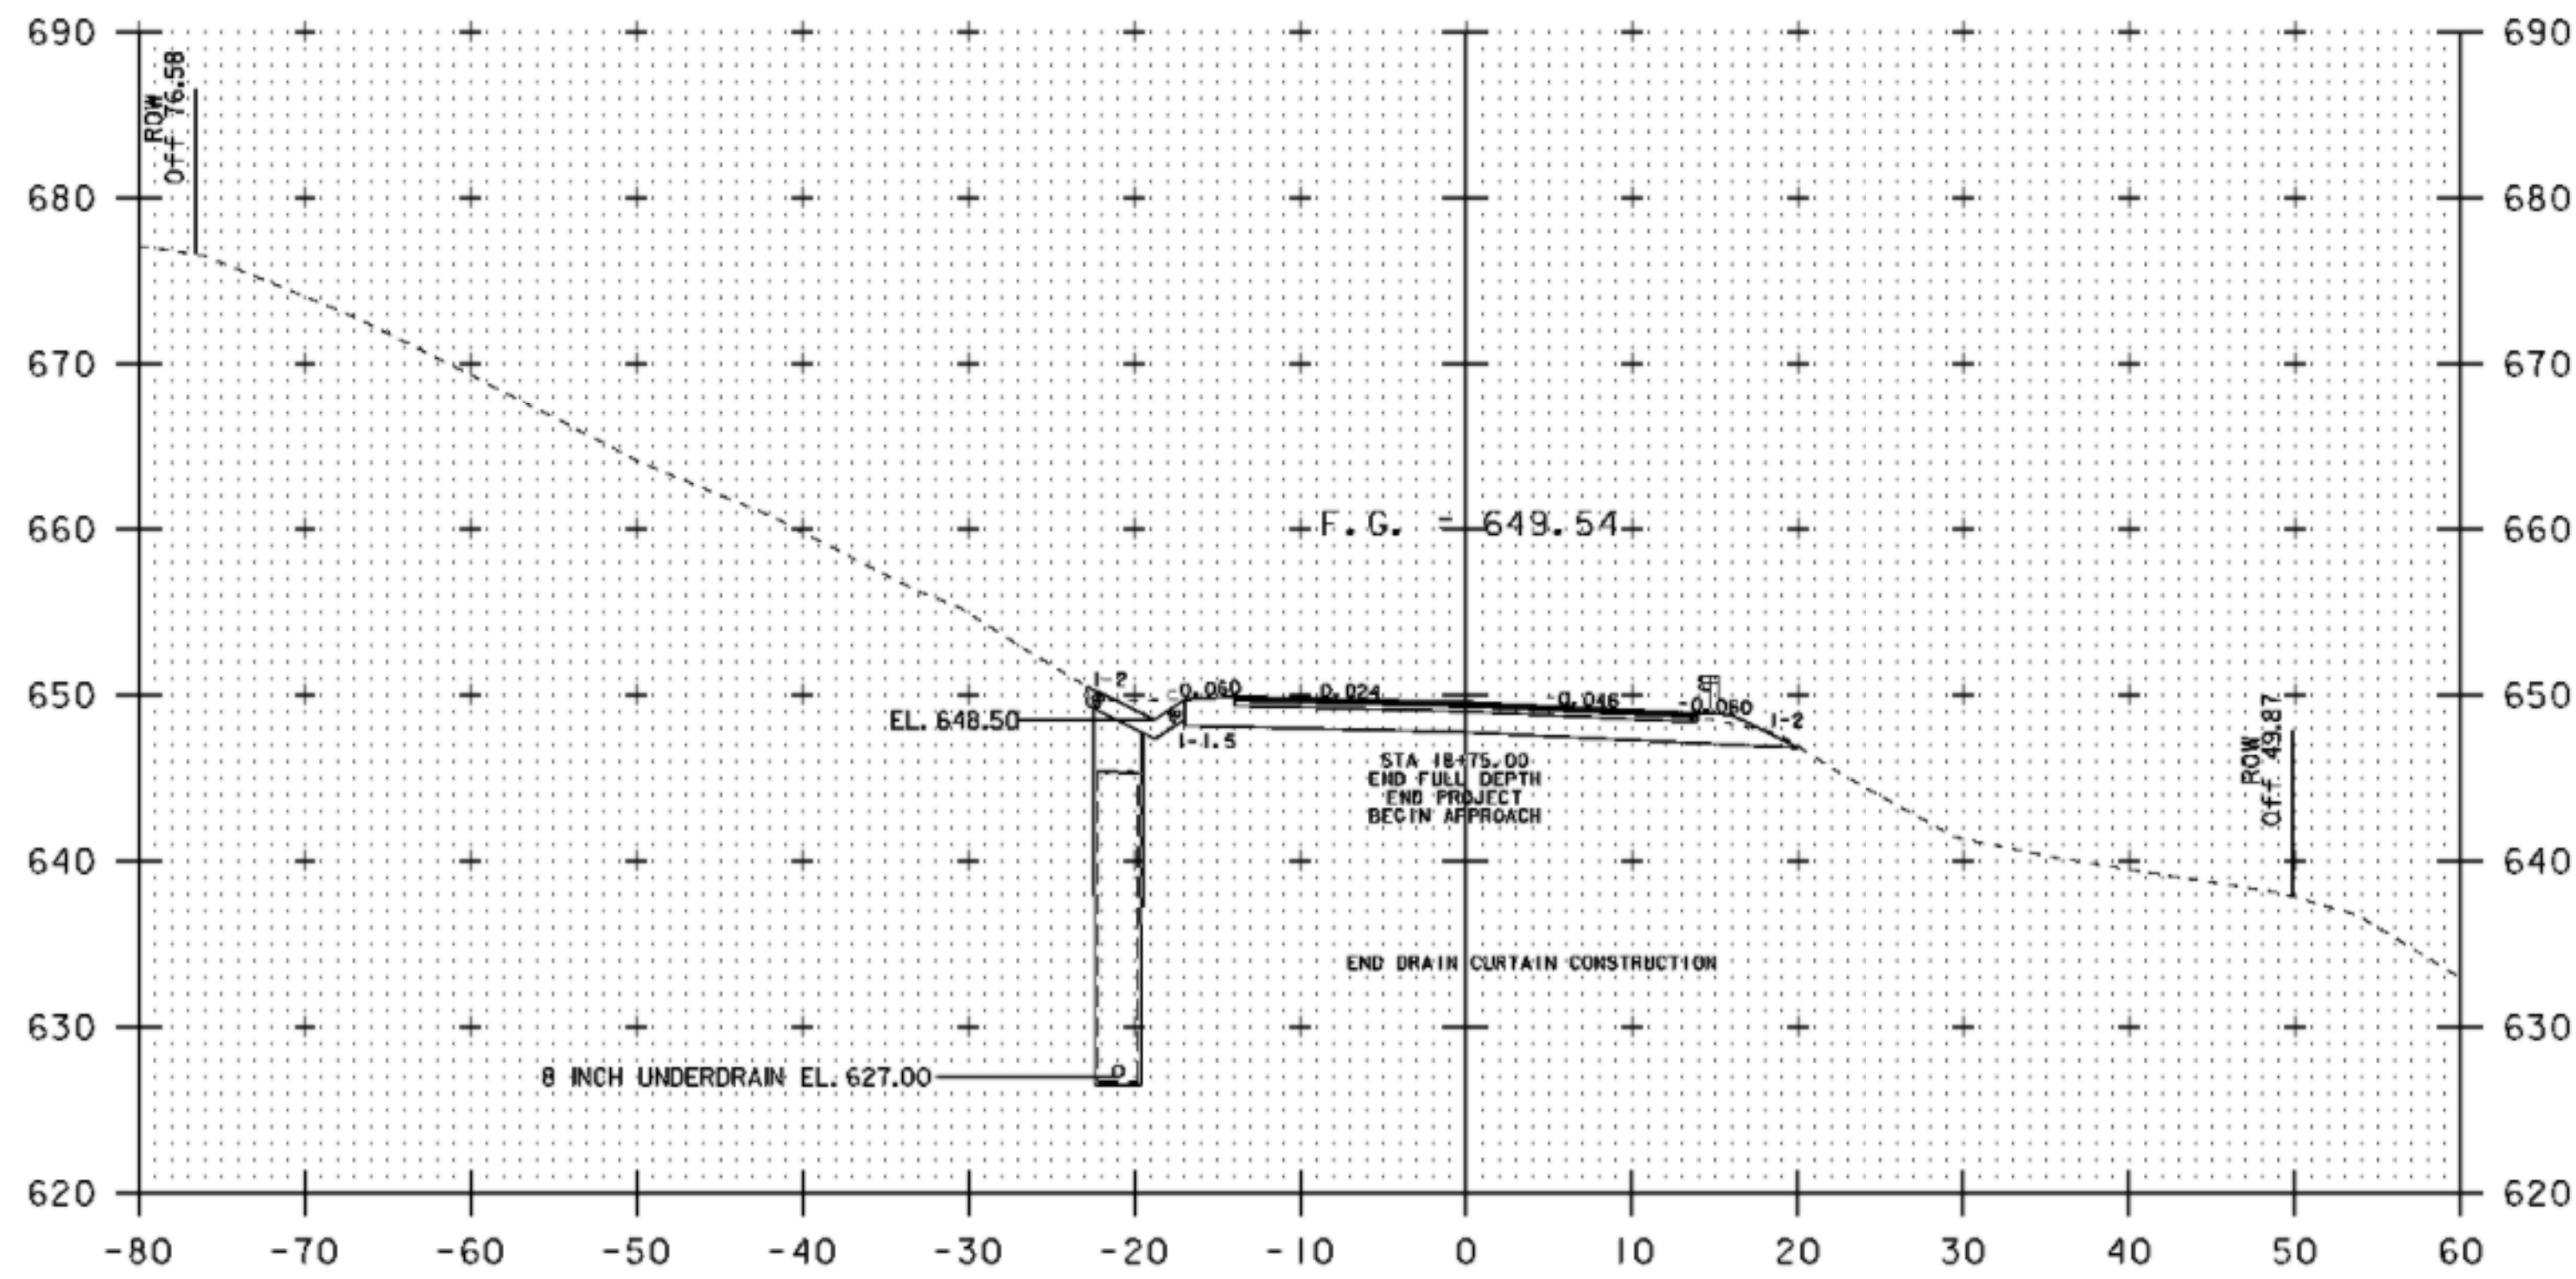

18+75

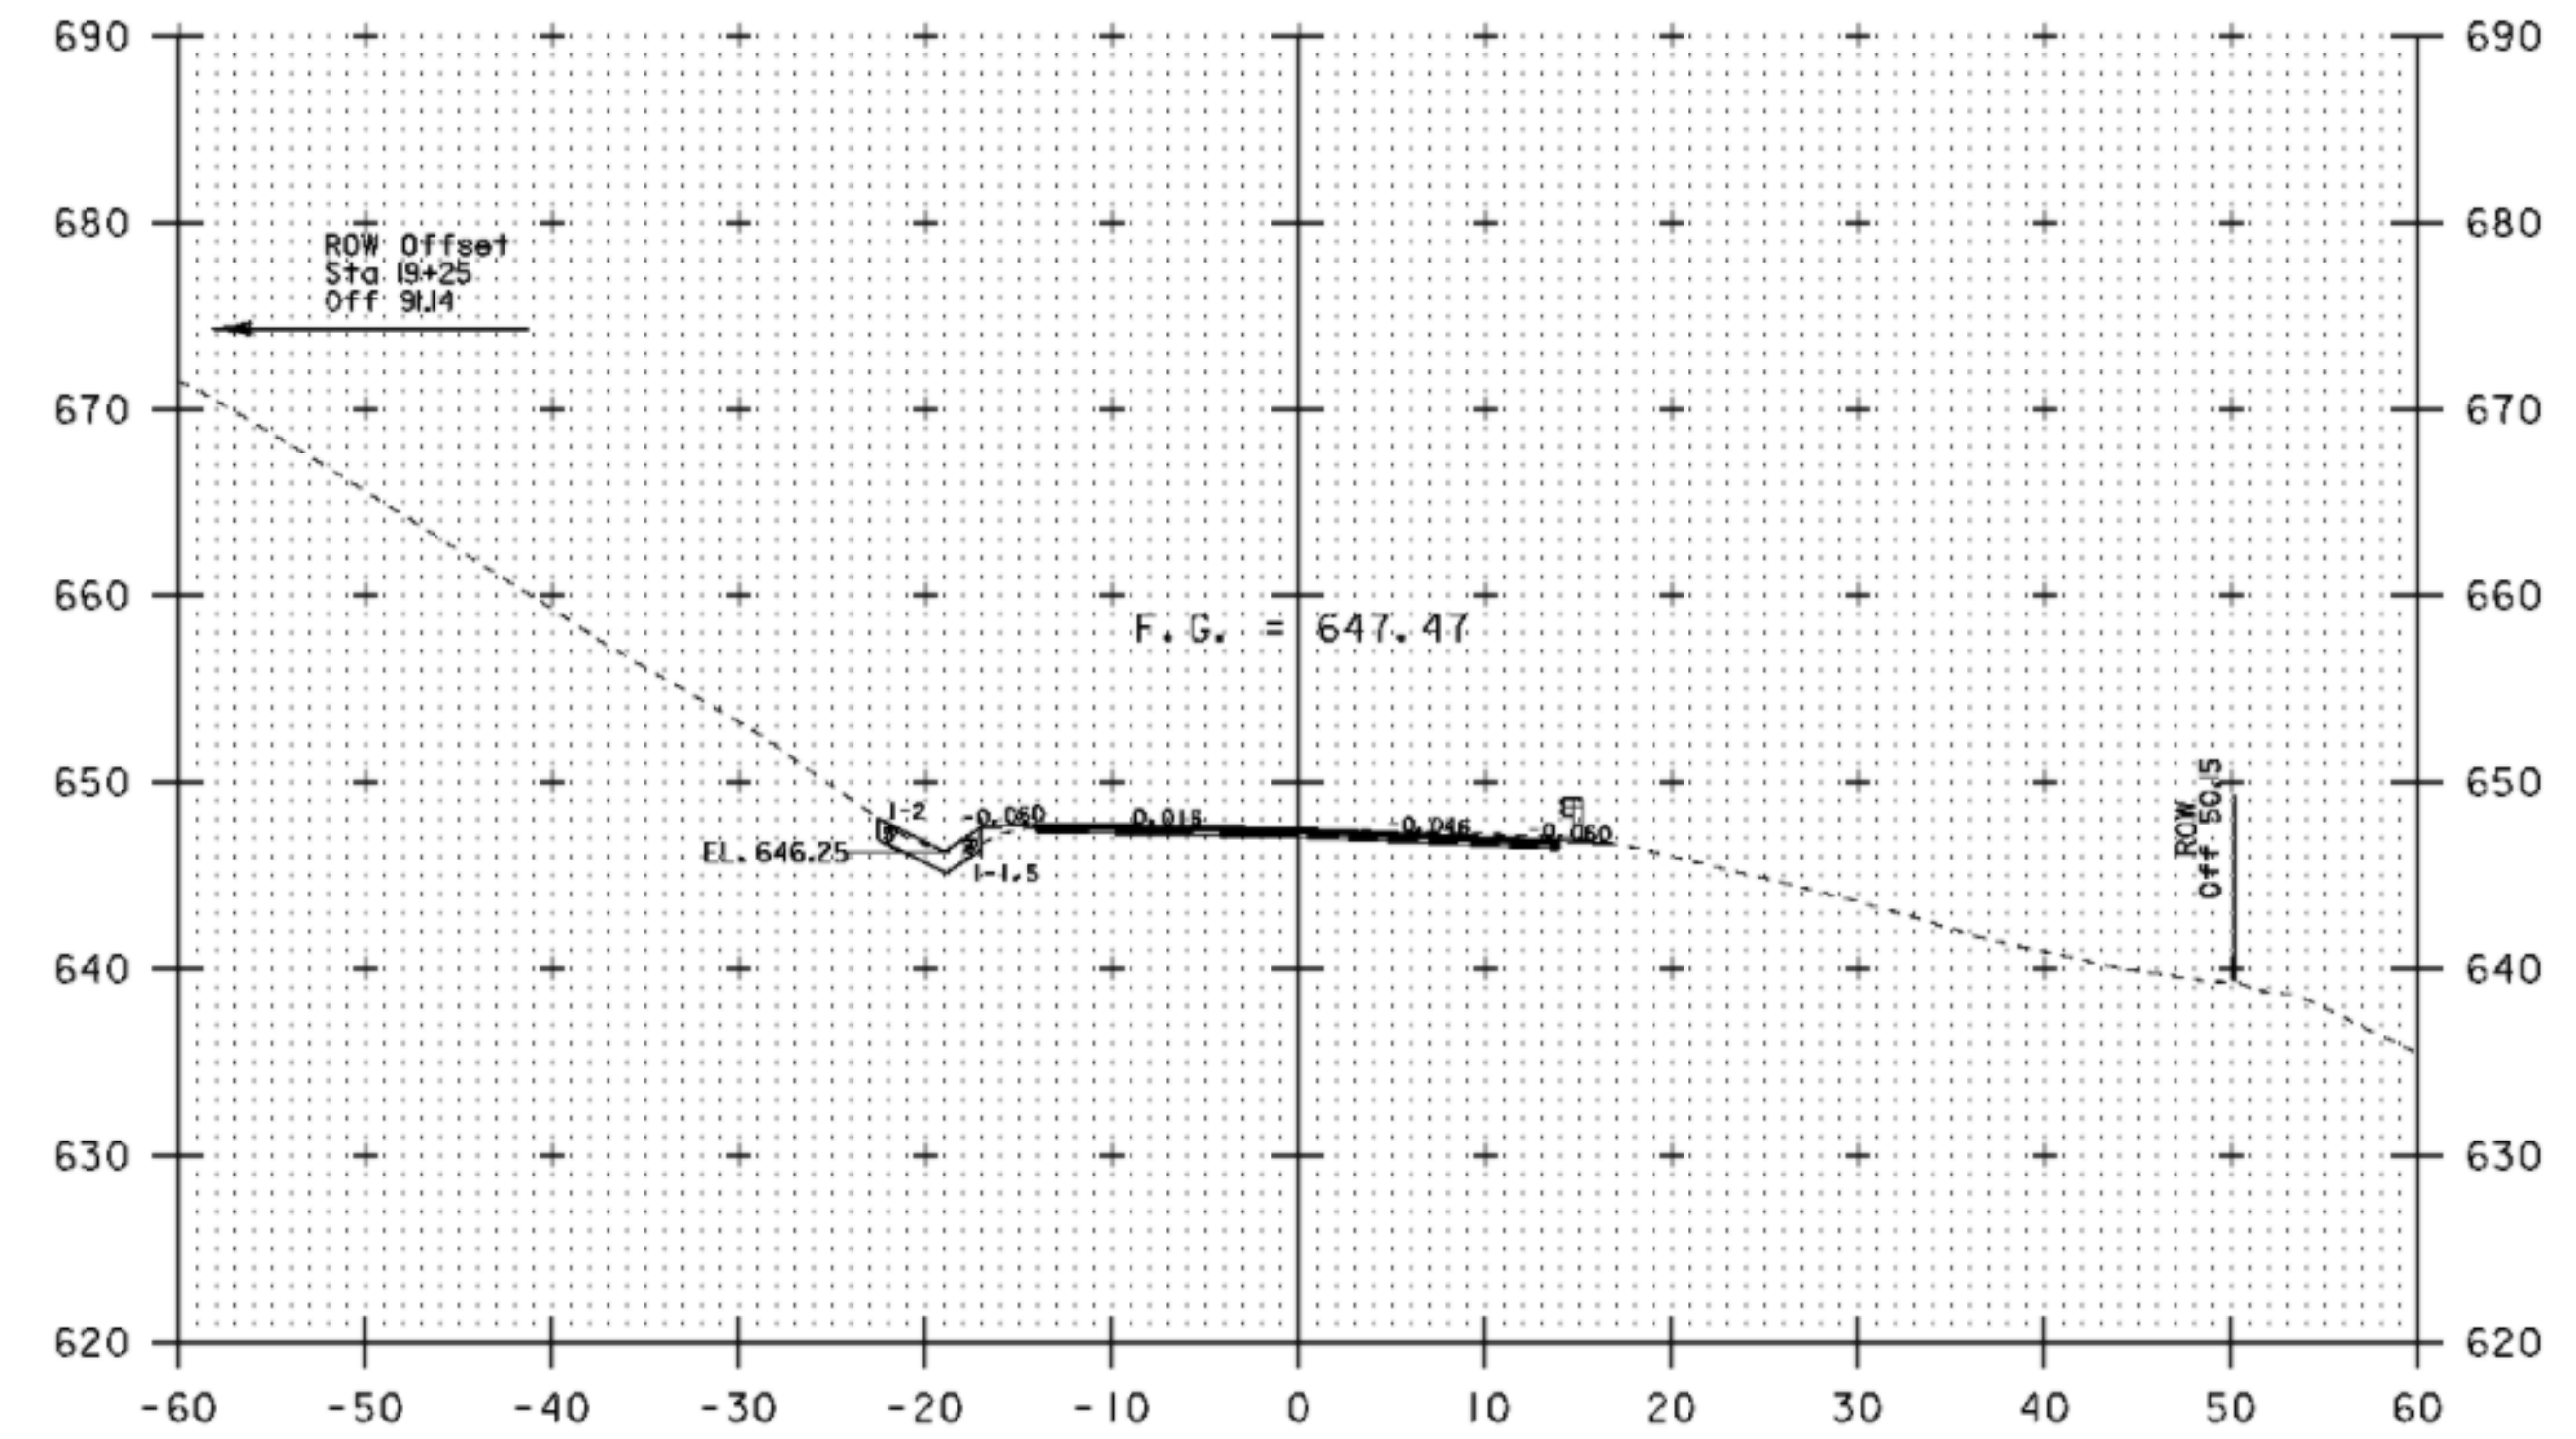

19+25

MAINLINE CROSS SECTIONS 18+75 TO 19+50

PROJECT NAME: CAMBRIDGE	
PROJECT NUMBER: STP 0235(9)	
FILE NAME: D07C152WRK.DGN	PLOT DATE: 28-JUL-2009
PROJECT LEADER: K. ROBBE	DRAWN BY: N. PAPPAS
DESIGNED BY: N. PAPPAS	CHECKED BY: S. MENARD
IPARM: d07x152_xs_09	SHEET 25 OF 28