



20+00

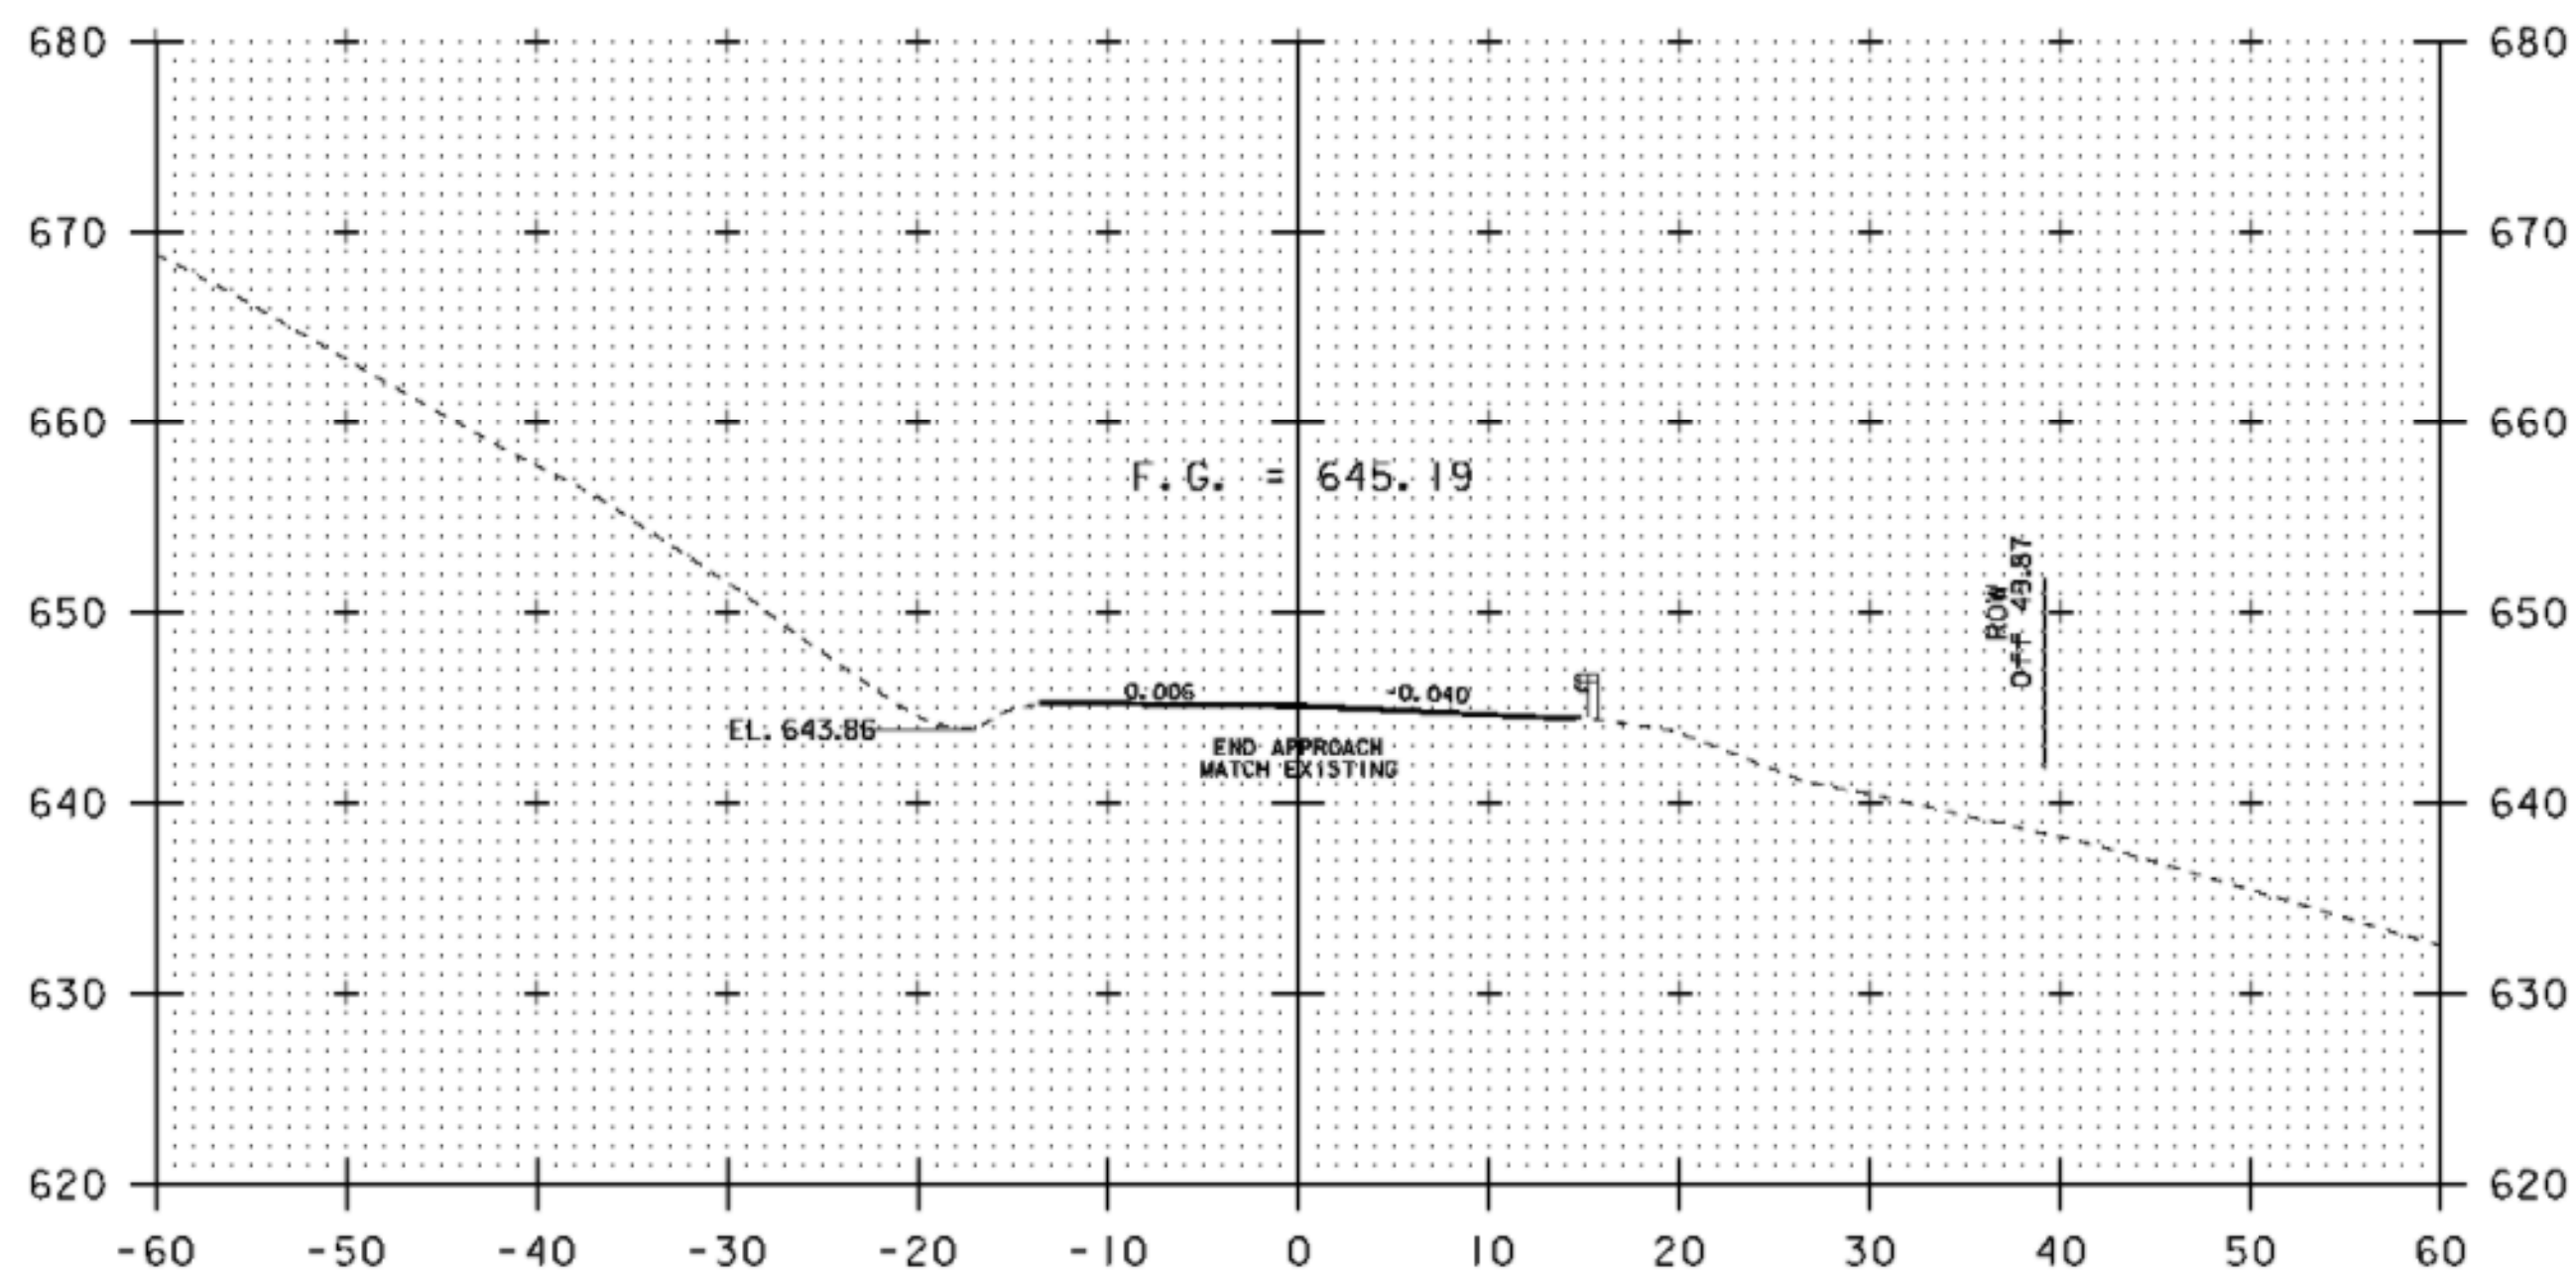

19+75

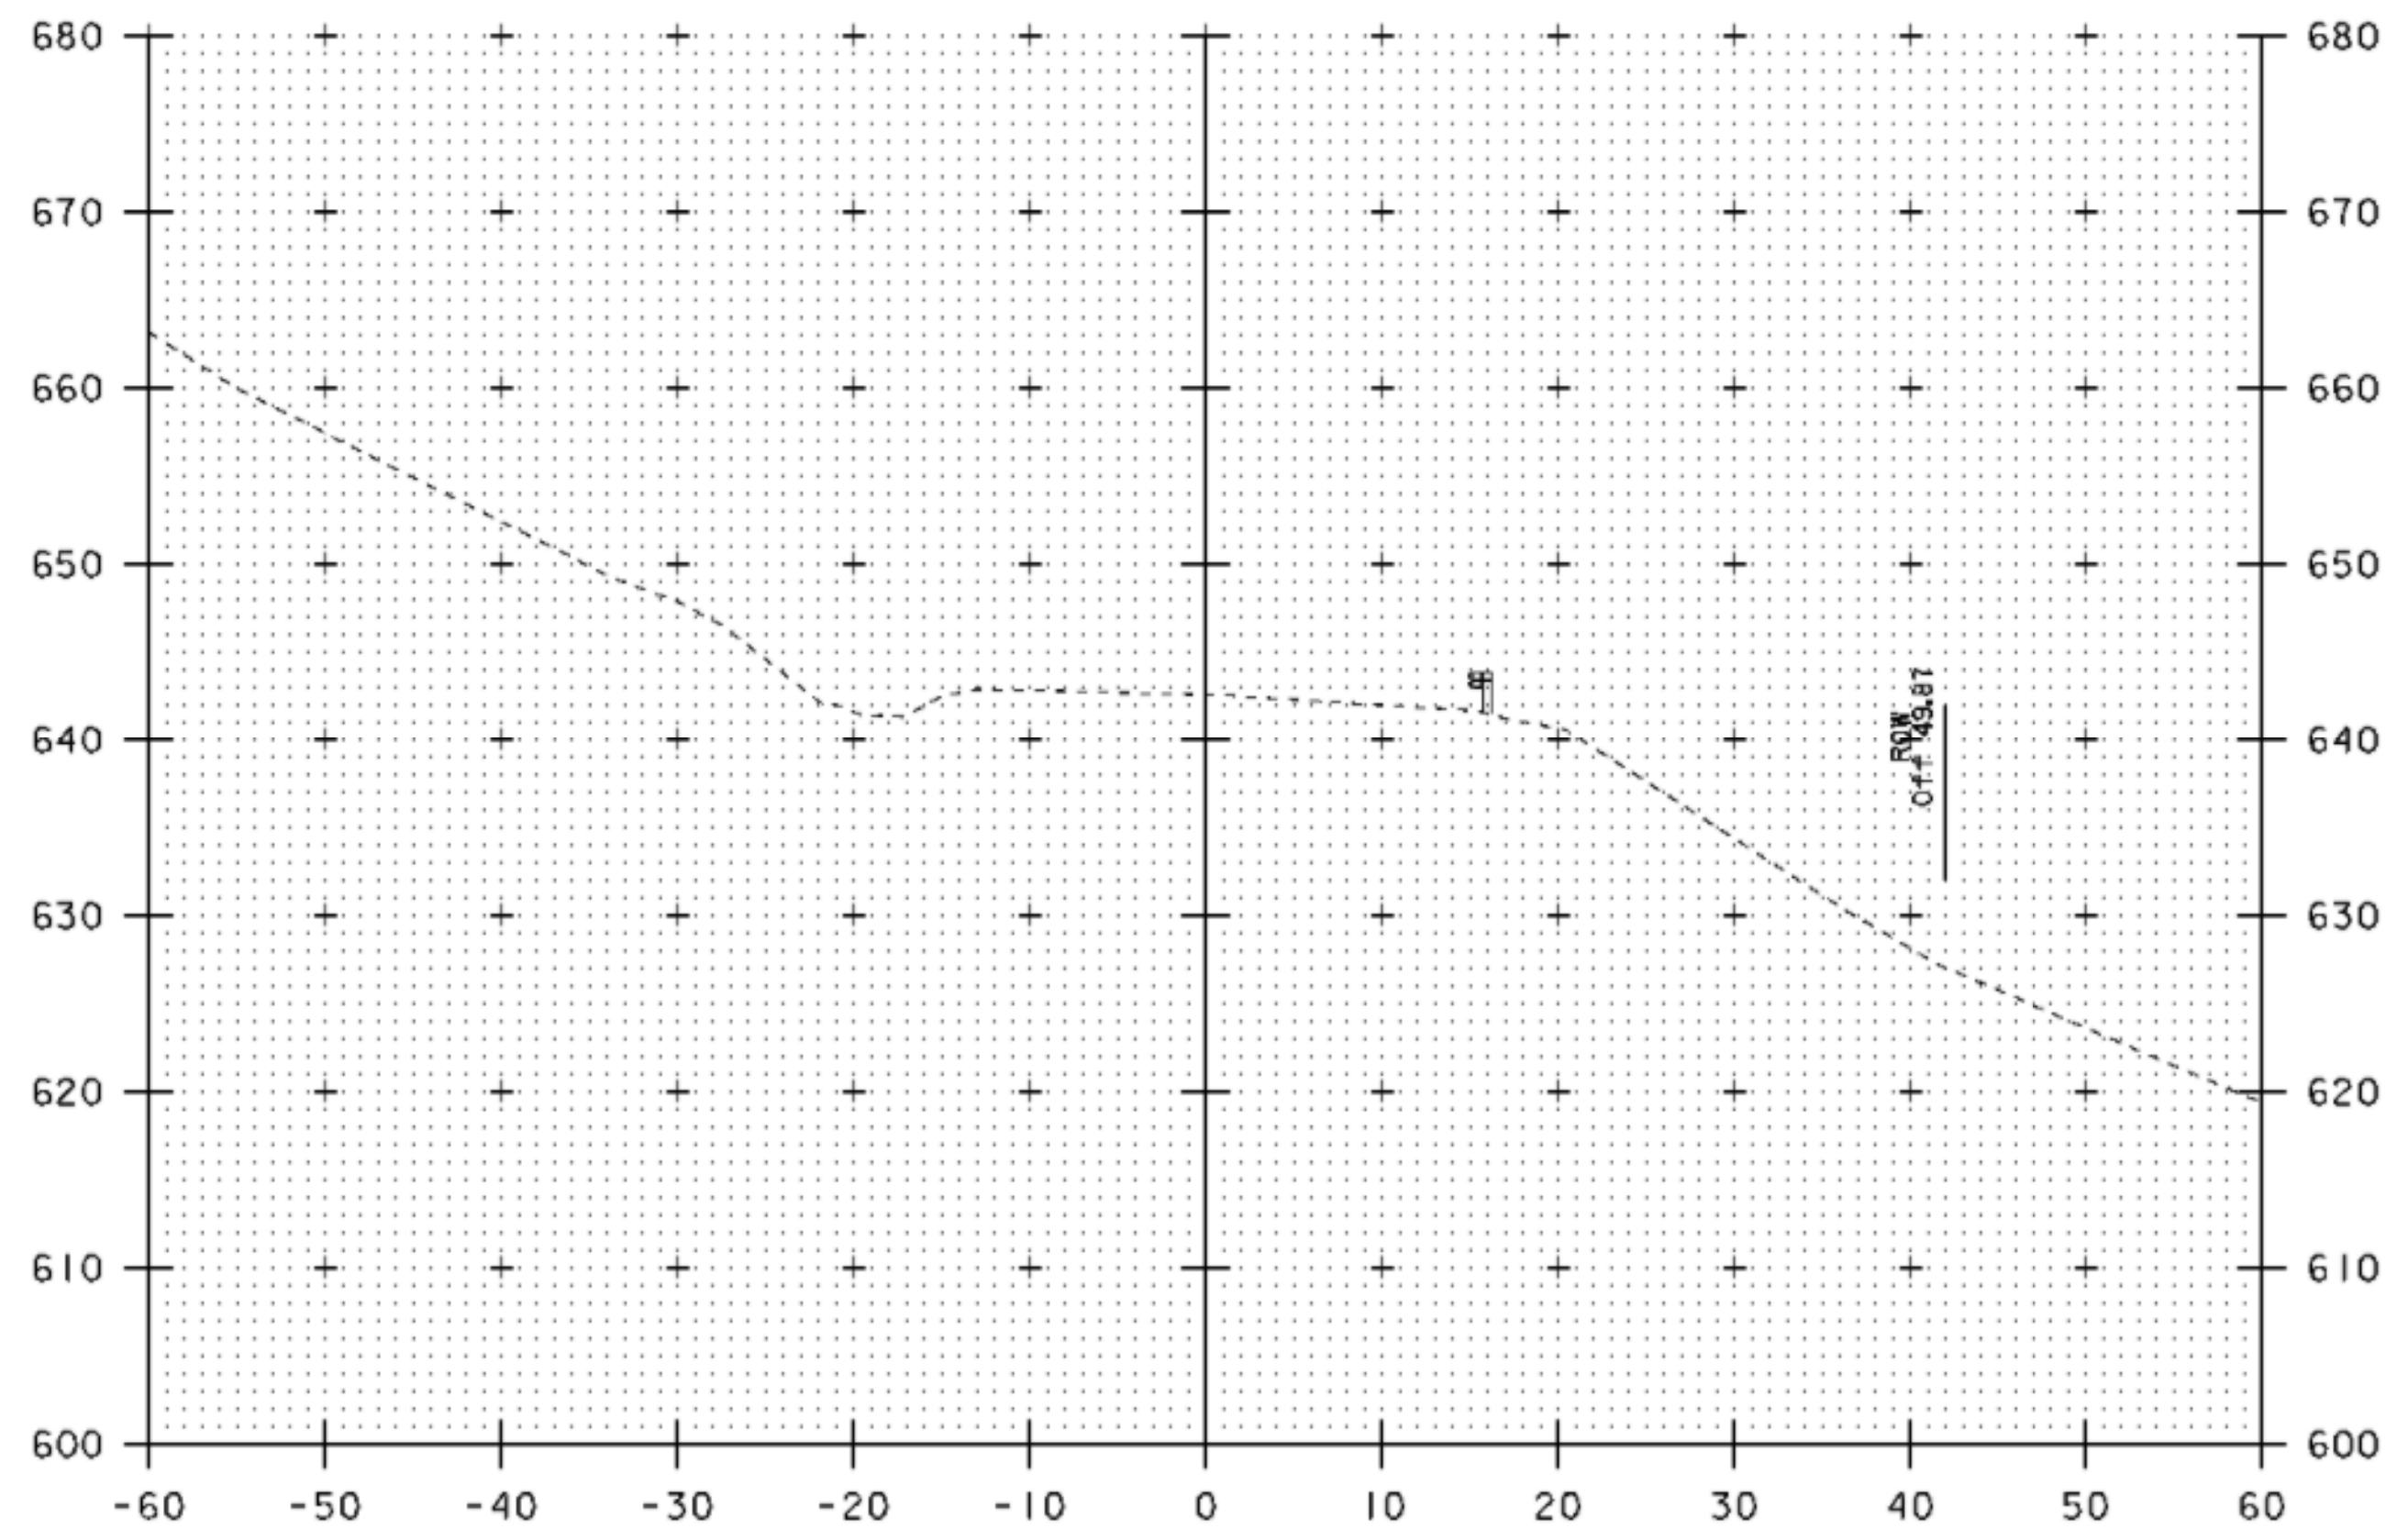

20+25

MAINLINE CROSS SECTIONS 19+75 TO 20+25

PROJECT NAME:	CAMBRIDGE	PLOT DATE:	28-JUL-2009
PROJECT NUMBER:	STP 0235(9)	DRAWN BY:	N. PAPPAS
FILE NAME:	D07C152WRK.DGN	CHECKED BY:	S. MENARD
PROJECT LEADER:	K. ROBBE	SHEET	26 OF 28
DESIGNED BY:	N. PAPPAS		
IPARM:	d07x152_xs_10		