



SEE SHEET 15 FOR VT 102 & US 2 DETAIL

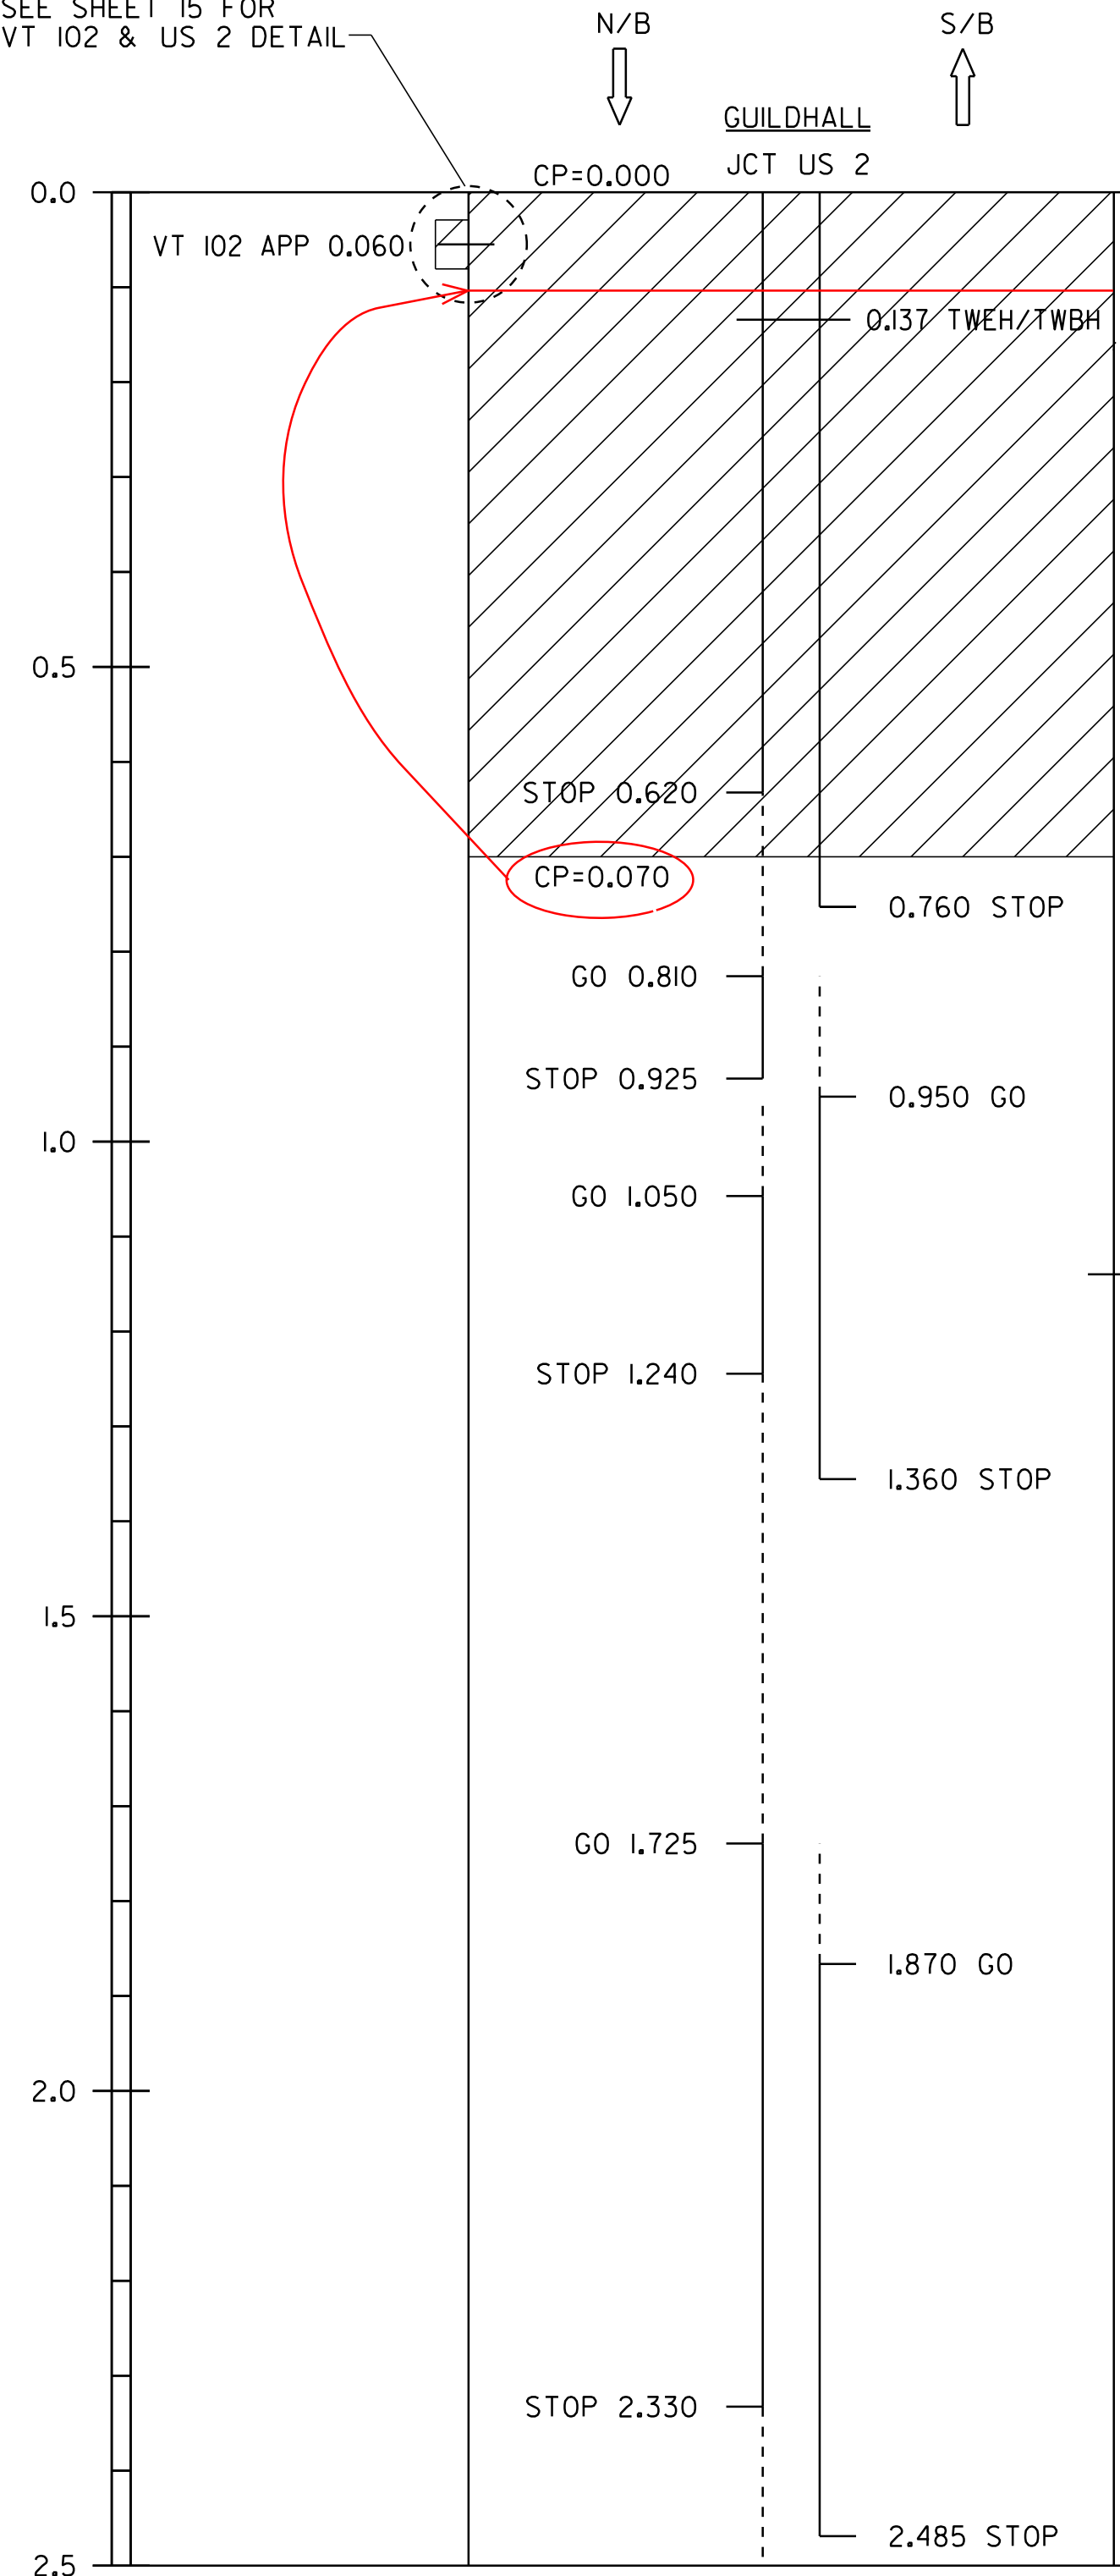

**BEGIN STP 2706 (1)
MM 0.000**

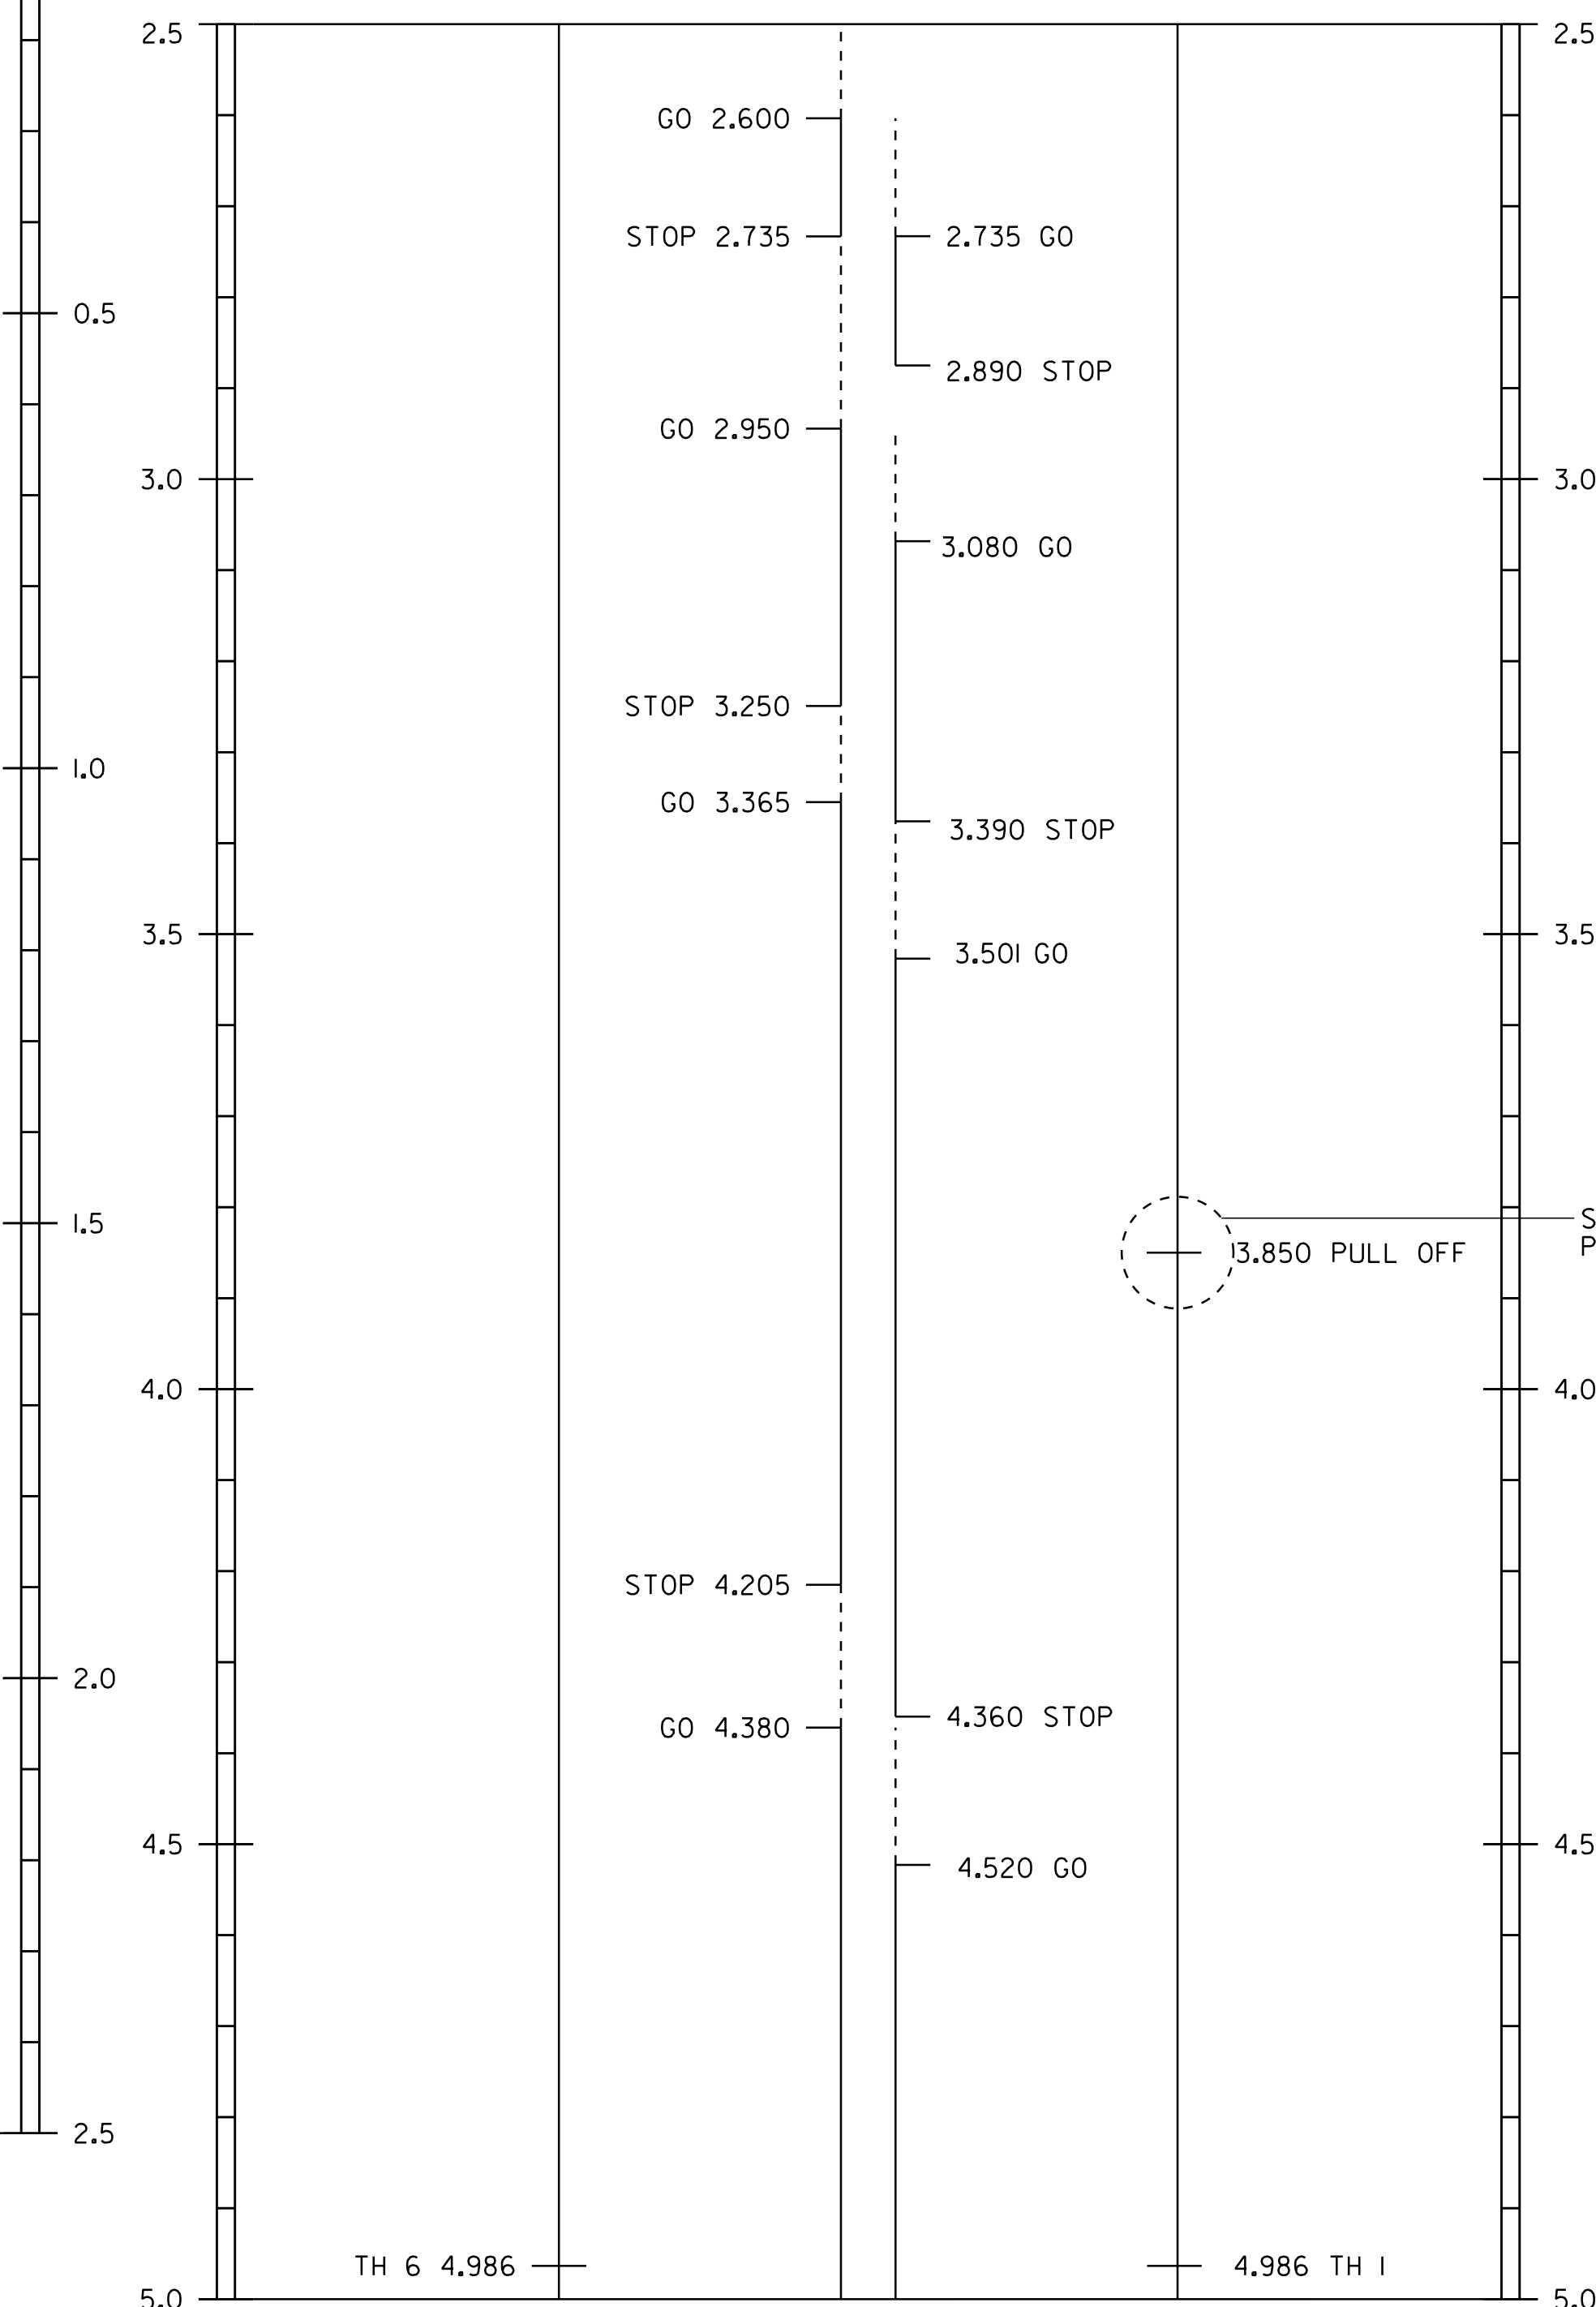

SEE NEXT SHEET

- 646.402 DURABLE 4" WHITE LINE, THERMOPLASTIC
- 646.602 TEMPORARY 4" WHITE LINE, PAINT
- MM 0.000 TO MM 5.000 LT & RT, SOLID EDGE LINE (INCLUDES GAP FOR TOWN HIGWAYS)
- MM 1.131 LT & RT, TH 8, SOLID EDGE LINE
- MM 4.986 LT & RT, TH 1, SOLID EDGE LINE
- MM 4.986 LT & RT, TH 6, SOLID EDGE LINE
- 646.412 DURABLE 4" YELLOW LINE, THERMOPLASTIC
- 646.612 TEMPORARY 4" YELLOW LINE, PAINT
- MM 0.000 TO MM 0.620 LT & RT, DOUBLE SOLID CL
- MM 0.620 TO MM 0.760, DASH RT, SOLID LT
- MM 0.760 TO MM 0.810, DASH RT
- MM 0.810 TO MM 0.925, DASH LT, SOLID RT
- MM 0.925 TO MM 0.950, DASH LT
- MM 0.950 TO MM 1.050, DASH RT, SOLID LT
- MM 1.050 TO MM 1.240 LT & RT, DOUBLE SOLID CL (INCLUDES 40' GAP FOR TOWN HIGWAYS)
- MM 1.131 LT & RT, TH 8, DOUBLE SOLID CL
- MM 1.240 TO MM 1.360, DASH RT, SOLID LT
- MM 1.360 TO MM 1.725, DASH RT
- MM 1.725 TO MM 1.870, DASH LT, SOLID RT
- MM 1.870 TO MM 2.330 LT & RT, DOUBLE SOLID CL
- MM 2.330 TO MM 2.485, DASH RT, SOLID LT
- MM 2.485 TO MM 2.600, DASH RT
- MM 2.600 TO MM 2.735, DASH LT, SOLID RT
- MM 2.735 TO MM 2.890, DASH RT, SOLID LT
- MM 2.890 TO MM 2.950, DASH RT
- MM 2.950 TO MM 3.080, DASH LT, SOLID RT
- MM 3.080 TO MM 3.250 LT & RT, DOUBLE SOLID CL
- MM 3.250 TO MM 3.365, DASH RT, SOLID LT
- MM 3.365 TO MM 3.390 LT & RT, DOUBLE SOLID CL
- MM 3.390 TO MM 3.501, DASH LT, SOLID RT
- MM 3.501 TO MM 4.205 LT & RT, DOUBLE SOLID CL
- MM 4.205 TO MM 4.360, DASH RT, SOLID LT
- MM 4.360 TO MM 4.380, DASH RT
- MM 4.380 TO MM 4.520, DASH LT, SOLID RT
- MM 4.520 TO MM 5.000 LT & RT, DOUBLE SOLID CL (INCLUDES 40' GAP FOR TOWN HIGWAYS)
- MM 4.986 LT & RT, TH 1, DOUBLE SOLID CL
- MM 4.986 LT & RT, TH 1, DOUBLE SOLID CL

- 646.482 DURABLE 24" STOP BAR, THERMOPLASTIC
- 646.682 TEMPORARY 24" STOP BAR, PAINT
- ~~MM 0.033 LT~~
- MM 1.131 LT, TH 8
- MM 4.986 LT, TH 1
- MM 4.986 RT, TH 6

- 646.492 DURABLE LETTER OR SYMBOL, THERMOPLASTIC
- 646.692 TEMPORARY LETTER OR SYMBOL, PAINT
- MM 0.008 RT, YIELD SYMBOLS - 3 EA
- ~~MM 0.030 LT, "STOP"~~
- MM 0.164 LT, "STOP AHEAD"
- MM 1.131 LT, TH 8, "STOP"
- MM 4.986 LT, TH 1, "STOP"
- MM 4.986 RT, TH 6, "STOP"

- 621.20 STEEL BEAM GUARDRAIL, GALVANIZED
- MM 0.455 TO MM 0.523 RT
- MM 0.466 TO MM 0.523 LT
- MM 1.314 TO MM 1.347 LT
- MM 1.354 TO MM 1.382 LT

- 621.205 STEEL BEAM GUARDRAIL, GALVANIZED W/8 FEET POSTS
- MM 0.523 TO MM 0.527 RT
- MM 1.338 TO MM 1.347 RT
- MM 1.354 TO MM 1.387 RT
- MM 2.150 TO MM 2.220 RT
- MM 2.195 TO MM 2.225 LT
- MM 4.690 TO MM 4.782 RT
- MM 4.789 TO MM 4.808 RT
- MM 4.749 TO MM 4.782 LT
- MM 4.789 TO MM 4.833 LT

- 621.206 STEEL BEAM GUARDRAIL, GALVANIZED/NESTED
- MM 1.347 TO MM 1.354 LT

- 621.207 STEEL BEAM GUARDRAIL, GALVANIZED/NESTED W/8 FEET POSTS
- MM 1.347 TO MM 1.354 RT

- 621.50 MANUFACTURED TERMINAL SECTION, FLARED
- MM 0.448 TO MM 0.455 RT
- MM 0.459 TO MM 0.466 LT
- MM 0.523 TO MM 0.530 LT
- MM 1.307 TO MM 1.314 LT
- MM 1.331 TO MM 1.338 RT
- MM 1.382 TO MM 1.389 LT
- MM 1.387 TO MM 1.394 RT
- MM 2.143 TO MM 2.150 RT
- MM 2.220 TO MM 2.227 RT
- MM 4.742 TO MM 4.749 LT
- MM 4.683 TO MM 4.690 RT
- MM 4.808 TO MM 4.815 RT
- MM 4.833 TO MM 4.840 LT

- 621.60 ANCHOR FOR STEEL BEAM RAIL
- MM 0.527 RT
- MM 2.195 LT
- MM 2.225 LT

- 621.80 REMOVAL AND DISPOSAL OF GUARDRAIL
- MM 1.295 TO MM 1.370 LT
- MM 1.310 TO MM 1.370 RT
- MM 4.685 TO MM 4.805 RT
- MM 4.750 TO MM 4.823 LT

- 621.81 REMOVAL AND DISPOSAL OF GUIDE POSTS
- MM 0.455 TO MM 0.475 RT
- MM 0.485 TO MM 0.510 LT
- MM 2.165 TO MM 2.210 RT
- MM 2.195 TO MM 2.225 LT

- 675.20 TRAFFIC SIGN, TYPE A
- 675.341 SQUARE TUBE SIGN POST AND ANCHOR
- 675.50 REMOVING SIGNS
- 675.60 ERECTING SALVAGED SIGNS
- SEE TRAFFIC SIGN SUMMARY SHEETS FOR ALL SIGN INFORMATION

LEGEND

COLD PLANE AREAS

NOT TO SCALE

PROJECT LAYOUT SHEET #1	PROJECT NAME: GUILDHALL-MAIDSTONE
	PROJECT NUMBER: STP 2706 (1)
FILE NAME: ...07C162\...07C162.dgn	PLOT DATE: 31-OCT-2011 10:43
PROJECT LEADER: DOMEY	DRAWN BY: PAVT MGMT
DESIGNED BY: PAVT MGMT	CHECKED BY: PAVT MGMT
IPARM FILE NAME: 07C162_09.i	SHEET 9 OF 18