


END STP 2706 (1)
MM 2.835

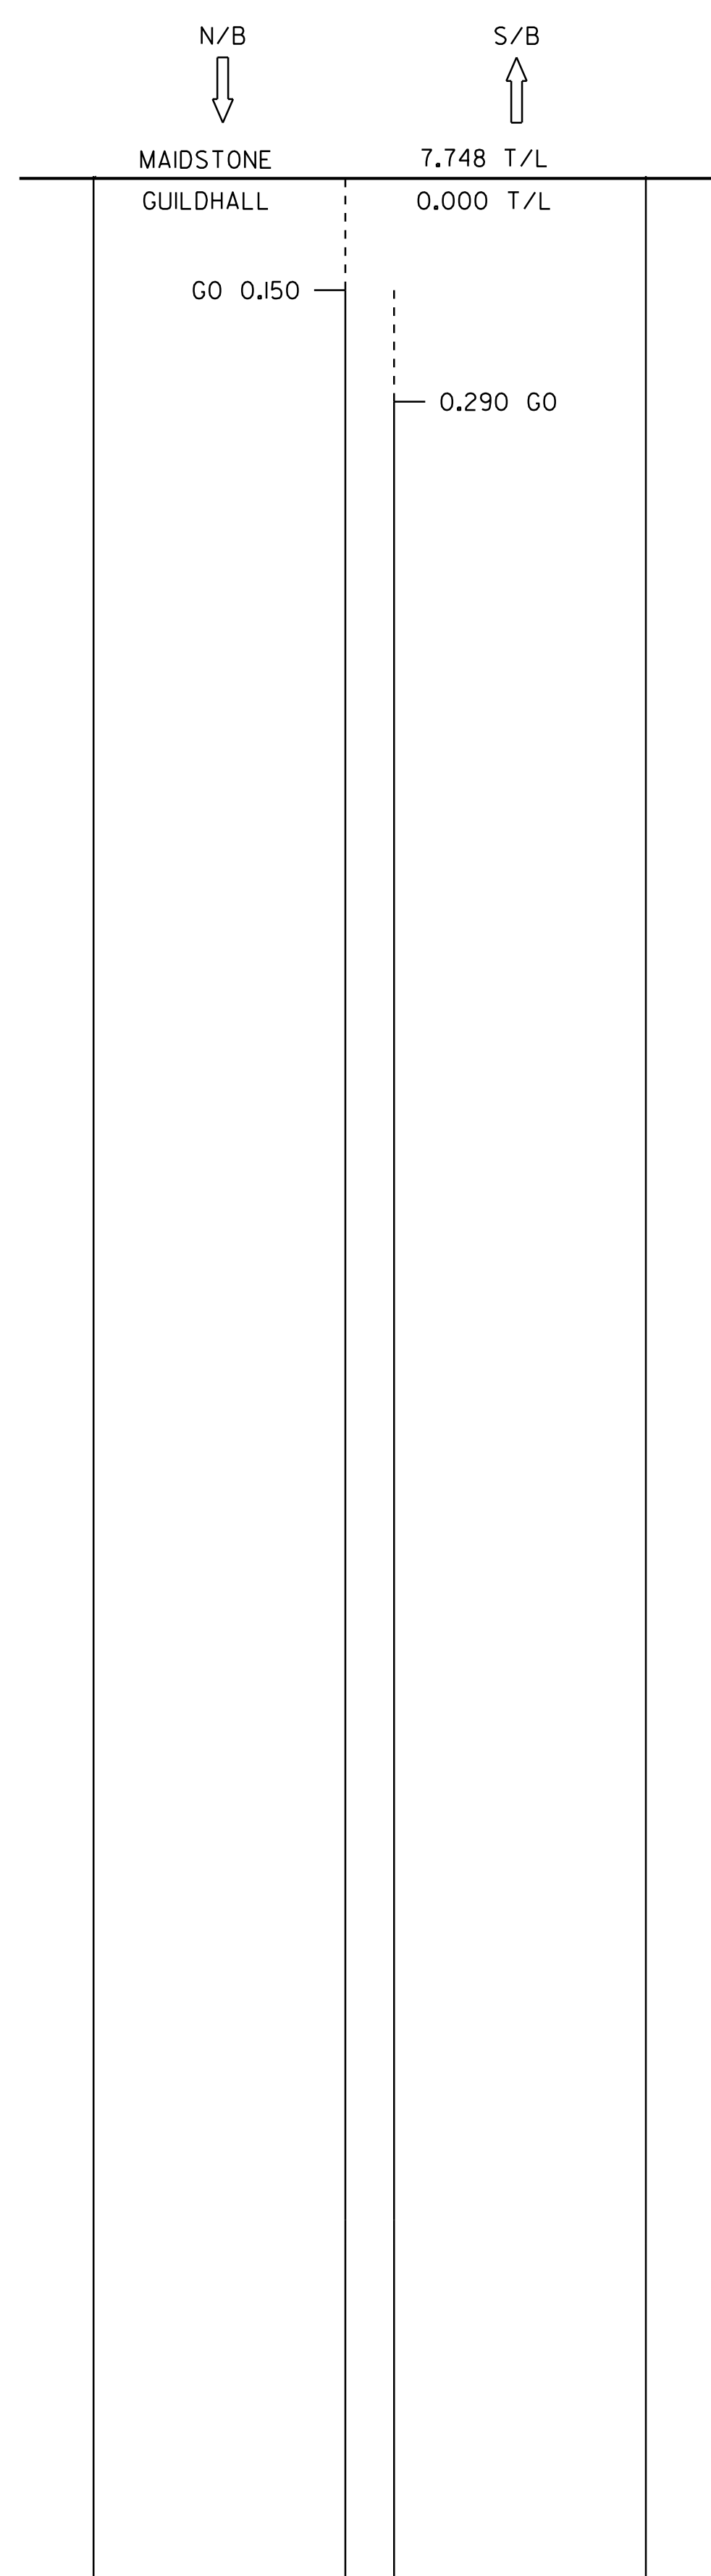

- 646.402 DURABLE 4" WHITE LINE, THERMOPLASTIC
- 646.602 TEMPORARY 4" WHITE LINE, PAINT
- GUILDHALL
- MM 5.000 TO MM 7.748 LT & RT, SOLID EDGE LINE (INCLUDES GAP FOR TOWN HIGWAYS)
- MM 5.830 LT & RT, TH 3, SOLID EDGE LINE
- MM 7.137 LT & RT, TH 4, SOLID EDGE LINE
- MM 7.253 LT & RT, TH 4, SOLID EDGE LINE
- MAIDSTONE
- MM 0.000 TO MM 2.835 LT & RT, SOLID EDGE LINE

- 646.412 DURABLE 4" YELLOW LINE, THERMOPLASTIC
- 646.612 TEMPORARY 4" YELLOW LINE, PAINT
- GUILDHALL
- MM 5.000 TO MM 5.840 LT & RT, DOUBLE SOLID CL (INCLUDES 40' GAP FOR TOWN HIGWAYS)
- MM 5.830 LT & RT, TH 3, DOUBLE SOLID CL
- MM 5.840 TO MM 5.920, DASHED RT, SOLID LT
- MM 5.920 TO MM 6.000, DASH LT
- MM 6.000 TO MM 6.150, SOLID RT, DASH LT
- MM 6.150 TO MM 6.165 LT & RT, DOUBLE SOLID CL
- MM 6.165 TO MM 6.310, DASH RT, SOLID LT
- MM 6.310 TO MM 6.810, DASH LT
- MM 6.810 TO MM 6.890, SOLID RT, DASH LT
- MM 6.890 TO MM 7.445 LT & RT, DOUBLE SOLID CL
- MM 7.445 TO MM 7.590, DASH RT, SOLID LT
- MM 7.590 TO MM 7.747, DASH RT (INCLUDES 40' GAP FOR TOWN HIGWAYS)
- MM 7.137 LT & RT, TH 4, DOUBLE SOLID CL
- MM 7.253 LT & RT, TH 4, DOUBLE SOLID CL
- MAIDSTONE
- MM 0.000 TO MM 2.835 LT & RT, DOUBLE SOLID CL

- 525.50 BRIDGE RAILING REPAIR, TYPE I
- GUILDHALL
- MM 5.414 TO MM 5.418 LT
- MM 5.414 TO MM 5.418 RT (SEE SHEET 17 FOR DETAILS)

- 621.20 STEEL BEAM GUARDRAIL, GALVANIZED
- GUILDHALL
- MM 5.310 TO MM 5.409 LT
- MM 5.855 TO MM 5.905 RT
- MM 5.863 TO MM 5.875 LT
- MM 5.903 TO MM 5.925 LT
- MM 6.270 TO MM 6.321 RT
- MM 7.605 TO MM 7.700 RT
- MAIDSTONE
- MM 0.645 TO MM 0.700 RT
- MM 0.657 TO MM 0.695 LT
- MM 1.816 TO MM 1.888 RT
- MM 1.960 TO MM 2.040 RT
- MM 2.504 TO MM 2.636 RT

- 621.50 MANUFACTURED TERMINAL SECTION, FLARED
- GUILDHALL
- MM 5.303 TO MM 5.310 LT
- MM 5.343 TO MM 5.350 RT
- MM 5.462 TO MM 5.469 RT
- MM 5.479 TO MM 5.486 LT
- MM 5.848 TO MM 5.855 RT
- MM 5.856 TO MM 5.863 LT
- MM 5.905 TO MM 5.912 RT
- MM 5.925 TO MM 5.932 LT
- MM 6.263 TO MM 6.270 RT
- MM 6.321 TO MM 6.328 RT
- MM 7.598 TO MM 7.605 RT
- MAIDSTONE
- MM 0.650 TO MM 0.657 LT
- MM 0.695 TO MM 0.702 LT
- MM 1.809 TO MM 1.816 RT
- MM 1.953 TO MM 1.960 RT
- MM 2.040 TO MM 2.047 RT
- MM 2.497 TO MM 2.504 RT
- MM 2.636 TO MM 2.643 RT

- 621.60 ANCHOR FOR STEEL BEAM RAIL
- GUILDHALL
- MM 7.700 RT
- MAIDSTONE
- MM 0.645 RT
- MM 0.700 RT
- MM 1.888 RT

- 621.80 REMOVAL AND DISPOSAL OF GUARDRAIL
- GUILDHALL
- MM 5.320 TO MM 5.420 LT
- MM 5.350 TO MM 5.460 RT
- MM 5.855 TO MM 5.905 RT
- MM 5.865 TO MM 5.895 LT
- MM 6.275 TO MM 6.315 RT
- MM 7.605 TO MM 7.690 RT
- MAIDSTONE
- MM 0.649 TO MM 0.695 RT
- MM 0.657 TO MM 0.695 LT
- MM 1.816 TO MM 1.885 RT
- MM 1.960 TO MM 2.040 RT
- MM 2.510 TO MM 2.635 RT

- 675.20 TRAFFIC SIGN, TYPE A
- 675.341 SQUARE TUBE SIGN POST AND ANCHOR
- 675.50 REMOVING SIGNS
- 675.60 ERECTING SALVAGED SIGNS
- SEE TRAFFIC SIGN SUMMARY SHEETS FOR ALL SIGN INFORMATION

- 646.482 DURABLE 24" STOP BAR, THERMOPLASTIC
- 646.682 TEMPORARY 24" STOP BAR, PAINT
- GUILDHALL
- MM 5.830 LT, TH 3
- MM 7.137 LT, TH 4
- MM 7.253 LT, TH 4

- 646.492 DURABLE LETTER OR SYMBOL, THERMOPLASTIC
- 646.692 TEMPORARY LETTER OR SYMBOL, PAINT
- GUILDHALL
- MM 5.830 LT, TH 3, "STOP"
- MM 6.920 LT, "SCHOOL"
- MM 7.055 RT, "SCHOOL"
- MM 7.137 LT, TH 4, "STOP"
- MM 7.253 LT, TH 4, "STOP"

- 621.205 STEEL BEAM GUARDRAIL, GALVANIZED W/8 FEET POSTS
- GUILDHALL
- MM 5.425 TO MM 5.479 LT
- MM 5.350 TO MM 5.409 RT
- MM 5.425 TO MM 5.462 RT
- MM 5.875 TO MM 5.903 LT

- 621.70 GUARDRAIL APPROACH SECTION, GALVANIZED TYPE I
- GUILDHALL
- MM 5.409 TO MM 5.414 LT
- MM 5.409 TO MM 5.414 RT (SEE SHEET 17 FOR DETAILS)

- 621.71 GUARDRAIL APPROACH SECTION, GALVANIZED TYPE II
- GUILDHALL
- MM 5.418 TO MM 5.425 LT
- MM 5.418 TO MM 5.425 RT (SEE SHEET 17 FOR DETAILS)

LEGEND

COLD PLANE AREAS

NOT TO SCALE

PROJECT LAYOUT SHEET #2	PROJECT NAME: GUILDHALL-MAIDSTONE	
	PROJECT NUMBER: STP 2706 (1)	
	FILE NAME: ...07C162\...07C162.dgn	PLOT DATE: 31-OCT-2010 10:43
PROJECT LEADER: DOMEY	DRAWN BY: PAVT MGMT	
DESIGNED BY: PAVT MGMT	CHECKED BY: PAVT MGMT	
IPARM FILE NAME: 07C162_10.1	SHEET 10 OF 18	