





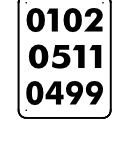


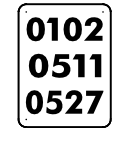

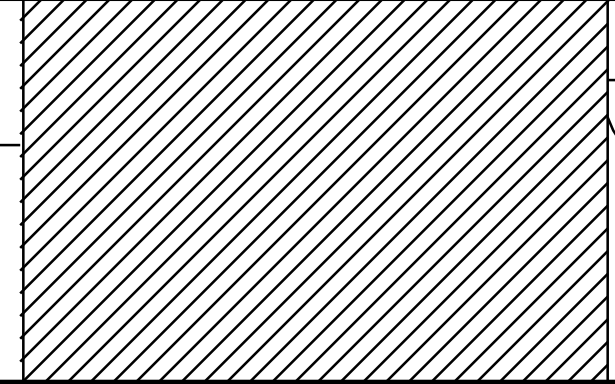


KILOMETER MARKER, STATION, OR SIGN NUMBER	SIGN LEGEND	SIGN DIMENSIONS			NEW, SALVAGED & SIGNS TO BE REMOVED			EXISTING POSTS		675.34I SQUARE TUBE SIGN POST AND ANCHOR					REMARKS	SIGN DETAIL		
		EACH	WIDTH (in)	HEIGHT (in)	675.20 TRAFFIC SIGNS, TYPE A	675.50 REMOVING SIGNS	675.60 ERECTING SALVAGED SIGNS	RETAIN	SALVAGE	NO. OF POSTS	SQUARE STEEL (in)			ANCHORS		MOUNTS	DETAIL ON SHEET NUMBER	STD. SHEET NUMBER
											1.75	2.0	2.5					

MM 4.986 LTH 1	  	1	30/6	30/10	6.25/0.42	2	1			1							SALVAGE STREET SIGN RI-1/ VD-700 (MOUNTED BACK TO BACK)		
MM 4.986 LTH 1		1	24	30	5.00	1			1								VR-017		
MM 4.986 RTH 6	  	1	30/6	30/10	6.25/0.42	2	1			1							SALVAGE STREET SIGN RI-1/ VD-700 (MOUNTED BACK TO BACK)		
MM 4.986 RTH 6		1	24	30	5.00	1			1								VR-017		
MM 5.273 LTH 5	 	1	30/6	30/10	6.25/0.42	1			1								RI-1/ VD-700 (MOUNTED BACK TO BACK)		
MM 5.290 LTH 5		1	24	30	5.00	1			1								VR-017		

FINAL POST LENGTHS ARE TO BE DETERMINED IN THE FIELD. POST SIZES ARE COMPUTED BASED ON INFORMATION FURNISHED ON THE STANDARD SHEET AND THE VTRANS SIGN POST DESIGN GUIDELINE.	SF	EA	EA		FT	FT	FT	<b>TRAFFIC SIGN SUMMARY SHEET #2</b>	PROJECT NAME: GUILDHALL-MAIDSTONE PROJECT NUMBER: STP 2706 (I)
	TOTALS	35.01	10		2	90	90		90