

646.402 DURABLE 4" WHITE LINE, THERMOPLASTIC
 646.602 TEMPORARY 4" WHITE LINE, PAINT
 MM 0.000 TO MM 0.068 RT, VT 102 APPROACH, SOLID EDGE LINE
 MM 0.009 TO MM 0.033 LT, VT 102 APPROACH, SOLID EDGE LINE
 MM 0.000 TO MM 0.083 LT & RT, TH 2 APPROACH, SOLID EDGE LINE
 MM 0.000 TO MM 0.083 LT & RT, TH 2 APPROACH, SOLID EDGE LINE
 MAINLINE STATIONS ON LAYOUT SHEETS

646.412 DURABLE 4" YELLOW LINE, THERMOPLASTIC
 646.612 TEMPORARY 4" YELLOW LINE, PAINT
 MM 0.000 TO MM 0.040 LT & RT, VT 102 APPROACH, DOUBLE SOLID CL
 MM 0.000 TO MM 0.083 LT & RT, TH 2 APPROACH, DOUBLE SOLID CL
 MM 0.000 TO MM 0.083 LT & RT, TH 2 APPROACH, DOUBLE SOLID CL
 MAINLINE STATIONS ON LAYOUT SHEETS

646.492 DURABLE LETTER OR SYMBOL, THERMOPLASTIC
 646.692 TEMPORARY LETTER OR SYMBOL, PAINT
 MM 0.013 LT, VT 102 APPROACH, "STOP"
 MM 0.036 RT, VT 102 APPROACH, YIELD SYMBOLS - 3 EA
 MM 0.057 LT, TH 2 APPROACH, YIELD SYMBOLS - 3 EA
 MM 0.027 RT, TH 2 APPROACH, YIELD SYMBOLS - 3 EA
 MM 0.035 RT, TH 2 APPROACH, YIELD SYMBOLS - 3 EA
 MAINLINE STATIONS ON LAYOUT SHEETS

646.482 DURABLE 24" STOP BAR, THERMOPLASTIC
 646.682 TEMPORARY 24" STOP BAR, PAINT
 MM 0.009 LT, VT 102 APPROACH
 MAINLINE STATIONS ON LAYOUT SHEETS

675.20 TRAFFIC SIGN, TYPE A
 675.34I SQUARE TUBE SIGN POST AND ANCHOR
 675.50 REMOVING SIGNS
 675.60 ERECTING SALVAGED SIGNS
 SEE TRAFFIC SIGN SUMMARY SHEETS FOR ALL SIGN INFORMATION

604.412 REHAB DROP INLETS, CATCH BASINS, OR MANHOLES, CLASS I
 604.415 REHAB DROP INLETS, CATCH BASINS, OR MANHOLES, CLASS II
 604.418 REHAB DROP INLETS, CATCH BASINS, OR MANHOLES, CLASS III
 TH 2 - 5 EA
 (THE TYPE IS TO BE DETERMINED BY THE RESIDENT ENGINEER)


604.42 CHANGING ELEVATION OF SEWER MANHOLES
 TH 2 - 1EA

MAINLINE STATIONS, SIGNS AND PAVEMENT MARKINGS ARE SHOWN FOR ILLUSTRATIVE PURPOSES ONLY. REFER TO LAYOUT SHEET I FOR CONSTRUCTION NOTES, AND SIGN SUMMARY SHEETS FOR SIGN DETAILS.


DO NOT PLACE THIS STOP BAR & STOP LETTERING

ALL OTHER LETTERING AND SYMBOLS TO REMAIN AS SHOWN.

MAINLINE STATIONS, SIGNS AND PAVEMENT MARKINGS ARE SHOWN FOR ILLUSTRATIVE PURPOSES ONLY. REFER TO LAYOUT SHEET I FOR CONSTRUCTION NOTES.

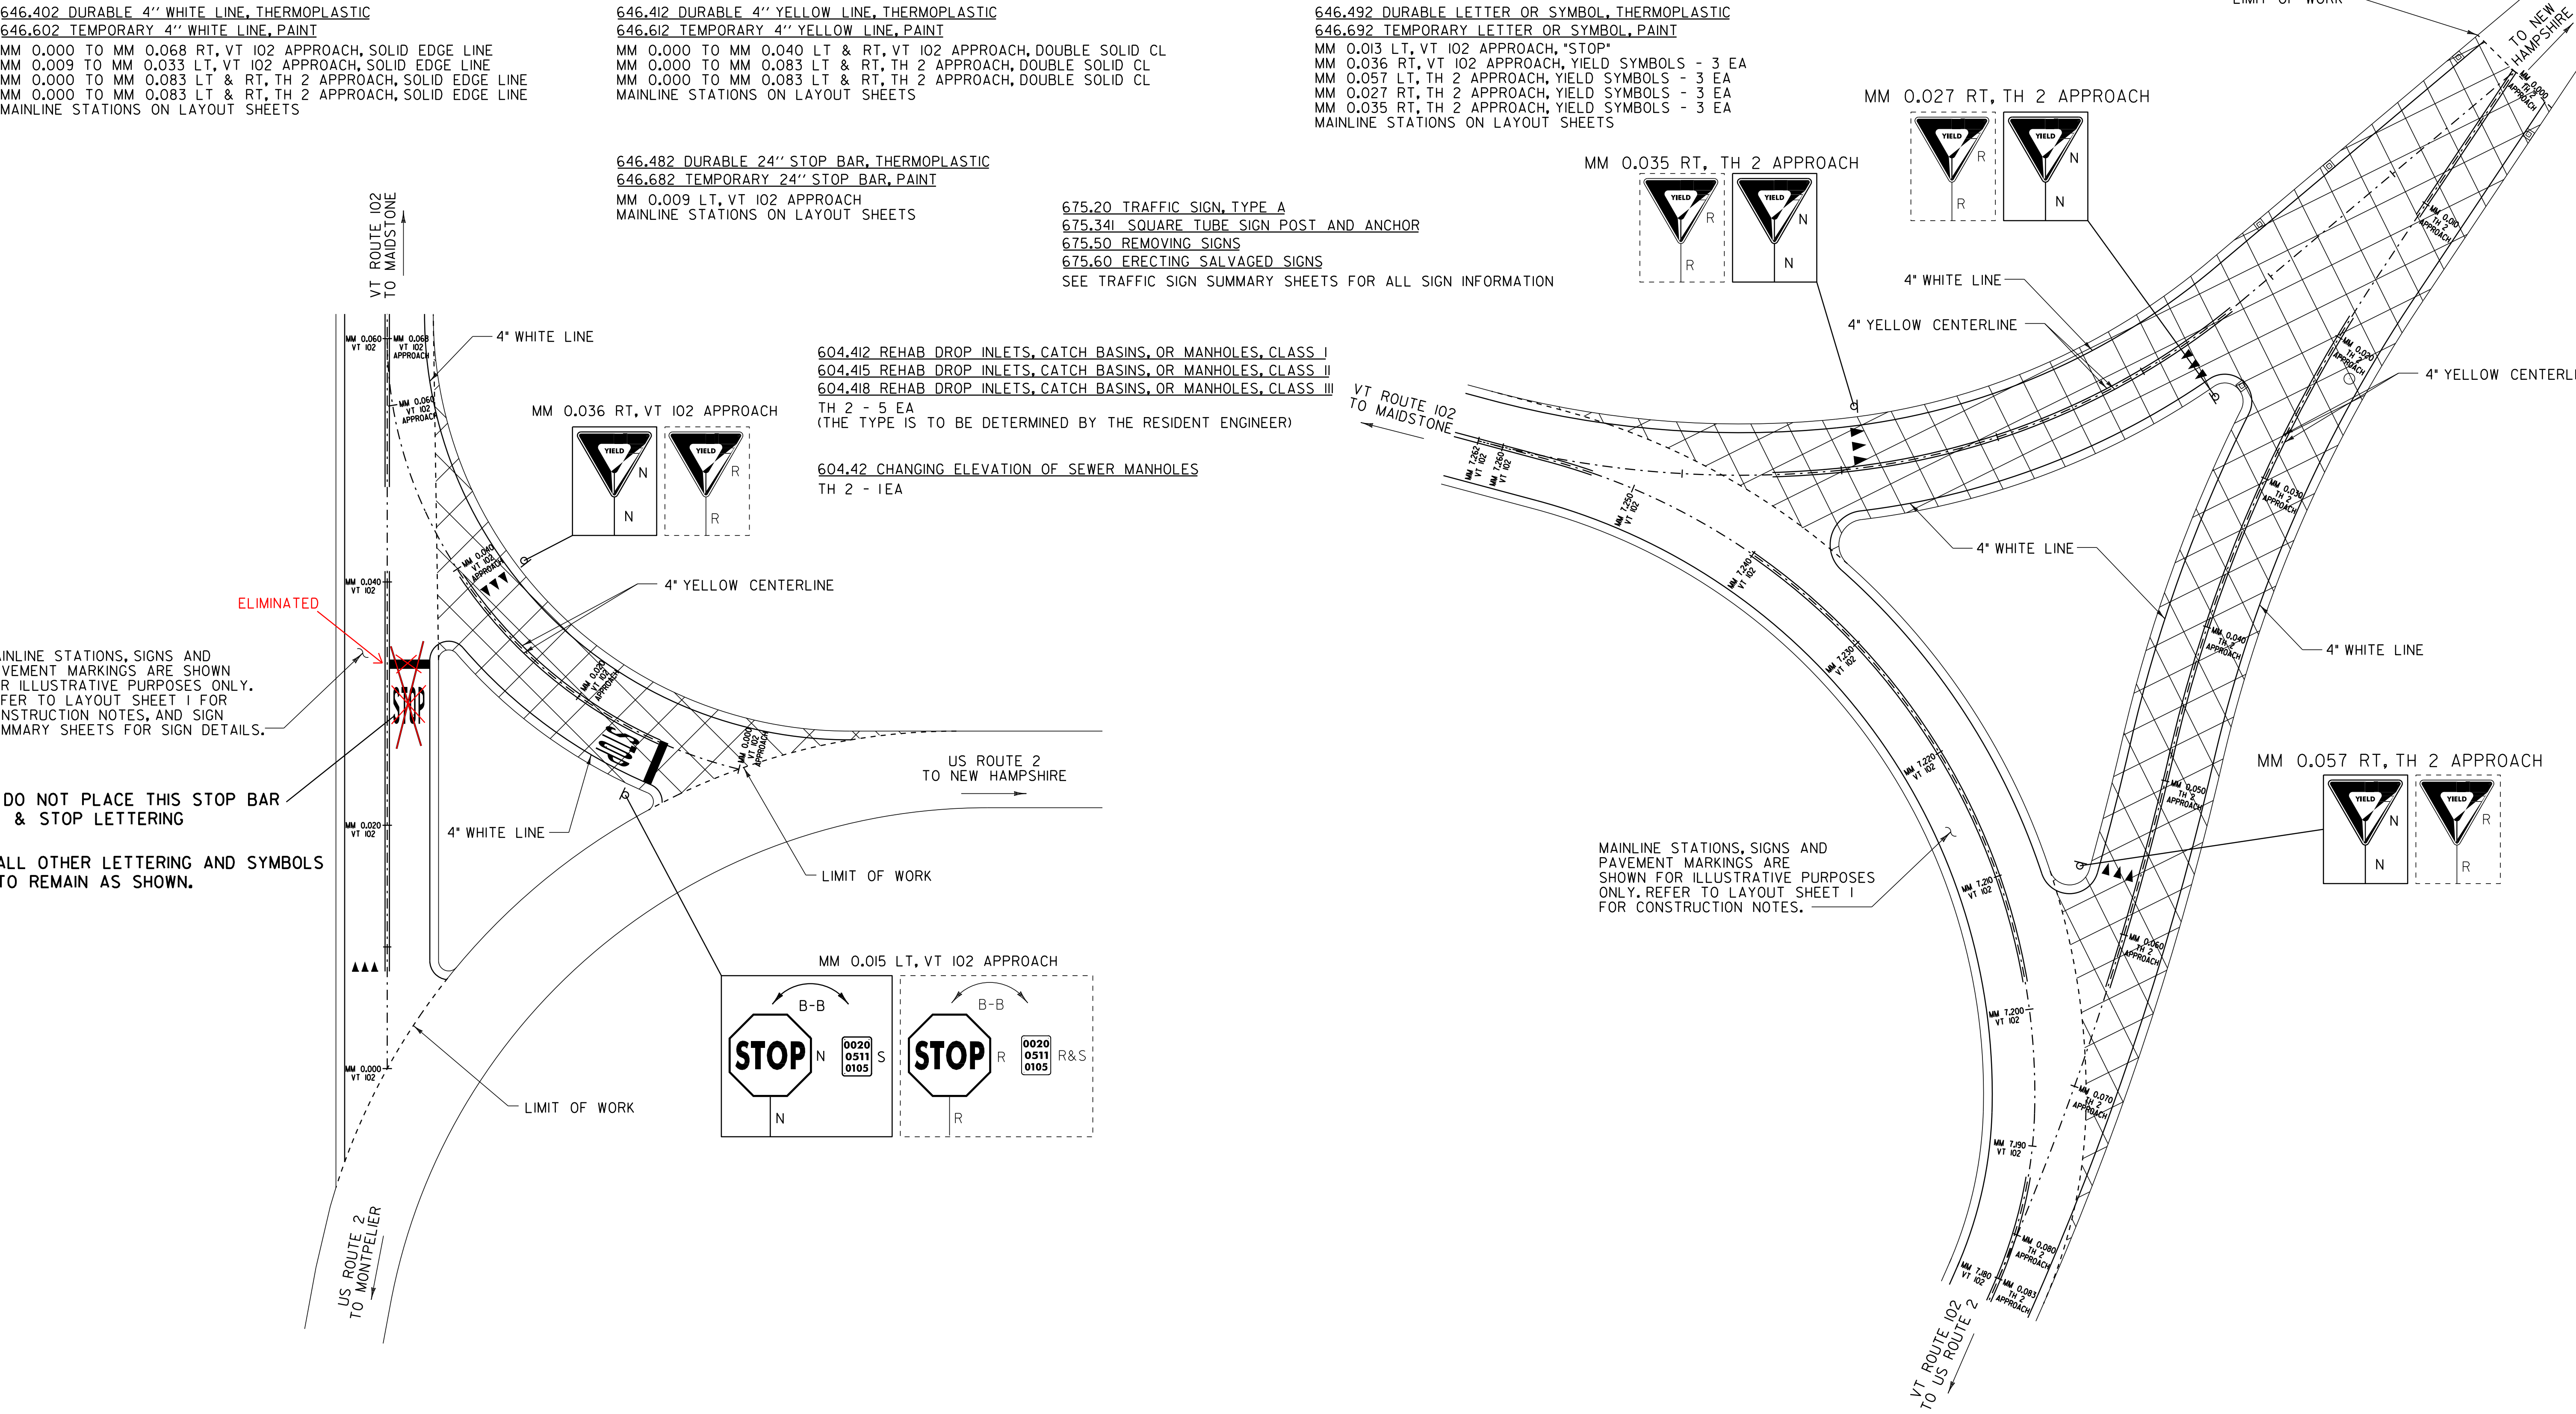

US ROUTE 2 INTERSECTION

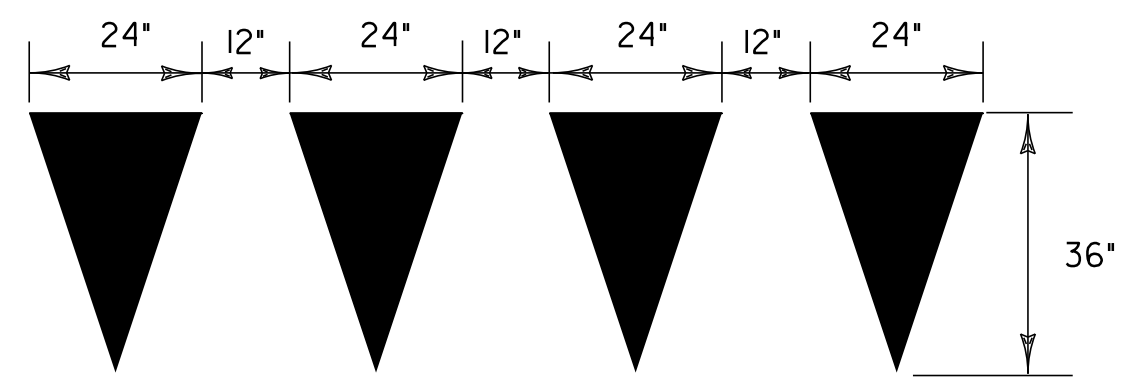

YIELD LINE DETAILS

TO BE PAID AS ONE LETTER OR SYMBOL PER TRIANGLE

TH 2 INTERSECTION



NOT TO SCALE

INTERSECTION DETAIL SHEET #1	PROJECT NAME: GUILDHALL-MAIDSTONE
	PROJECT NUMBER: STP 2706 (I)
	FILE NAME: ...07C162\...07C162.dgn
	IPARM FILE NAME: 07C162_15.1
PROJECT LEADER: DOMEY	PLOT DATE: 31-OCT-2011 10:43
DESIGNED BY: PAVT MGMT	DRAWN BY: PAVT MGMT
CHECKED BY: PAVT MGMT	SHEET 15 OF 18