


646.402 DURABLE 4" WHITE LINE, THERMOPLASTIC
 646.602 TEMPORARY 4" WHITE LINE, PAINT
 MM 5.273 LT & RT, TH 5, SOLID EDGE LINE
 MM 5.303 LT & RT, TH 5, SOLID EDGE LINE
 MAINLINE STATIONS ON LAYOUT SHEETS

646.412 DURABLE 4" YELLOW LINE, THERMOPLASTIC
 646.612 TEMPORARY 4" YELLOW LINE, PAINT
 MM 5.273 LT, TH 5, DOUBLE SOLID CL
 MM 5.303 LT, TH 5, DOUBLE SOLID CL
 MAINLINE STATIONS ON LAYOUT SHEETS

646.482 DURABLE 24" STOP BAR, THERMOPLASTIC
 646.682 TEMPORARY 24" STOP BAR, PAINT
 MM 5.273 LT, TH 5
 MM 5.303 LT, TH 5
 MAINLINE STATIONS ON LAYOUT SHEETS


646.492 DURABLE LETTER OR SYMBOL, THERMOPLASTIC
 646.692 TEMPORARY LETTER OR SYMBOL, PAINT
 MM 5.273 LT, TH 5, "STOP"
 MM 5.303 LT, TH 5, "STOP"
 MM 5.294 LT, TH 5, YIELD SYMBOLS - 3 EA
 MAINLINE STATIONS ON LAYOUT SHEETS

675.20 TRAFFIC SIGN, TYPE A
 675.341 SQUARE TUBE SIGN POST AND ANCHOR
 675.50 REMOVING SIGNS
 675.60 ERECTING SALVAGED SIGNS
 SEE TRAFFIC SIGN SUMMARY SHEETS FOR ALL SIGN INFORMATION

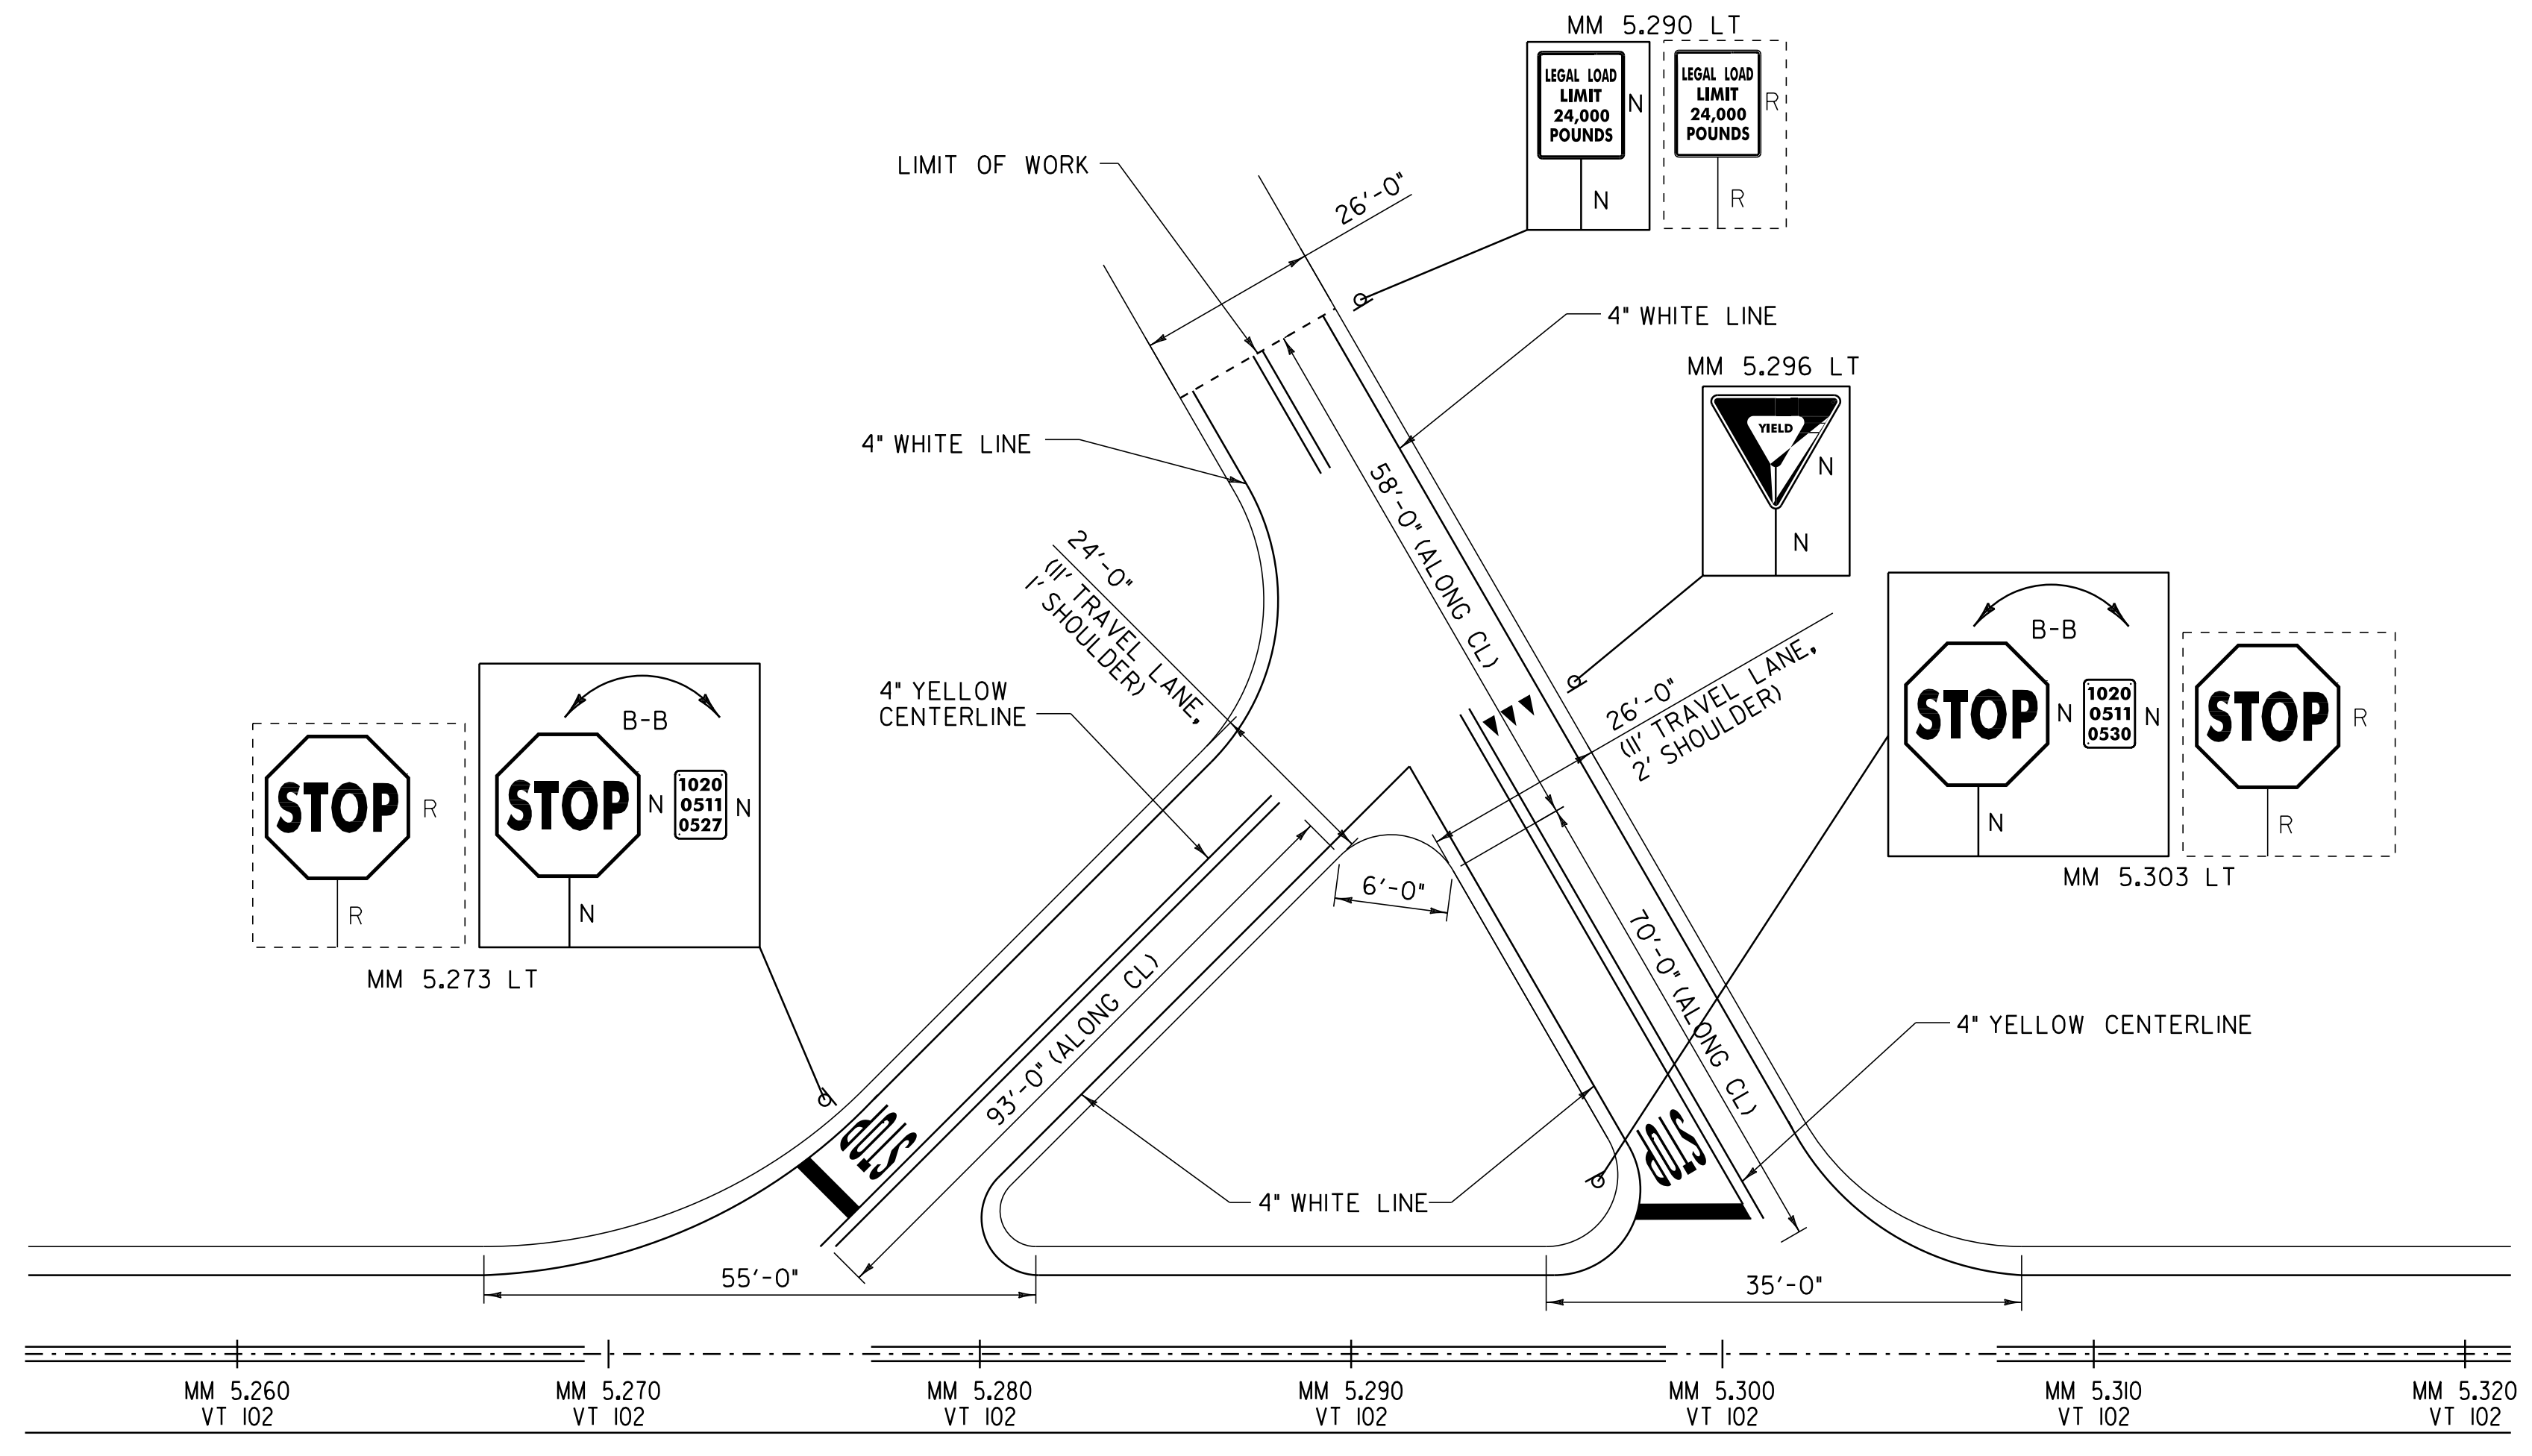


BUILT AS PER PLAN

TH 5 INTERSECTION

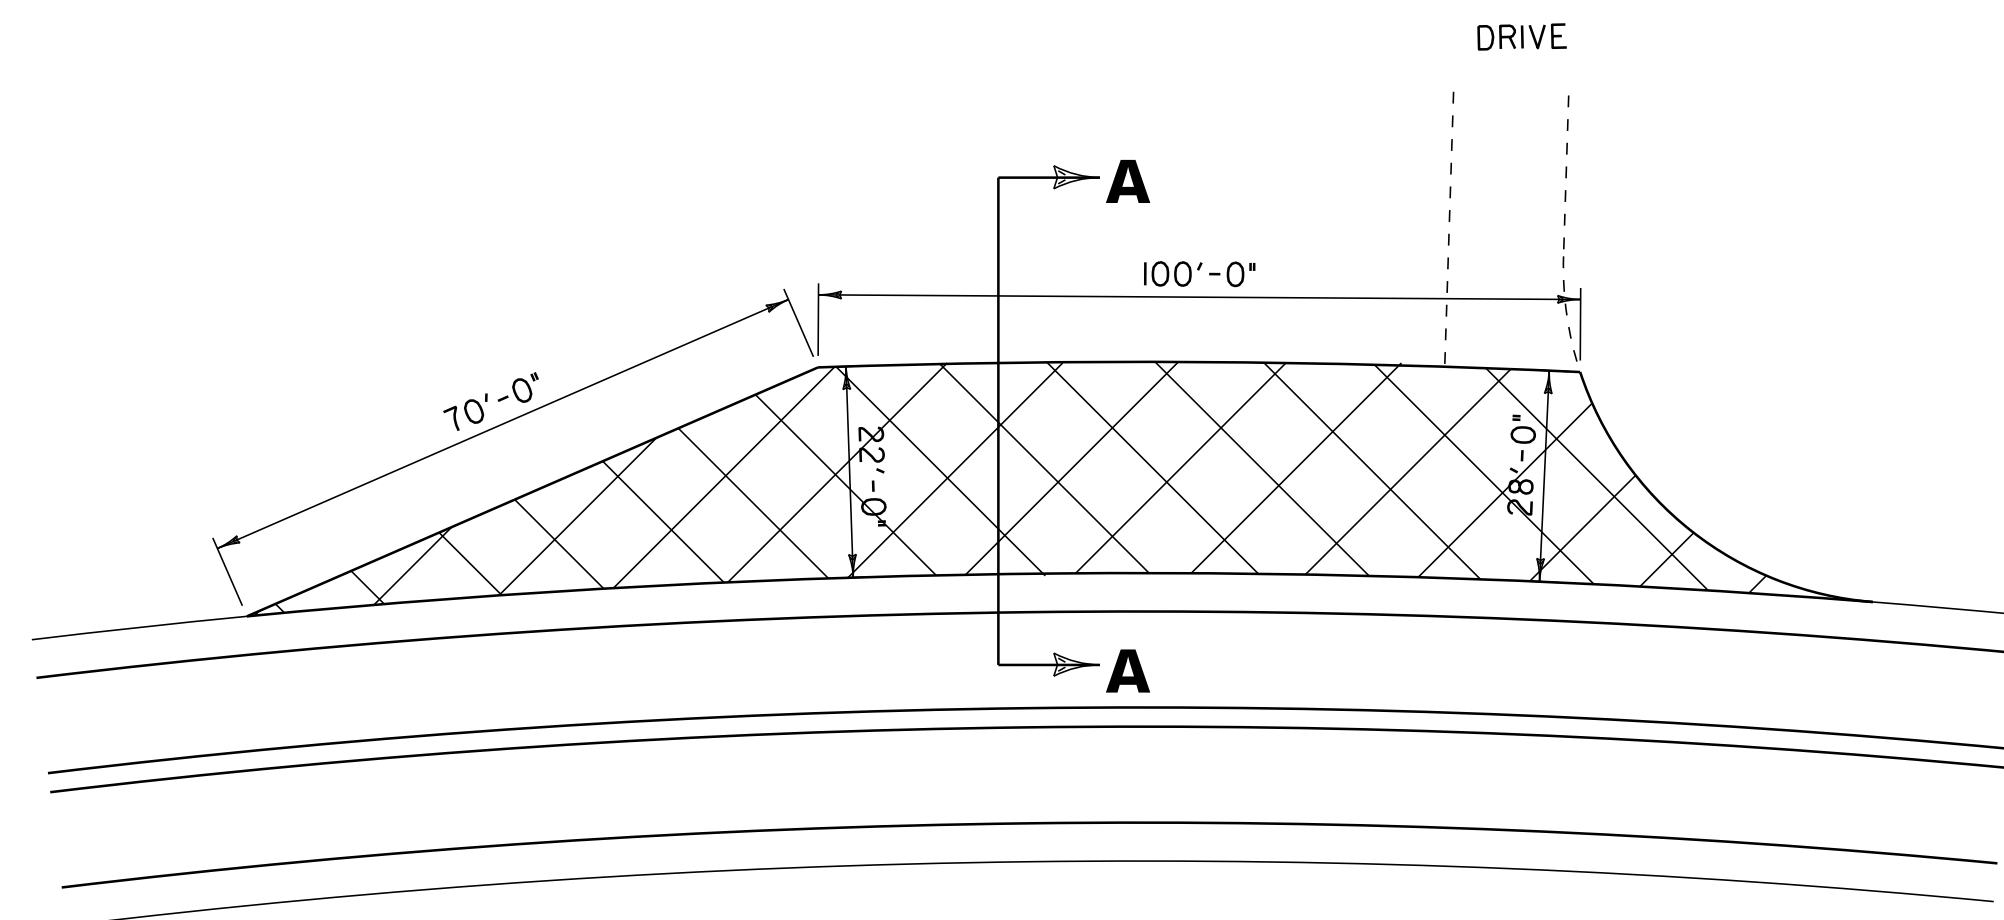

PULL OFF - MM 3.850 LT

AREA TO BE PAVED

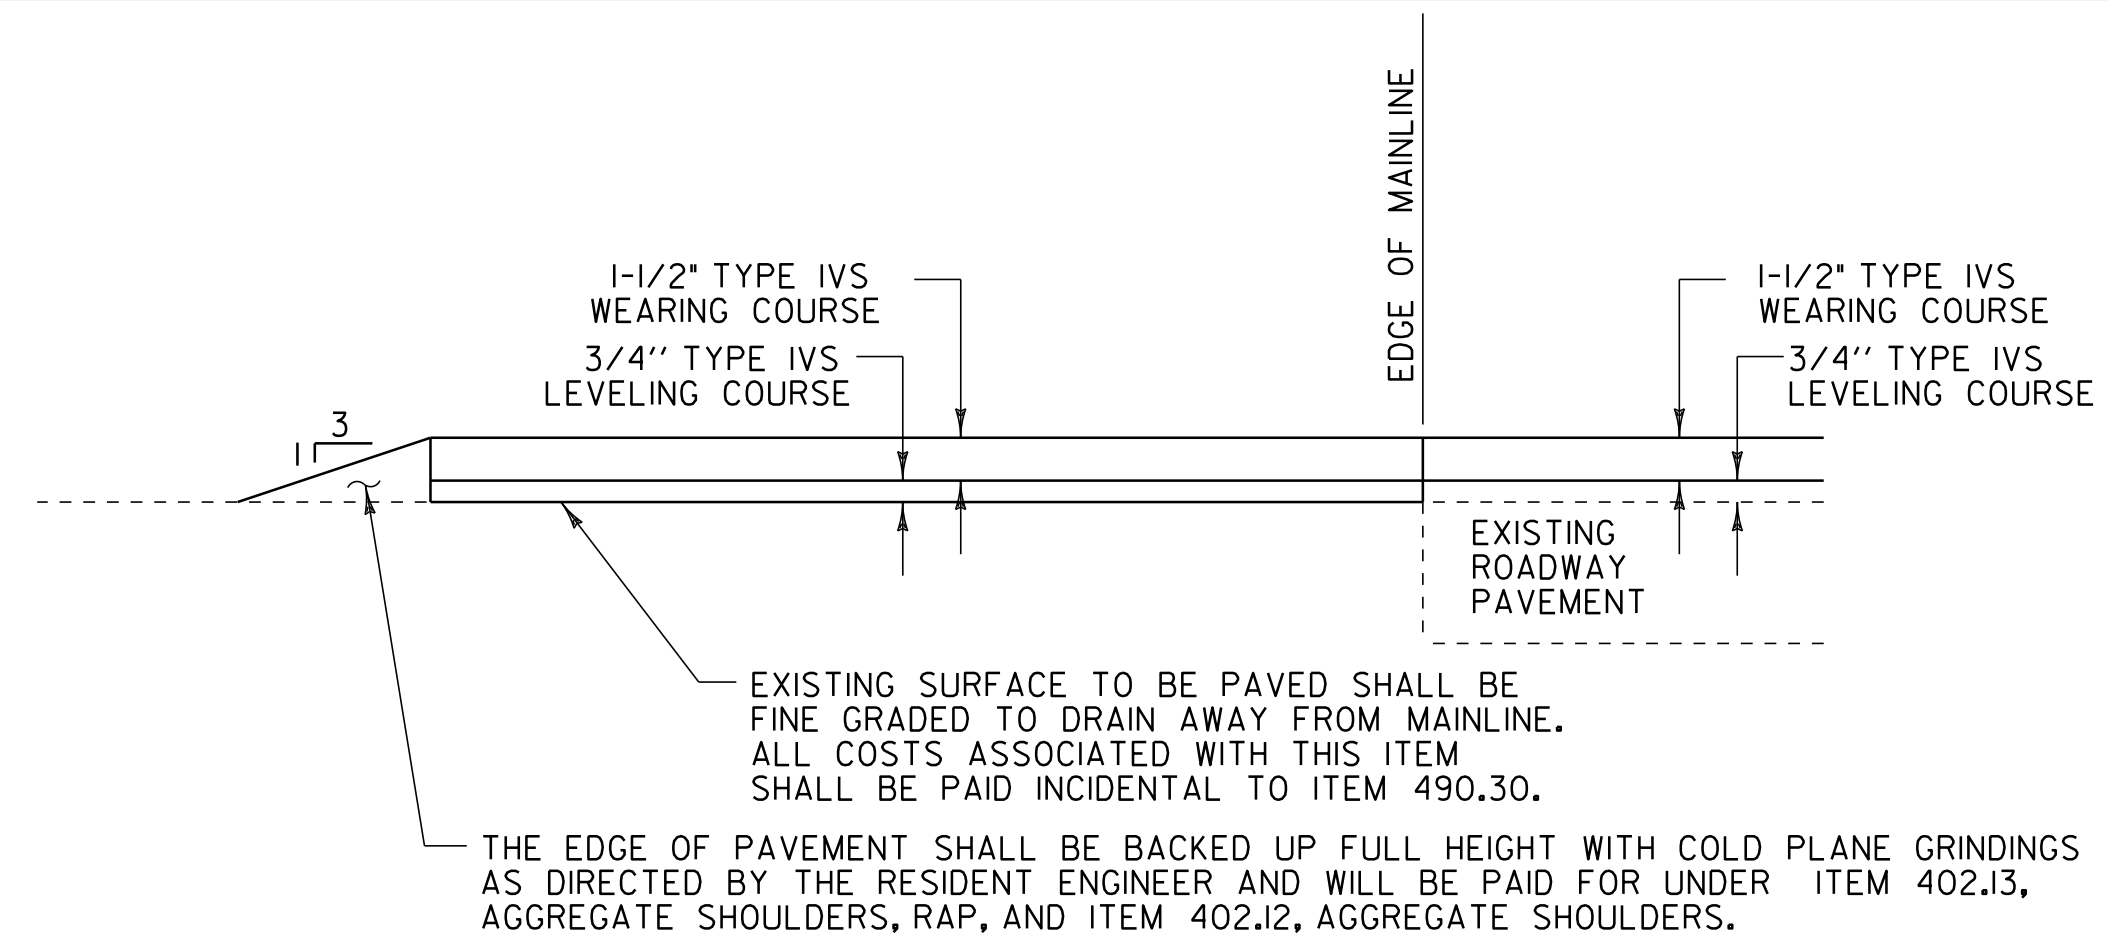

SECTION A-A

NOT TO SCALE

**INTERSECTION
 DETAILS
 SHEET #2**

PROJECT NAME:	GUILDHALL-MAIDSTONE		
PROJECT NUMBER:	STP 2706 (I)		
FILE NAME:	...07C162\...07C162.dgn	PLOT DATE:	31-OCT-2011 10:43
PROJECT LEADER:	DOMY	DRAWN BY:	PAVT MGMT
DESIGNED BY:	PAVT MGMT	CHECKED BY:	PAVT MGMT
IPARM FILE NAME:	07C162_16.i	SHEET	16 OF 18