

INDEX OF SHEETS

FOR INDEX, SEE SHEET 2

STATE OF VERMONT
AGENCY OF TRANSPORTATION




PROPOSED IMPROVEMENT
TOWN OF WEATHERSFIELD
COUNTY OF WINDSOR
VT RTE. 106

THIS PROJECT BEGINS IN WEATHERSFIELD ON VT. RTE. 106 AT STA. 123+55 (MM 2.339) AND EXTENDS NORTHERLY A DISTANCE OF 1.946 MILES (10,275 FEET) TO STATION 226+25 (MM 4.285) IN WEATHERSFIELD.

WORK TO BE PERFORMED UNDER THIS PROJECT INCLUDES RESURFACING WITH A LEVELING COURSE, WEARING COURSE, NEW PAVEMENT MARKINGS, GUARDRAIL, SIGNS, AND INCIDENTAL ITEMS AS SHOWN IN THE PROJECT QUANTITIES.

LENGTH OF PROJECT = 10,275 FT (1.946 MILES)
LENGTH OF ROADWAY = 10,275 FT (1.946 MILES)

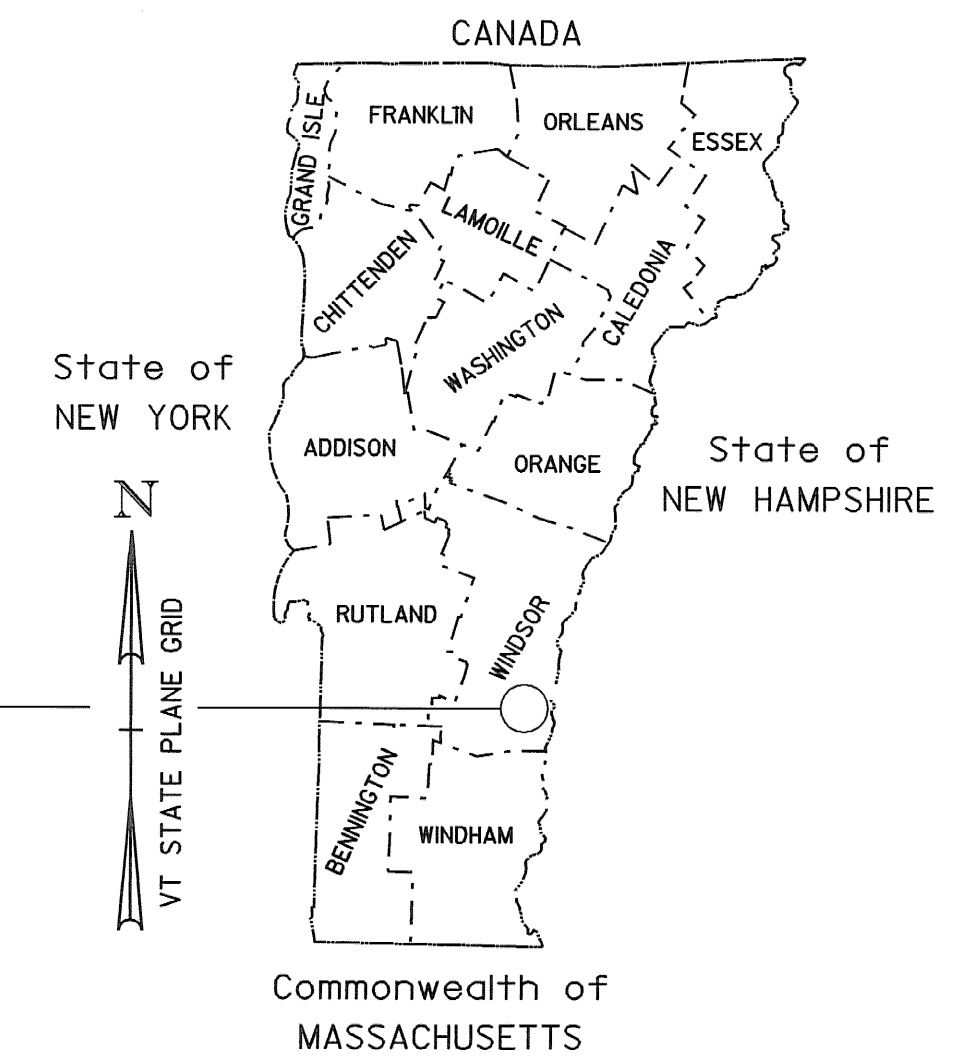


PROJECT LOCATION
STP 2711(1)

RECORD PLANS	
CONTRACTOR:	PIKE INDUSTRIES, INC. - BERLIN, VT
RESIDENT ENGINEER:	BUTCH COLBY
CONSTRUCTION BEGAN:	AUGUST 10, 2009
CONSTRUCTION COMPLETE:	OCTOBER 9, 2009
RECORD PLANS BY:	BUTCH COLBY & C. PIERCE
I HEREBY CERTIFY THAT ALL THE CONSTRUCTION REQUIRED BY THIS SET OF DRAWINGS HAS BEEN ACCOMPLISHED AS INDICATED HEREIN.	
BY:	<i>[Signature]</i> RESIDENT ENGINEER
DATE:	4/29/10
NOTE: Any further information concerning final quantities, amounts or other details relative to this project may be found at Central Files in the electronic archives.	

	AADT		DHV		CUM. ESALS (2009-2019)	CUM. ESALS (2009-2029)
	2009	2019	2009	2019		
BEGINNING OF PROJECT TO VT. RTE. 131	3100	3400	370	400	762,000	1,787,000

BITUMINOUS CONCRETE PAVEMENT SUPERPAVE MIXTURE DESIGN CRITERIA	
DESIGN LANE / DESIGN LIFE ESAL	893,500
DESIGN NUMBER OF GYRATIONS	65
PERFORMANCE GRADE ASPHALT BINDER	SEE SECTION 490 GENERAL SPECIAL PROVISIONS

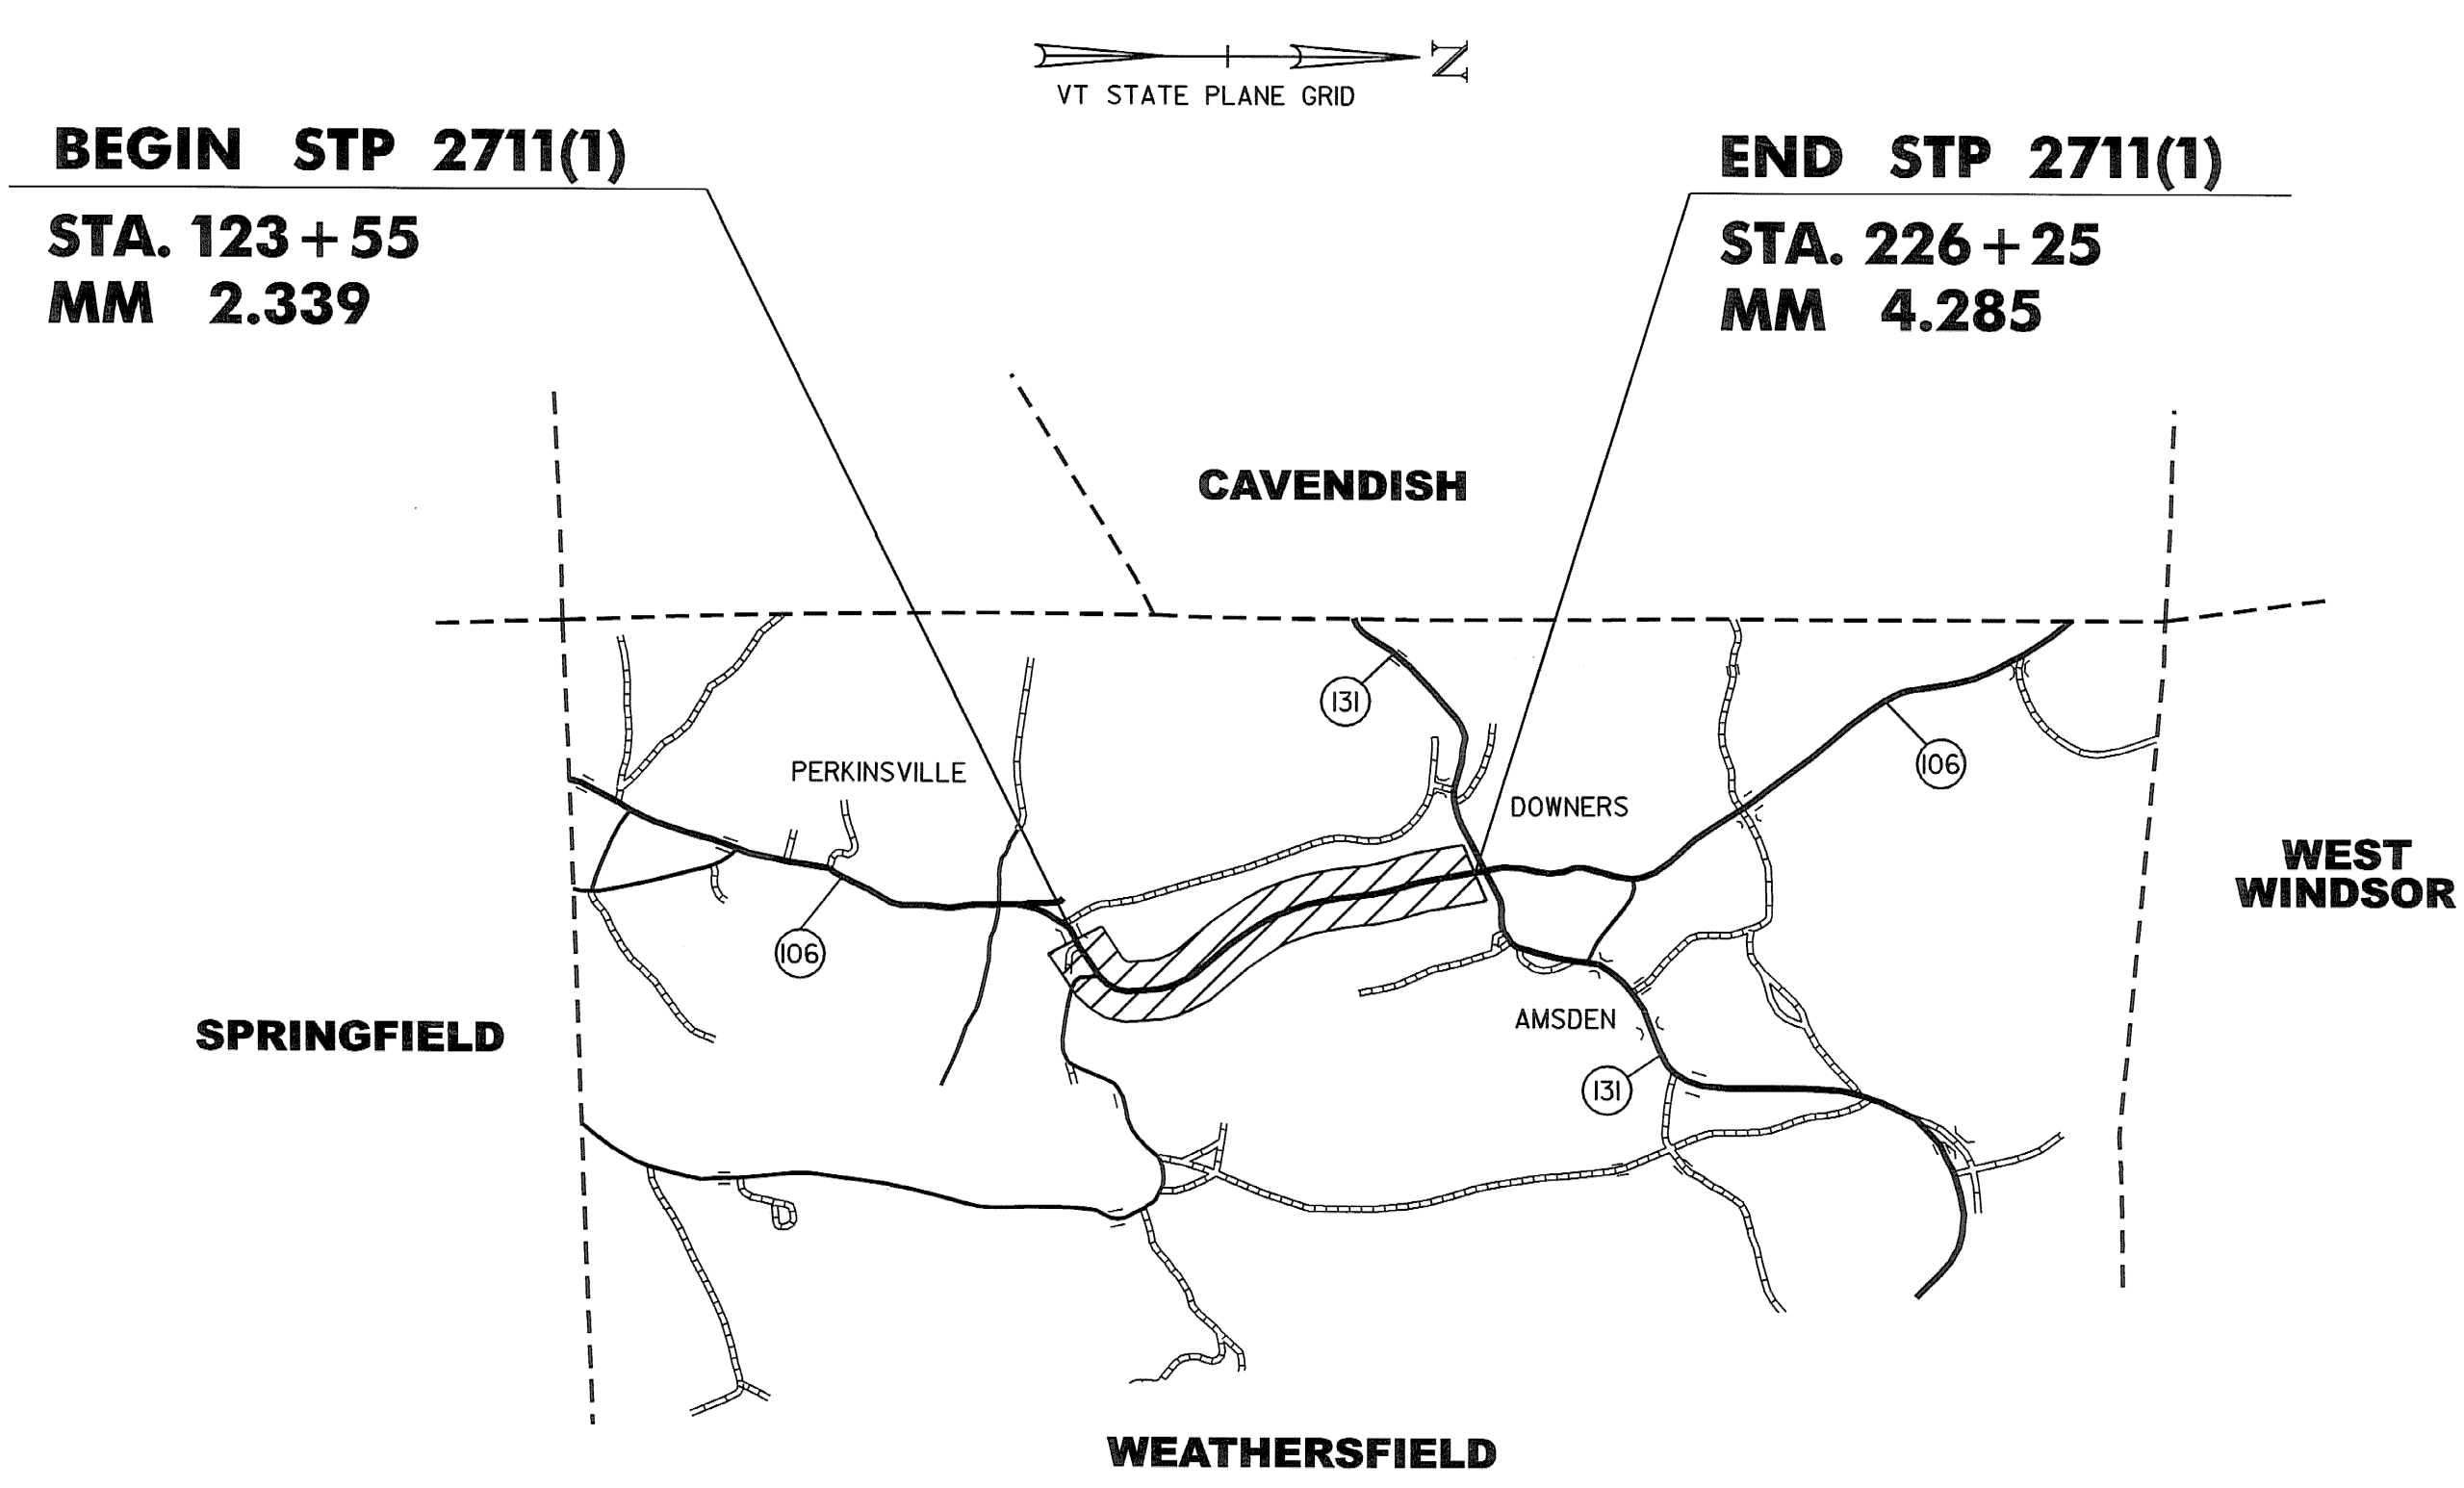

CONVENTIONAL SYMBOLS	
COUNTY LINE	
TOWN LINE	
LIMITS OF ACCESS	
POINT OF ACCESS	
FENCE LINE	
STONE WALL	
TRAVELED WAY	
GUARD RAIL	
RAILROAD	
SURVEY LINE	
CULVERT	
POWER POLE	
TELEPHONE POLE	
TREES	
CONTROL OF ACCESS	
PROPERTY LINE	
R.O.W. TAKING LINE	
SLOPE RIGHTS	
TOP OF CUT	
TOE OF SLOPE	

SURVEYED BY :	
SURVEYED DATE :	
DATUM	
VERTICAL	N/A
HORIZONTAL	N/A

THESE PLANS ARE SUBJECT TO SUCH ENGINEERING CHANGES AS MAY BE REQUIRED BY THE FEDERAL HIGHWAY ADMINISTRATION OR THE DIRECTOR OF PROGRAM DEVELOPMENT.
CONSTRUCTION IS TO BE CARRIED ON IN ACCORDANCE WITH THESE PLANS AND THE STANDARD SPECIFICATIONS FOR CONSTRUCTION DATED 2006, AS APPROVED BY THE FEDERAL HIGHWAY ADMINISTRATION ON JUNE 15, 2006 FOR USE ON THIS PROJECT, INCLUDING ALL SUBSEQUENT REVISIONS AND SUCH REVISED SPECIFICATIONS AND SPECIAL PROVISIONS AS ARE INCORPORATED IN THESE PLANS.

DIRECTOR OF PROGRAM DEVELOPMENT	
APPROVED <i>[Signature]</i> DATE 5-7-09	
PROJECT MANAGER : TED DOMEY	
PROJECT NAME : WEATHERSFIELD	
PROJECT NUMBER : STP 2711(1)	
SHEET 1 OF 21 SHEETS	